


SHEET NO. 10
 PROJECT NO. 10
 DATE 10/2/54
 10/2/54

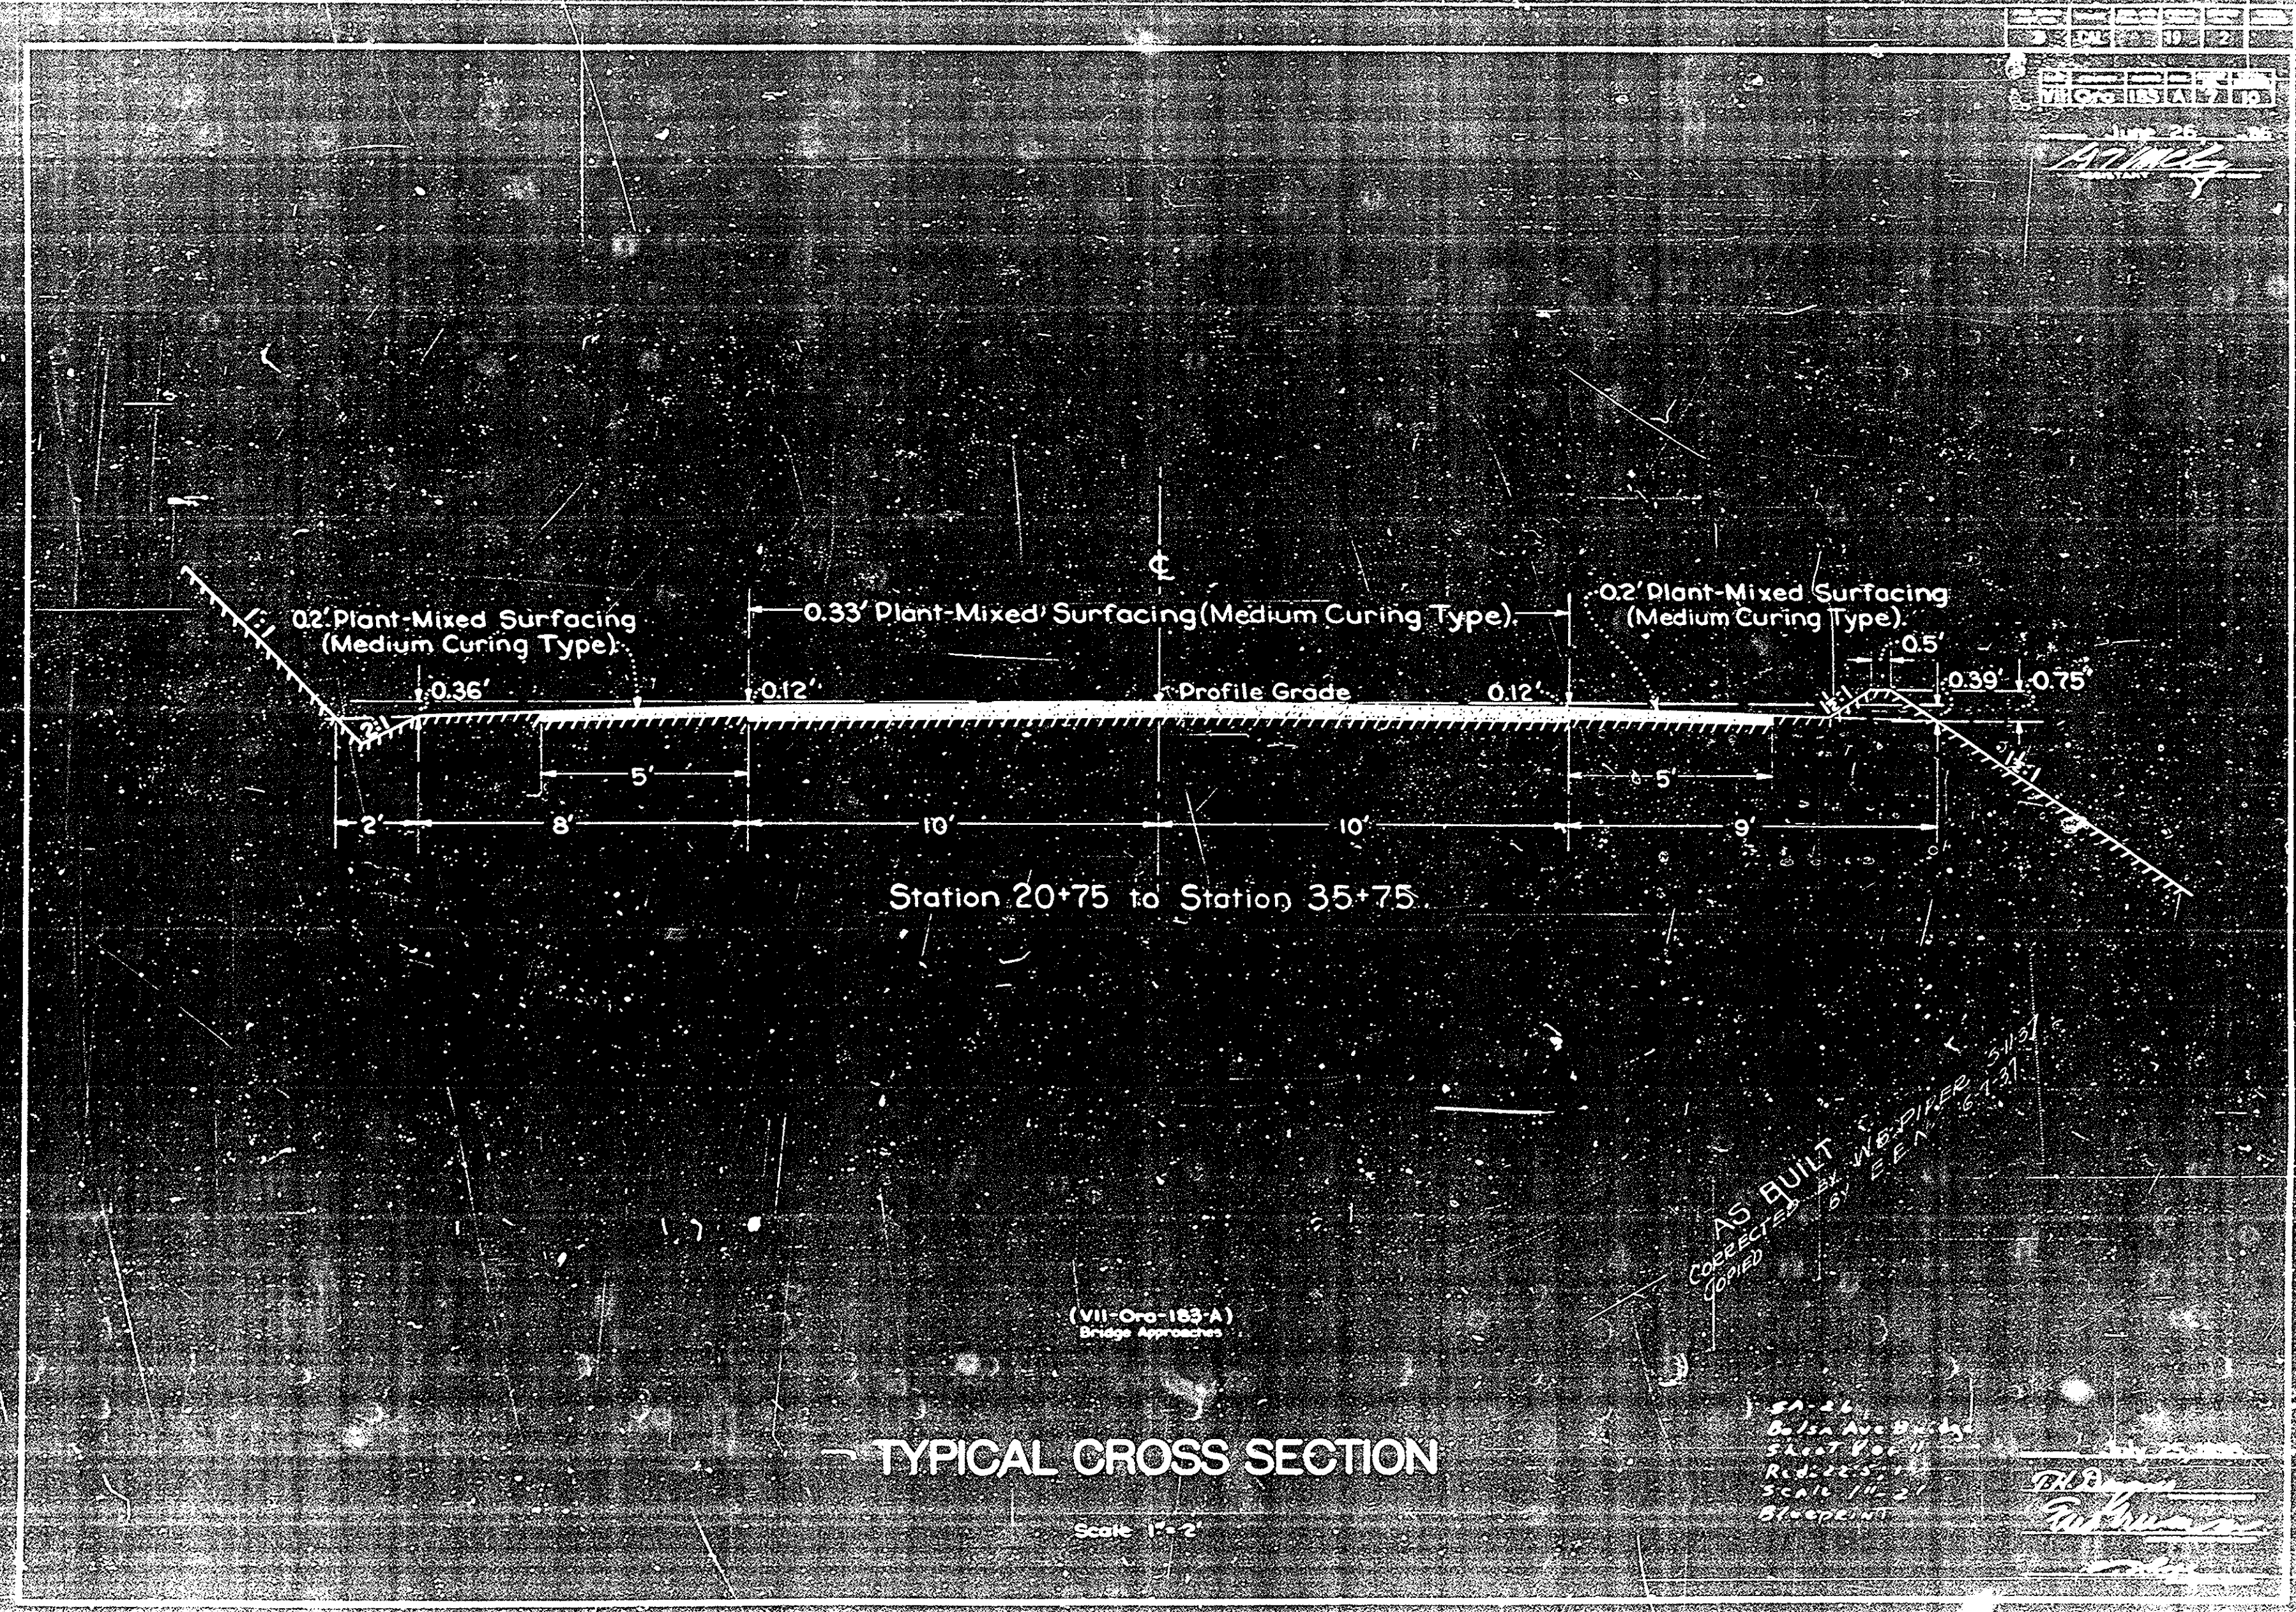

(VII-Ord-153-A)
Bridge Approaches

AS BUILT
 CORRECTED BY W. D. PIER
 COPIED BY E. E. N. 6-1-57

SA-26
 10/2/54
 10/2/54
 10/2/54
 10/2/54

D. H. Rogers
 10/2/54