







TYPICAL CROSS SECTION

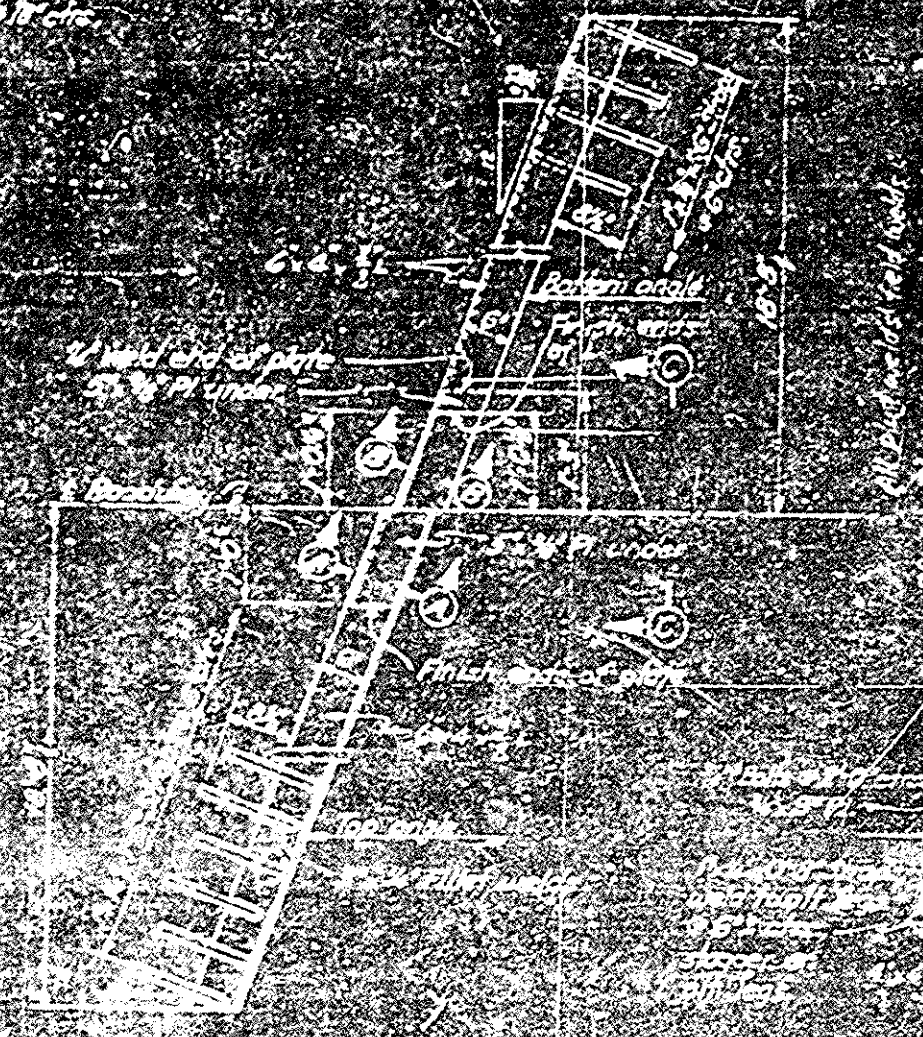



EXPANSION JOINT DETAIL

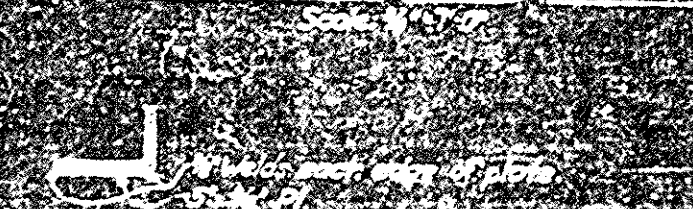

PLAN AT EXPANSION JOINT

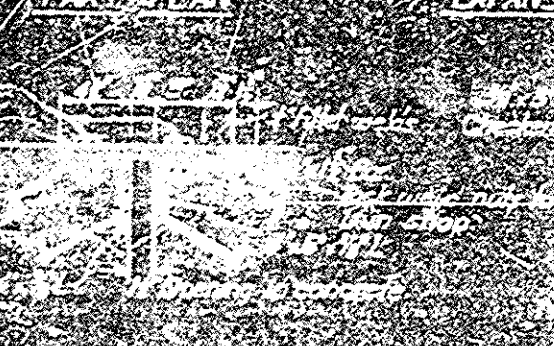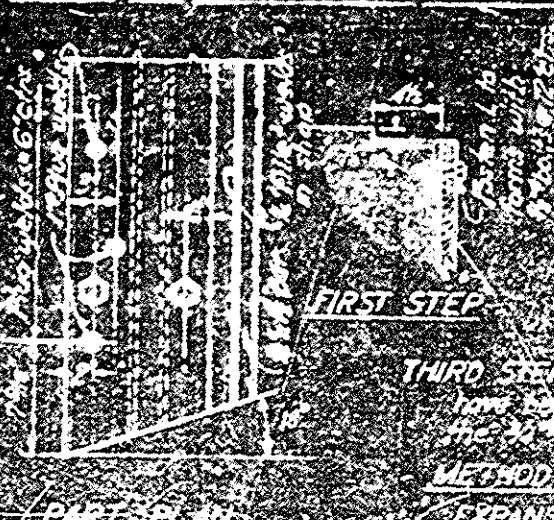


EXPANSION ARMOR DETAIL

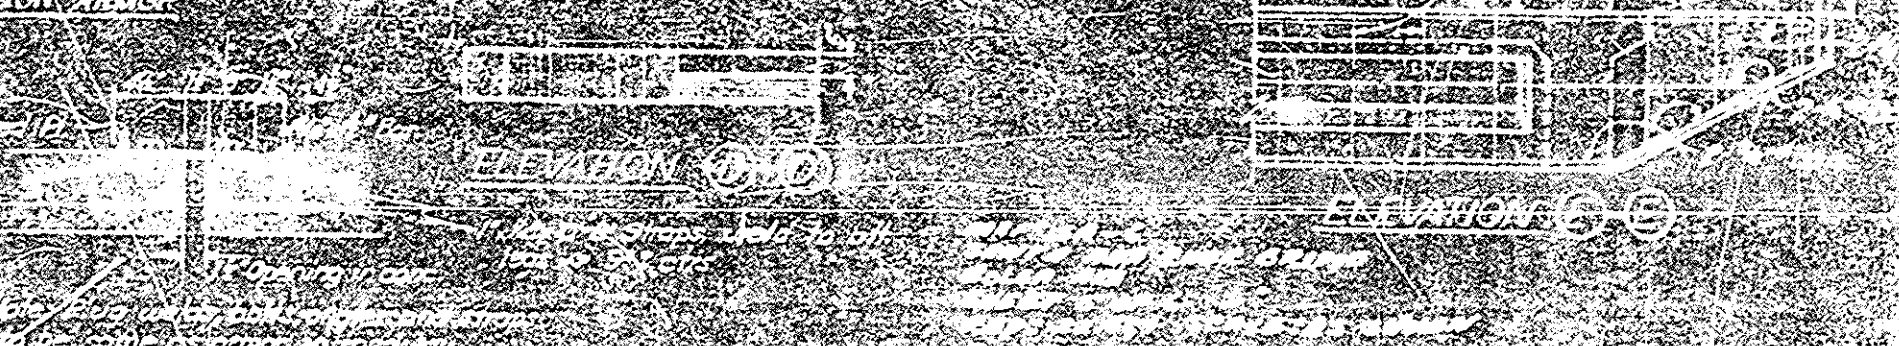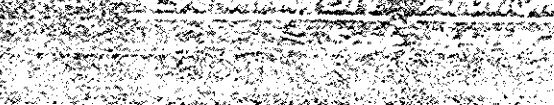

EXPANSION ARMOR DETAIL



SECTION AT PIER

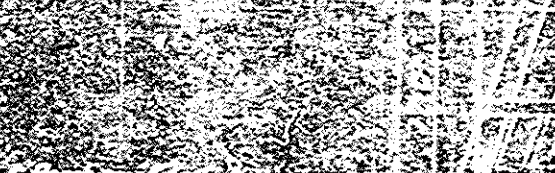


SECTION AT PIER



SECTION AT PIER



SECTION AT PIER

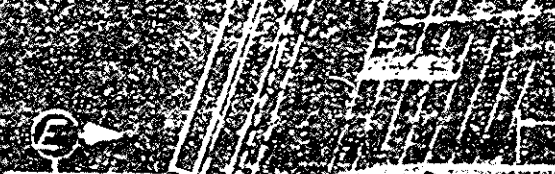

SECTION AT PIER




SECTION AT PIER



SECTION AT PIER




SECTION AT PIER

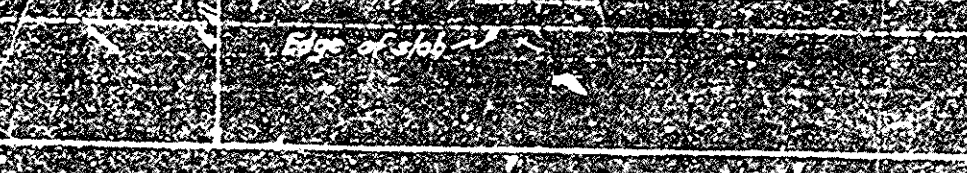

SECTION AT PIER



SECTION AT PIER

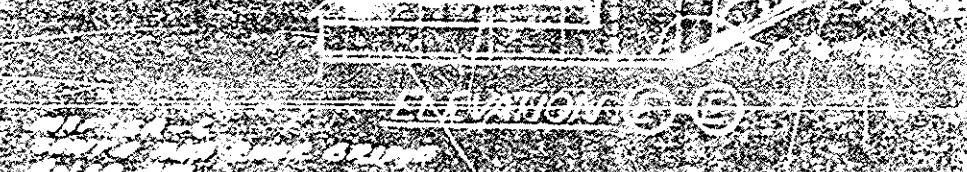

SECTION AT PIER

