

INDEX OF SHEETS

SHEET NO.	TITLE
1	TITLE SHEET
2	GENERAL PLAN
3	FOUNDATION PLAN
4	PIER DETAILS
5	SUPERSTRUCTURE LAYOUT
6	REINFORCEMENT & GENERAL NOTES
7	MISCELLANEOUS DETAILS
8	LOG OF TEST BORINGS
9	STRUCTURE EXCAV. & BACKFILL
10	PILE DETAIL
11	PLAN OF APPROACHES

HIGHWAY DEPARTMENT COUNTY OF ORANGE



PLAN

BOLSA AVE. BRIDGE

ACROSS SANTA ANA RIVER (CHANNEL EI) (SA-26A)



FROM STATION 341+10.00 TO STATION 347+00.00

TOTAL LENGTH 0.11 MILES

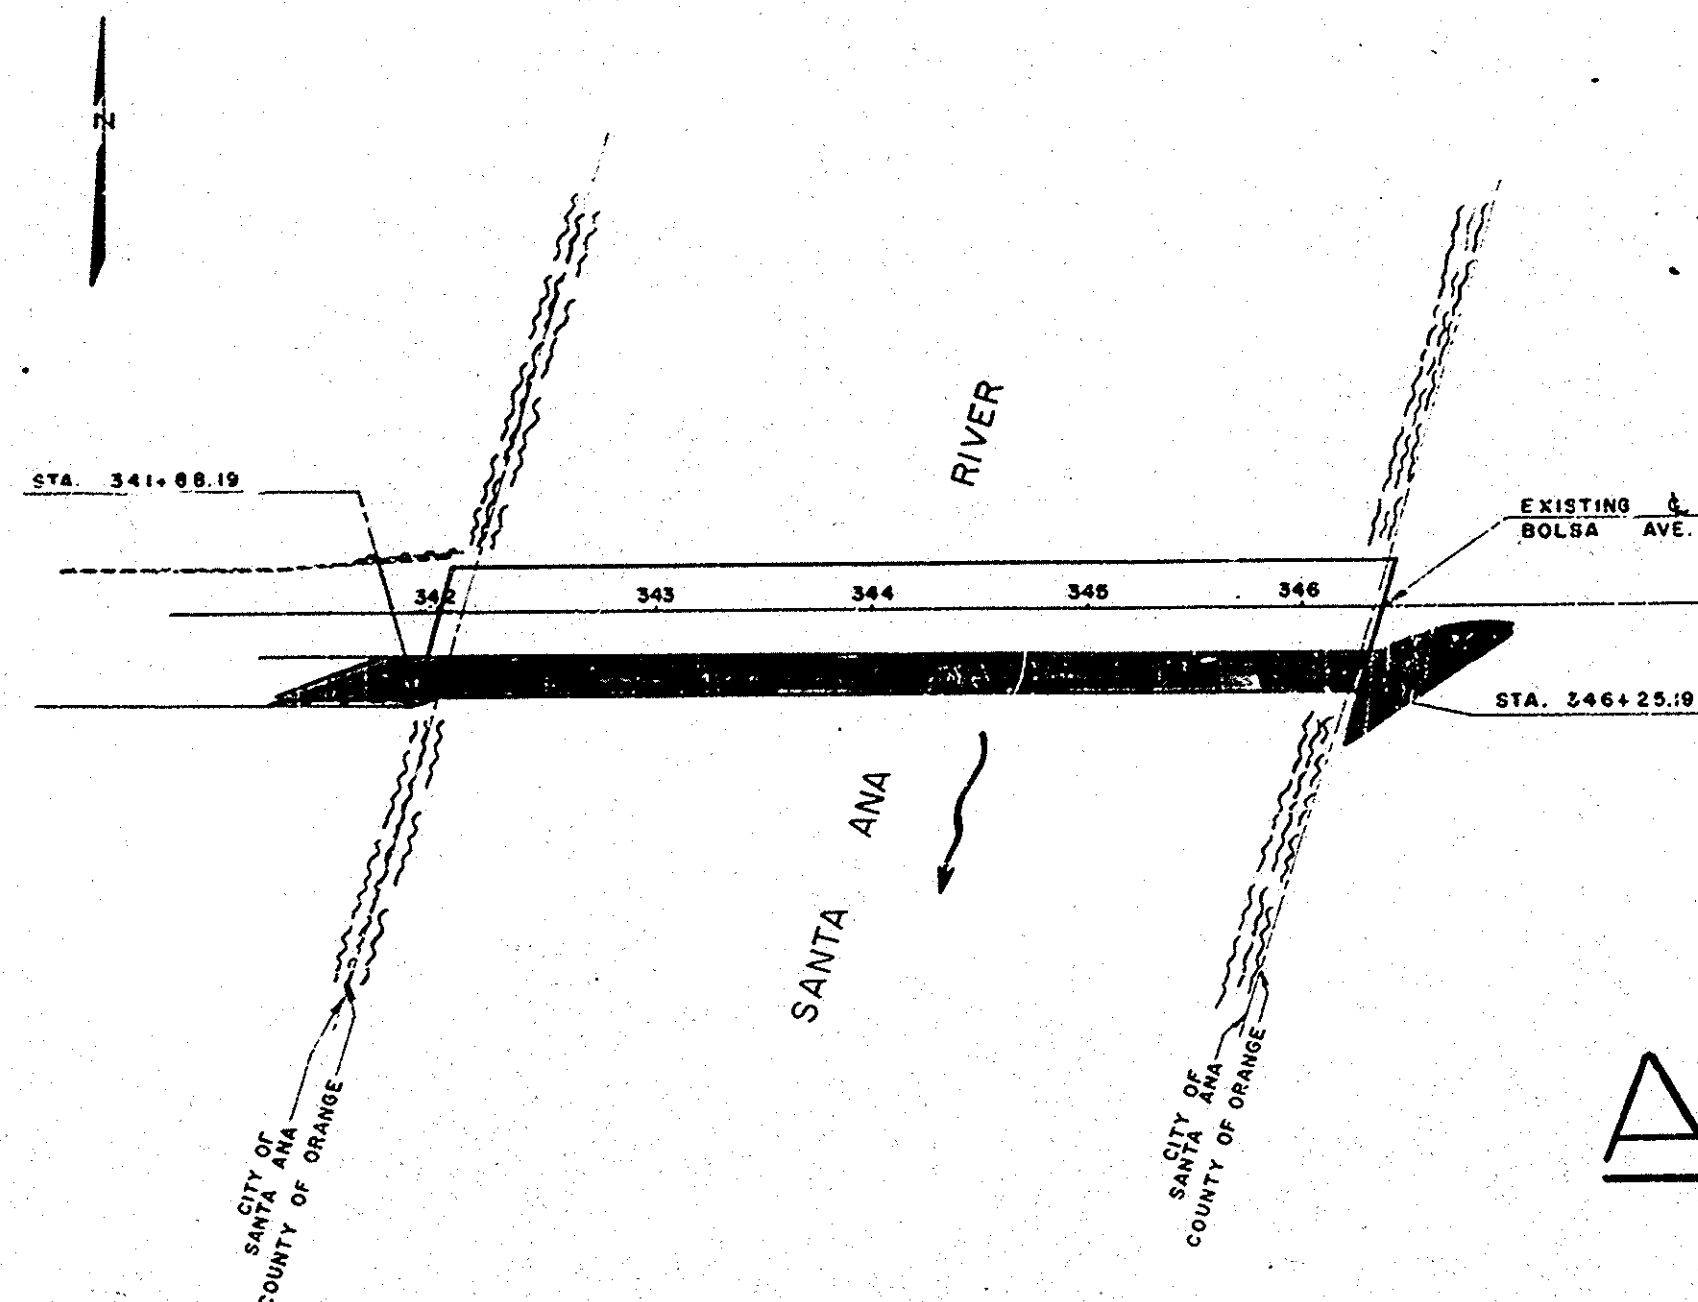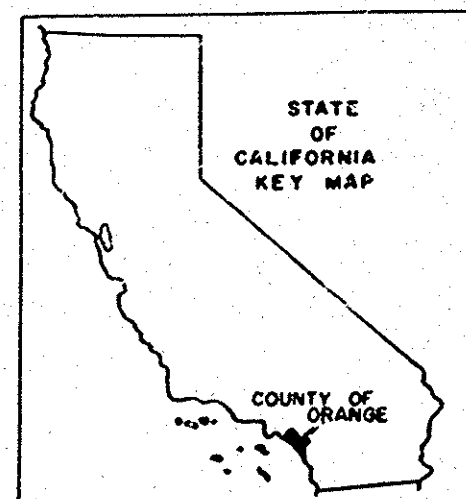

CONVENTIONAL SIGNS	
COUNTY LINE	FRUIT TREES
CITY LIMITS	EUCALYPTUS TREE
R/W LINE	EVERGREEN TREE
BASE OR SURVEY LINE	PALM TREE
CONSTRUCTION	POWER POLE
TRAVELED WAY	TELEPHONE POLE
RAILROAD TRACKS	GUY POLE & ANCHOR
CULVERTS	MANHOLE
DROP INLET	FIRE HYDRANT
WOOD FENCE	STANDPIPE
WIRE FENCE	WEIR BOX
CHAIN LINK FENCE	GAS WATER METERS
CORRUGATED METAL FENCE	WATER VALVE
CONCRETE WALL	GUARD RAIL
MASONRY WALL	LEVEL
HEDGE OR BUSHES	MARSH
BANK OR RETAINING WALL	SIDEWALK
FILL SLOPE	UNFENCED PROPERTY
CUT SLOPE	

LAYOUT PLAN

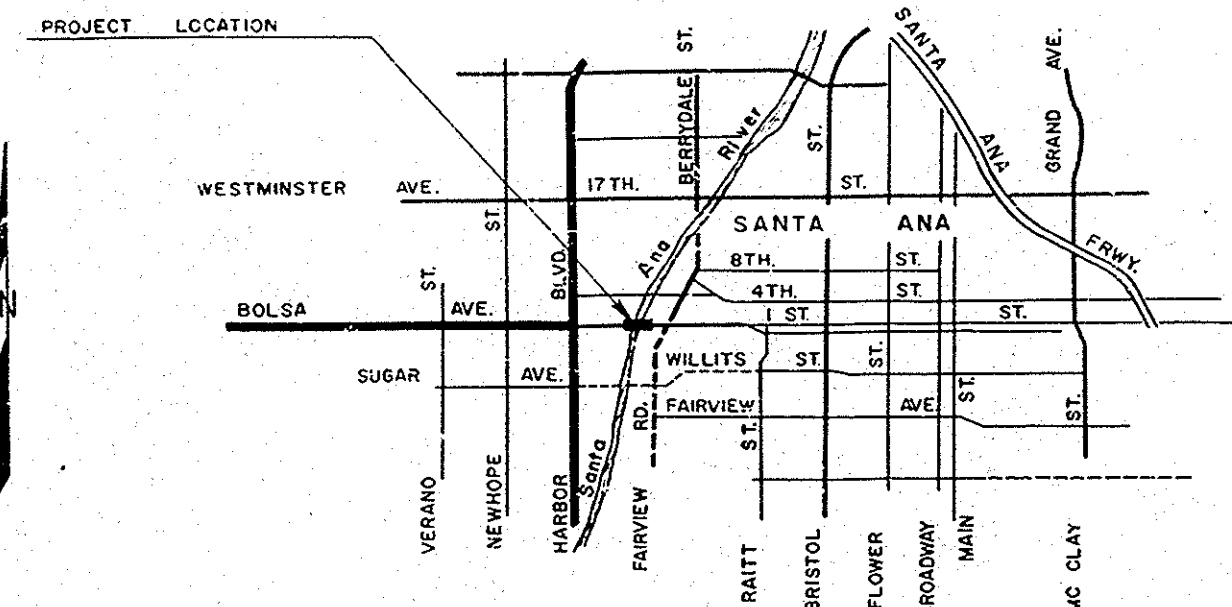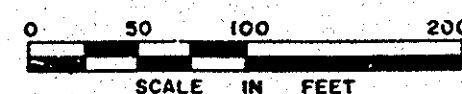

COUNTY OF ORANGE
ROAD COMMISSIONER
CIVIL ENGINEER LICENSE NO. 7872
FLOOD CONTROL DISTRICT

AS-BUILT PLANS

Corrections By: JOHN EWLES
Checked By: J. V. FROST

SA-26
Bolsa Ave Bridge-
As Built Plans
over Santa Ana River
Sheet 1 of 11
Red. 22.5:1 Scale Graphic
Blackline Print

MICROFILMED
JUN 18 1962

SA - 26

Filling @ Name
First St.

#14692
1959
First St. BR. ASBUILT
WIDENING OVER S.A.R.
SA-26A
55C-0022-WID
Thomas: 829-A3 118443