


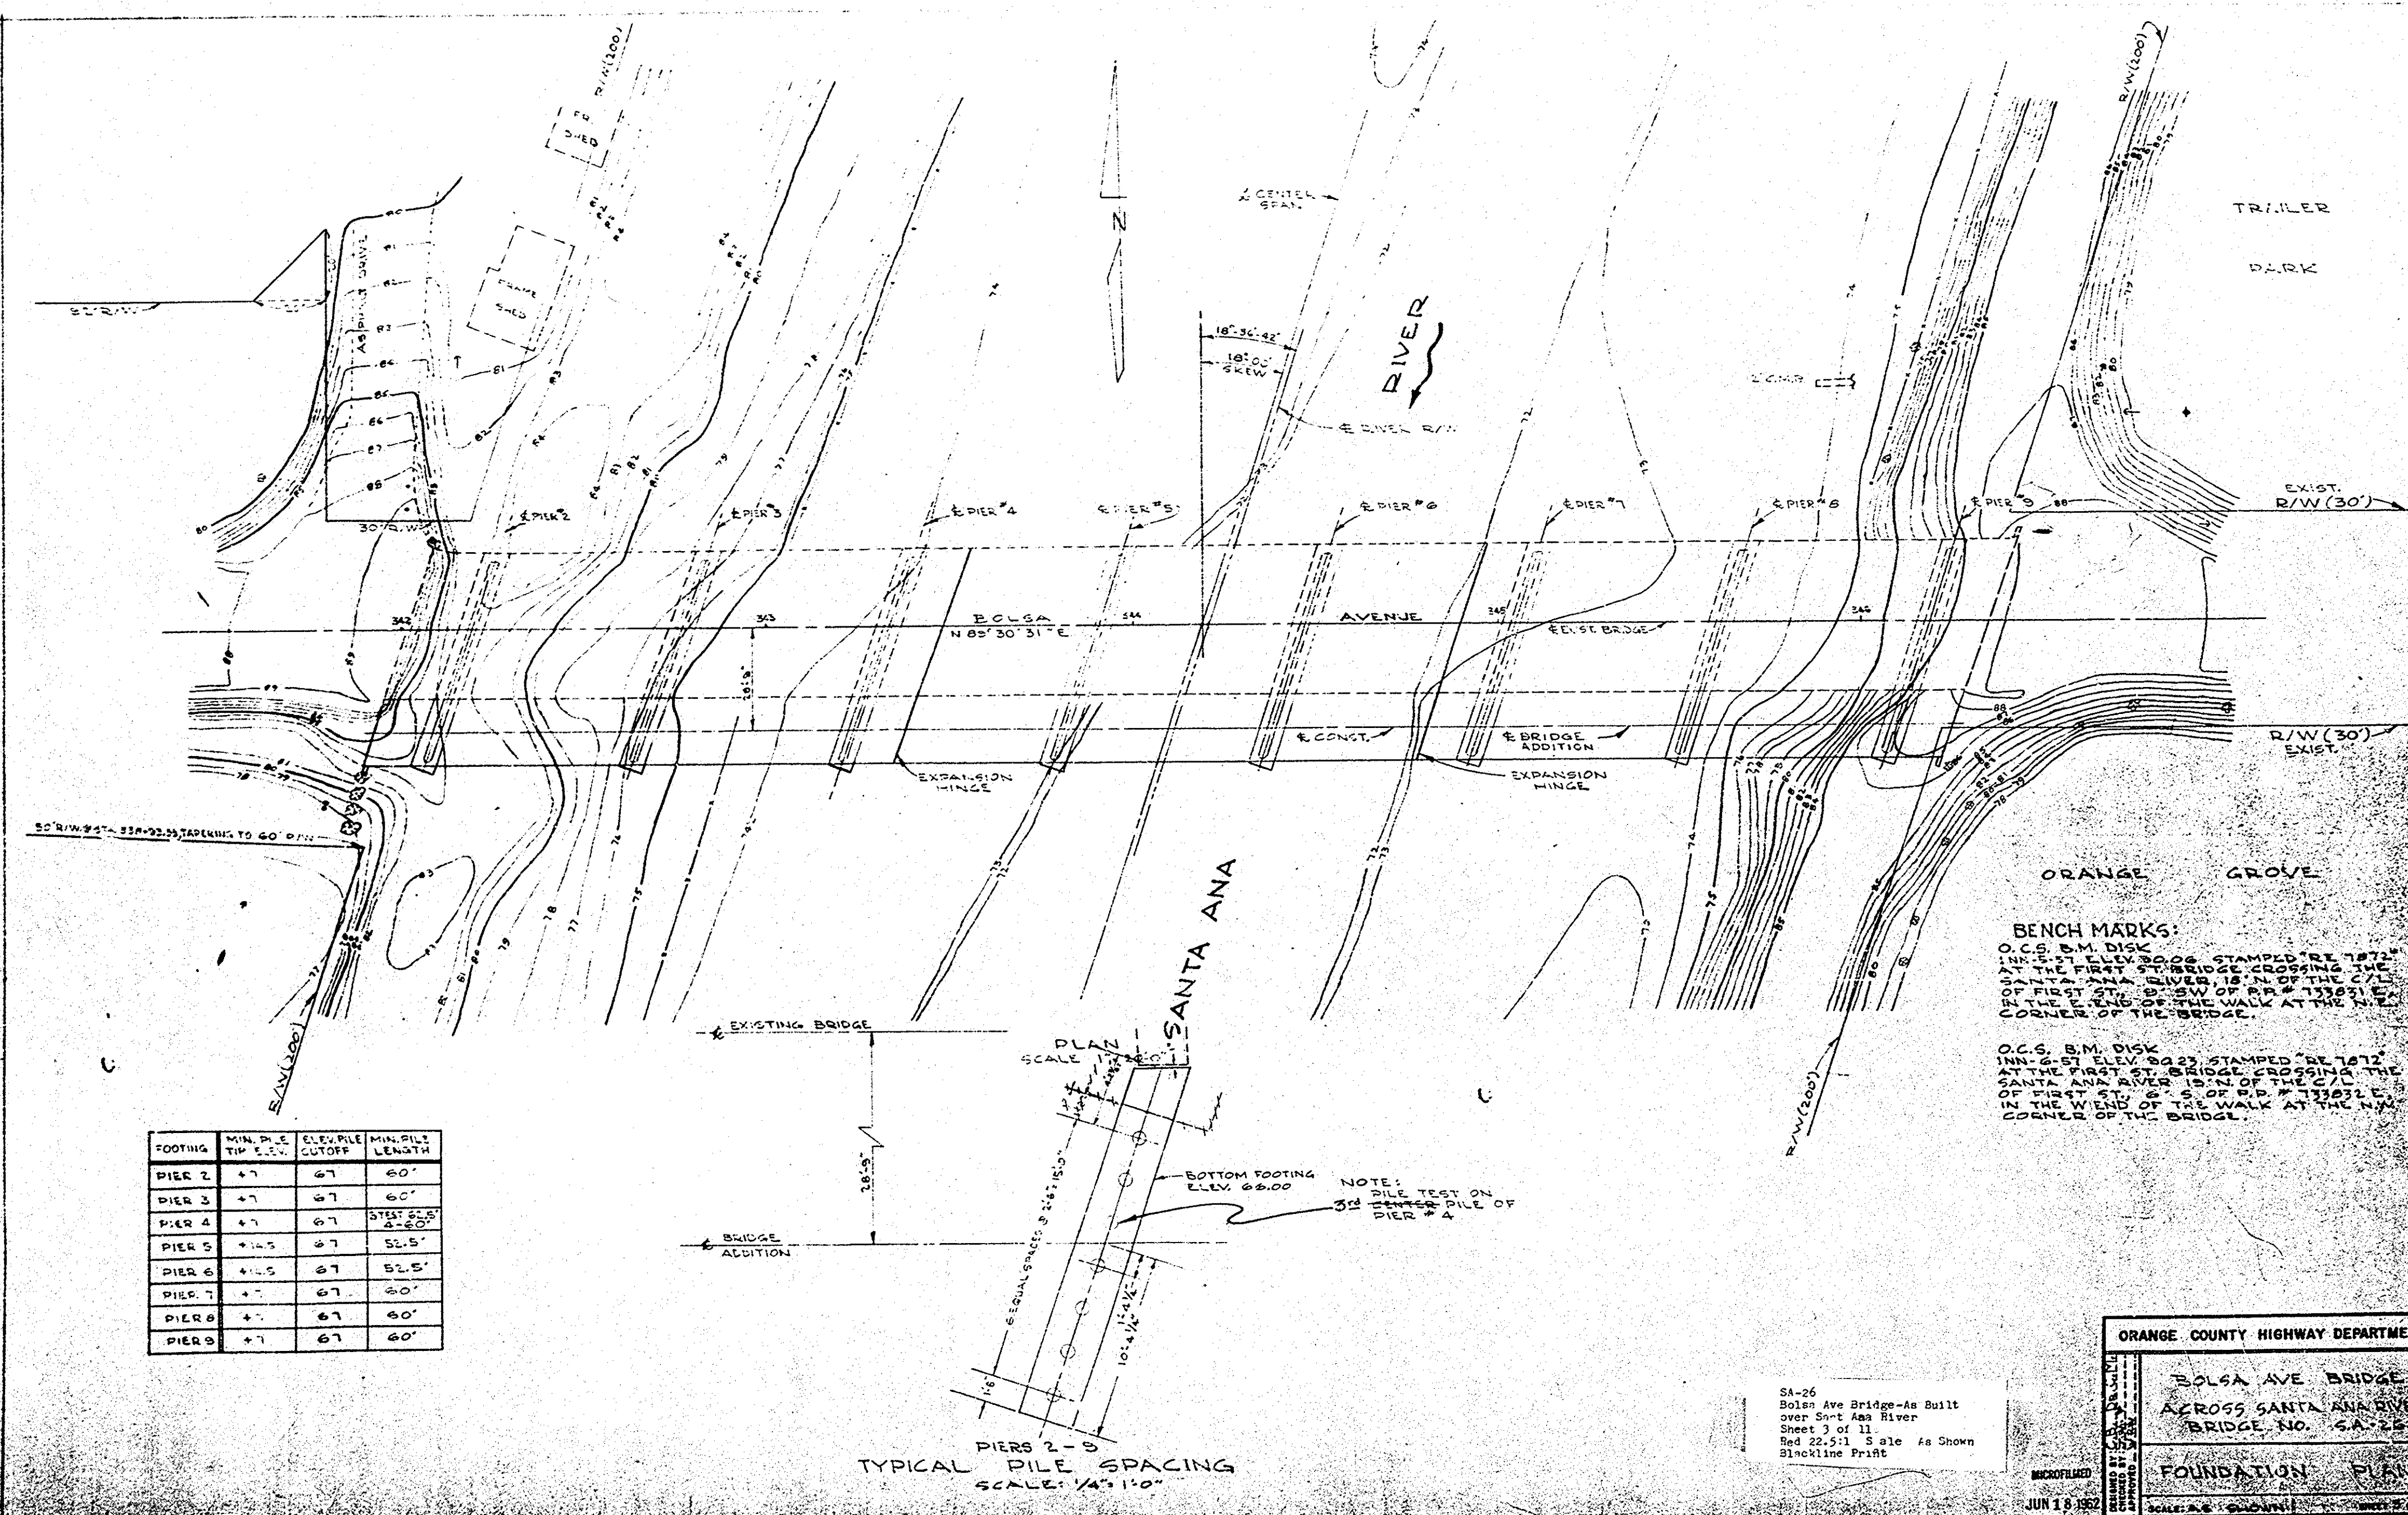

SA-26
 Bolsa Ave Bridge-As Built
 Over Santa Ana River
 Sheet 2 of 11
 Red 22.5:1 Scale As Shown
 Blackline Print

ORANGE COUNTY HIGHWAY DEPARTMENT

BOLSA AVE BRIDGE
 ACROSS SANTA ANA RIVER
 BRIDGE NO. SA-26

FOUNDATION PLAN

SCALE: 1/4" = 1'-0"

JUN 18 1962