

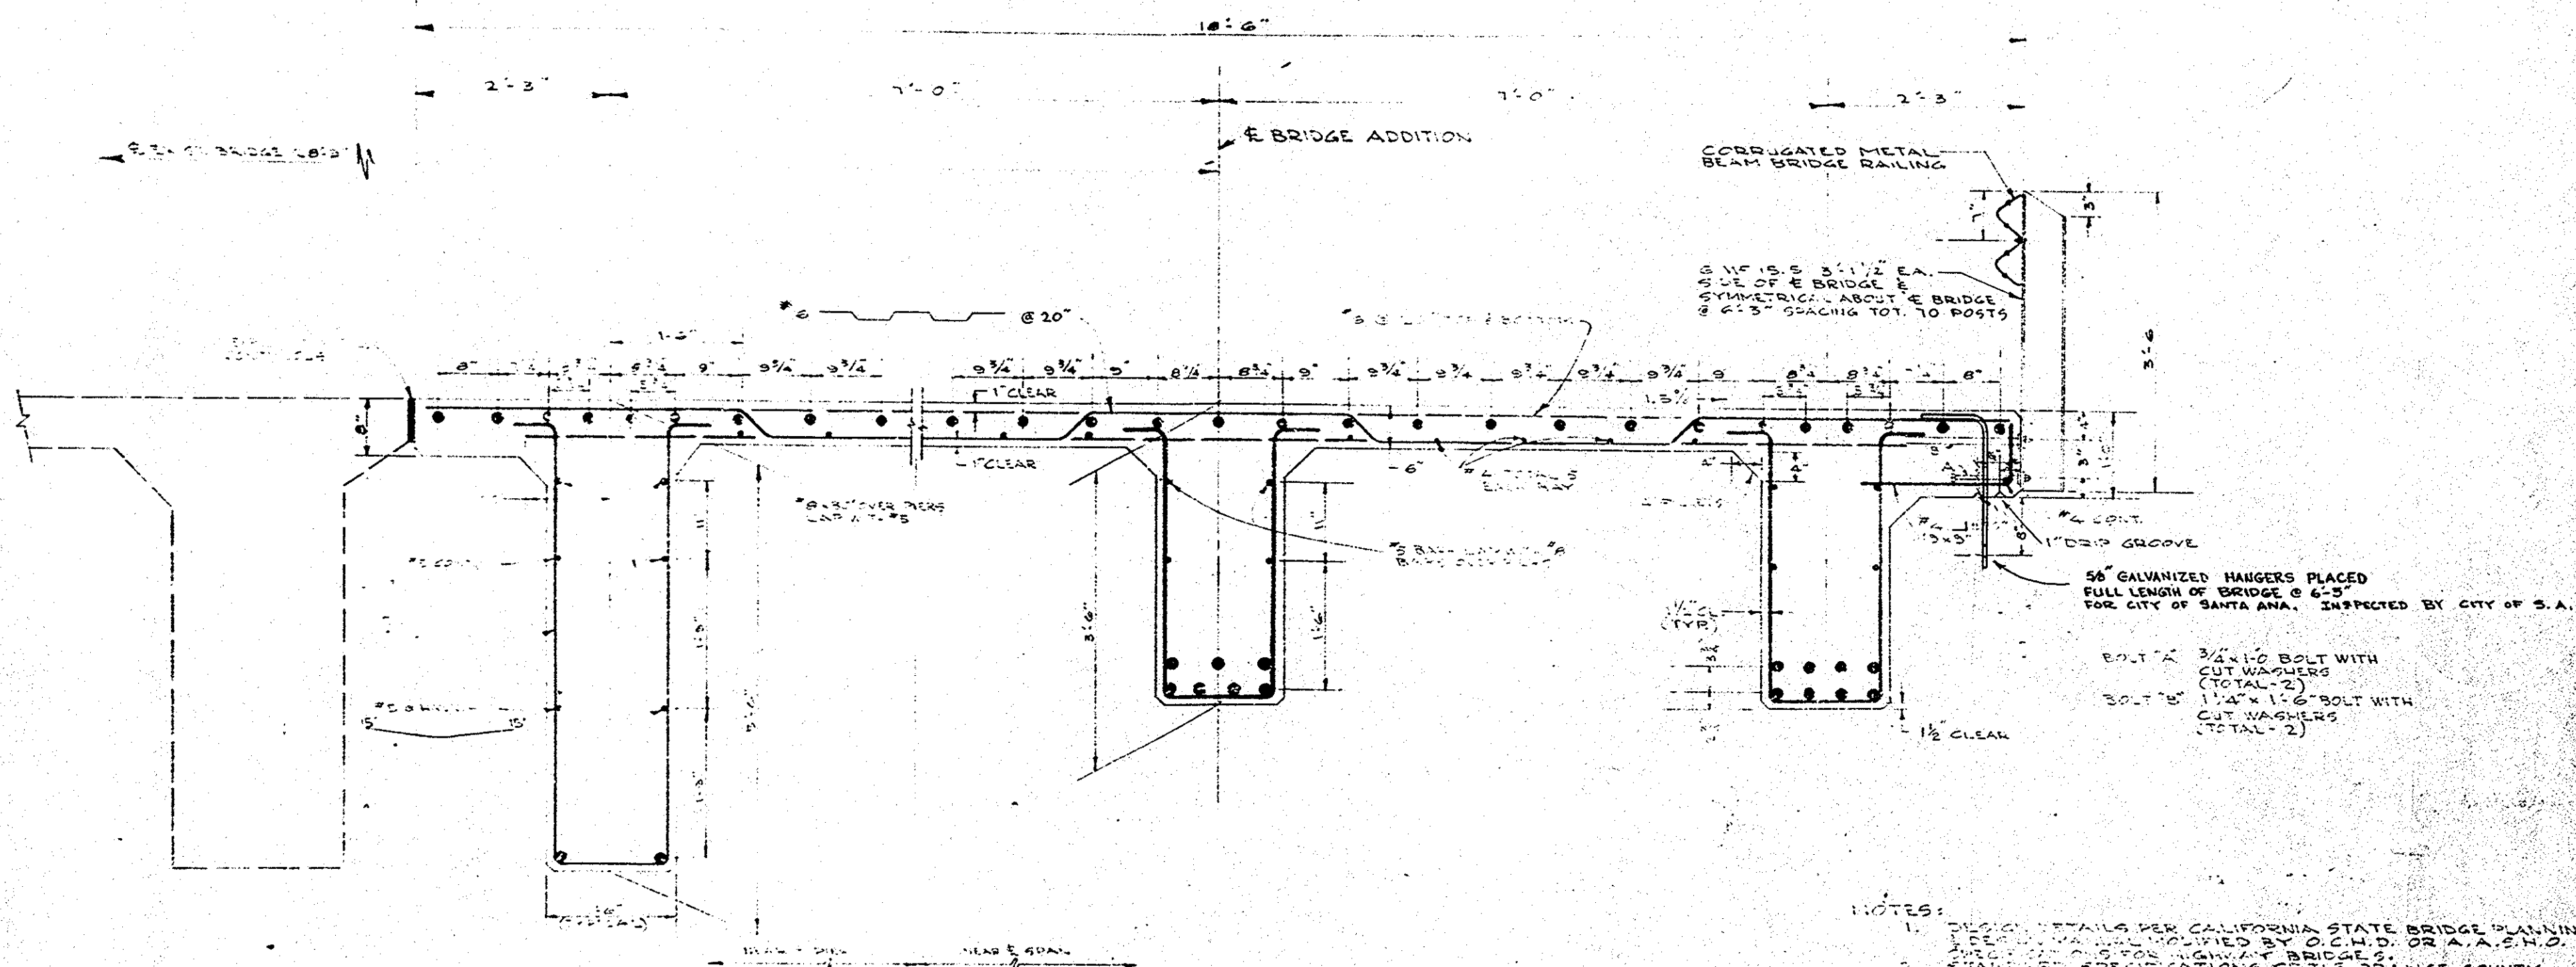


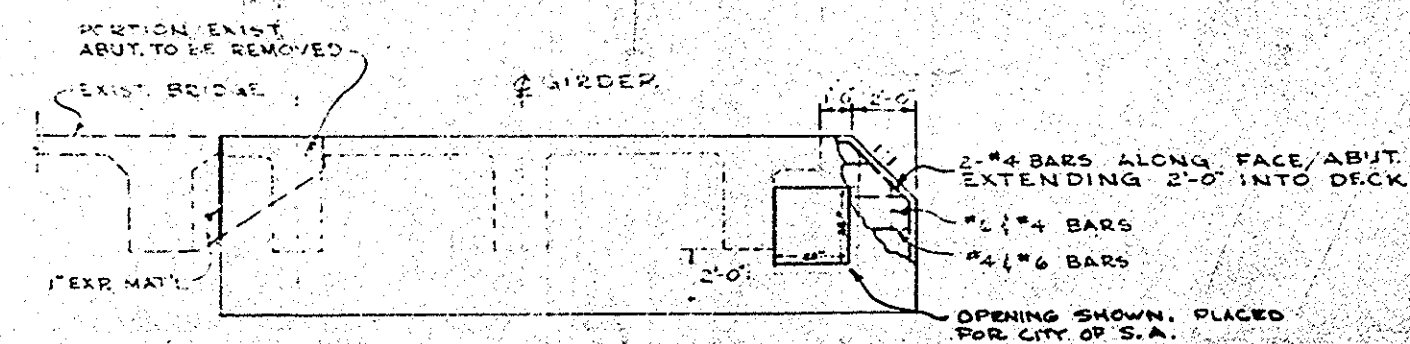

- NOTES:
1. DESIGN DETAILS PER CALIFORNIA STATE BRIDGE PLANNING DEPT. MAY BE USED, O.C.H.D. OR A.A.S.H.O. PRECEDENCE FOR HIGHWAY BRIDGES.
 2. STANDARD SPECIFICATIONS OF THE ORANGE COUNTY HIGHWAY DEPT. & THE SPECIAL PROVISIONS.
 3. 1100 S.F. - ALL LIVE LOAD
 4. TRUCKS ARE BEING CONC. WITH 45 TON BEARING
 5. UNIT STRUCTURES ARE AS FOLLOWS:
a. 1100 S.F. EXCEPT NOTED
b. 1100 S.F. FOR ROADWAY CLEAR IN GARDENS
c. 1100 S.F. 110
 6. REINFORCING BARS A.C.T.M. - #30S BARS.
 7. COVER FOR REINFORCEMENT IS 2" CLEAR UNLESS OTHERWISE NOTED.
 8. REINFORCING BARS W/SPACED 12 OR 35 DIA. AT SPICES
 9. REINFORCING BARS 12 OR 35 DIA. IN A.C.T.M.
 10. ALL CONCRETE IS CLASS "A" - 4000 PSI TYPE II PORTLAND CEMENT
 11. ALL FINISHED EDGES OF CONCRETE SHALL HAVE CURBS OR FINISHES AS OTHERWISE NOTED.
 12. LEAVE NO OBSTRUCTION & DETAIL NOT A PART OF THIS CONTRACT.

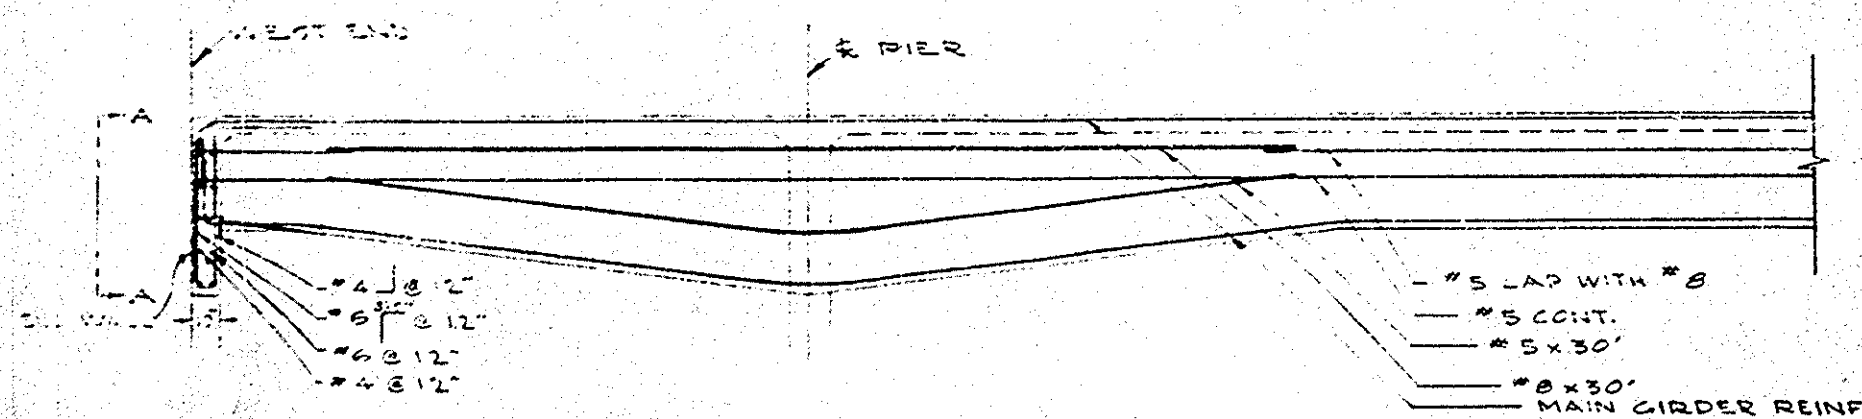

SECTION A-A
SCALE $\frac{1}{4}" = 1'-0"$

SA-26
Bolsa Ave Bridge-As Built
over Santa Ana River
Sheet 6 of 11
Red 22.5:1 Scale As Shown
Blackline Print

MICROFILMED
JUN 18 196

ORANGE COUNTY HIGHWAY DEPARTMENT

BOLSA AVE. BRIDGE
ACROSS SANTA ANA RIVER

TYPICAL SECTION & GENERAL NOTES

3SCALE: AS 51135N SHEET 2 OF 2