

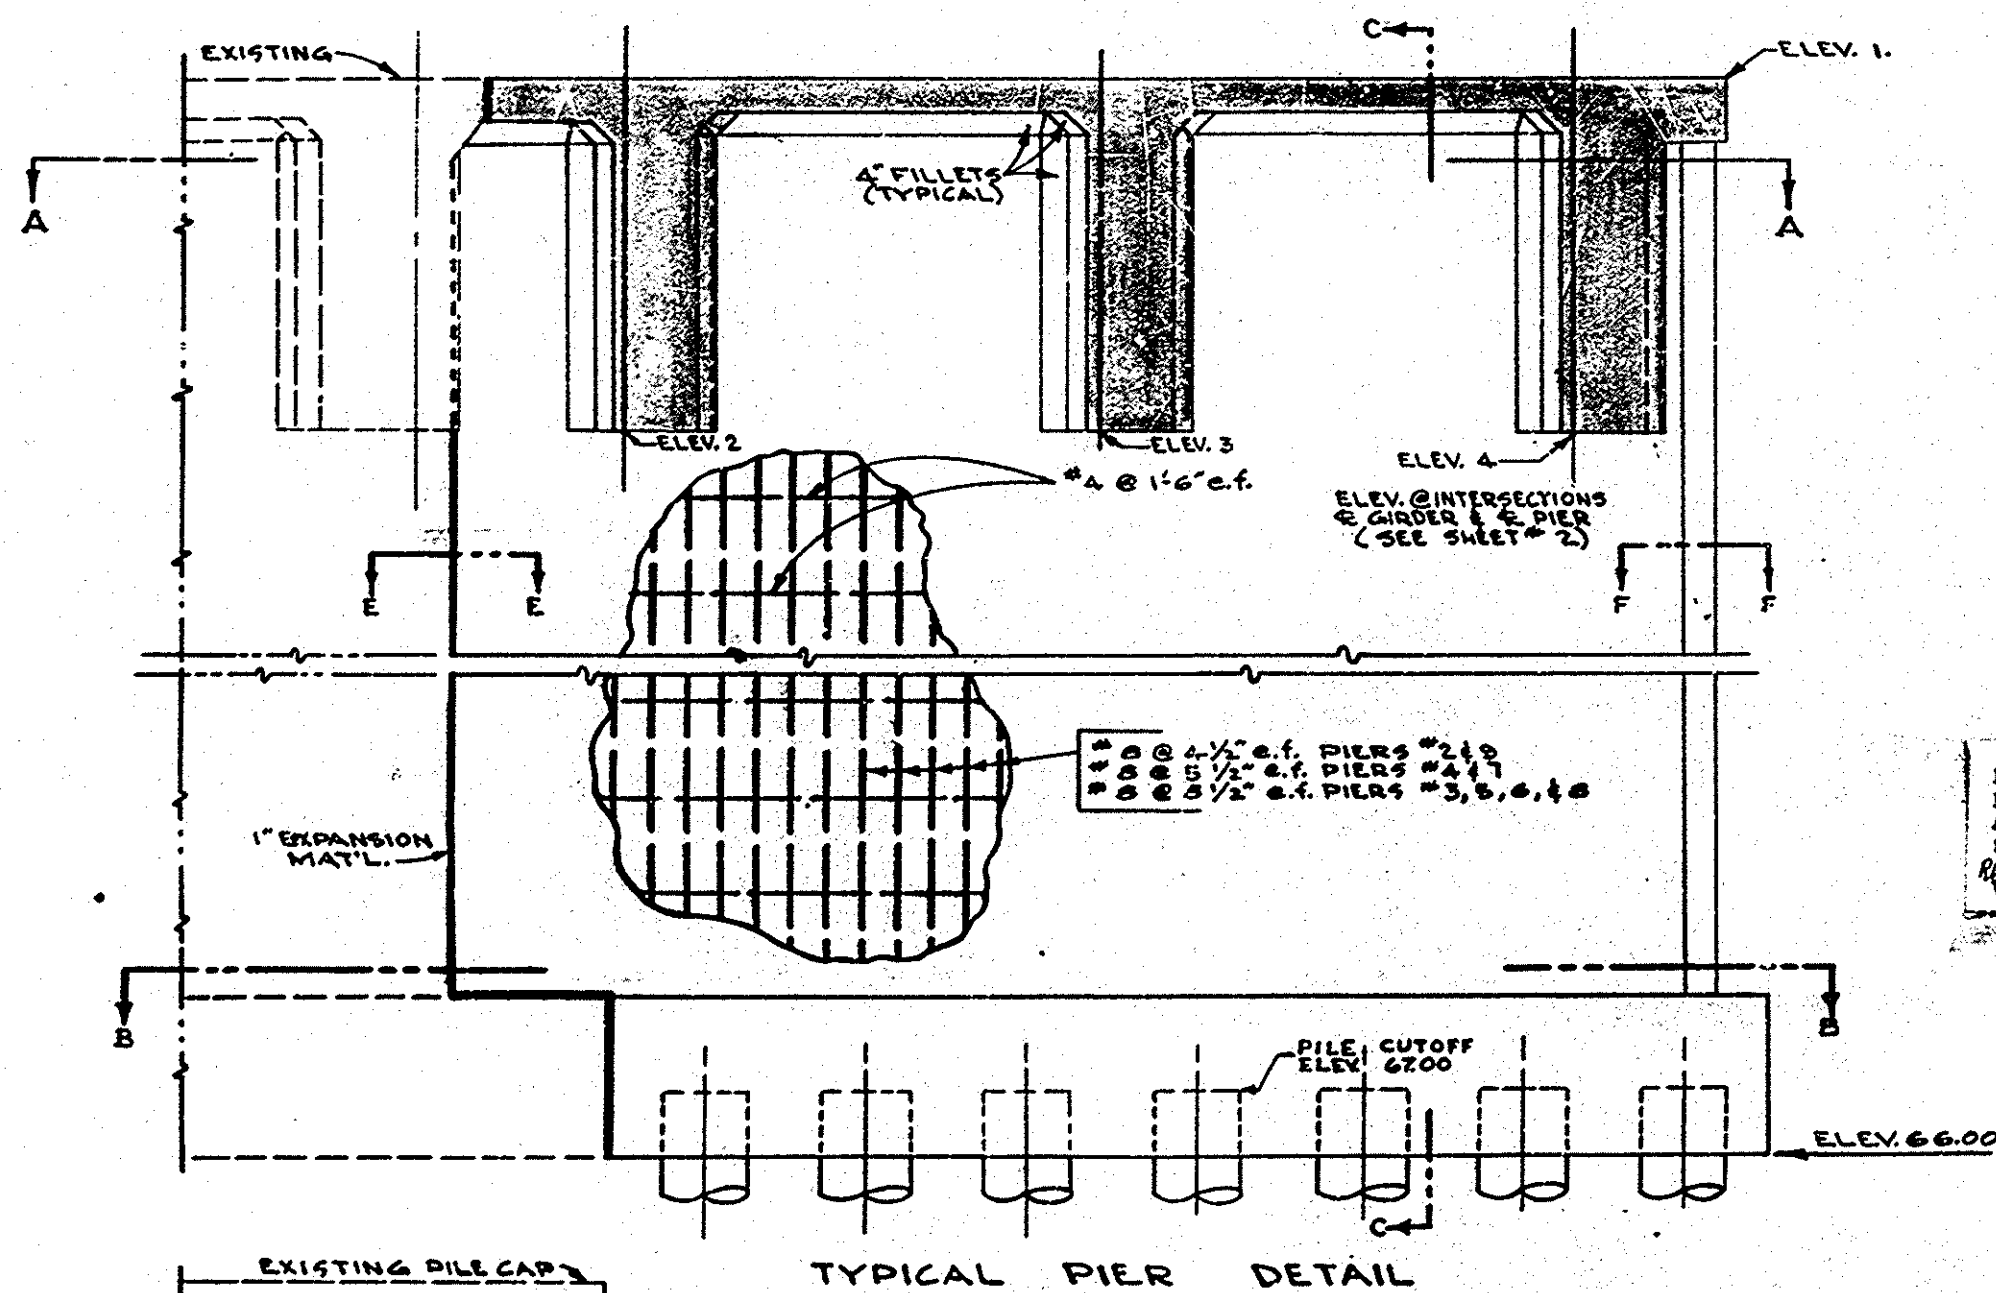
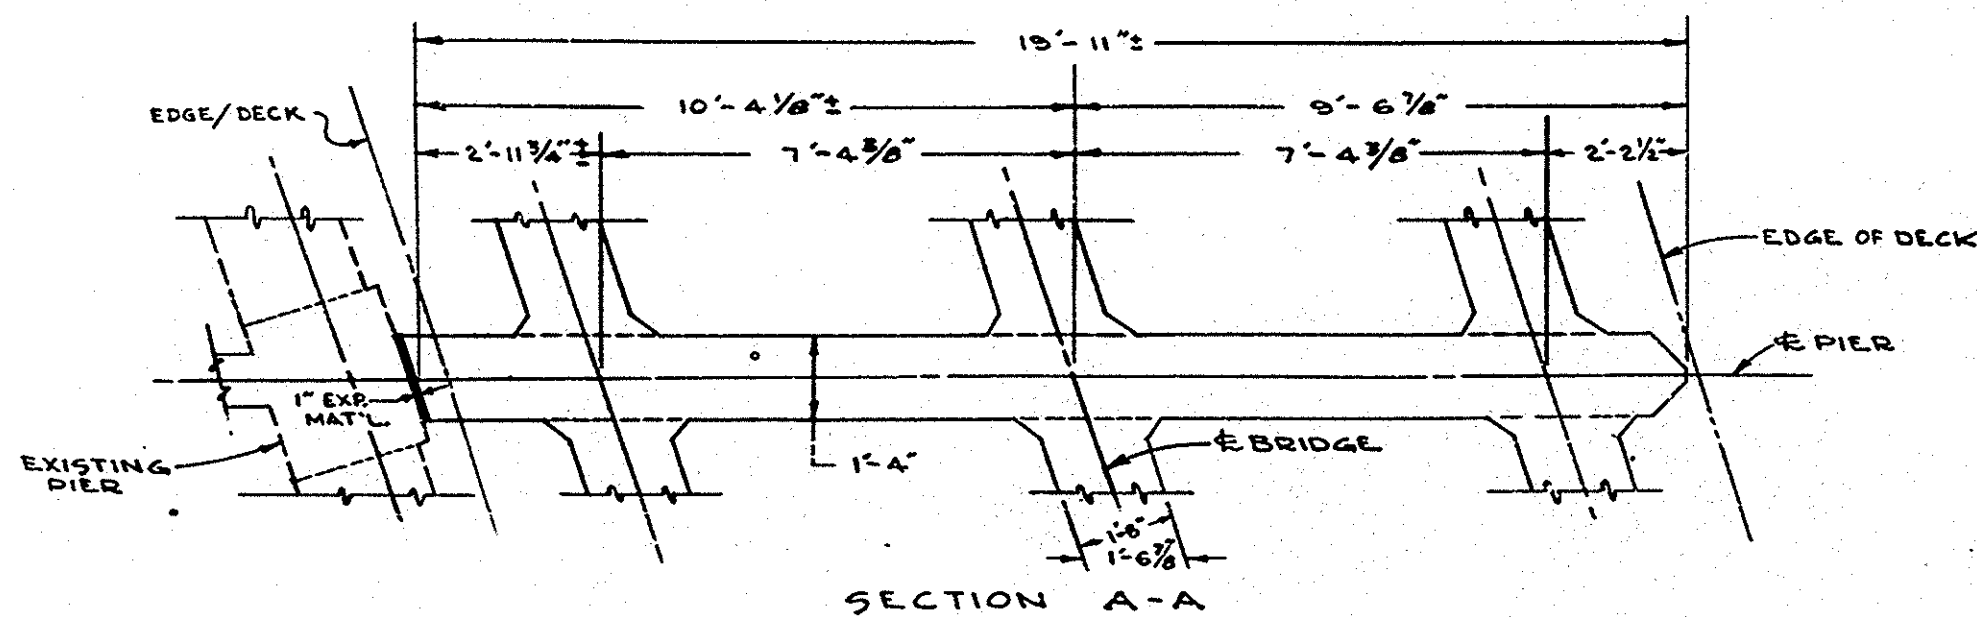
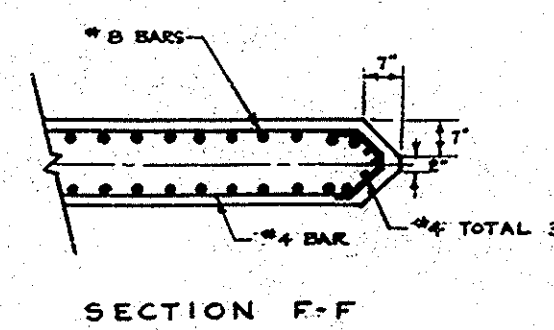
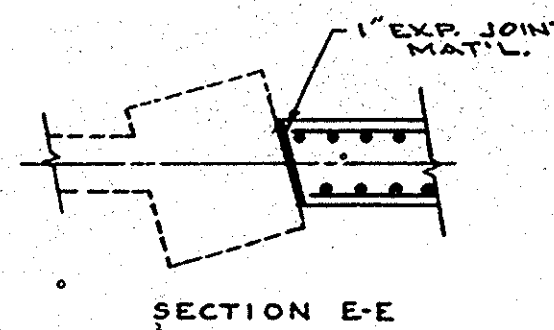


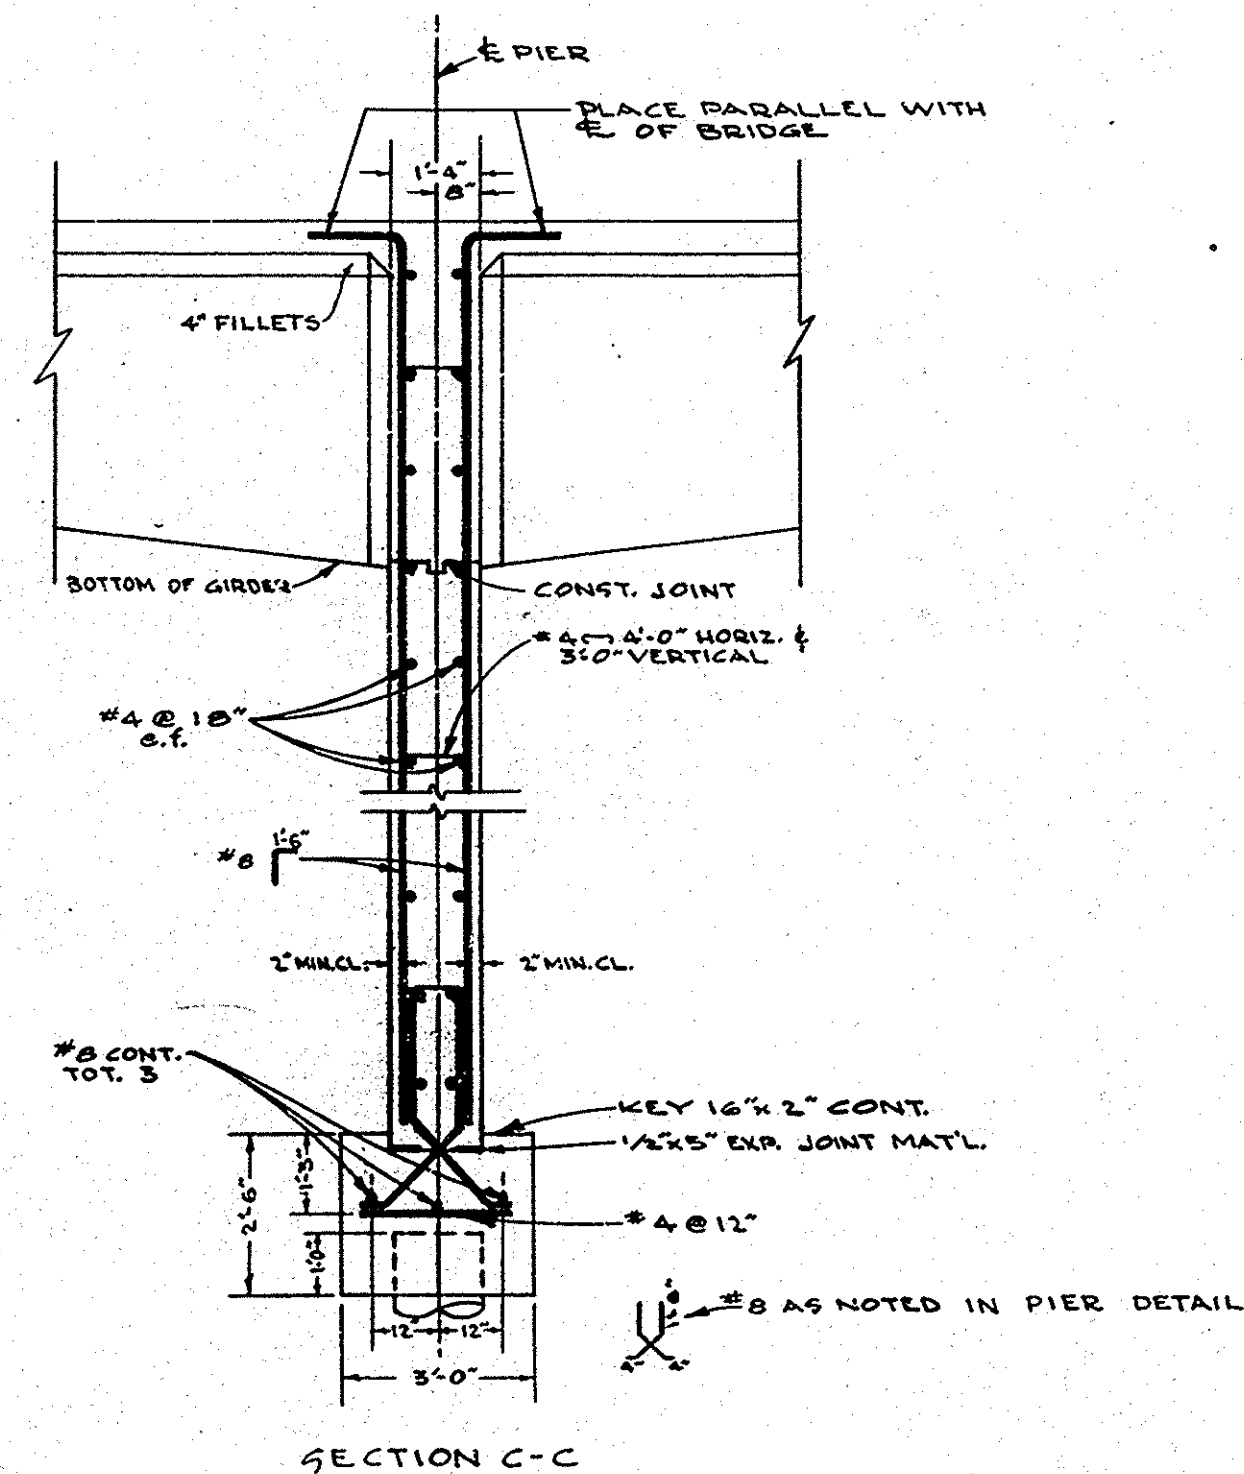

Bridge #SA-26
Bolsa Ave. Bridge
Across Santa Ana River
Sheet 5 of 22
Scale 1/2" = 1'-0"
Vellum-Pencil sketch

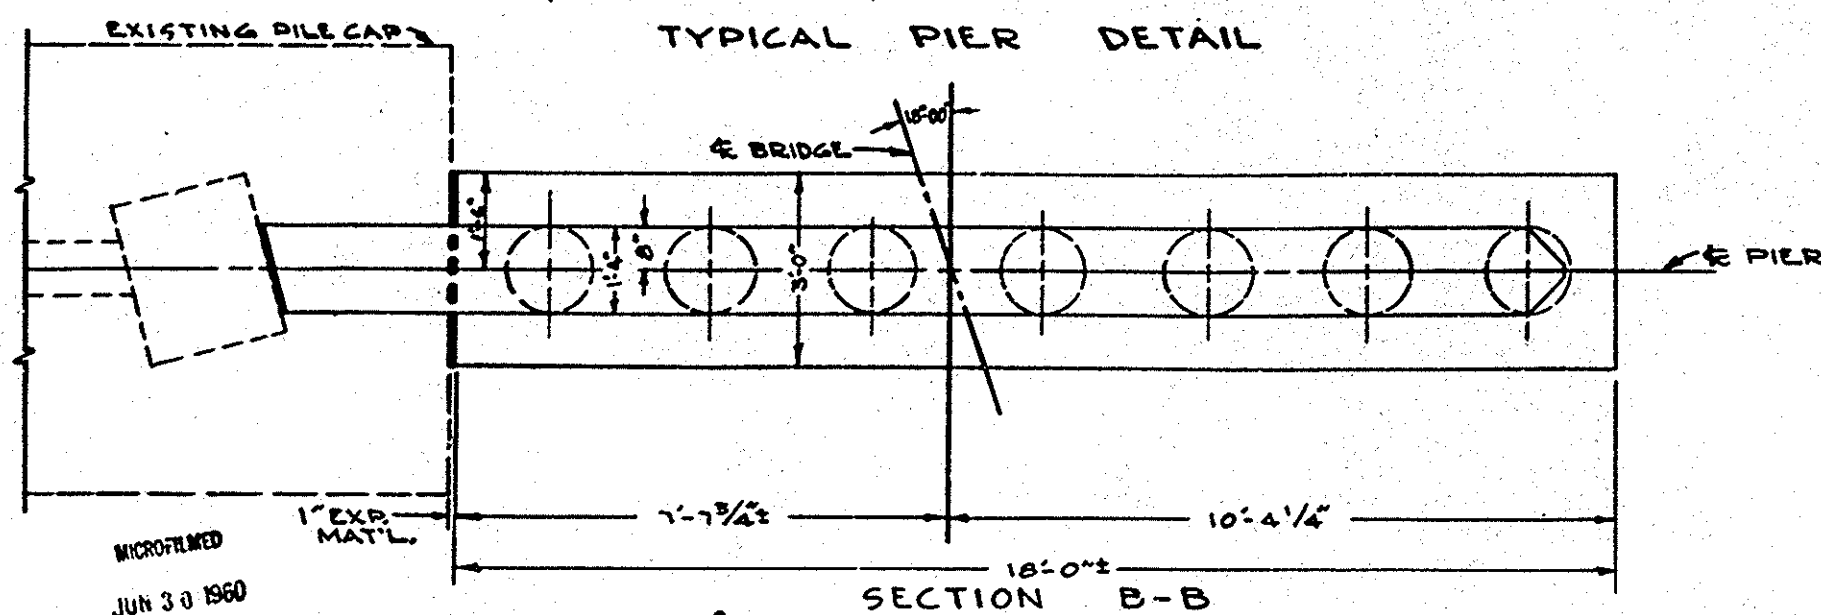

ORANGE COUNTY HIGHWAY DEPARTMENT	
BOLSA AVE. BRIDGE	
ACROSS SANTA ANA RIVER	
PIER DETAIL	
SCALE: 1/2" = 1'-0"	SHEET 5 OF 22

SA-26

MICROFILMED
JUN 30 1960