



BRIDGE DEPARTMENT

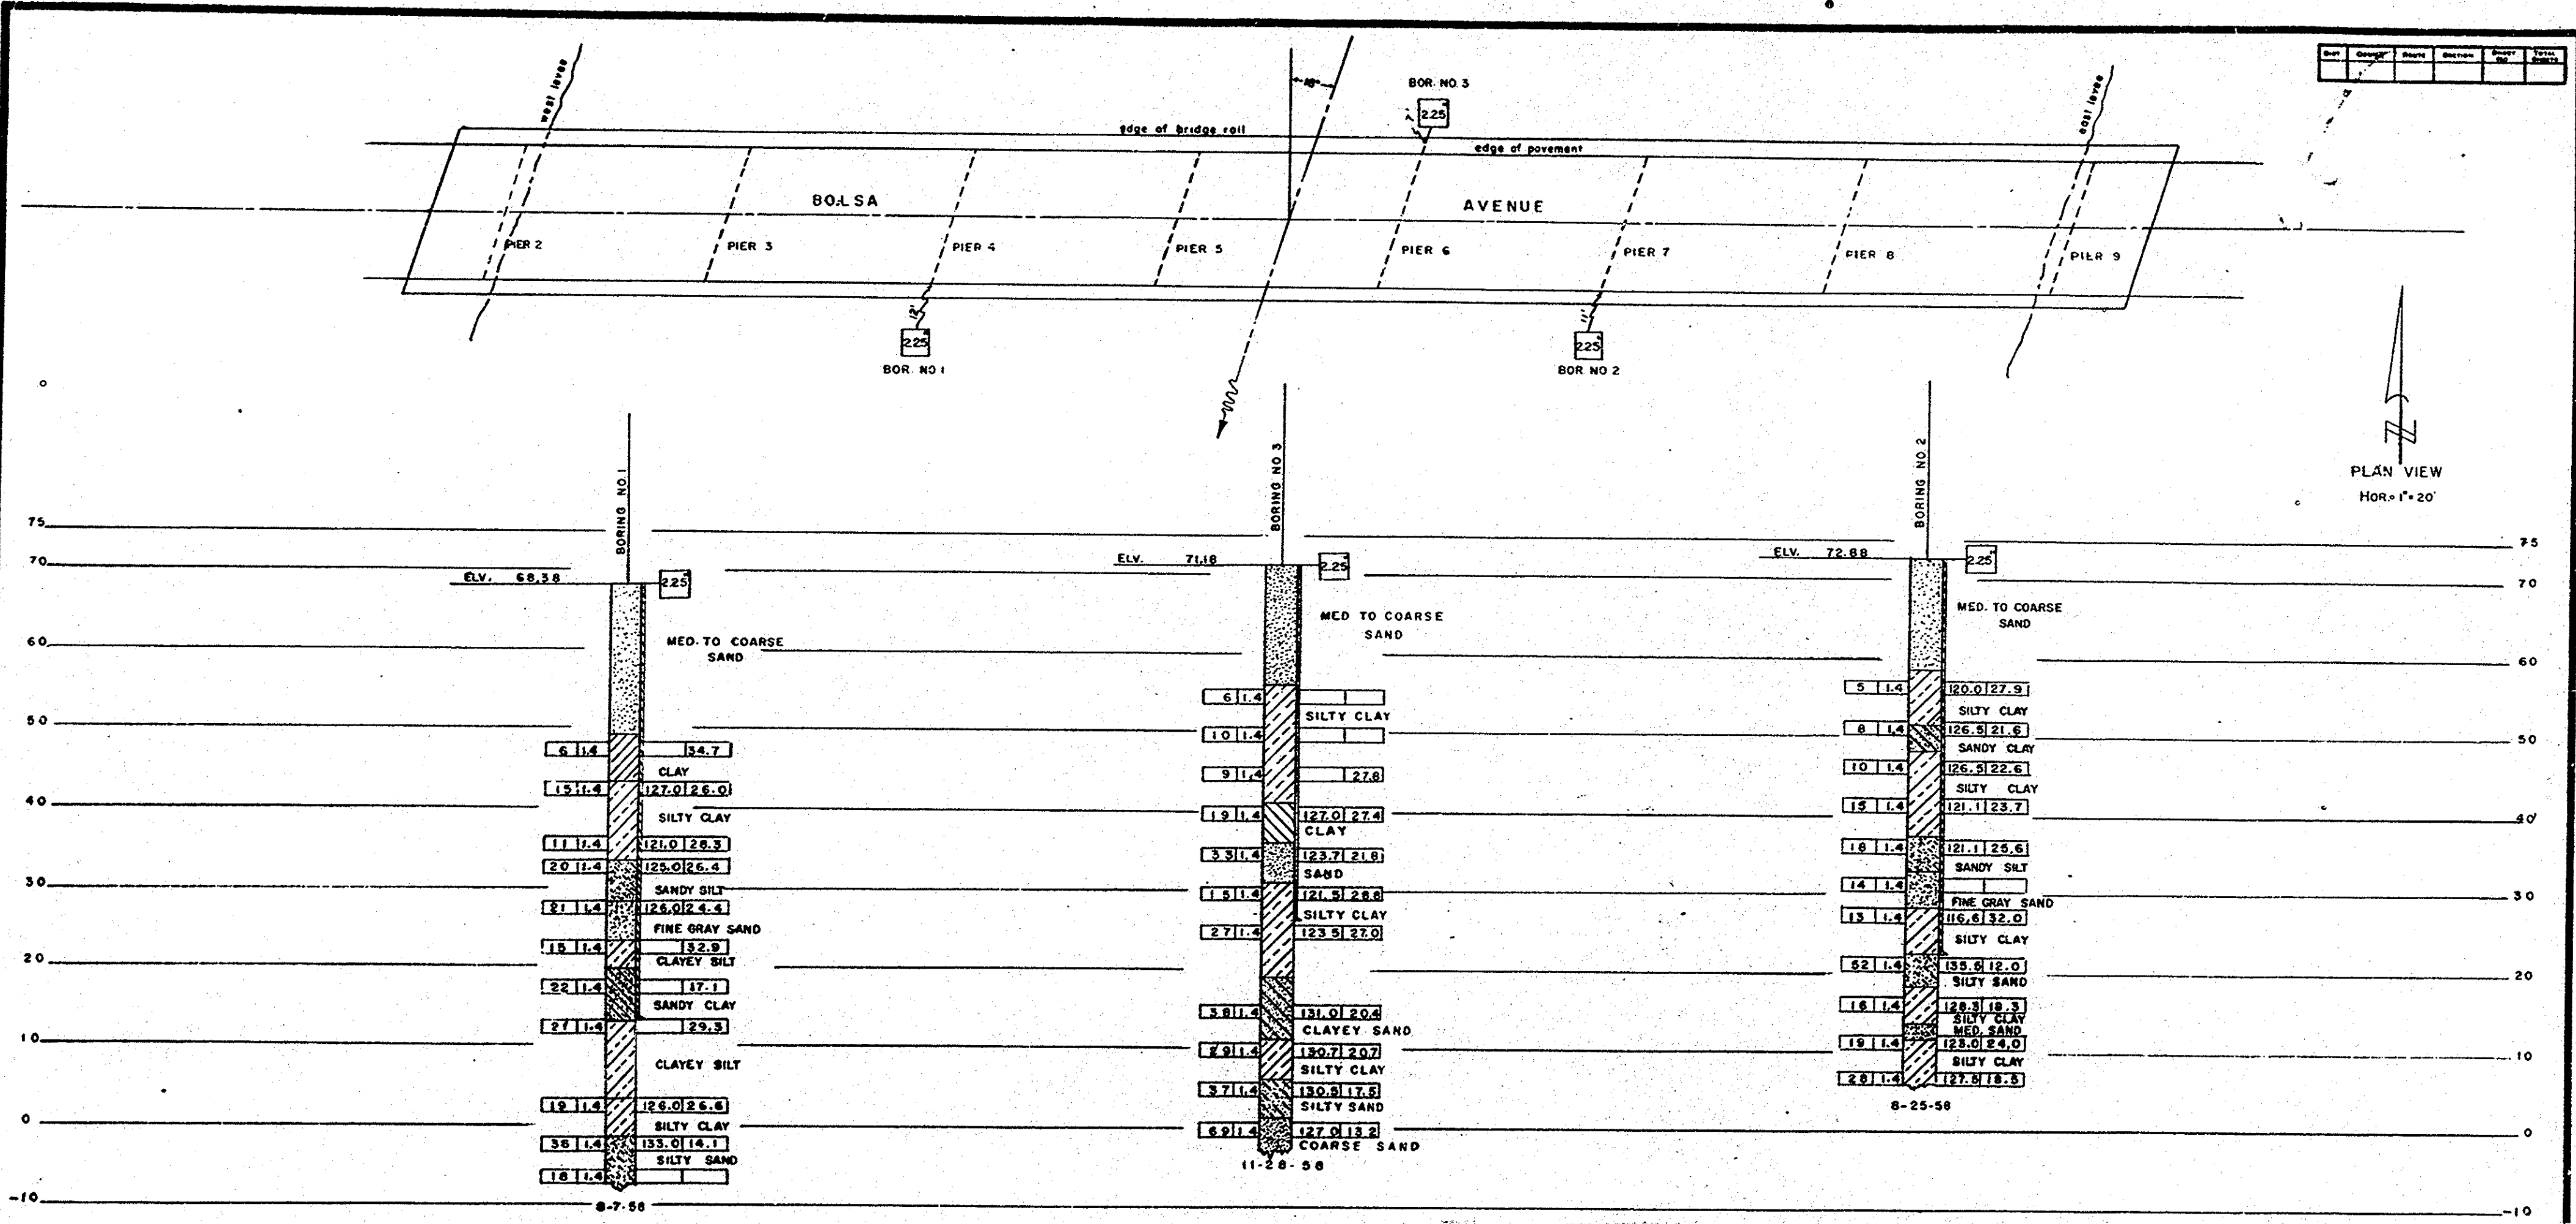


Bridge #24-26
Bolsa Ave. Bridge
Across Santa Ana River
Sheet 9 of 22
Elev. 22.5' Scale 1"=20'
Blackline Print

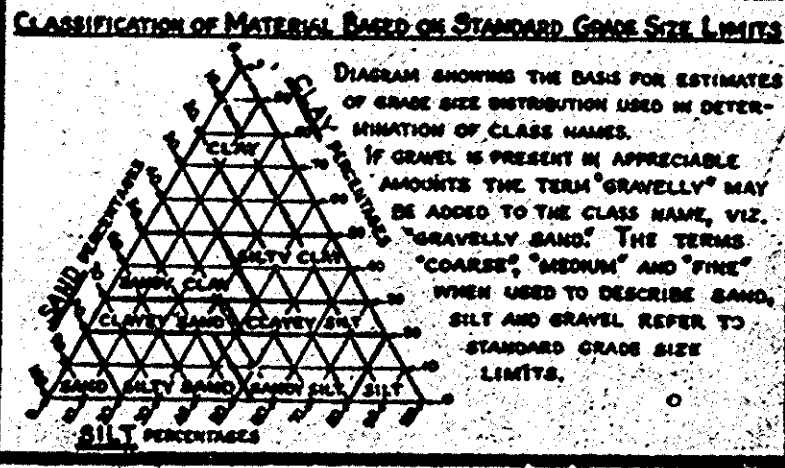

LEGEND OF EARTH MATERIALS

GRAVEL	SILTY CLAY OR CLAYEY SILT
SAND	PEAT AND/OR ORGANIC MATTER
SILT	FILL MATERIAL
CLAY	IGNEOUS ROCK
SANDY CLAY OR CLAYEY SAND	SEDIMENTARY ROCK
SANDY SILT OR SILTY SAND	METAMORPHIC ROCK

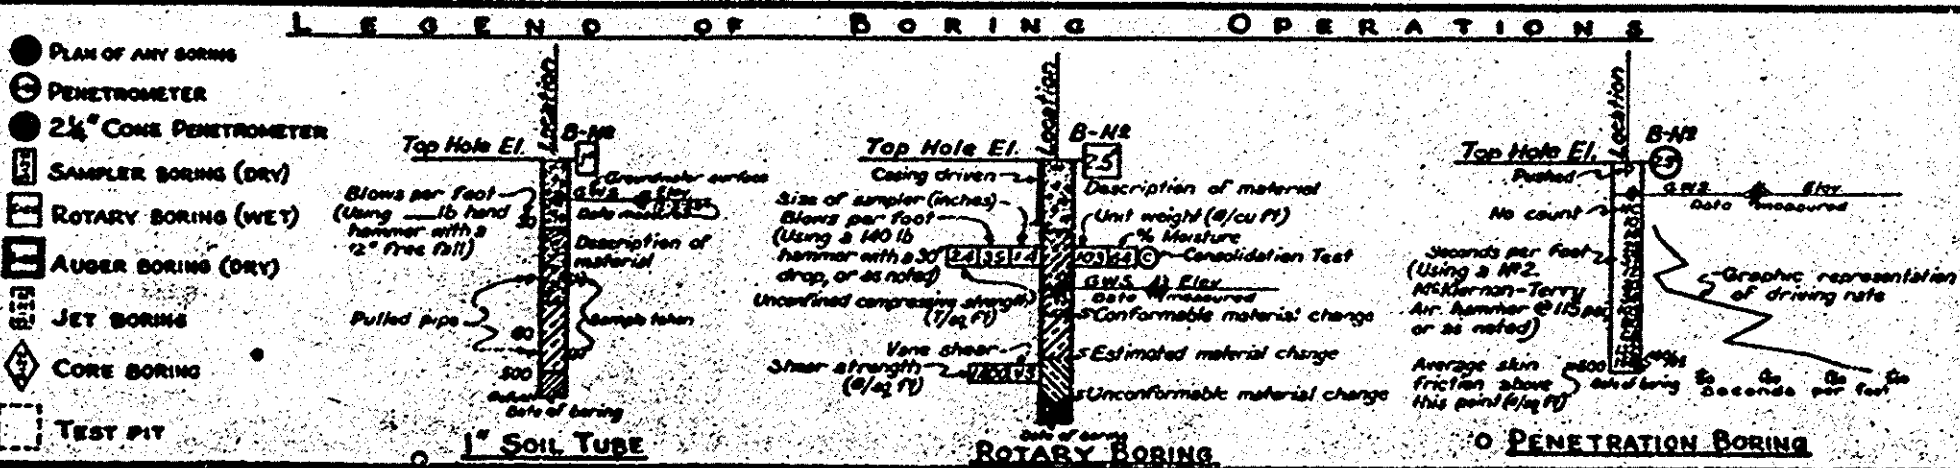

NOTES

The contractor's attention is directed to Section 2, Article (c) of the Standard Specifications and to the Special Provisions accompanying this set of plans. Classification of earth material as shown on this sheet is based upon field mechanical analysis.

**BOLSA AVENUE BRIDGE
ACROSS
SANTA ANA RIVER
LOG OF TEST BORINGS**

BORING NO.	FILE	DRAWING	DATE
24-26	SA-26	1E	J.P.

REPRODUCED
JUN 30 1960