
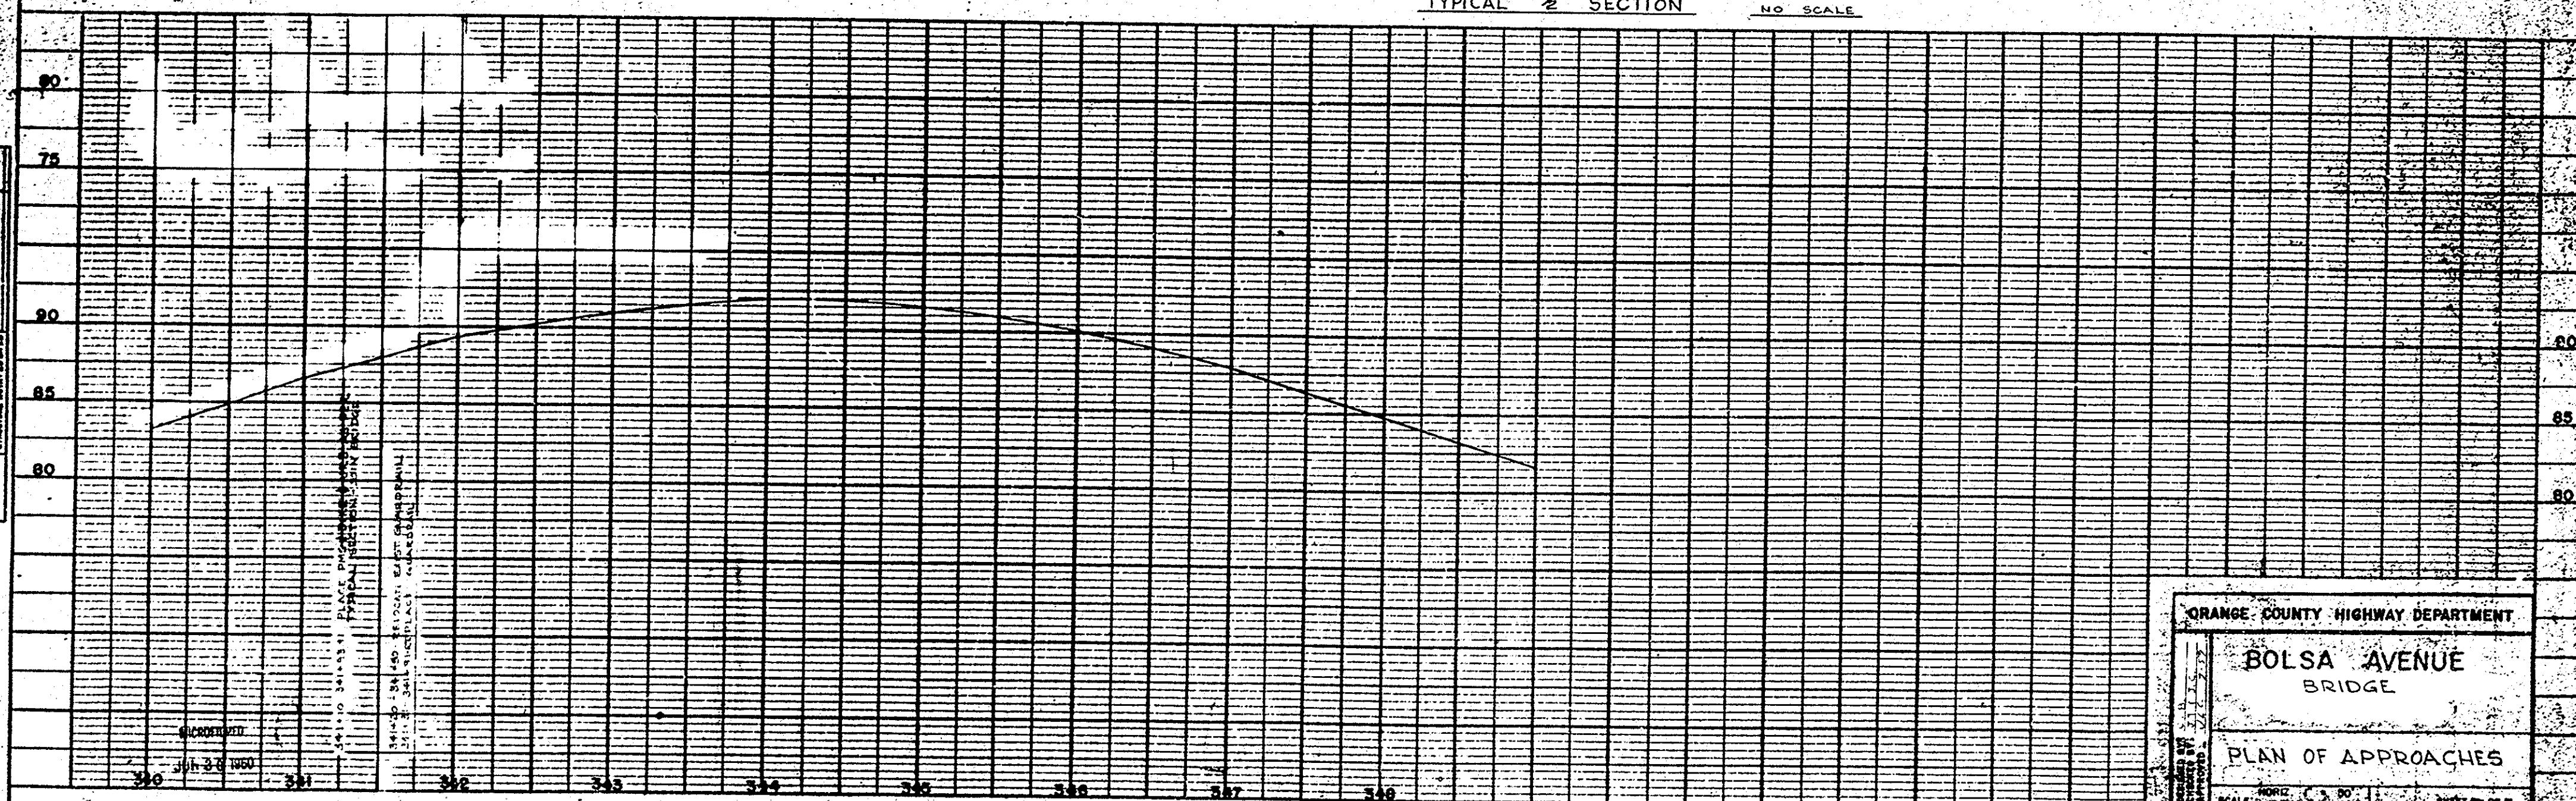


PLAN
NOTES
1. ALL DIMENSIONS IN FEET UNLESS OTHERWISE NOTED.
2. SEE SHEET 12 OF 22 FOR BRIDGE DETAILS.
3. SEE SHEET 13 OF 22 FOR ELEVATION DATA.

PROFILE
NOTES
1. ALL DIMENSIONS IN FEET UNLESS OTHERWISE NOTED.
2. SEE SHEET 12 OF 22 FOR BRIDGE DETAILS.
3. SEE SHEET 13 OF 22 FOR ELEVATION DATA.

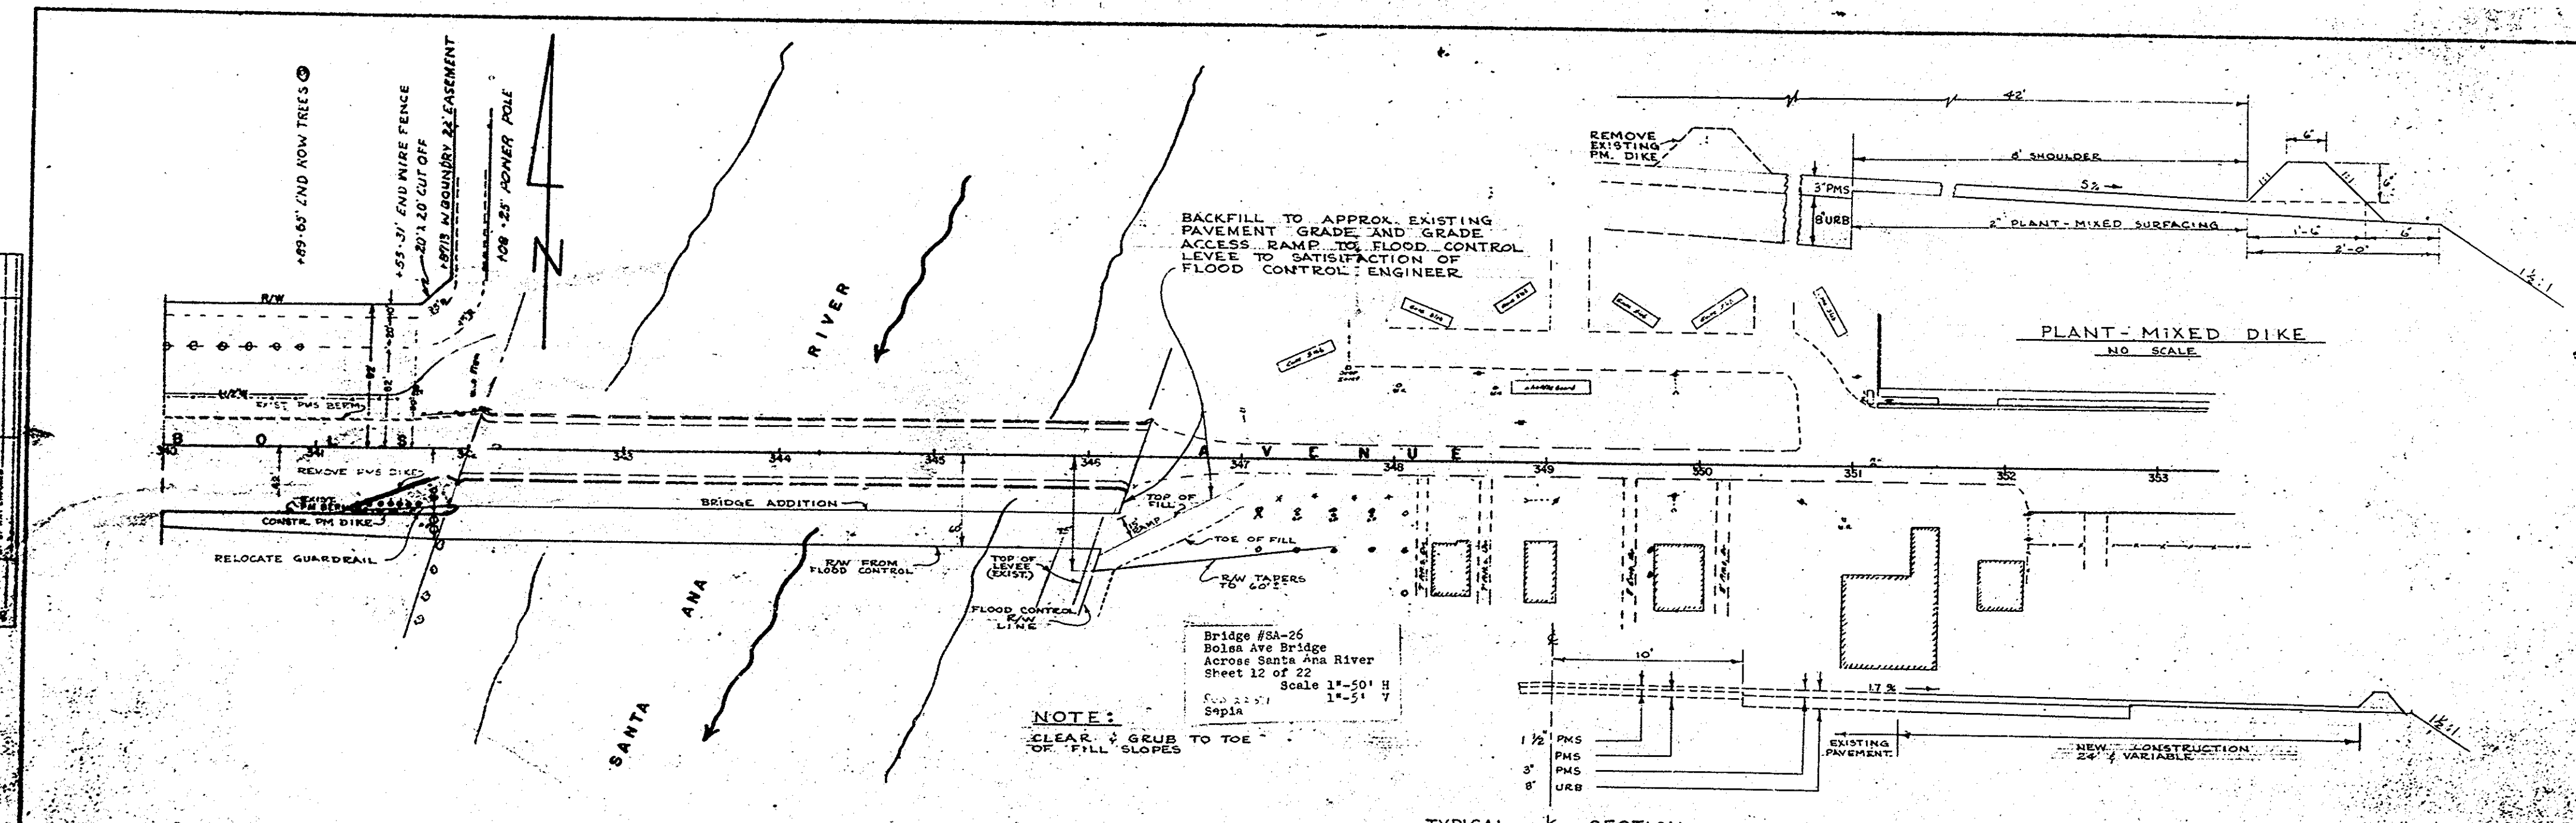

ORANGE COUNTY HIGHWAY DEPARTMENT

**BOLSA AVENUE
BRIDGE**

PLAN OF APPROACHES

SCALE: 1" = 50' H, 1" = 5' V

SHEET 12 OF 22