


14 15 16 17 18


19 20 21 22 23 24 25 26 27 28 29 30 31 32 33 34 35 36 37 38 39 40 41 42 43

44 45 46 47 48


BOLSA AVE
EAST APPROACH
FILL SLOPES FROM
TOPO NOTES
SCALE 1"=51'

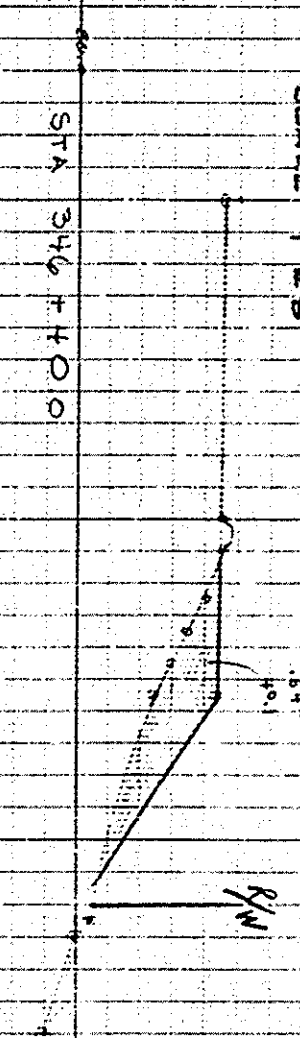

STA 346+10.0

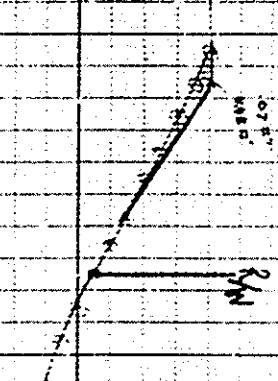

STA 346+50

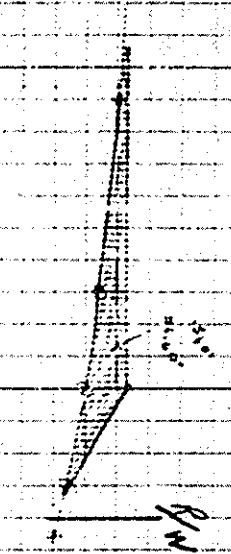

STA 346+22

SLOPE FILL — $(64-40) \times \frac{1}{2} \times (44.6) = 446 \text{ ft}^2$
 $(40-22) \times \frac{1}{2} \times (74.6) = 672 \text{ ft}^2$
 $(8) \times \frac{1}{2} \times (34.6) = 139$
1257 ft² or 46.6 cu yds.

Bridge #SA-26
Bolsa Ave. Bridge
Across Santa Ana River
Sheet 13 of 22
R.D. 22-57 Scale 1"=8'
X-sect.

MICROFILMED
JUN 30 1960

Sheet 13 of 22
SA-26