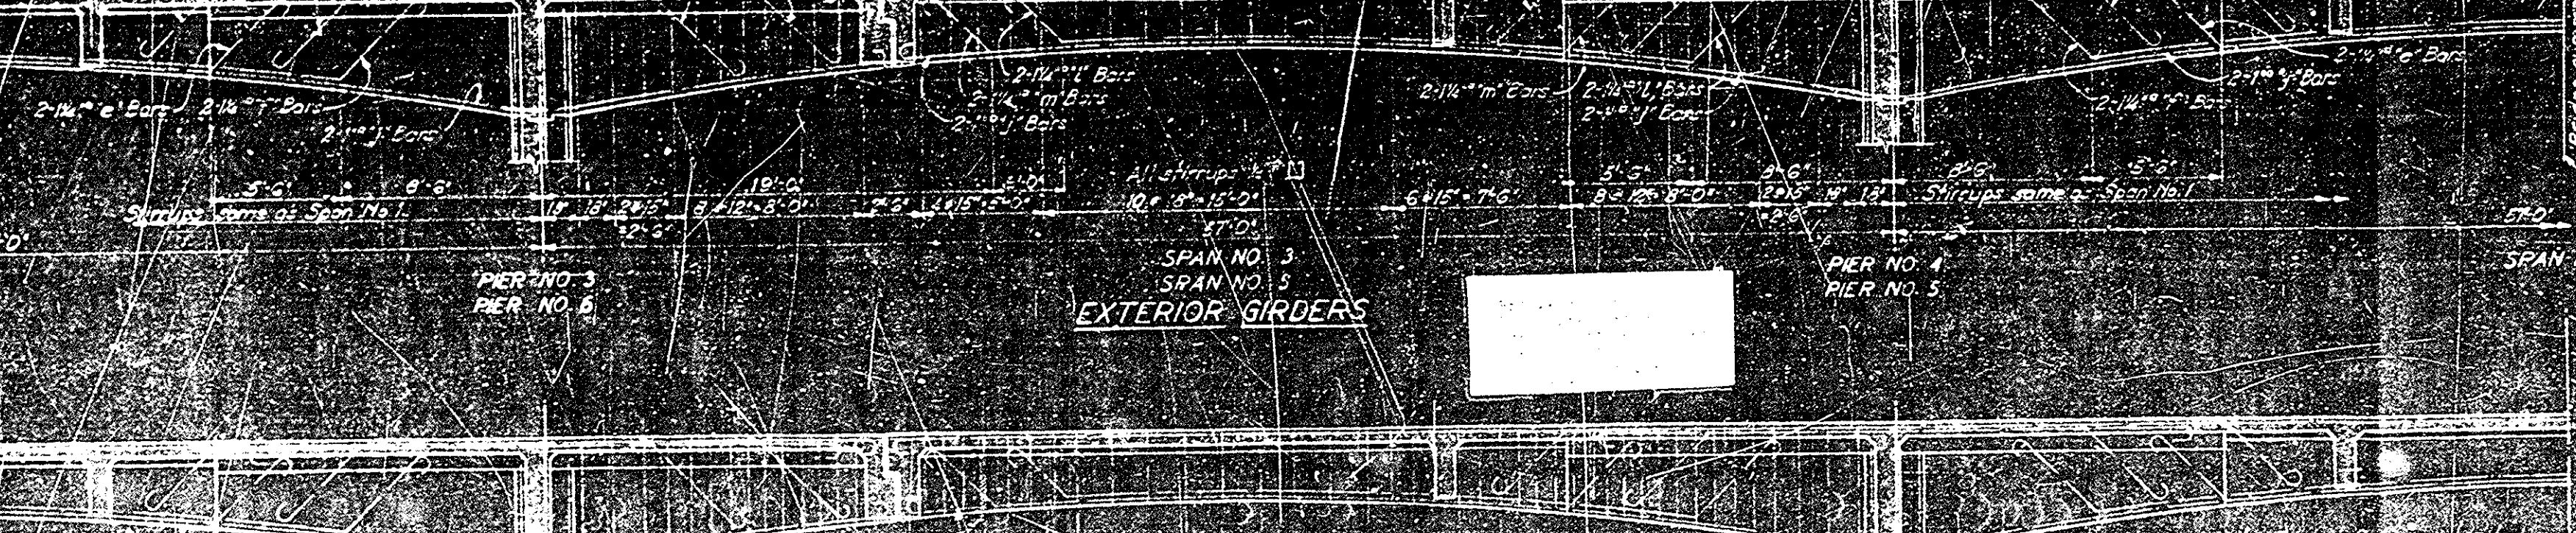
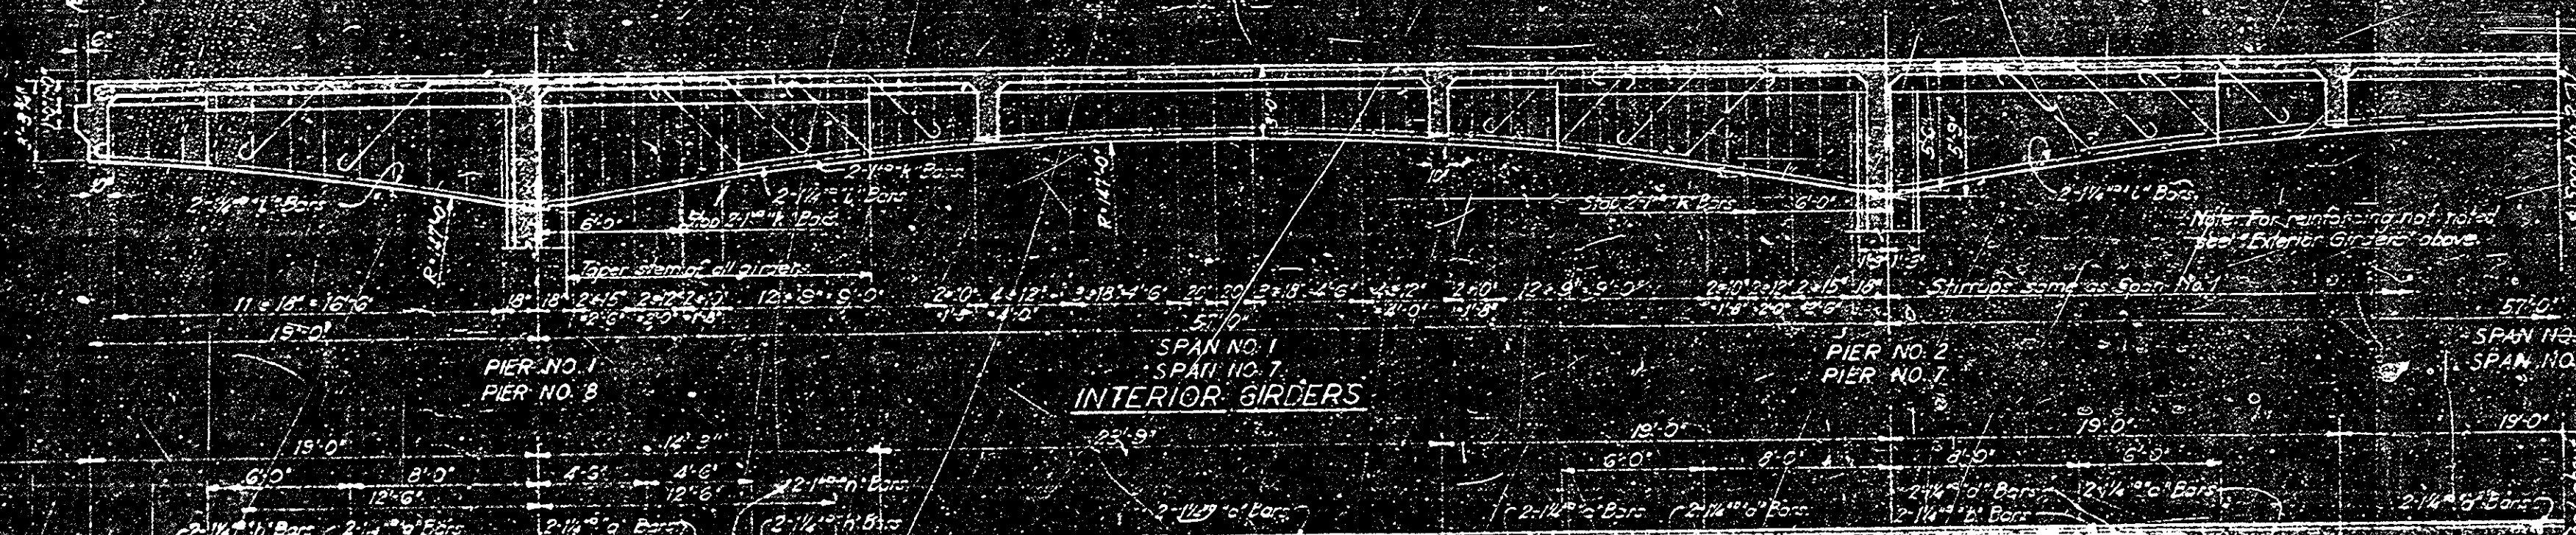
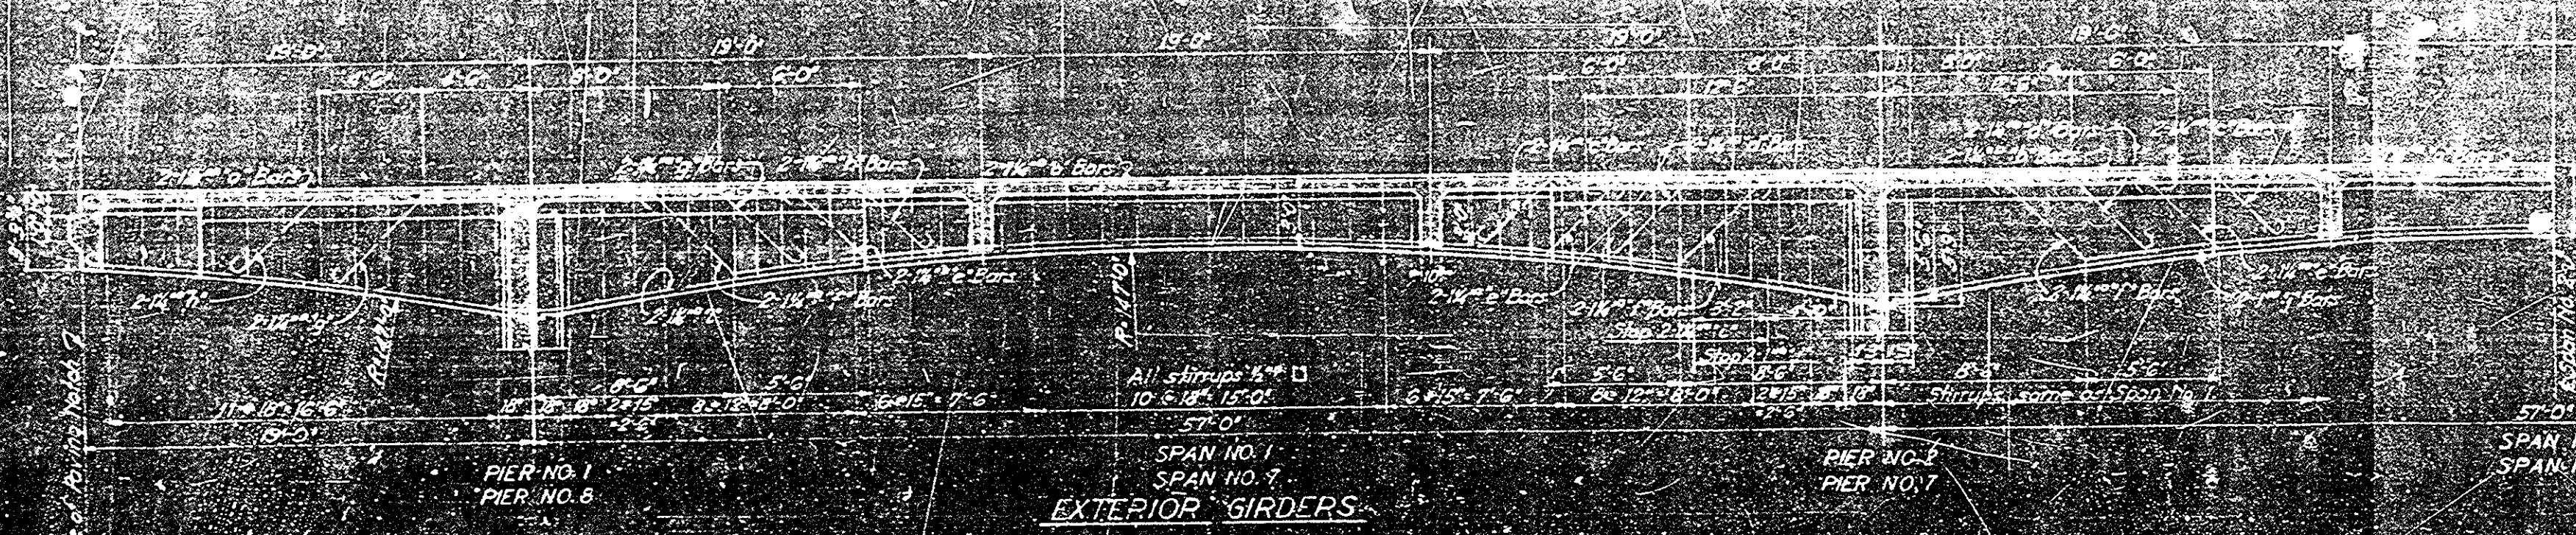


V-12-16
BRIDGE ACROSS SANTA ANA RIVER
GIRDER DETAILS