



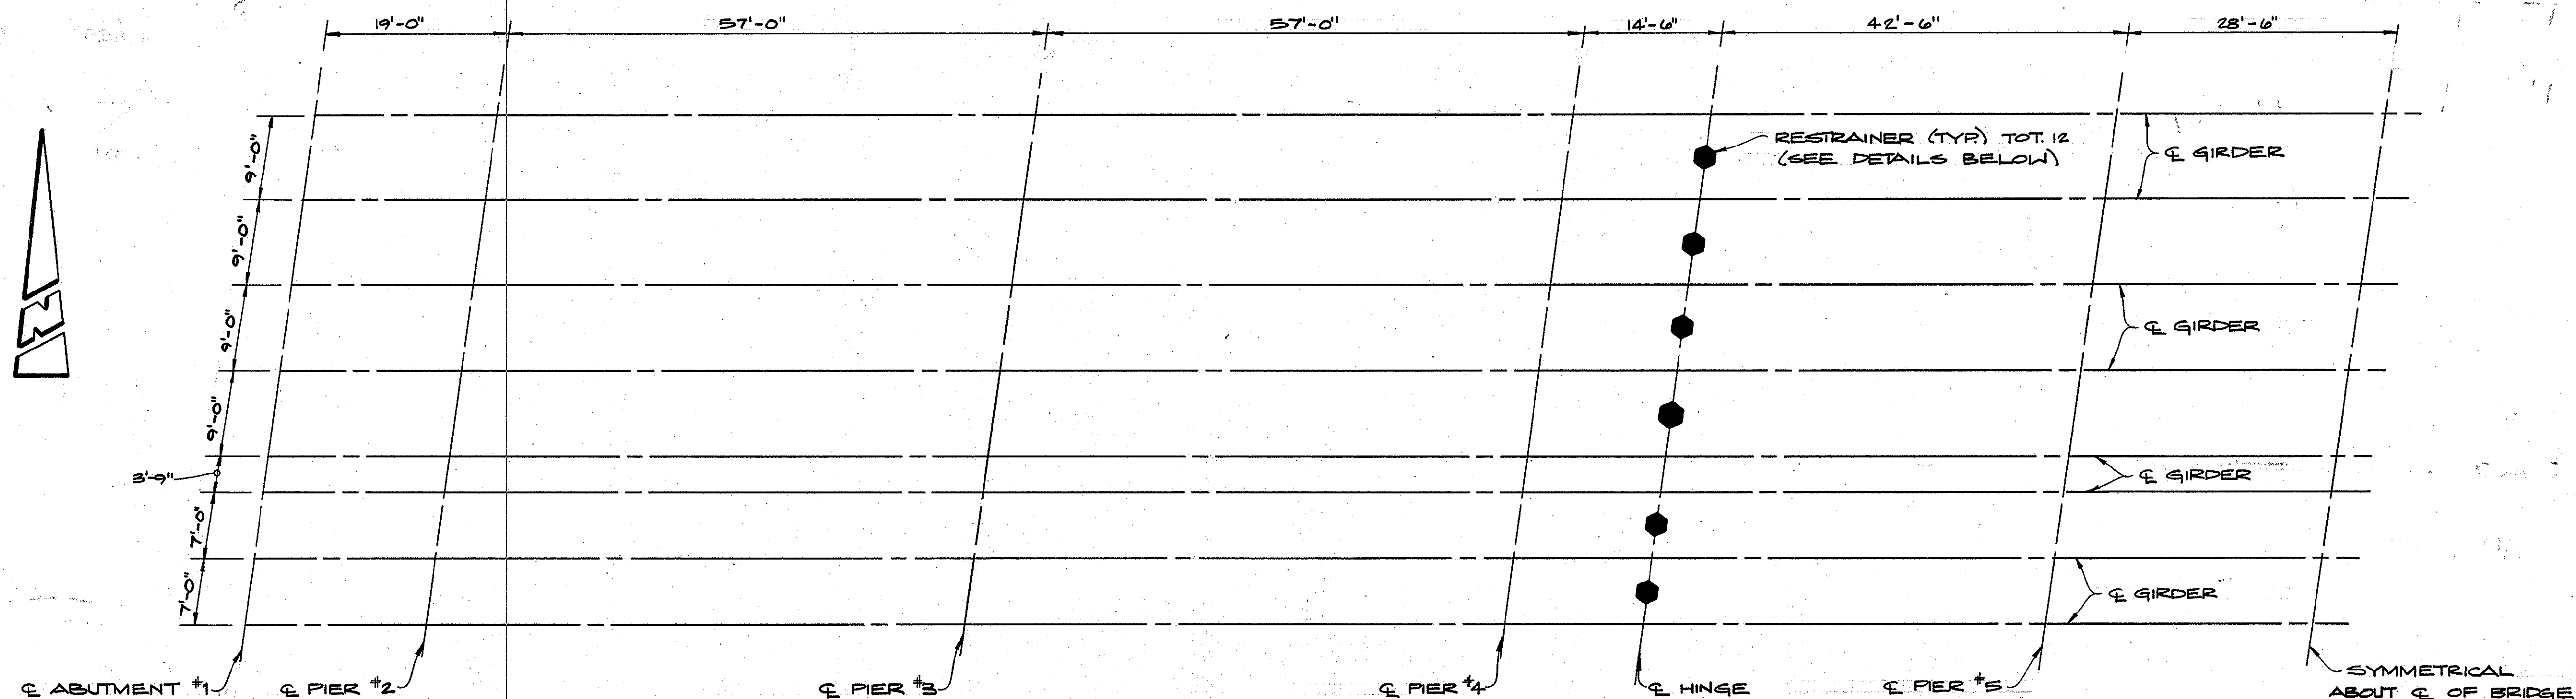

RESTRAINER LAYOUT


SCALE: 1"=10'

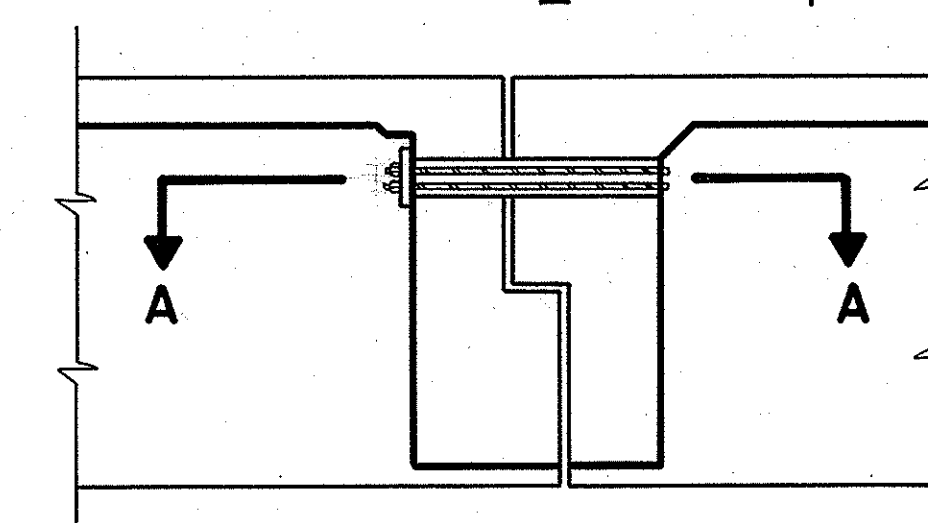

SECTION THRU RESTRAINER UNIT


NO SCALE

1/2 0 2
3 inches on original drawing

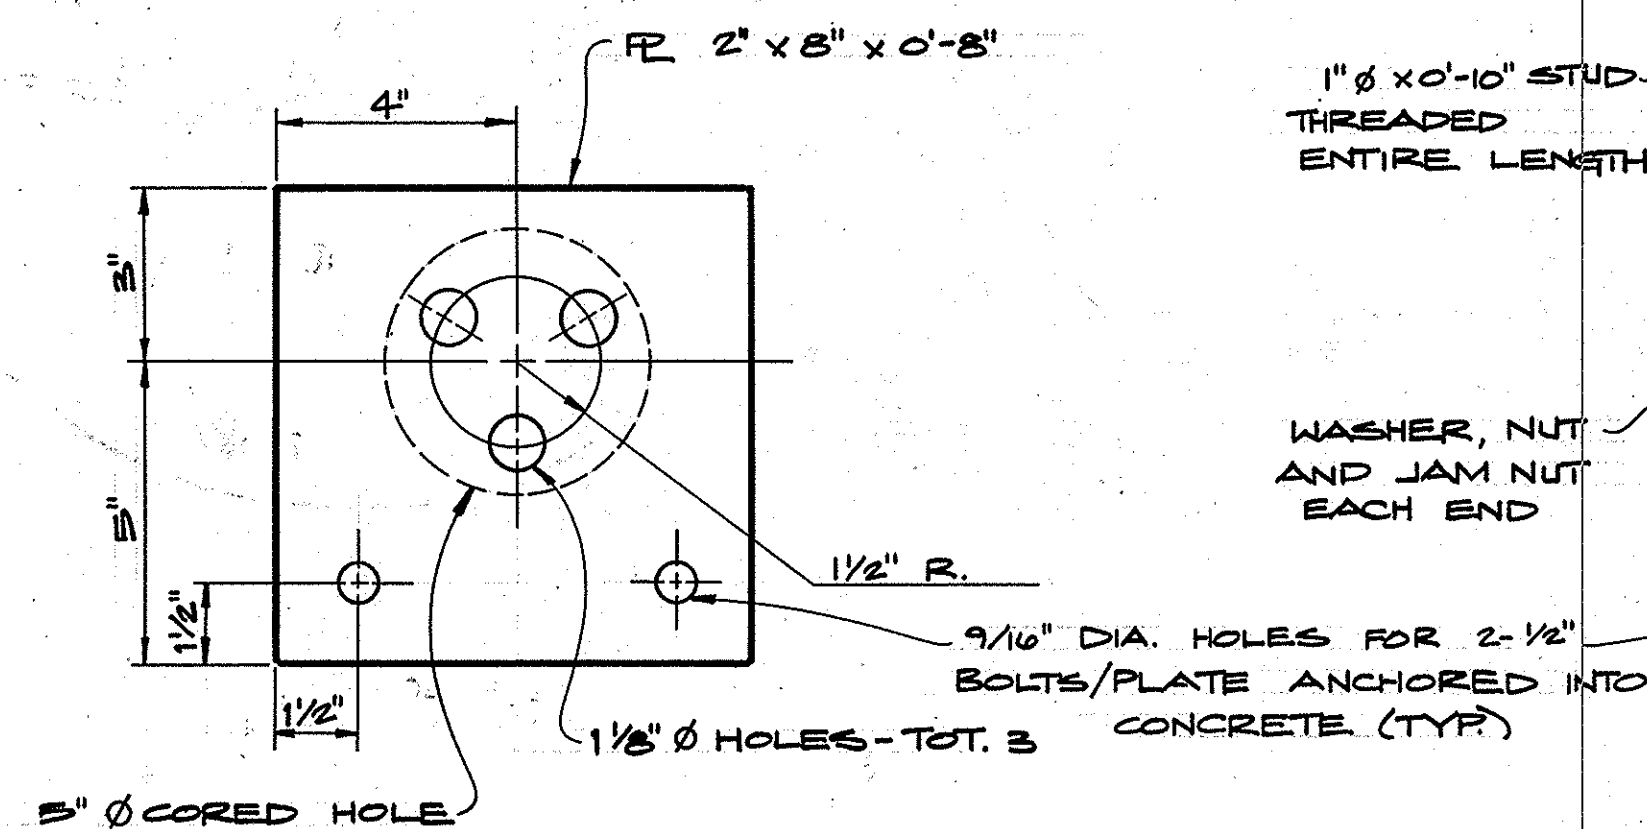


BEARING PLATE DETAIL

NO SCALE

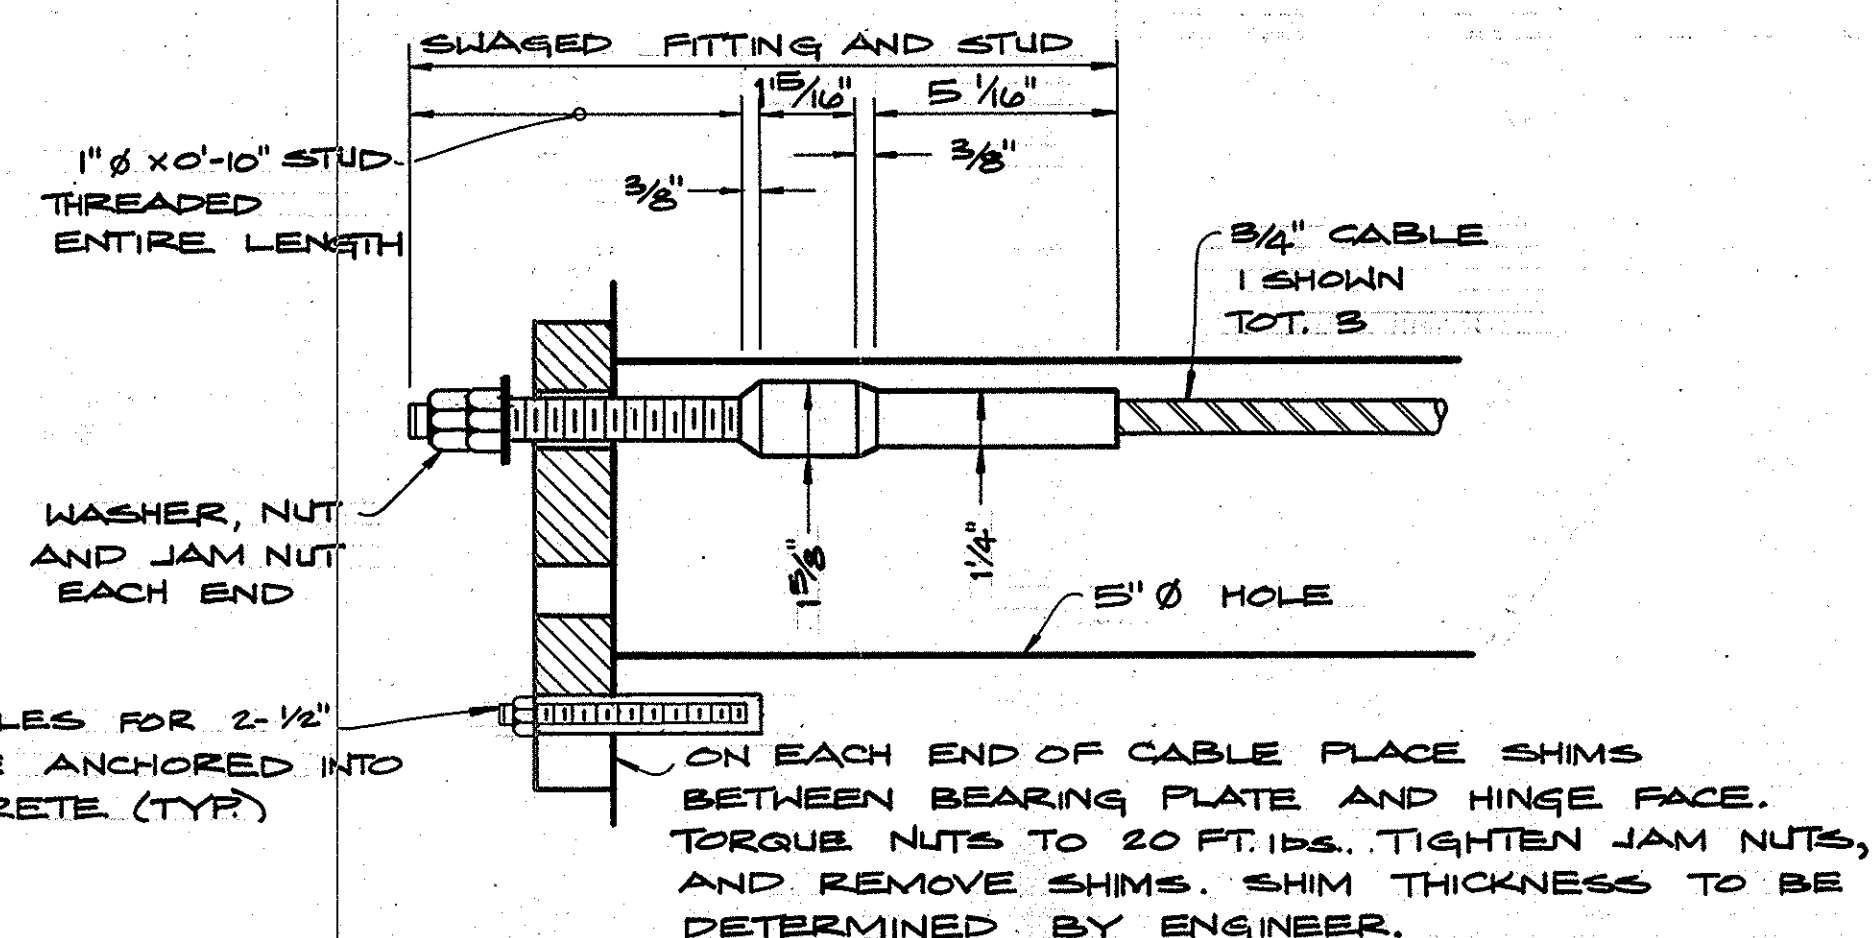

CABLE END ANCHORAGE

NO SCALE

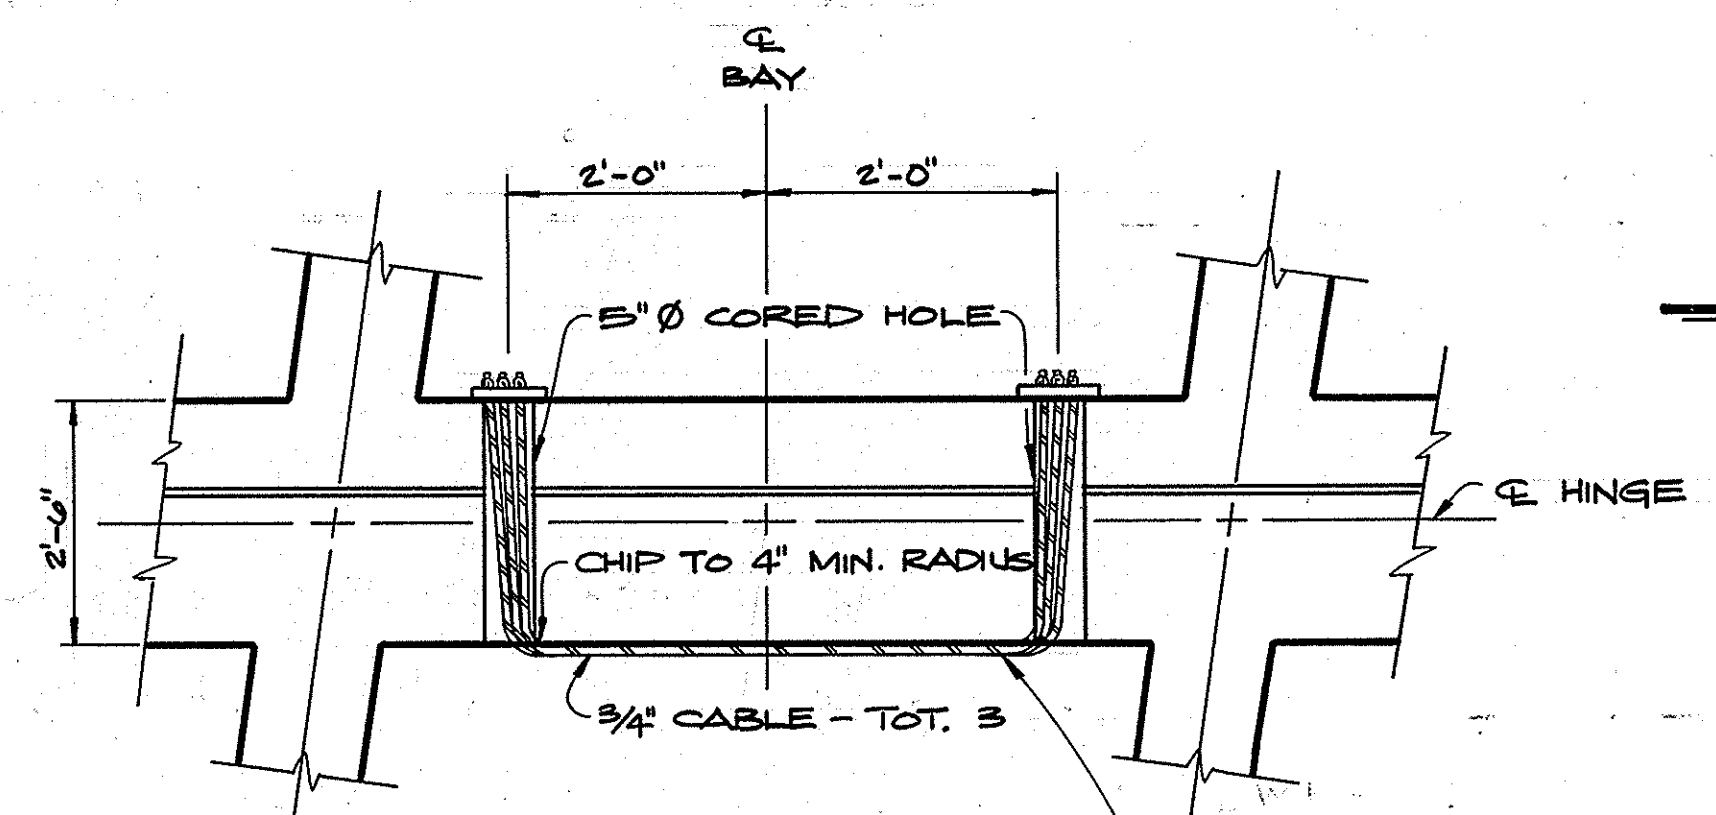

SECTION "A-A"

NO SCALE

ORANGE COUNTY ENVIRONMENTAL MANAGEMENT AGENCY			
SEISMIC RETROFIT			
BOLSA AVE. BRIDGE			
at			
SANTA ANA RIVER			
(SA-26 and SA-26A)			
MARK	DATE	DESCRIPTION	PREPARED UNDER SUPERVISION OF <i>Gene A. Felt</i> SHEET
REVISIONS			DATE
DESIGNED	M.M.H.	SCALE	DATE
DRAWN	P.B.	CHECKED	AS SHOWN 10/83
			DWG. NO.
			21