




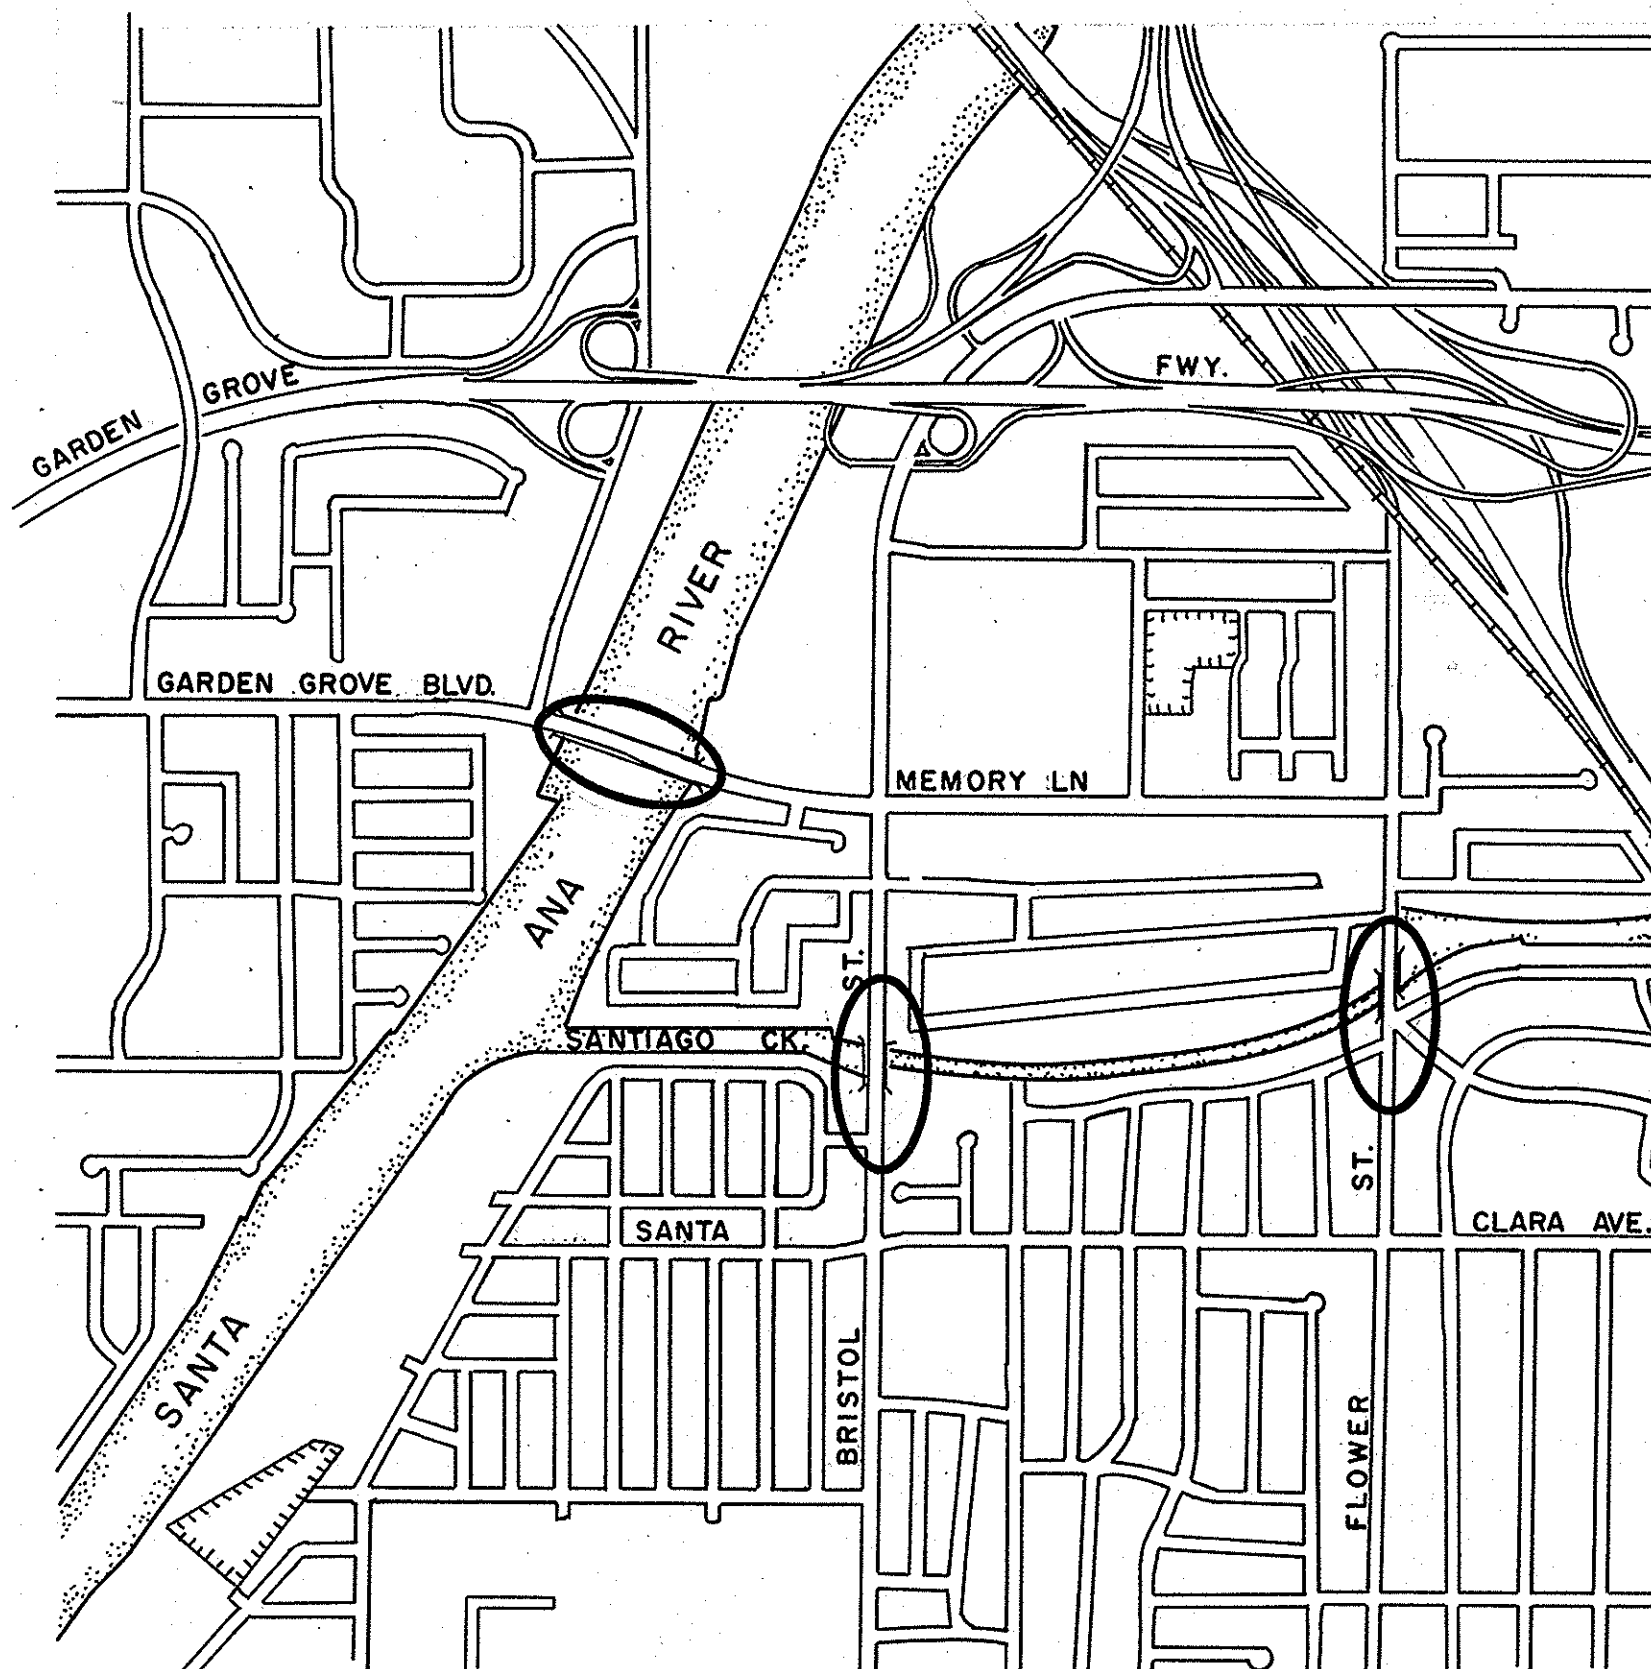


GARDEN GROVE BLVD., BRISTOL ST. AND
FLOWER ST. BRIDGES

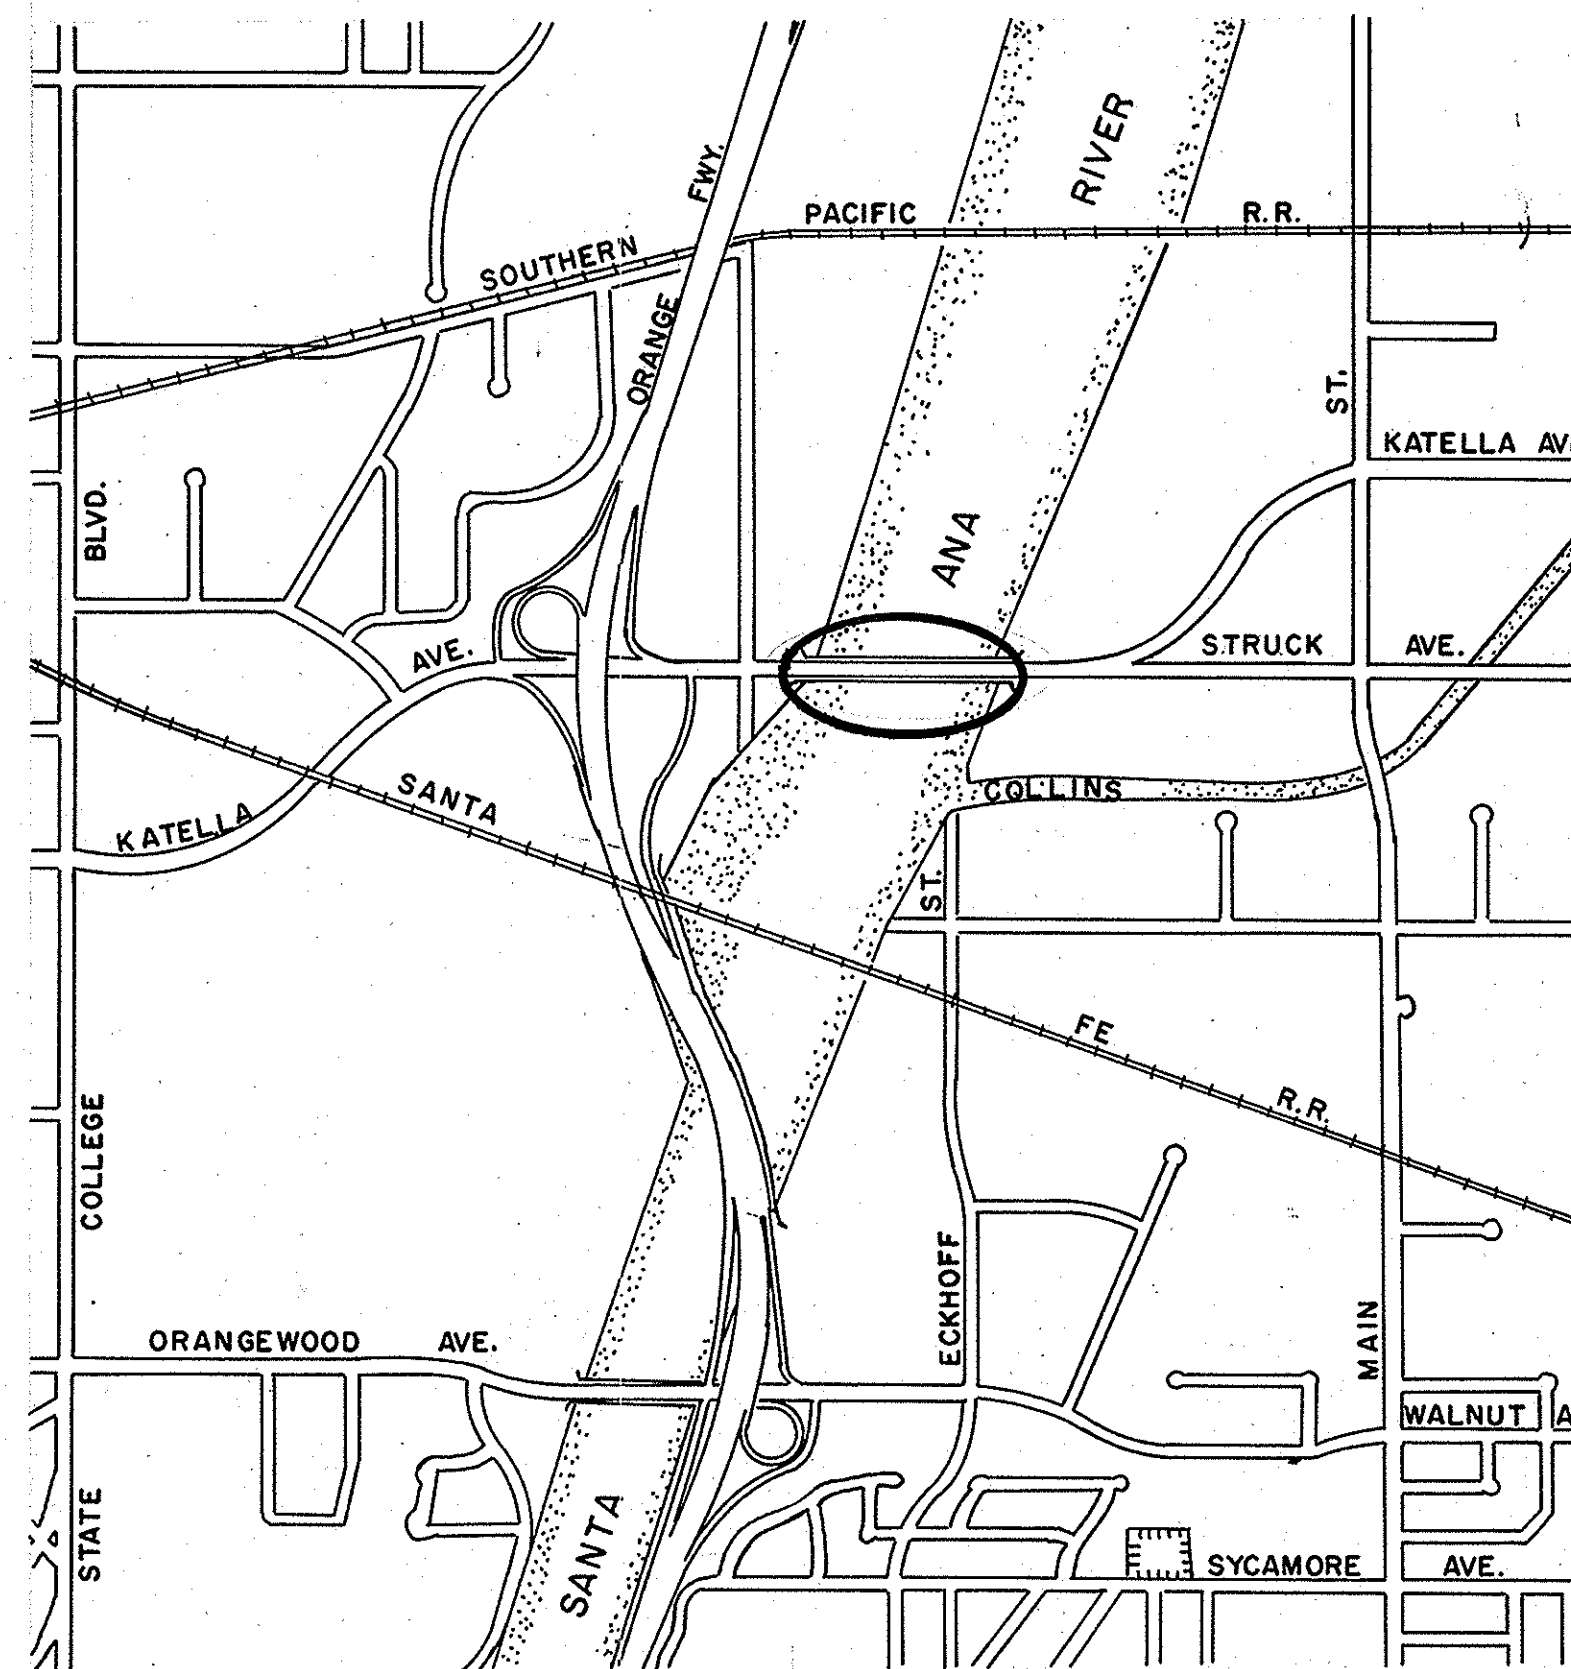


KATELLA AVENUE BRIDGE

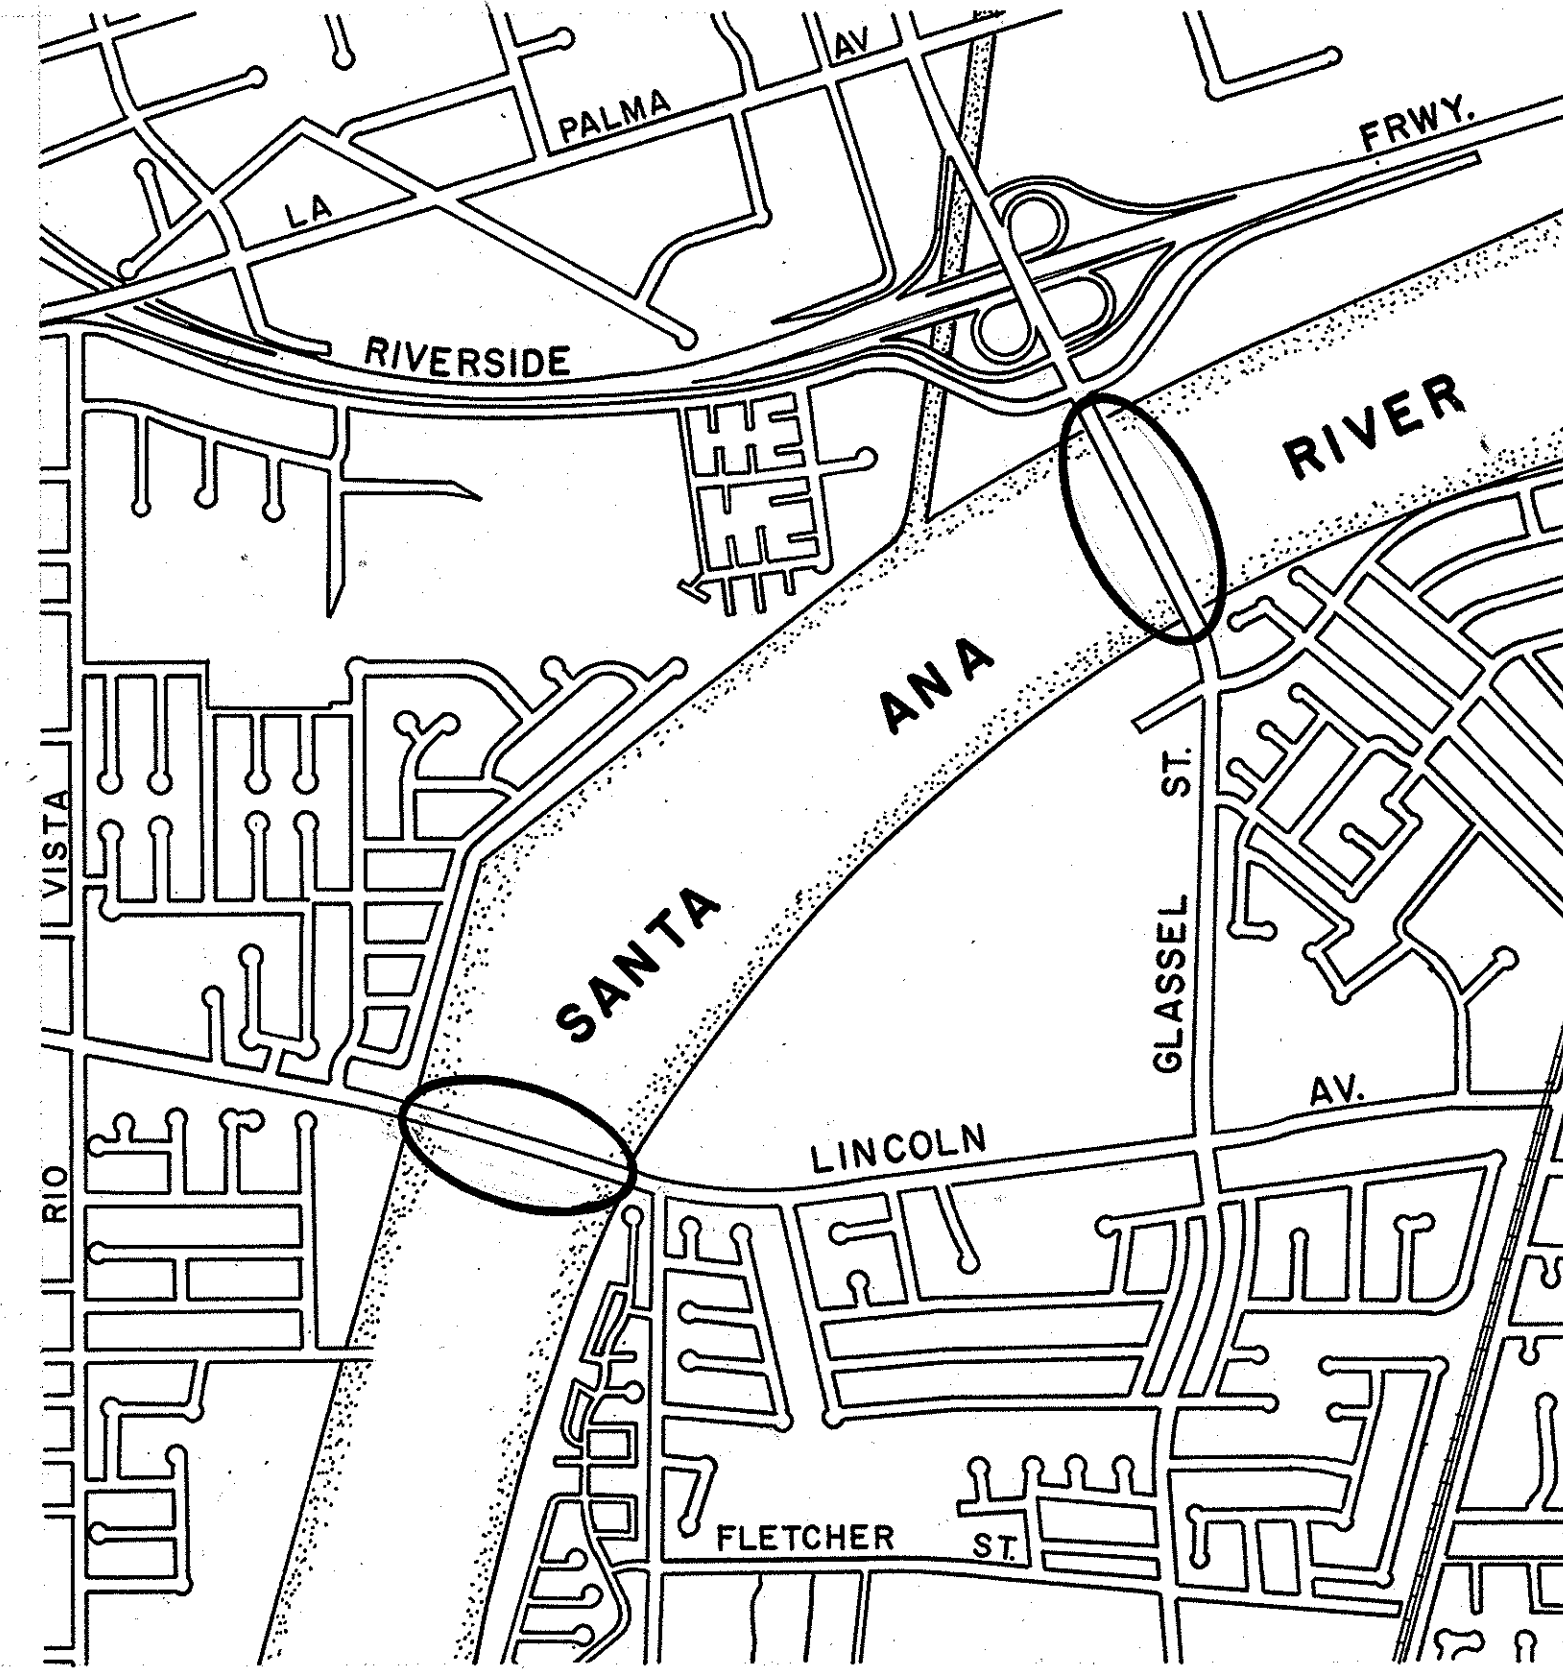


LINCOLN AVENUE AND
GLASSELL STREET BRIDGES

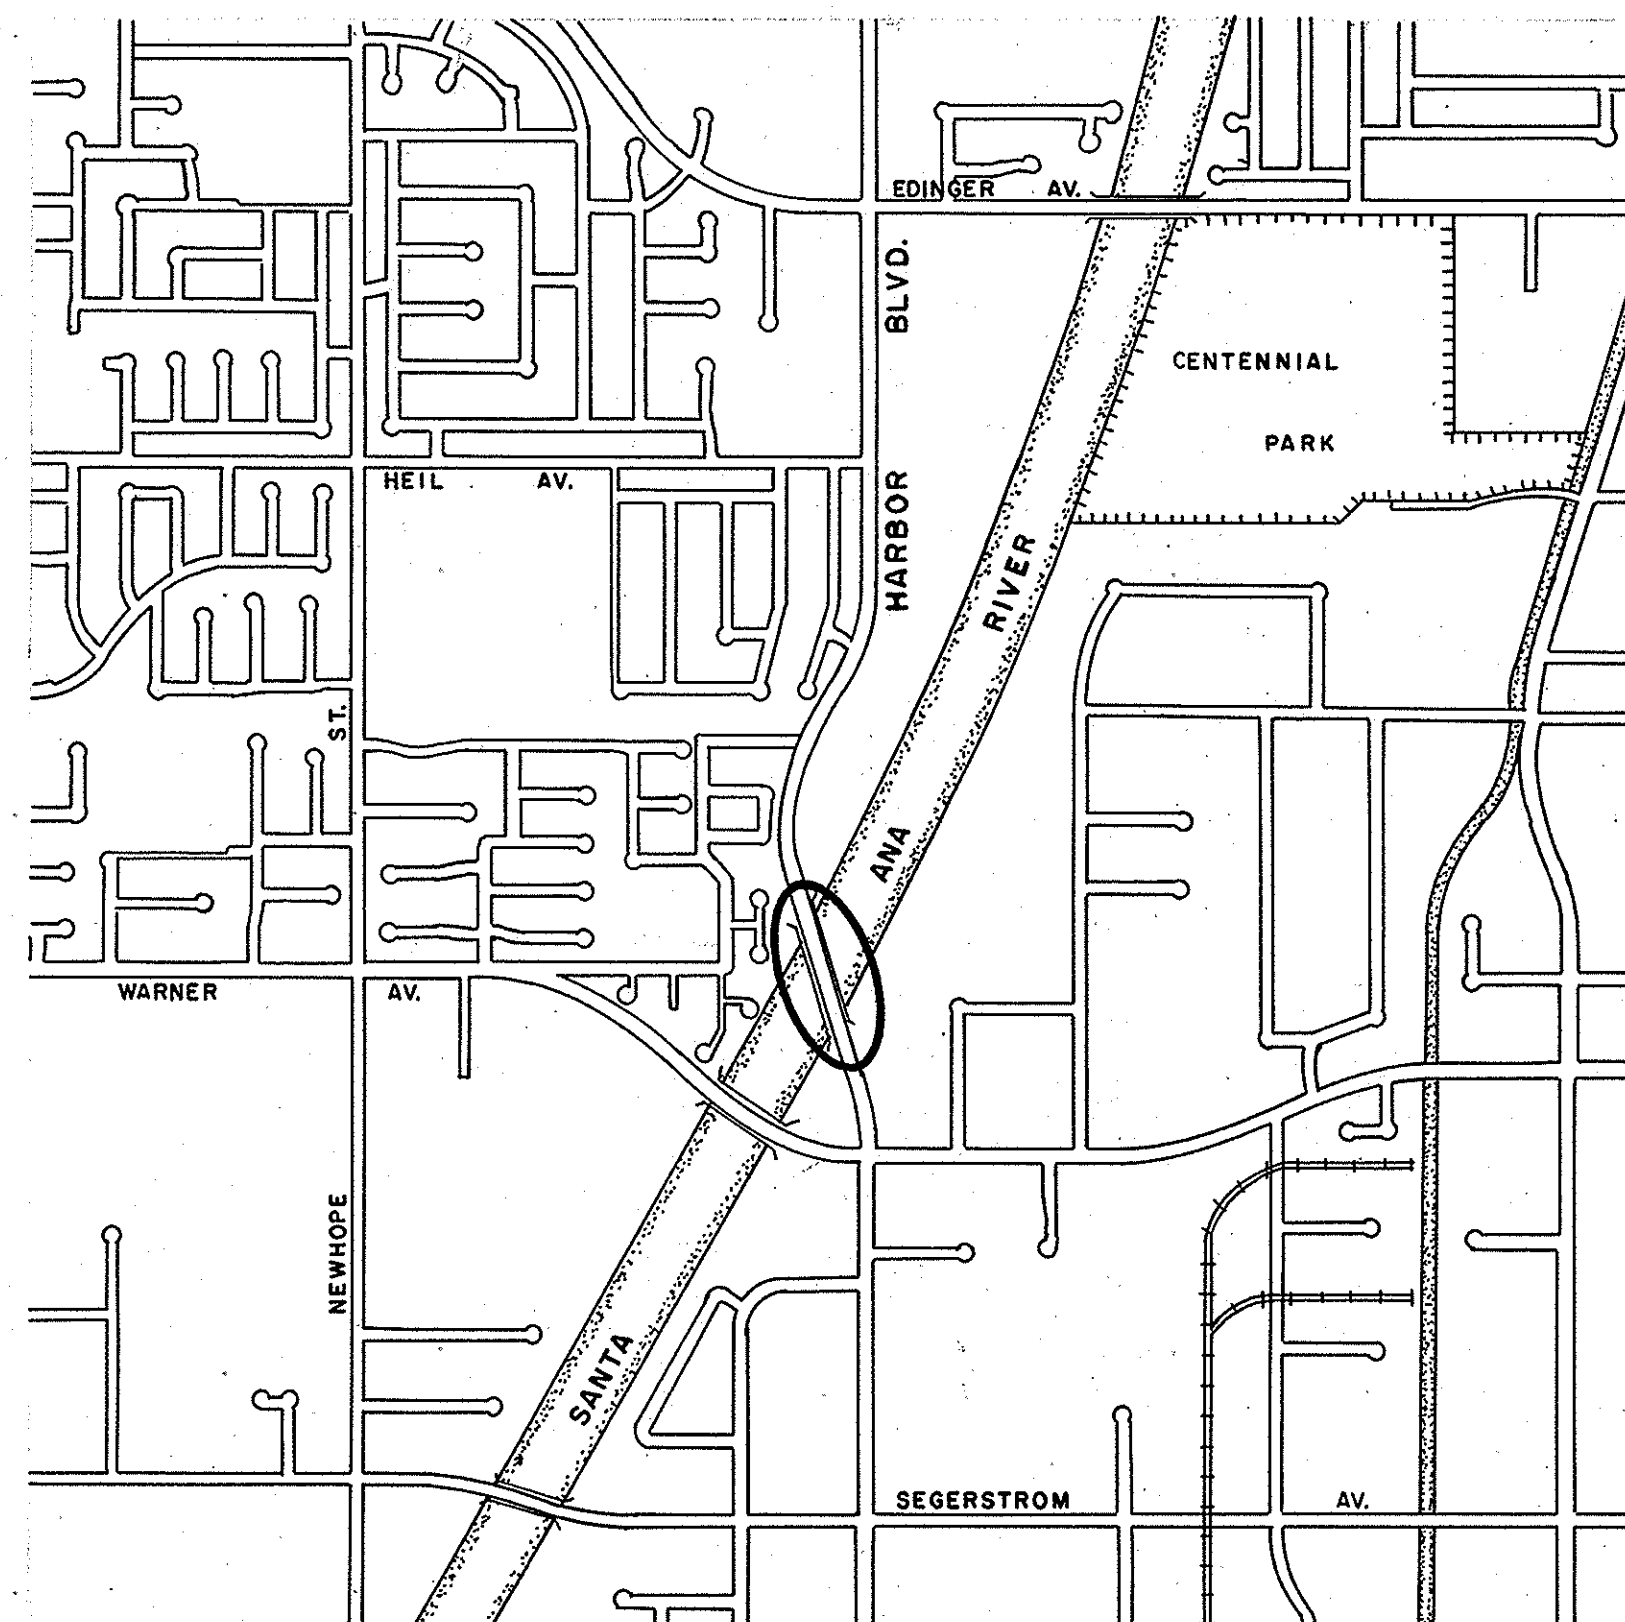

HARBOR BOULEVARD BRIDGE

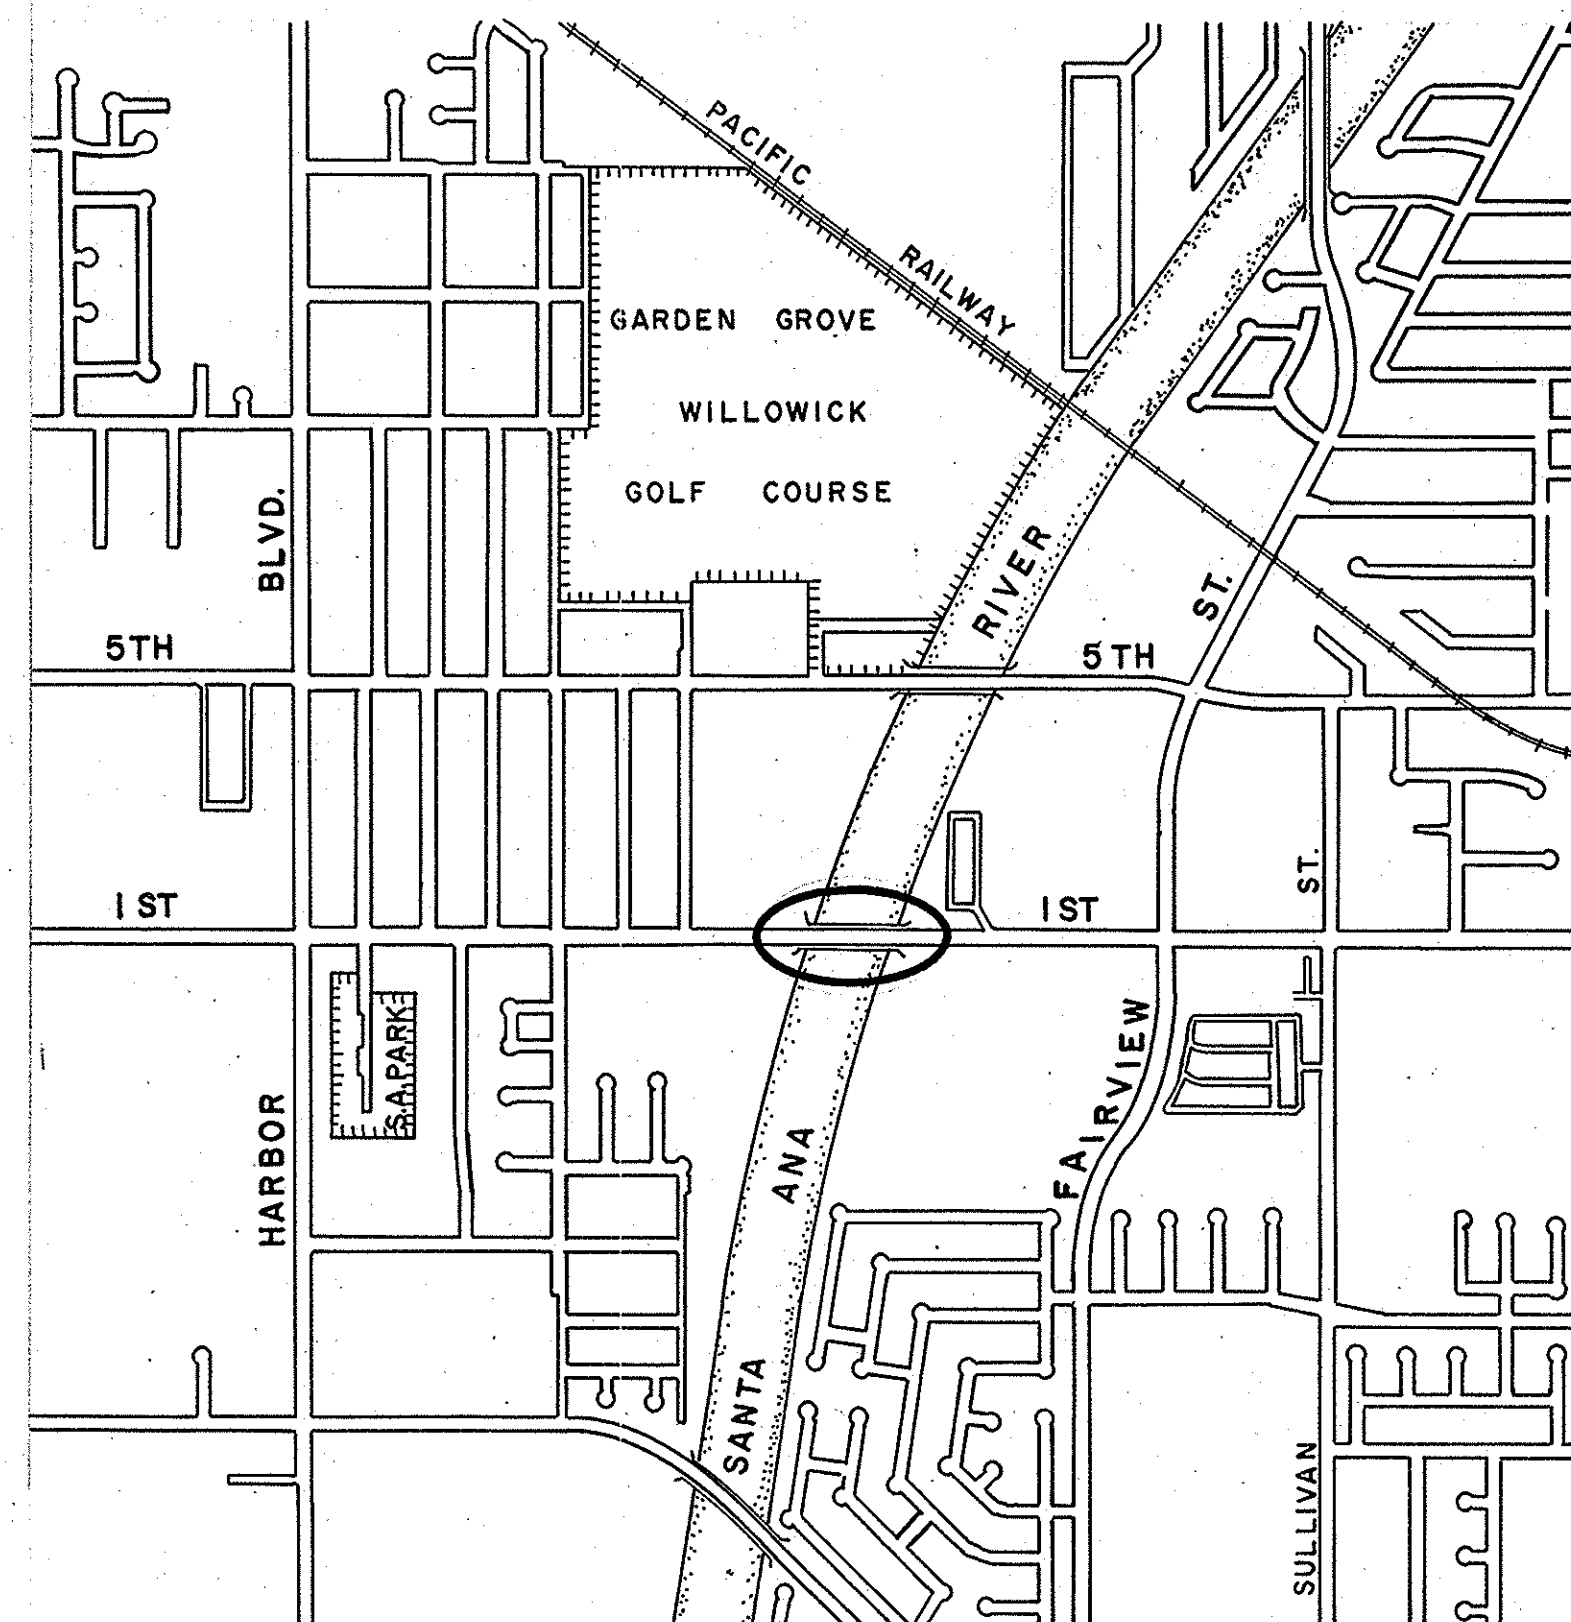

FIRST STREET BRIDGE

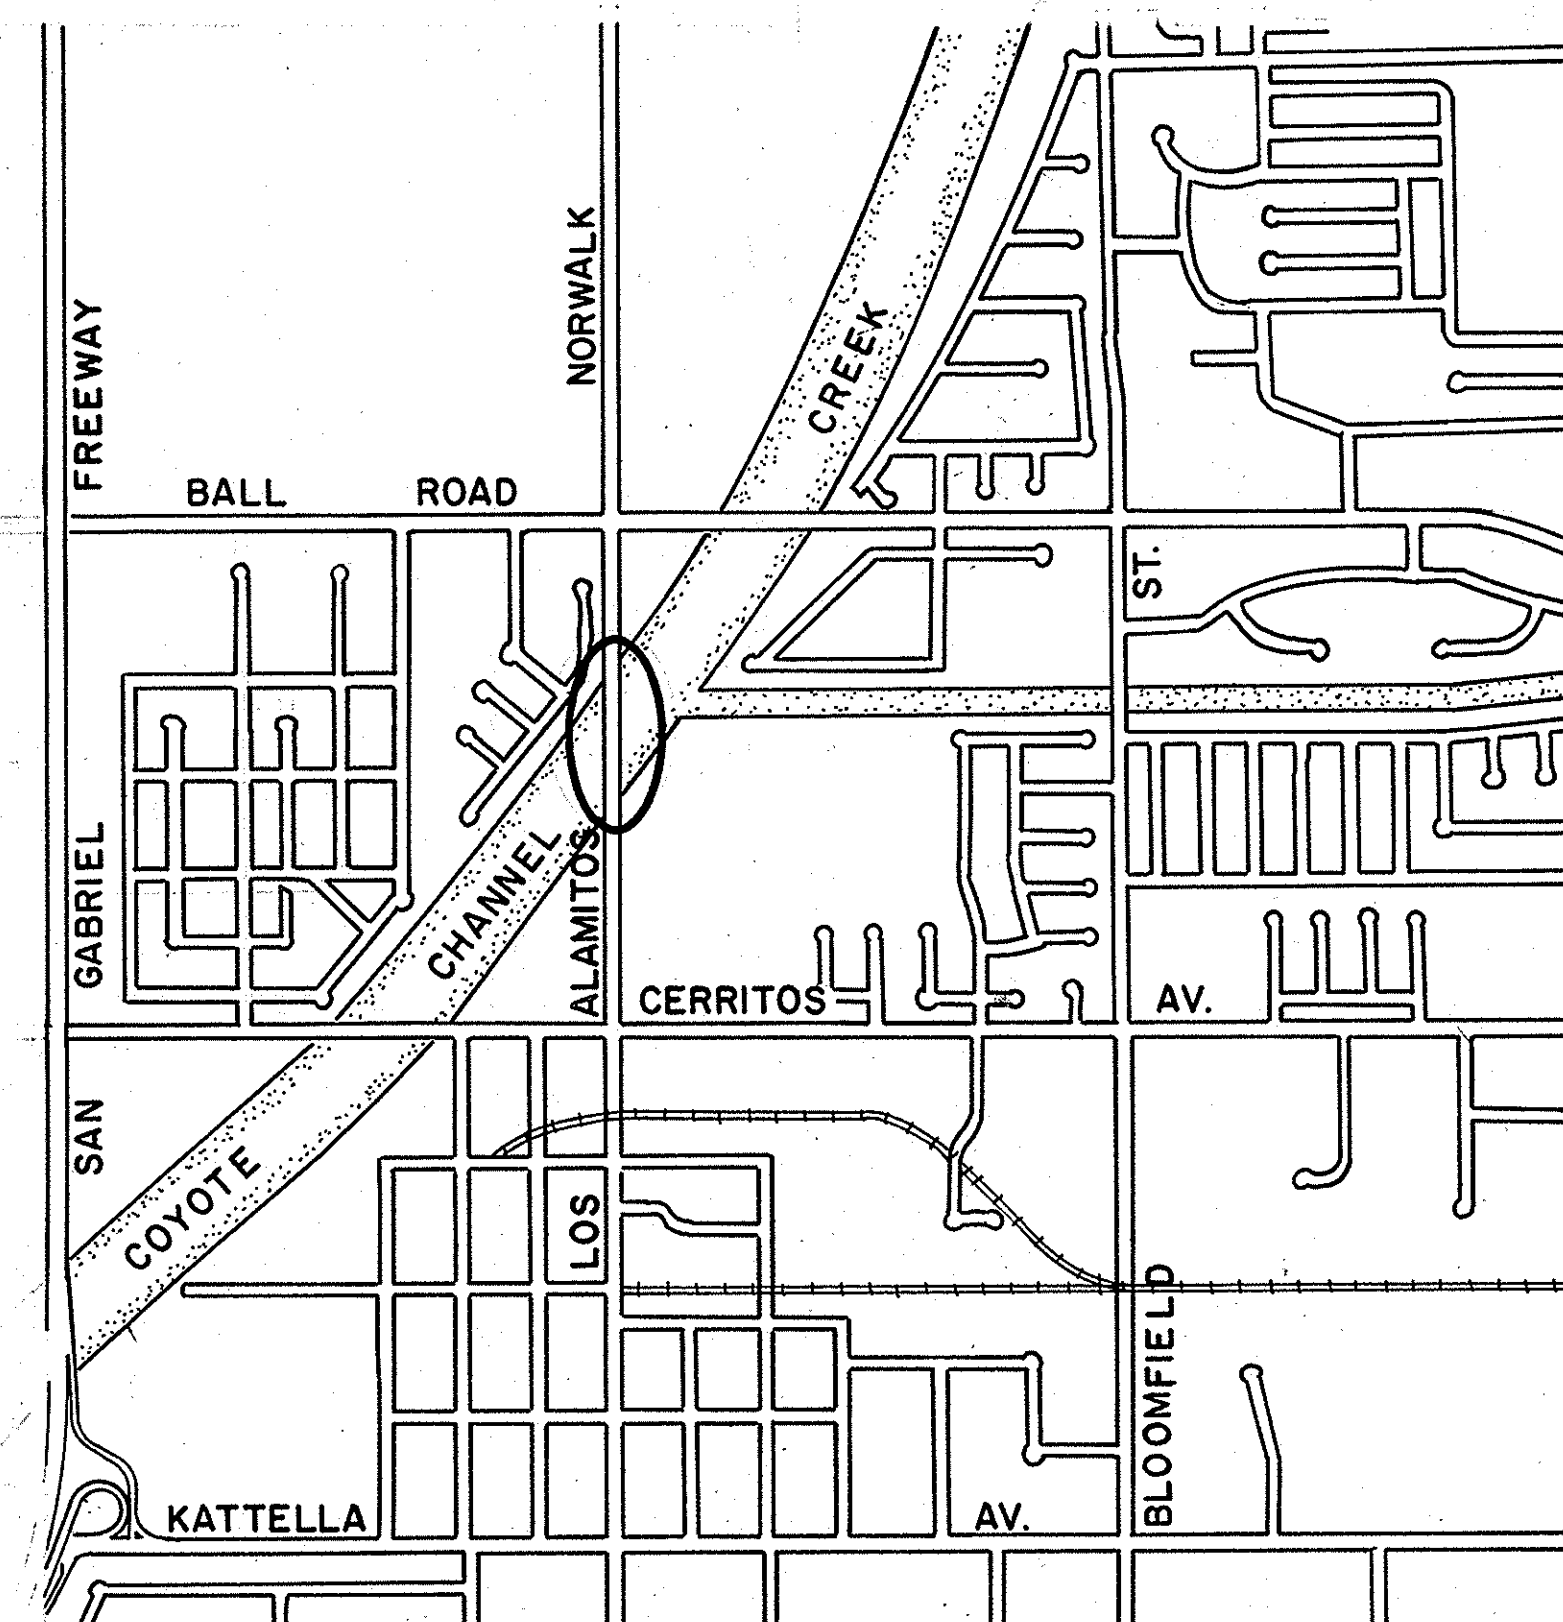

LOS ALAMITOS BLVD. BRIDGE

1 1/2 0 1 2
3 inches on original drawing

ORANGE COUNTY ENVIRONMENTAL MANAGEMENT AGENCY			
SEISMIC RETROFIT			
LOCATION MAPS			
MARK	DATE	DESCRIPTION	PREPARED UNDER SUPERVISION OF <i>Gene Williams</i> SHEET
DESIGNED		M. HSU	DATE
DRAWN		PB/BM	CHECKED
SCALE	DATE	DWG. NO.	2
AS SHOWN	10/83		