


EXACT

EXACT LEVEL & TOOL MFG. CO., Inc.

HIGH BRIDGE, N. J., U. S. A.

SINCE 1901

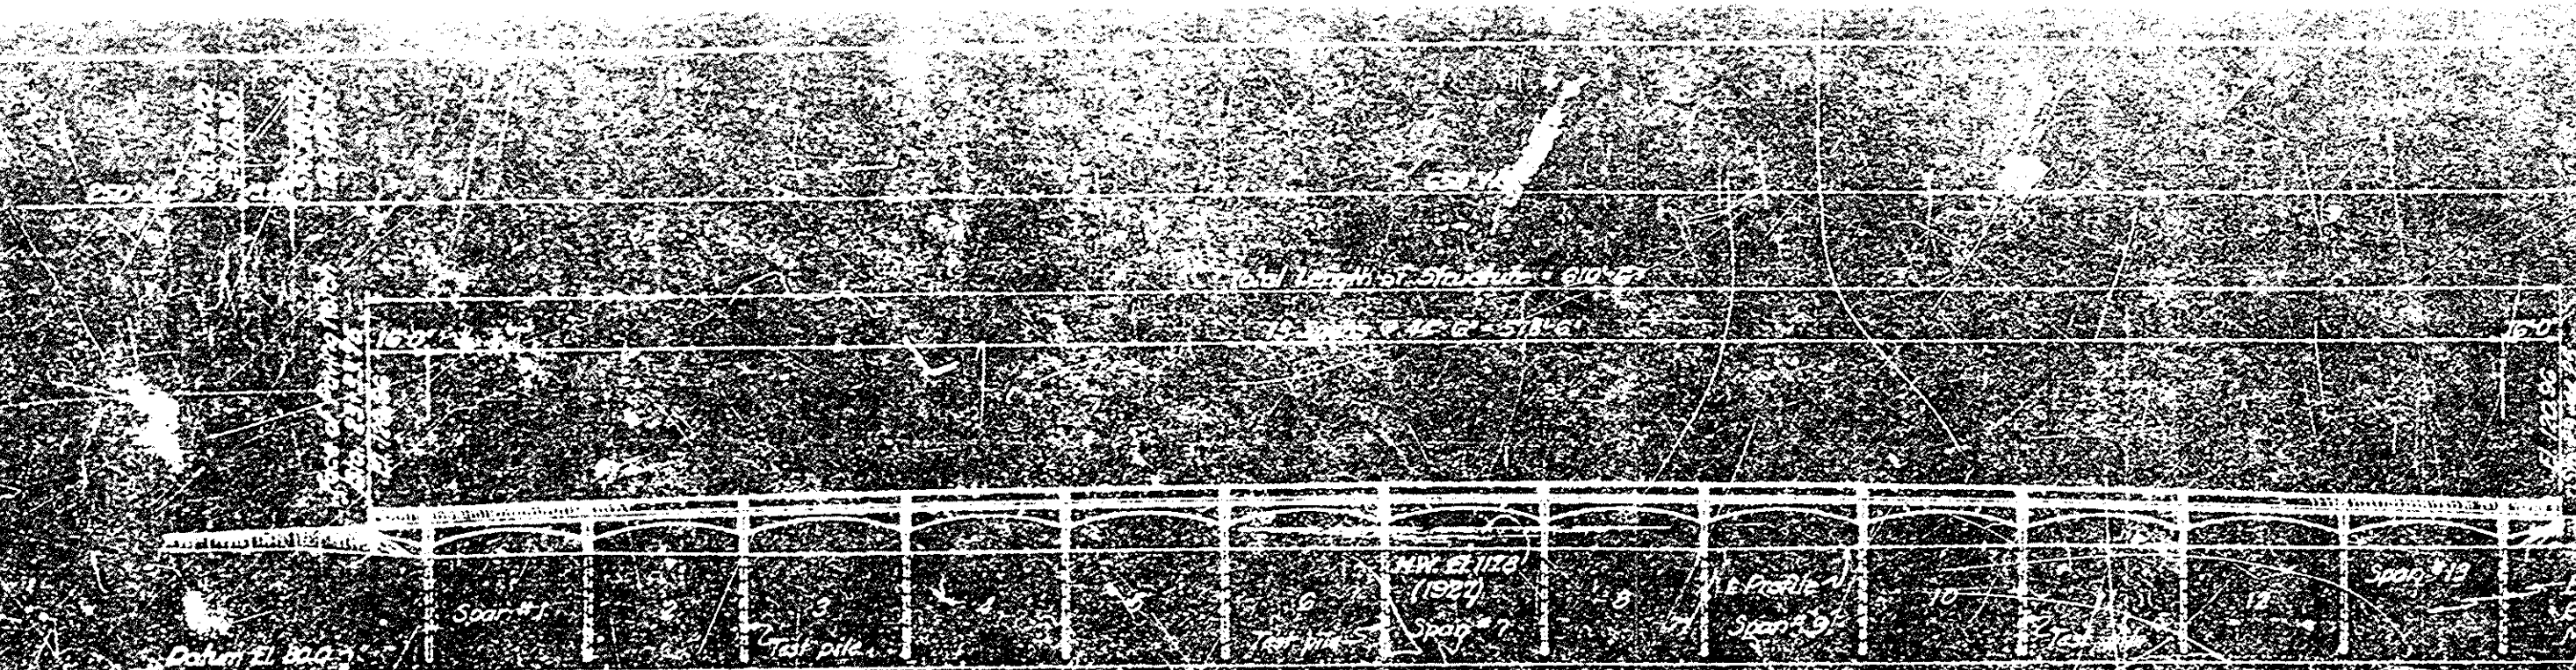

ELEVATION

- 1. Typical Pier
- 2. Typical Span
- 3. Typical Deck
- 4. Typical Cross-section of Highway
- 5. Plan and Elevation
- 6. Standard Details
- 7. Cross-sections

For General Notes on this
and all items see sheet No. 1

Bridges - SA-16

8703 1937
GARDEN GROVE RHD BR.
SA-18
55C-46
Thomas : 799-C6

(Don't have
Sheet 2)

193