

EXACT®

EXACT LEVEL & TOOL MFG. CO. IN. HIGH BRIDGE, N. J., U. S. A.

STRAIGHT EDGE RULE SE-48

ORANGE COUNTY ROAD DEPT.

STATE OF CALIFORNIA
AS BUILT

PLANS FOR CONSTRUCTION OF


GARDEN GROVE BLVD. BRIDGE SA-18

ACROSS SANTA ANA RIVER
CHANNEL EO1

PARTIALLY FUNDED WITH FEDERAL TOPICS FUNDS
T- 3041 (45)

INDEX OF SHEETS	
SHEET NO.	DESCRIPTION
1.	TITLE SHEET
2.	GENERAL BRIDGE PLAN & PROFILE
3.	APPROACH DETAILS
4-5.	GARDEN GROVE BLVD. CROSS-SECTIONS
6.	FOUNDATION PLAN & PILE DETAILS
7.	PIER DETAILS
8-9.	SUPERSTRUCTURE LAYOUT & DECK REINFORCEMENT
10.	TYPICAL SECTION
11.	HINGE DETAILS
12-13.	MISCELLANEOUS DETAILS
14-15.	GUARD RAIL-STRUCTURE EX. & BACKFILL DETAILS
16.	PILING DETAILS
17.	LOG OF TEST BORINGS

ALL WORK WITHIN THE FLOOD CONTROL DISTRICT RIGHT OF WAY SHALL BE PERFORMED IN ACCORDANCE WITH THE PROVISIONS OF THE CONSTRUCTION PERMIT GRANTED BY ORANGE COUNTY FLOOD CONTROL DISTRICT AND THE PLANS STAMPED WITH THE APPROVAL OF ORANGE COUNTY FLOOD CONTROL DISTRICT CONTRACTOR SHALL HAVE A COPY OF SAID PERMIT AND STAMPED PLANS ON THE JOB SITE.

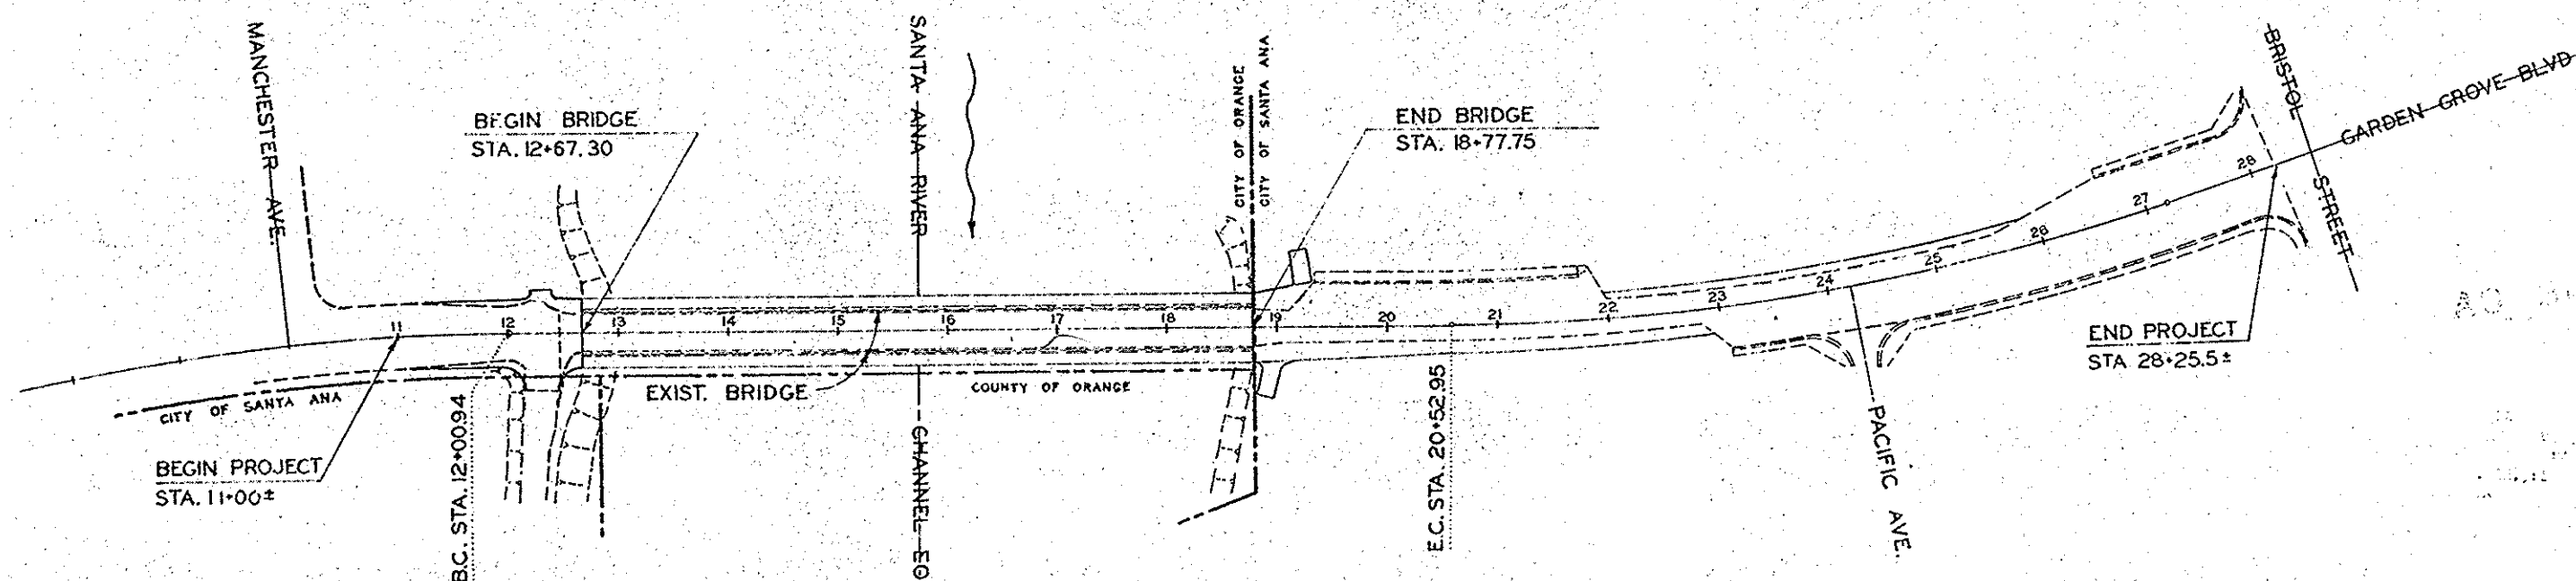

APPROVED: *[Signature]* 3-26-71
DEPUTY DISTRICT ENGINEER DISTRICT 07 DATE

APPROVED: *[Signature]* 3/29/71
DIVISION OF HIGHWAYS CITY & COUNTY PROJECT ENG. DATE

APPROVED: *[Signature]* 3/18/71
CITY ENGINEER DATE

APPROVED: *[Signature]* 3/18/71
DIRECTOR OF PUBLIC WORKS DATE

APPROVED: *[Signature]* 3-22-71
ROAD ENGINEER R.C.E. 7872 DATE

#10644 1971
GARDEN GROVE BLVD. BR
WIDENING (SA-18A)
55C-46
Thomas: 799-C6