


EXACT

STRAIGHT EDGE RULE SE-48

3-71
3-11
3-16

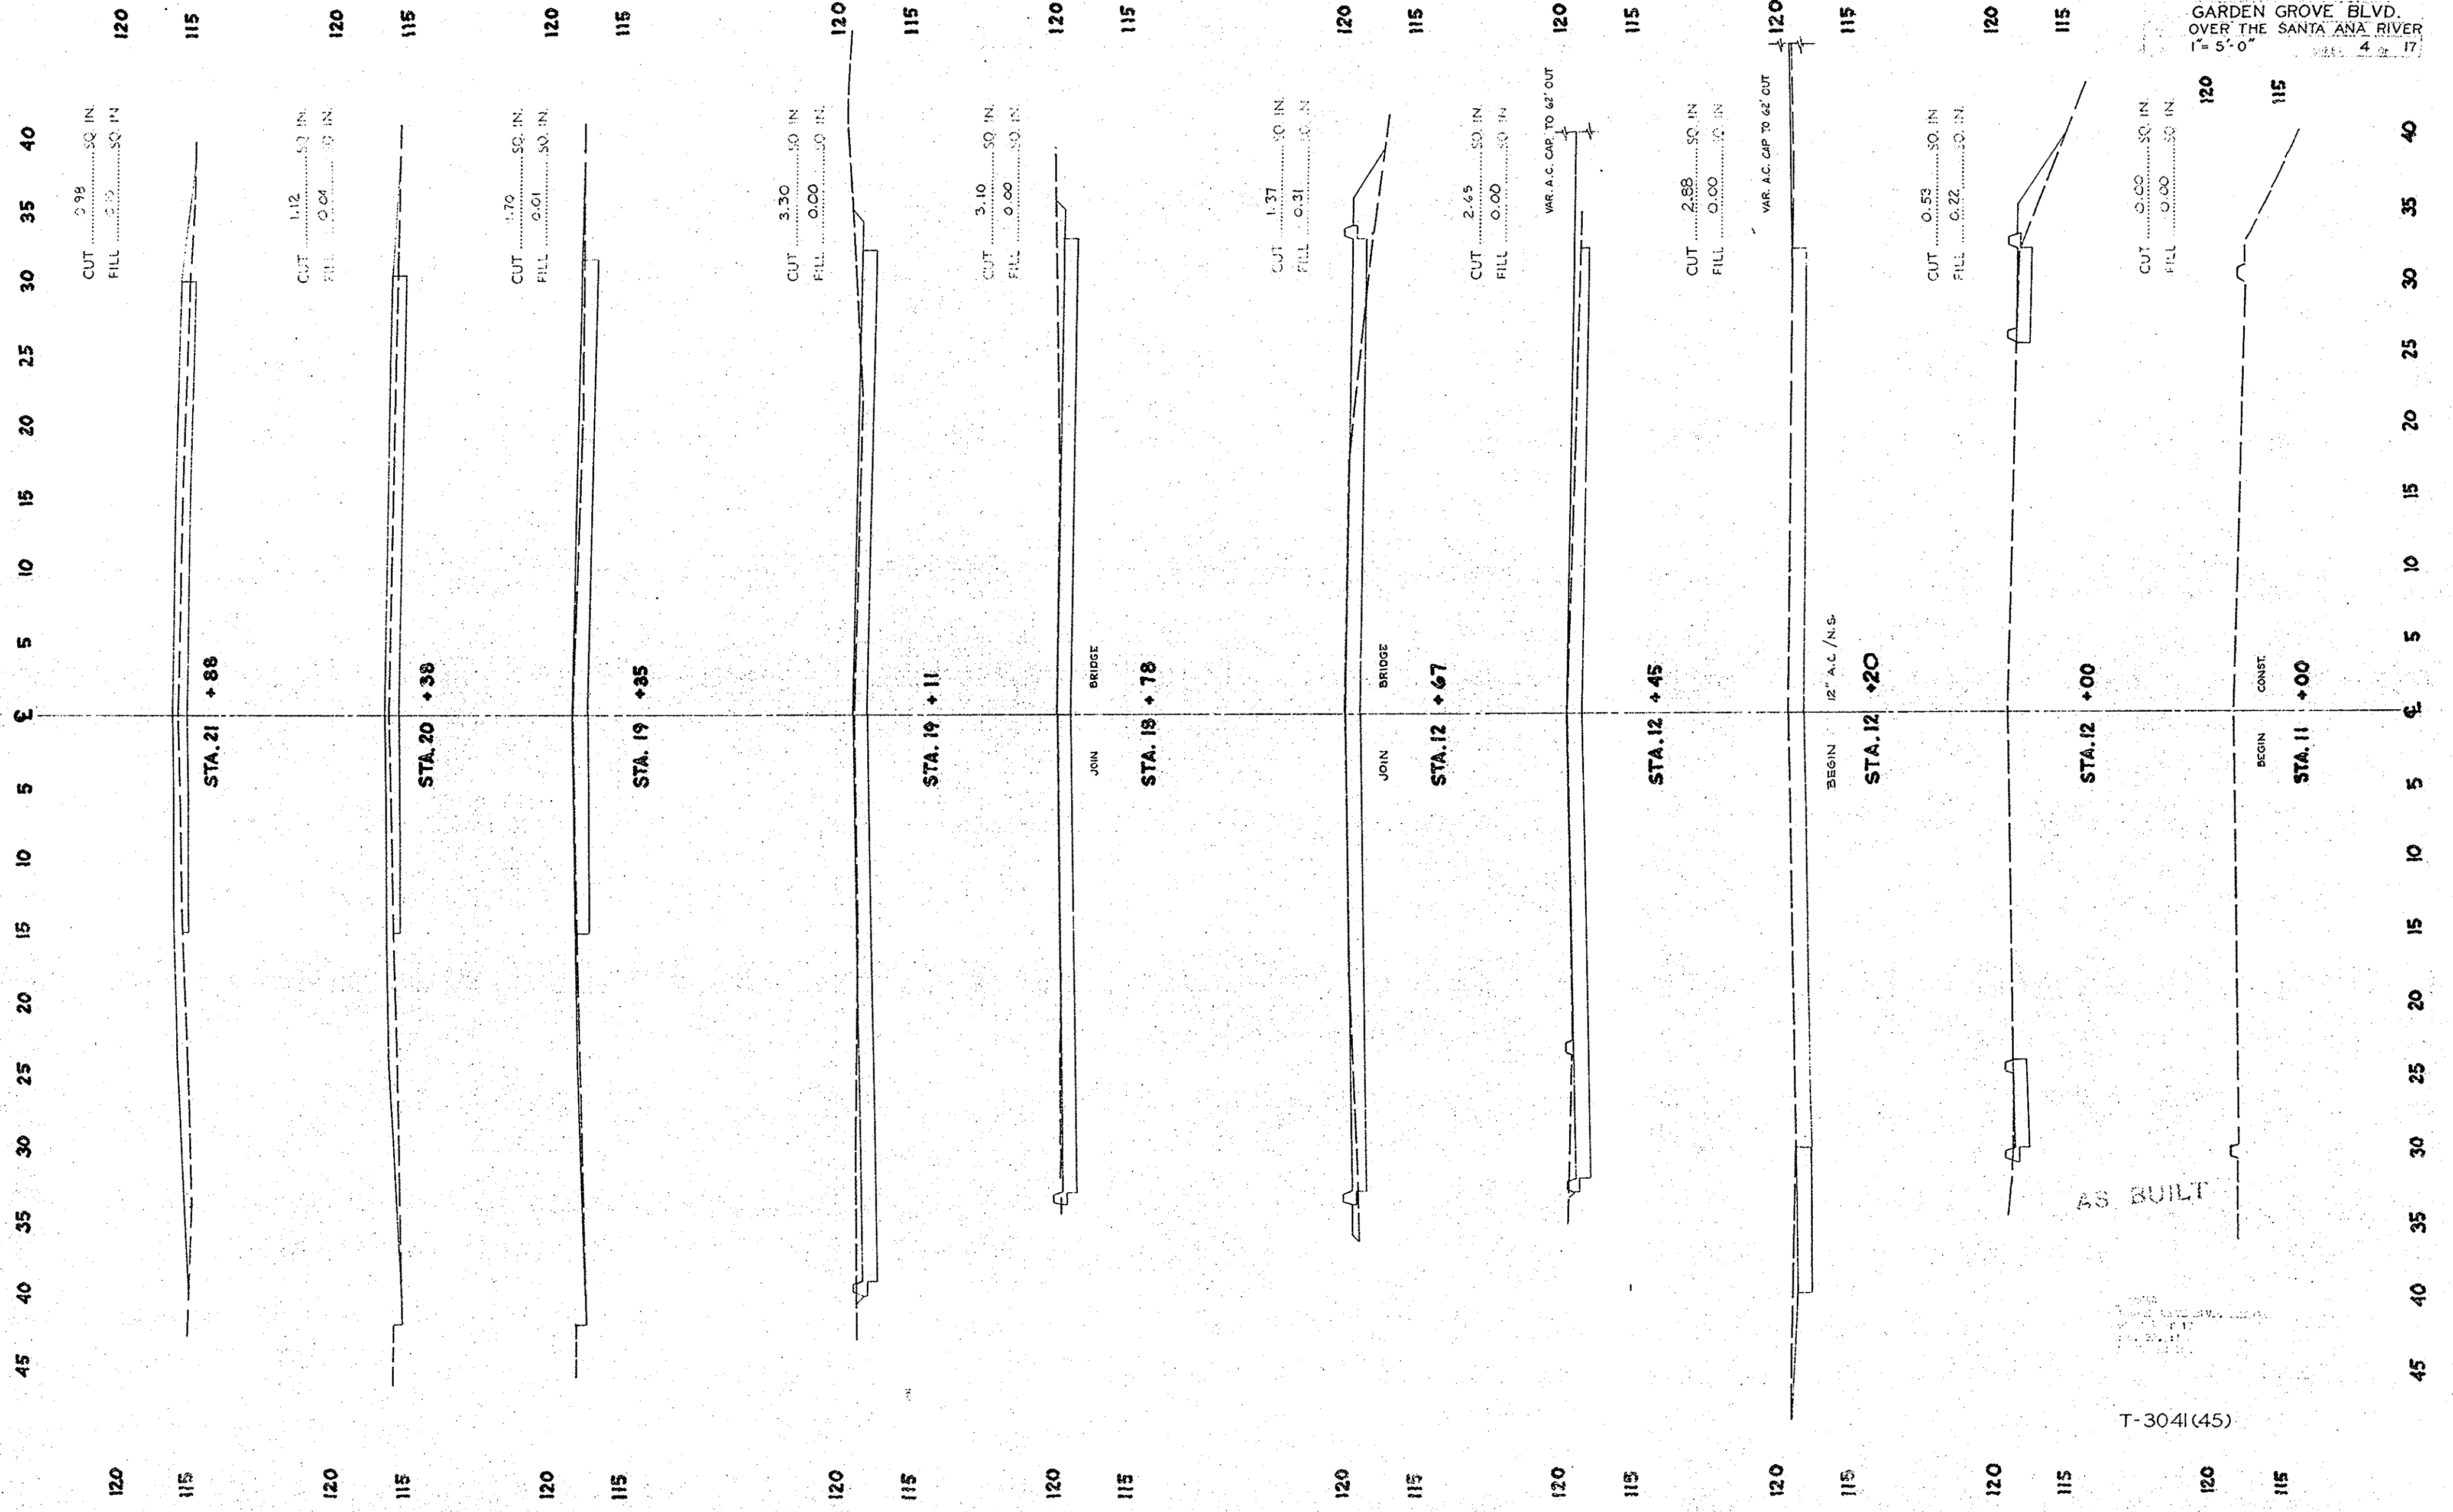

GARDEN GROVE BLVD.
OVER THE SANTA ANA RIVER
1" = 5'-0"

AS BUILT

T-3041(45)

Dr. 7 (10644)