


EXACT

STRAIGHT EDGE RULE SE-48

LANE COUNTY ROAD DEPARTMENT
GARDEN GROVE BLVD.
OVER SANTA ANA RIVER
1" = 5'-0" 24'-0" 5' 17'

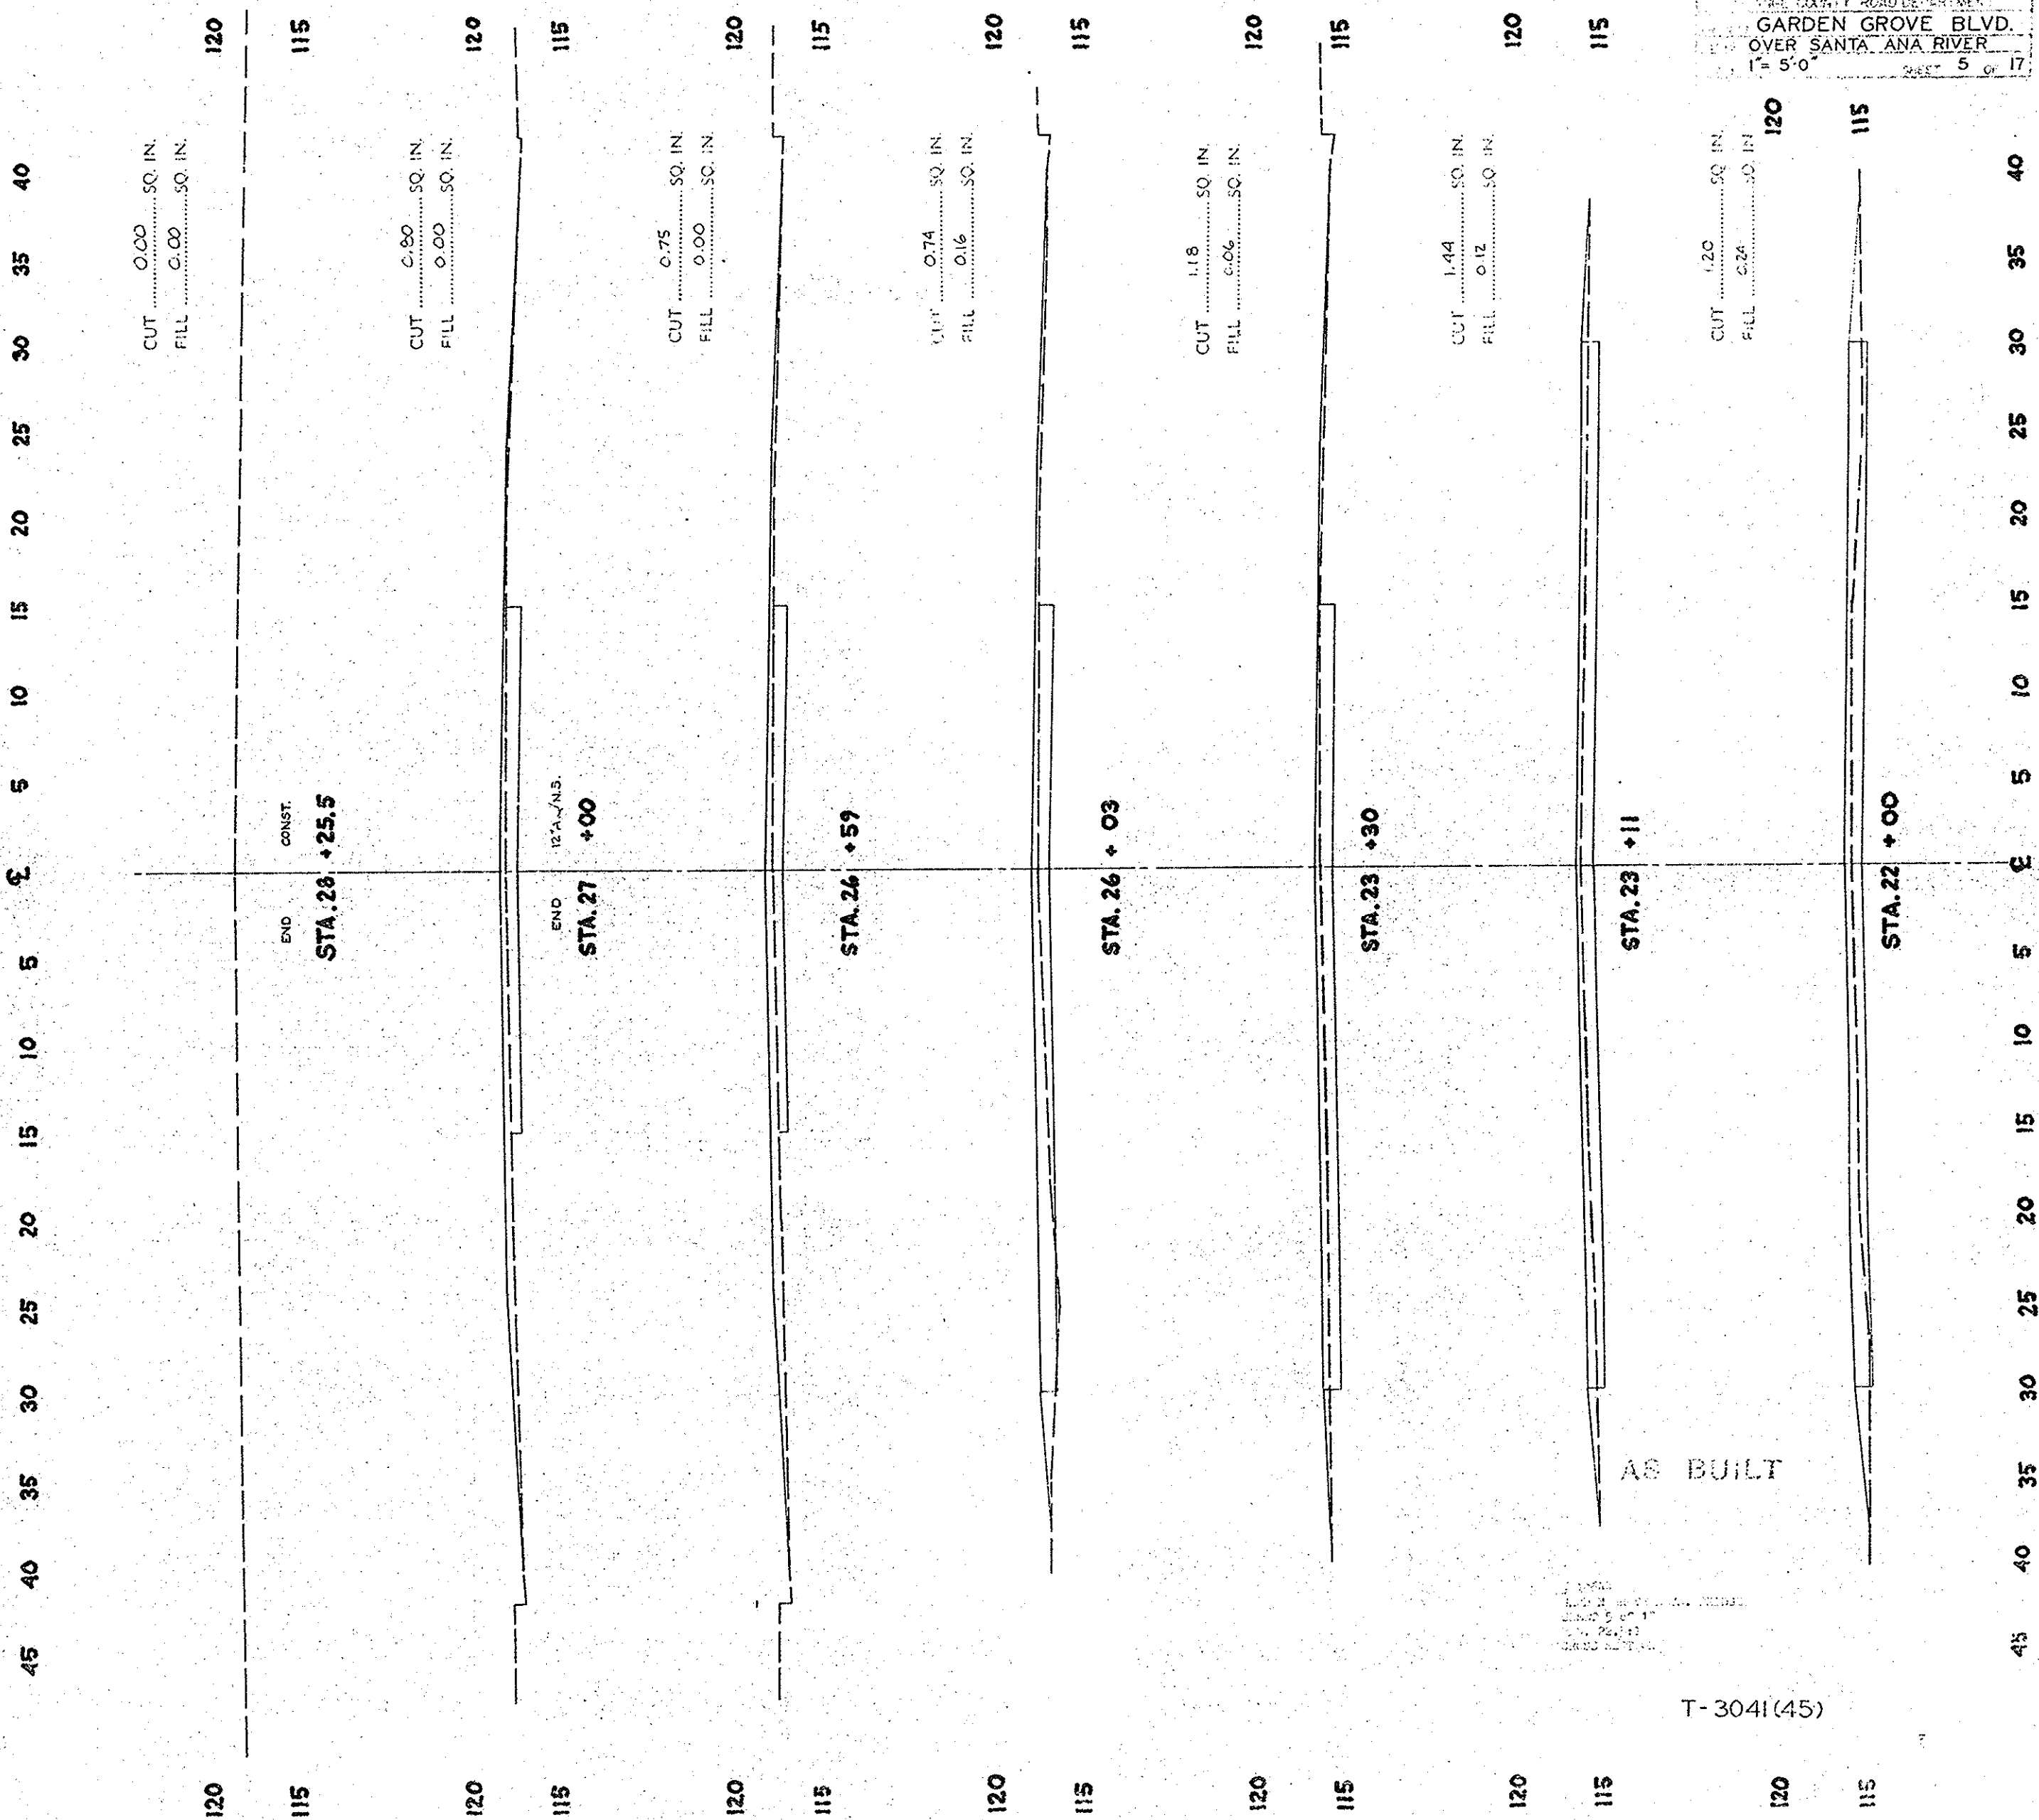

T-3041(45)

DR. K. K. K.