




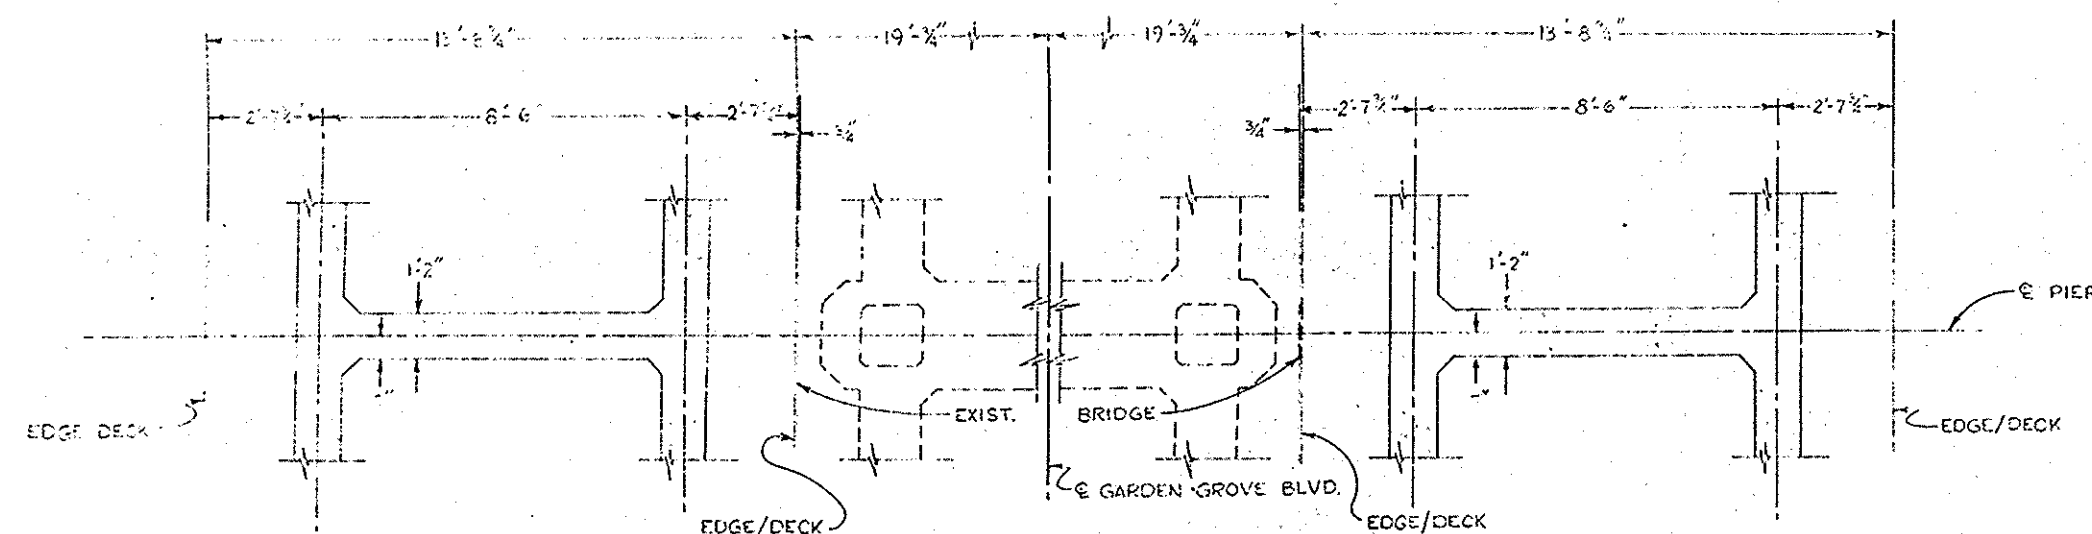

SECTION A-A
SCALE - 3/8" = 1'-0"

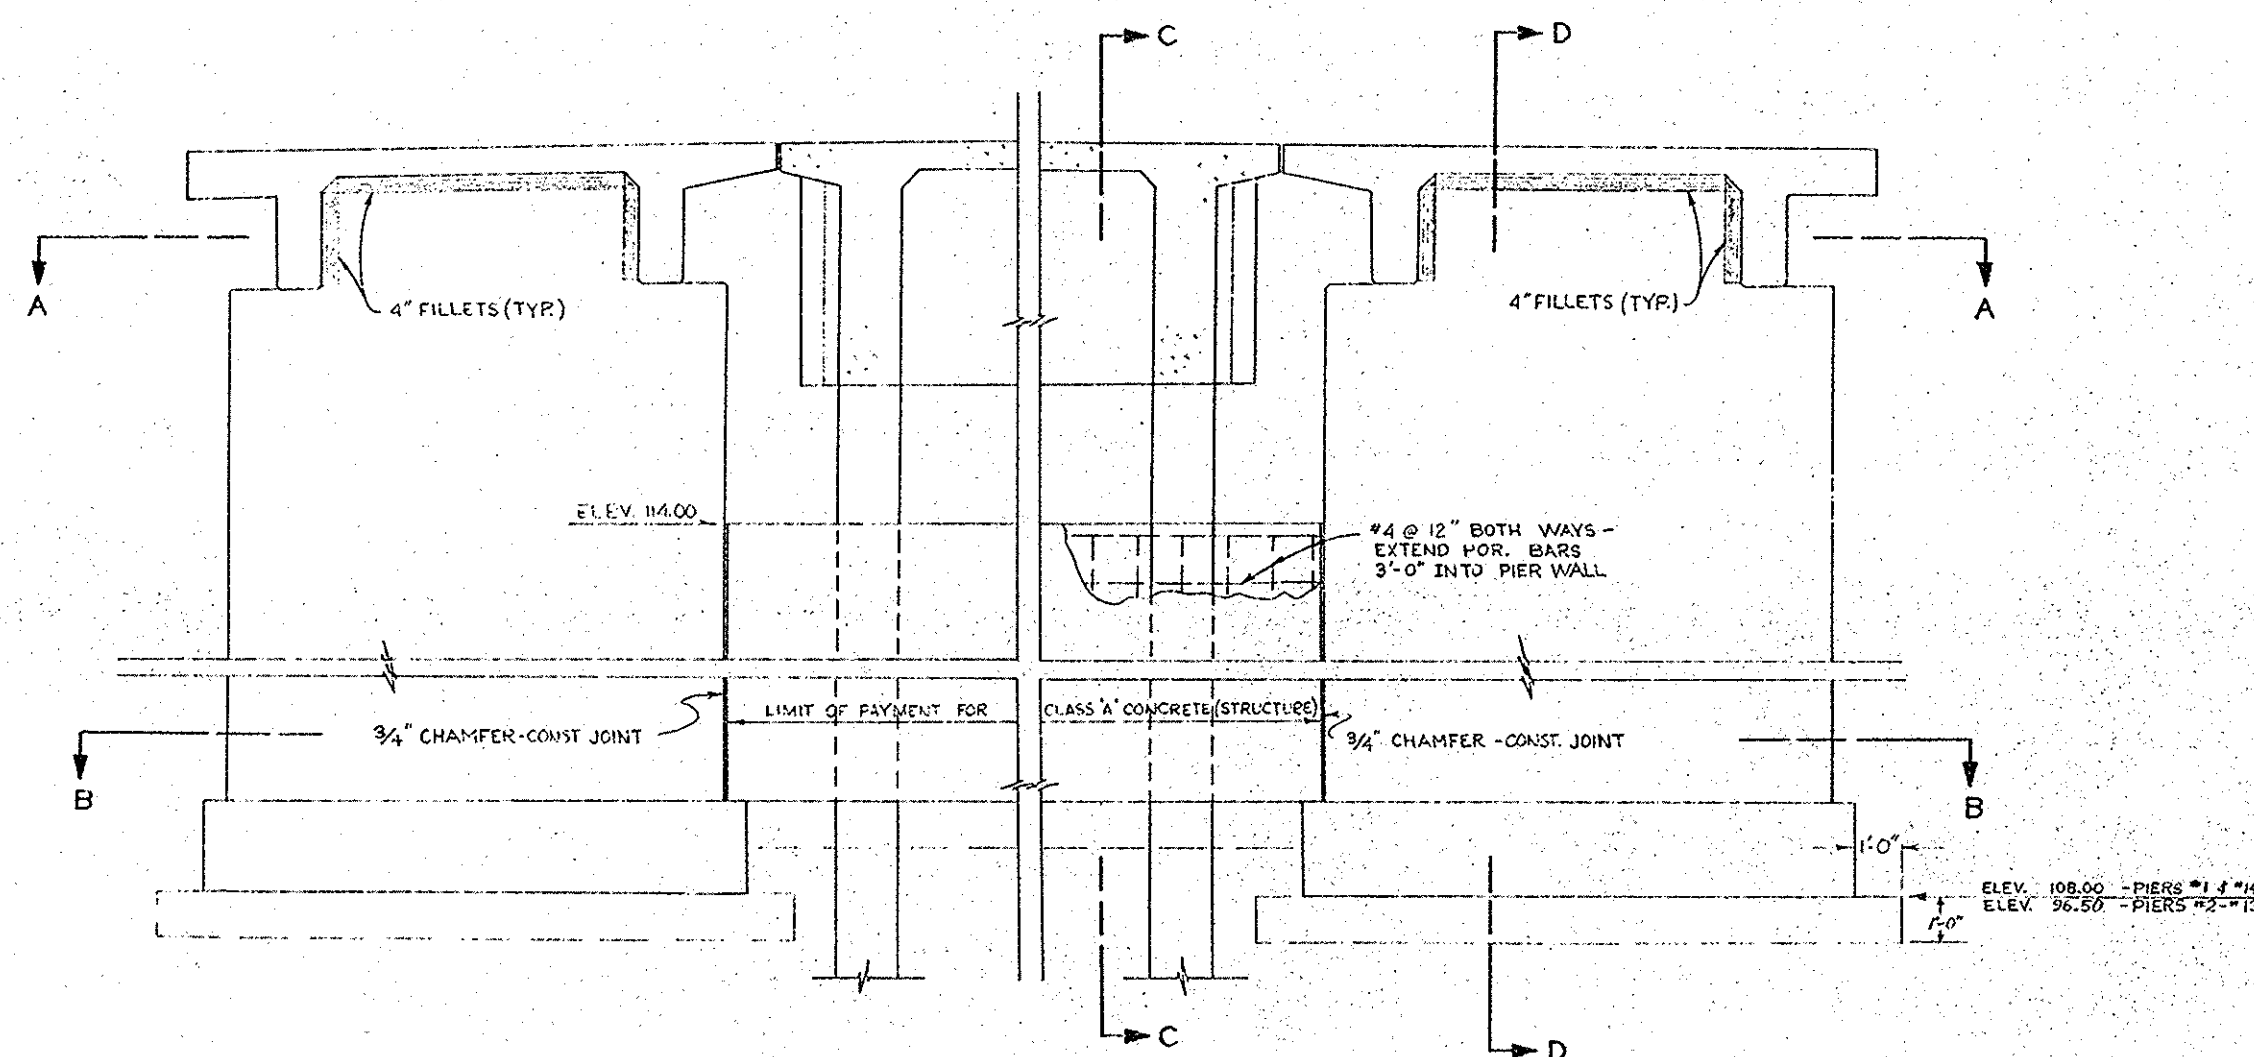


TYPICAL PIER DETAIL
SCALE - 3/8" = 1'-0"

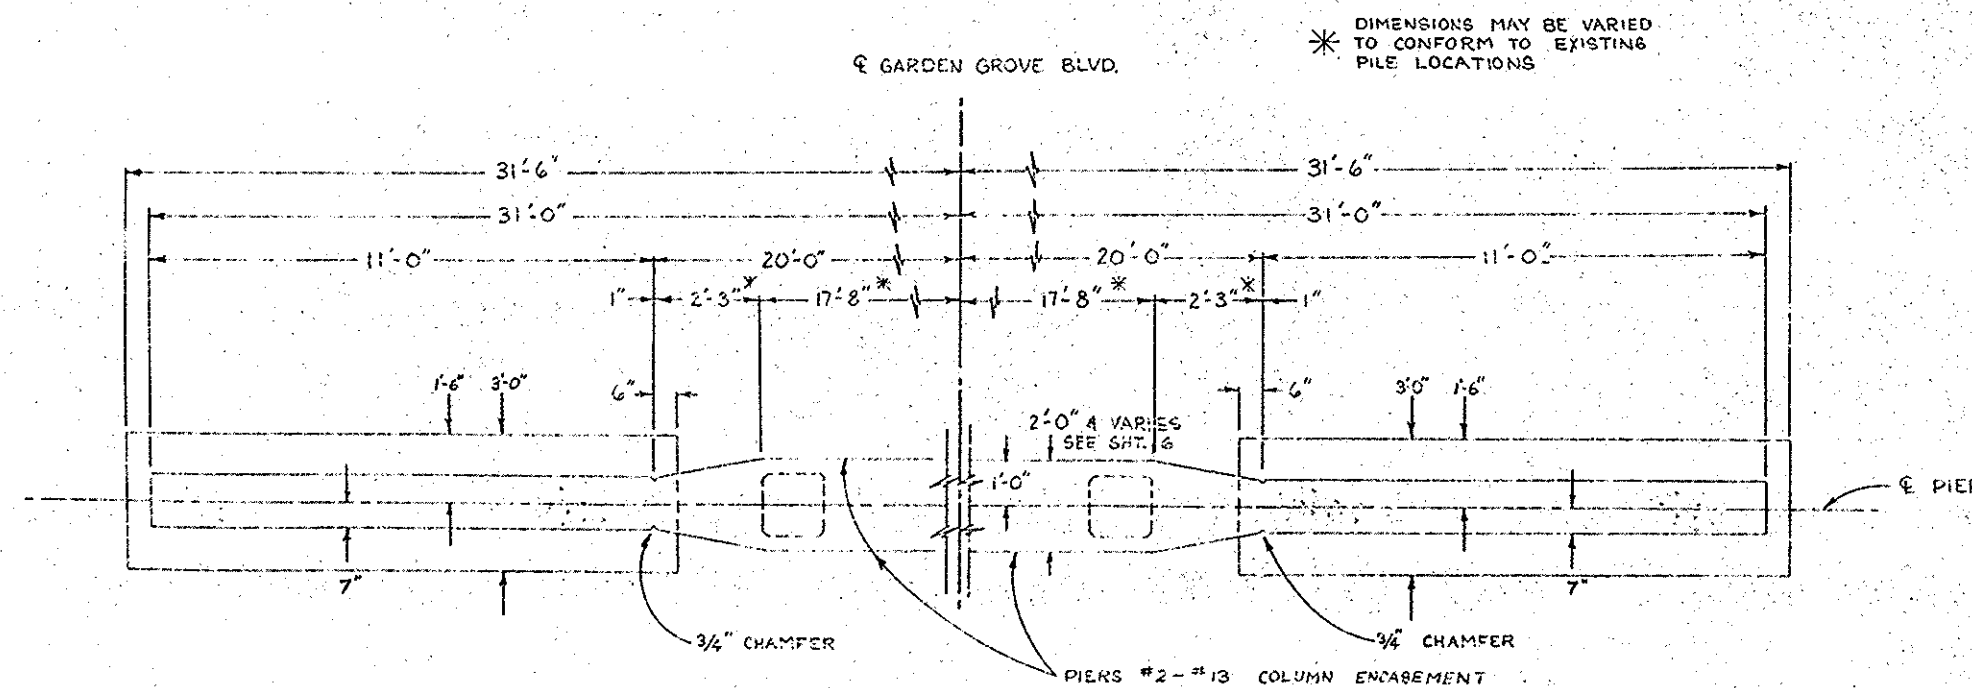


SECTION B-B
SCALE - 3/8" = 1'-0"

* DIMENSIONS MAY BE VARIED TO CONFORM TO EXISTING PILE LOCATIONS

NOTE
COLUMN ENCASUREMENTS SHALL BE POURED SEPARATE FROM THE PIER WALLS.

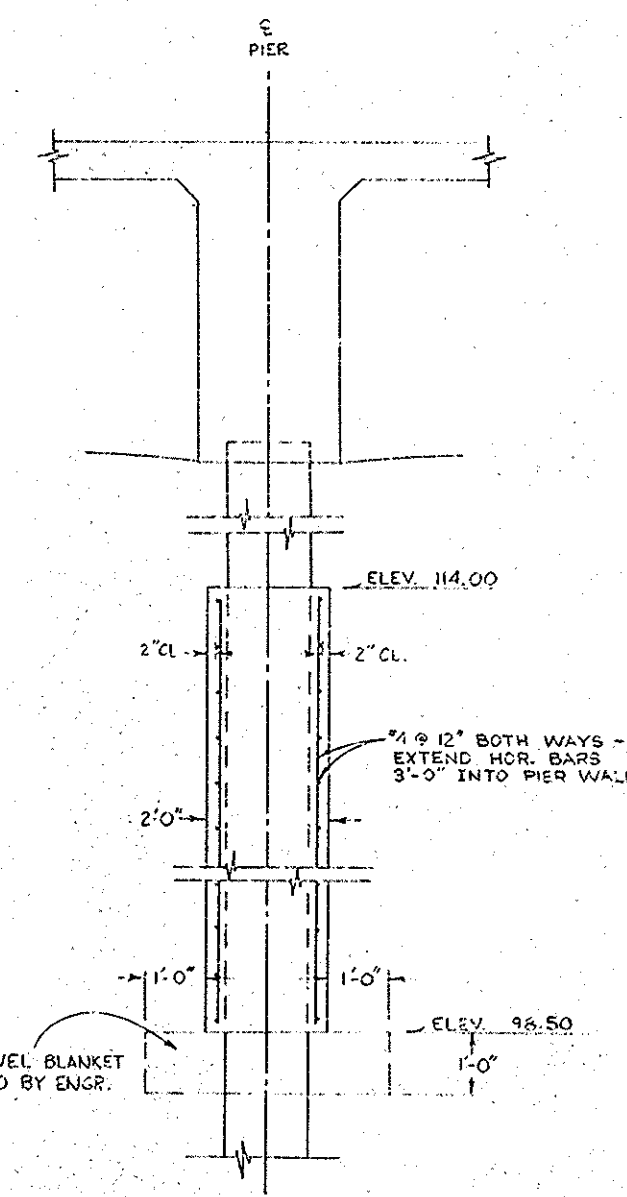

SECTION C-C (PIERS #2-#13)
SCALE - 1/2" = 1'-0"

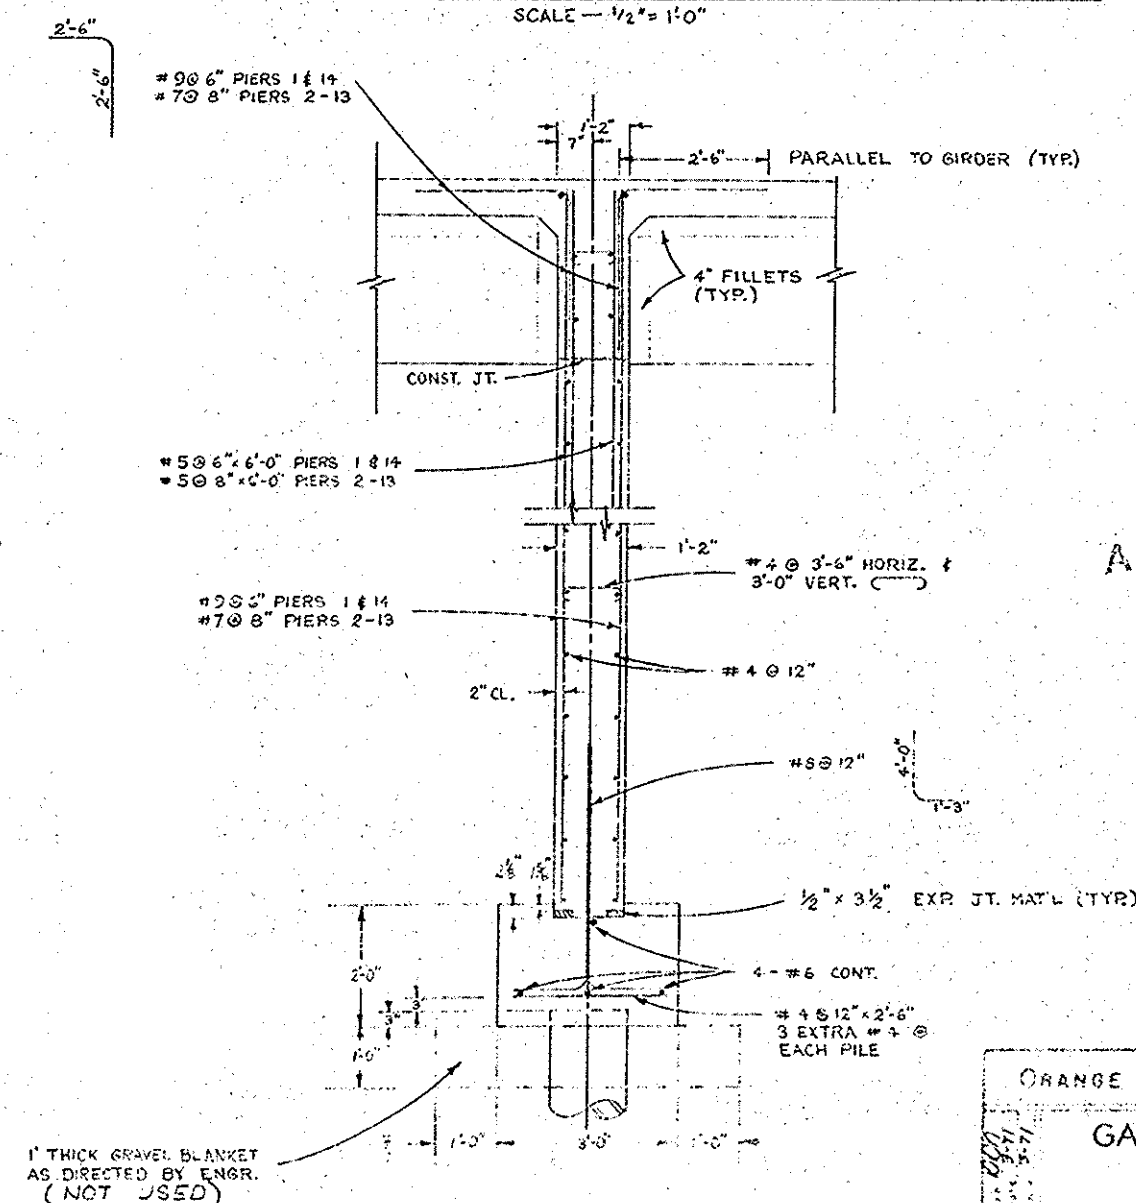

SECTION D-D
SCALE - 1/2" = 1'-0"

AS BUILT

T-3041(45)	
ORANGE COUNTY ROAD DEPARTMENT	
GARDEN GROVE BLVD. BRIDGE SA-18 OVER SANTA ANA RIVER	
PIER DETAILS	
SCALE: AS NOTED	SHEET 7 OF 17

Dr. 7(10644)