



TYPICAL LAYOUT PLAN

SCALE: 1/8" = 1'-0"

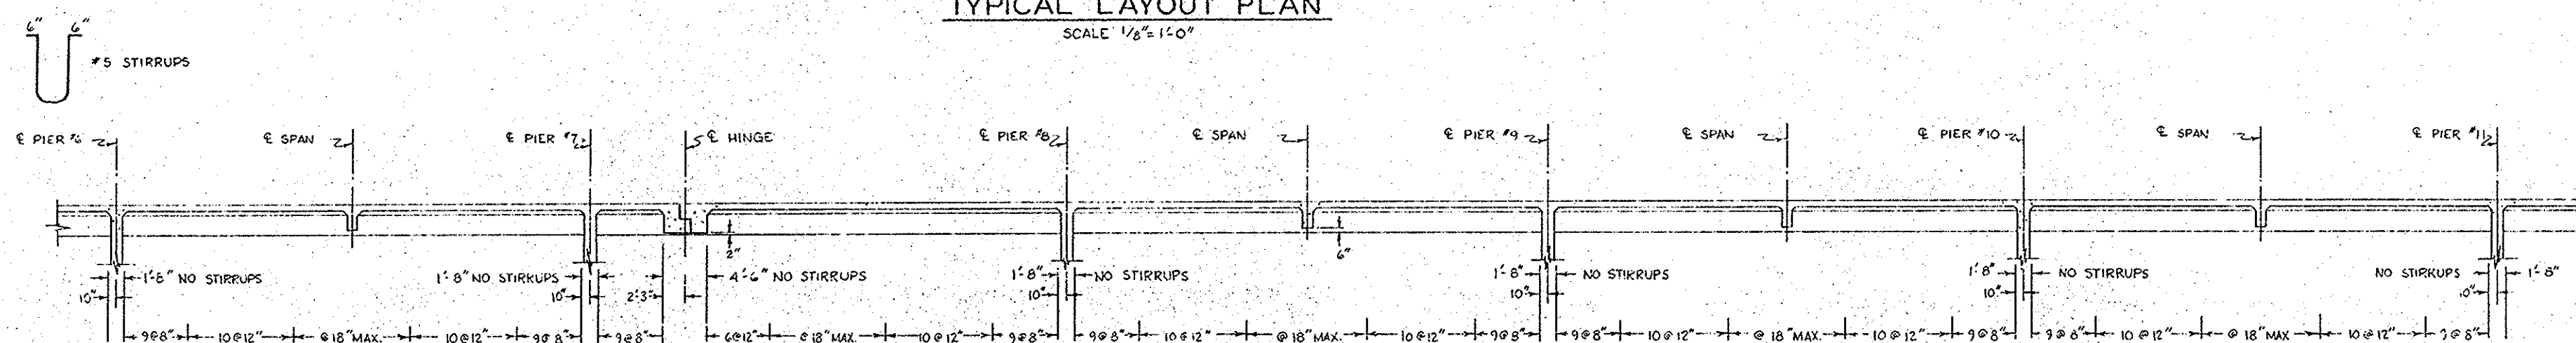

SECTION A-A - STIRRUP SPACING

SCALE: $\frac{1}{8}'' = 1'-0''$

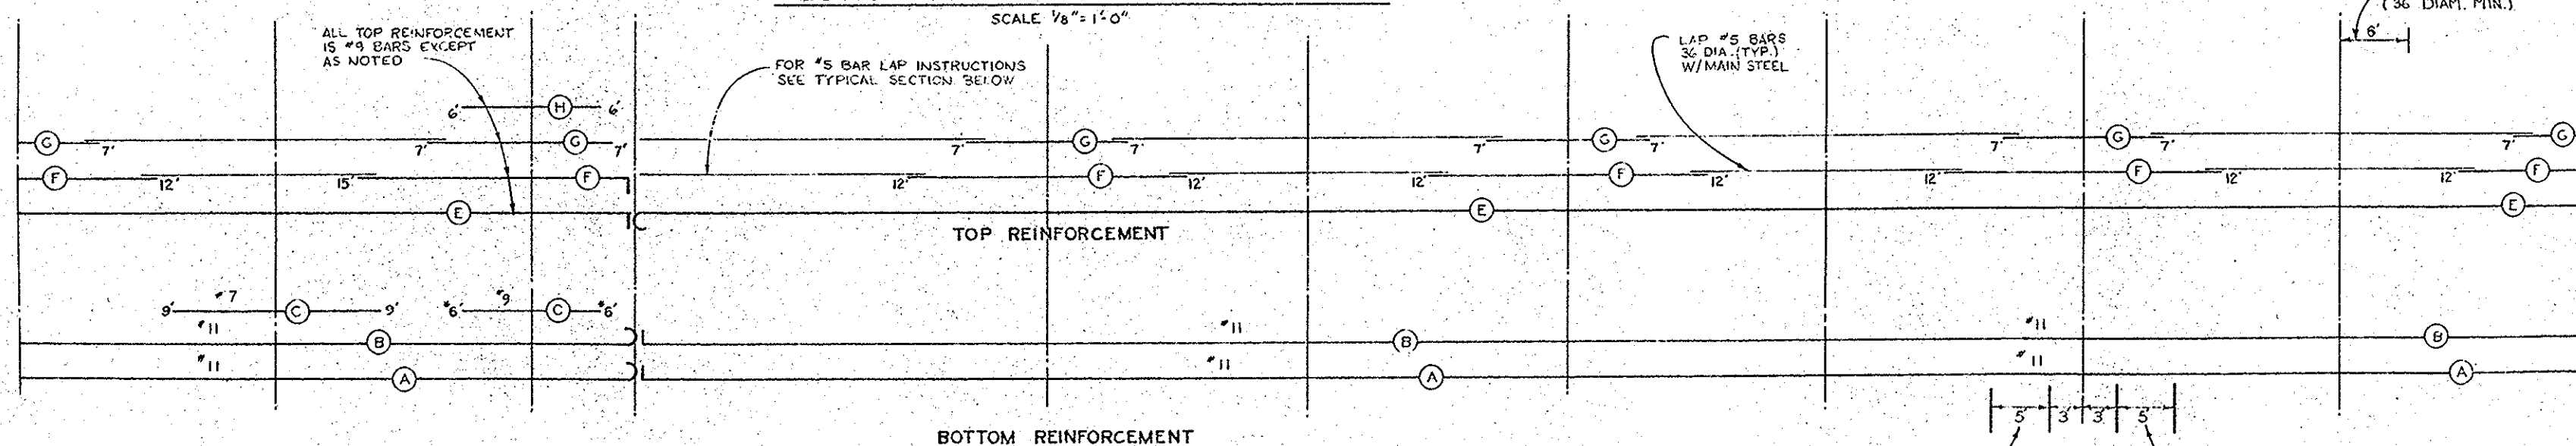


GIRDER REINFORCEMENT

SCALE: $\frac{1}{8}'' = 1'-0''$

NOTE: DIMENSION AT END OF BARS ARE FROM E DIAPH.
(BOT. REINF.) AND E PIER (TOP REINF.)

FOR ADDIT'L REINF. IN SLAB OVER INTERMEDIATE
DIAPH. SEE SHT #12.

* THIS BOT. REINF BAR IS DIM. FROM C PIER

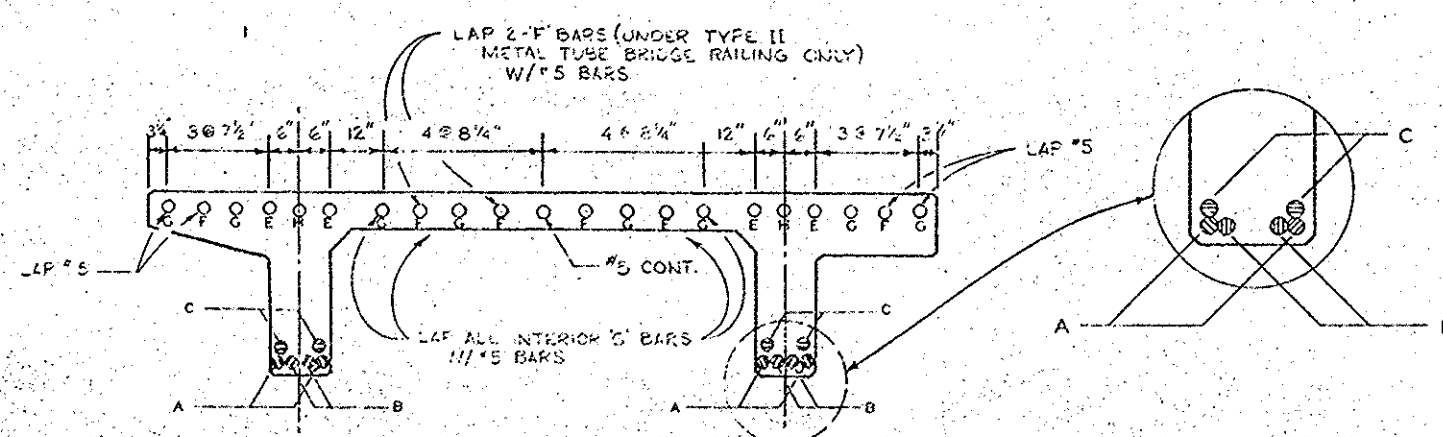

AS BUILD

T-3041(45)

ORANGE COUNTY ROAD DEPARTMENT

GARDEN GROVE BLVD.
BRIDGE SA-18
OVER

SANTA ANA RIVER

SUPERSTRUCTURE LAYOUT
& DECK REINFORCEMENT

AS NOTED

SHEEP 9 of 11

Dr. 7(10644)