




EXACT LEVEL & TOLERANCE - IN - 0.0005 INCHES - N.T. U.S.A.

STRAIGHT EDGE RULE SE-48

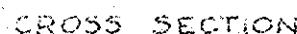

60000 30000 20000 10000 0

AS BUILT

NOTE

ADDITIONAL BORING DATA TAKEN
DURING CONSTRUCTION IS ON FILE
AT MATERIAL LAB

LITHOLOGICAL MATERIALS		CONSISTENCY CLASSIFICATION		LEGEND OF BORING OPERATIONS	
Symbol	Description	Symbol	Description	Symbol	Description
...	...	...	...	...	...

T-3041(45)

SRT 17 CF 17

DR. 10644