



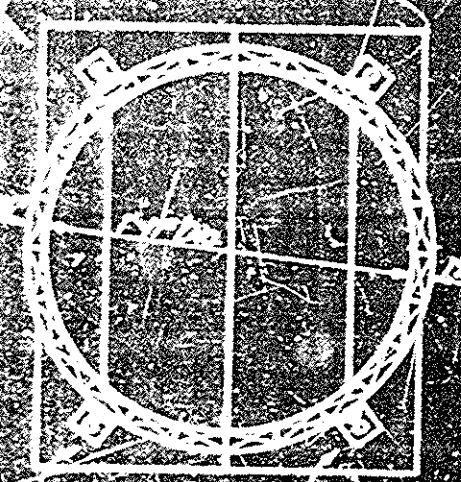

PLAN

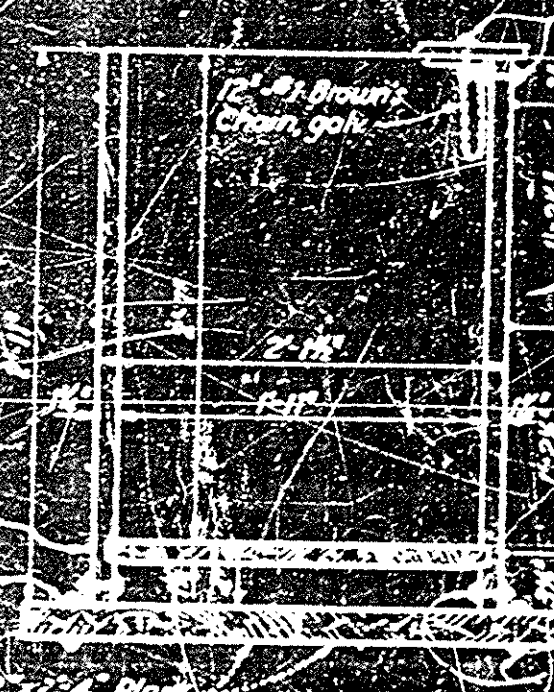

ELEVATION




SECTION A-A

REDWOOD FIRE TANK




STAVE DETAIL

Note:
Tank to be made of clear
hard redwood tank stock.
All hardware to be galvanized.
Outside of barrels and both
surfaces of cover to be painted
same as railing.

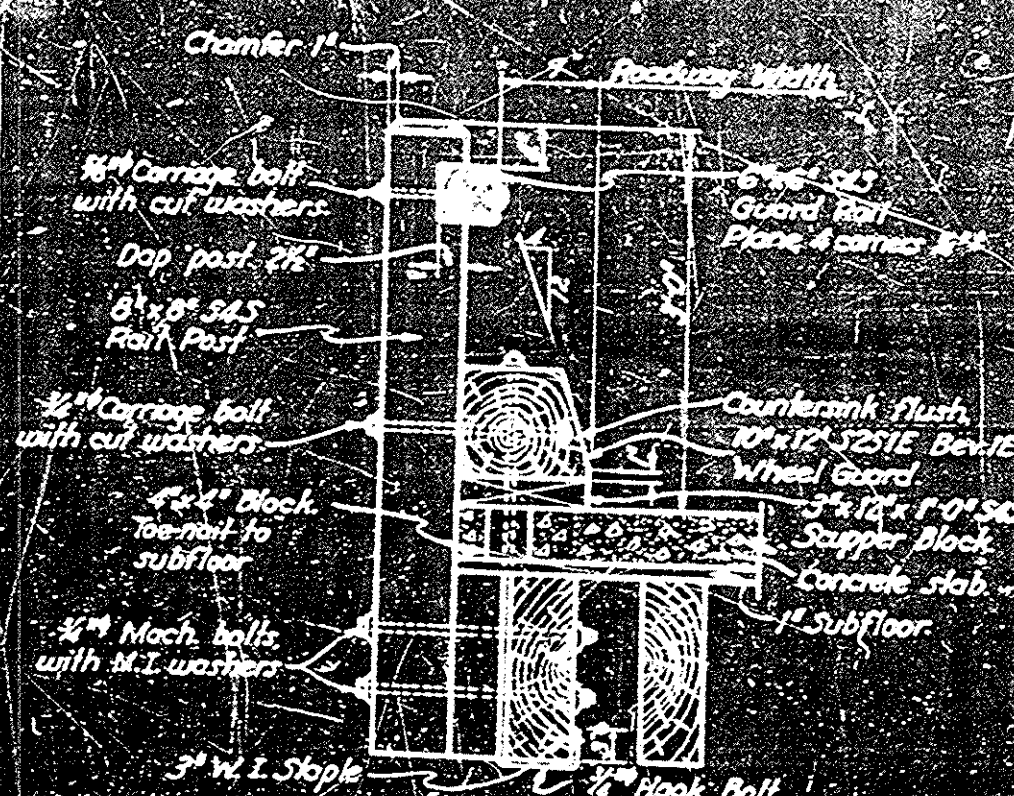


DETAILS FOR
CROWNED ROADWAY

Scale: 1"=1'-0"

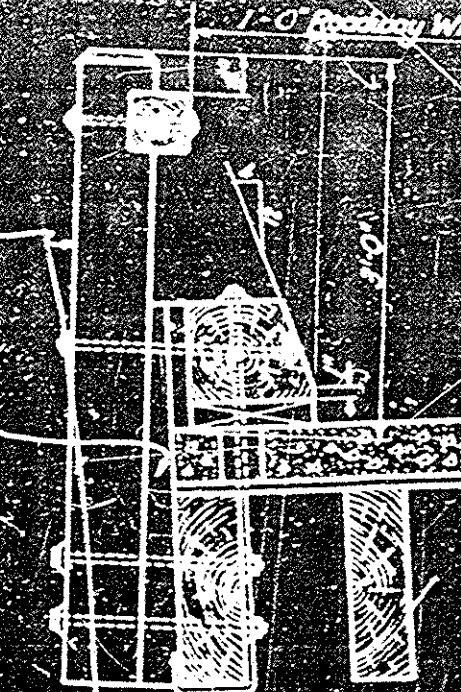


DETAILS FOR
SUPERELEVATED ROADWAY

Scale: 1"=1'-0"

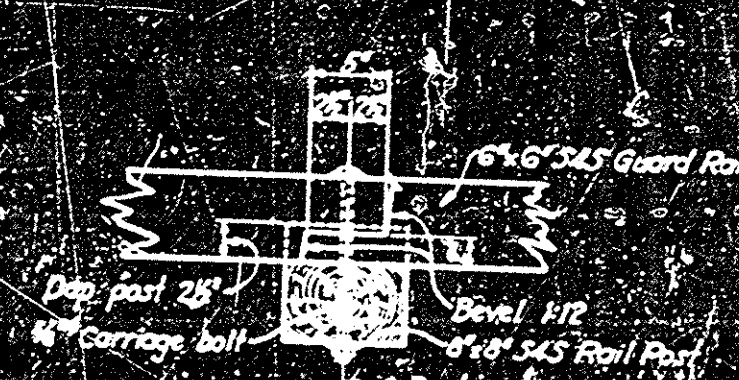

TIMBER RAIL SPLICE

Scale: 1/4"=1'-0"

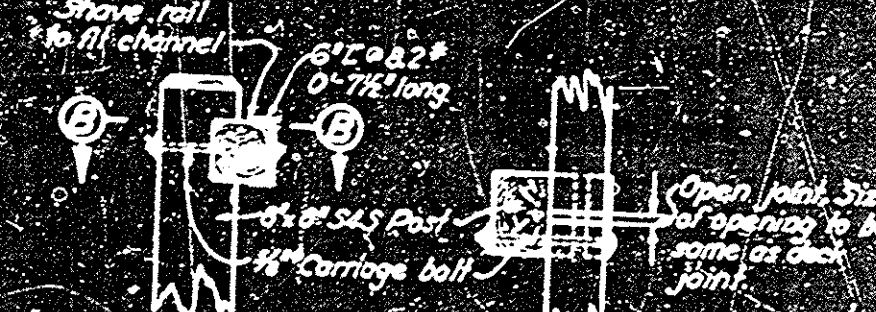

EXPANSION JOINTS IN RAILS

Joints to be located at posts nearest
expansion joints in deck.
Scale: 1"=1'-0"

ITEM	QUANTITY	UNIT	PRICE	TOTAL
1. Redwood tank stock	100	cu ft	1.50	150.00
2. Galvanized hardware	100	lb	0.10	10.00
3. Galvanized paint	100	gal	0.20	20.00
4. Railing	100	lb	0.10	10.00
5. Subfloor	100	sq ft	0.10	10.00
6. Concrete slab	100	sq ft	0.10	10.00
7. Hook bolts	100	lb	0.10	10.00
8. Carriage bolts	100	lb	0.10	10.00
9. Guard rail	100	lb	0.10	10.00
10. Supper block	100	lb	0.10	10.00
11. Counter sink flush	100	lb	0.10	10.00
12. 1/2" x 12" x 12" Bevel	100	lb	0.10	10.00
13. 1/2" x 12" x 12" Bevel	100	lb	0.10	10.00
14. 1/2" x 12" x 12" Bevel	100	lb	0.10	10.00
15. 1/2" x 12" x 12" Bevel	100	lb	0.10	10.00
16. 1/2" x 12" x 12" Bevel	100	lb	0.10	10.00
17. 1/2" x 12" x 12" Bevel	100	lb	0.10	10.00
18. 1/2" x 12" x 12" Bevel	100	lb	0.10	10.00
19. 1/2" x 12" x 12" Bevel	100	lb	0.10	10.00
20. 1/2" x 12" x 12" Bevel	100	lb	0.10	10.00

STANDARD & LIGHT
CLEARANCE MARKER

BRIDGE SA 8
Jefferson St
1 mi. N. of
Sheet 2 of 3
Redwood 1 scale as shown
Blue print

ITEM	QUANTITY	UNIT	PRICE	TOTAL
1. Redwood tank stock	100	cu ft	1.50	150.00
2. Galvanized hardware	100	lb	0.10	10.00
3. Galvanized paint	100	gal	0.20	20.00
4. Railing	100	lb	0.10	10.00
5. Subfloor	100	sq ft	0.10	10.00
6. Concrete slab	100	sq ft	0.10	10.00
7. Hook bolts	100	lb	0.10	10.00
8. Carriage bolts	100	lb	0.10	10.00
9. Guard rail	100	lb	0.10	10.00
10. Supper block	100	lb	0.10	10.00
11. Counter sink flush	100	lb	0.10	10.00
12. 1/2" x 12" x 12" Bevel	100	lb	0.10	10.00
13. 1/2" x 12" x 12" Bevel	100	lb	0.10	10.00
14. 1/2" x 12" x 12" Bevel	100	lb	0.10	10.00
15. 1/2" x 12" x 12" Bevel	100	lb	0.10	10.00
16. 1/2" x 12" x 12" Bevel	100	lb	0.10	10.00
17. 1/2" x 12" x 12" Bevel	100	lb	0.10	10.00
18. 1/2" x 12" x 12" Bevel	100	lb	0.10	10.00
19. 1/2" x 12" x 12" Bevel	100	lb	0.10	10.00
20. 1/2" x 12" x 12" Bevel	100	lb	0.10	10.00