
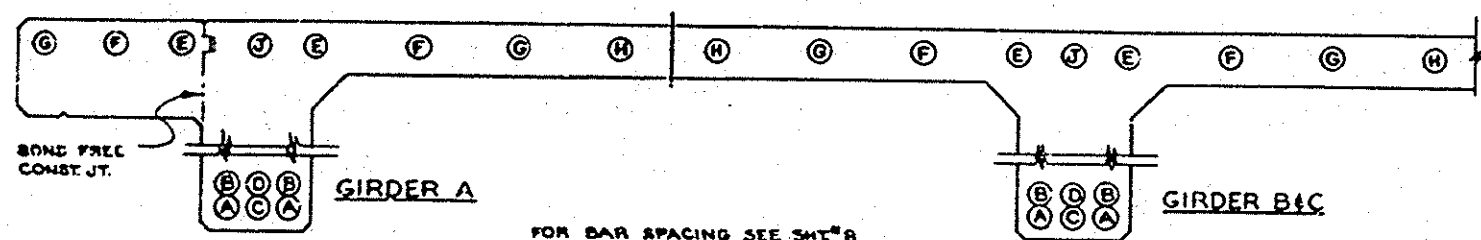
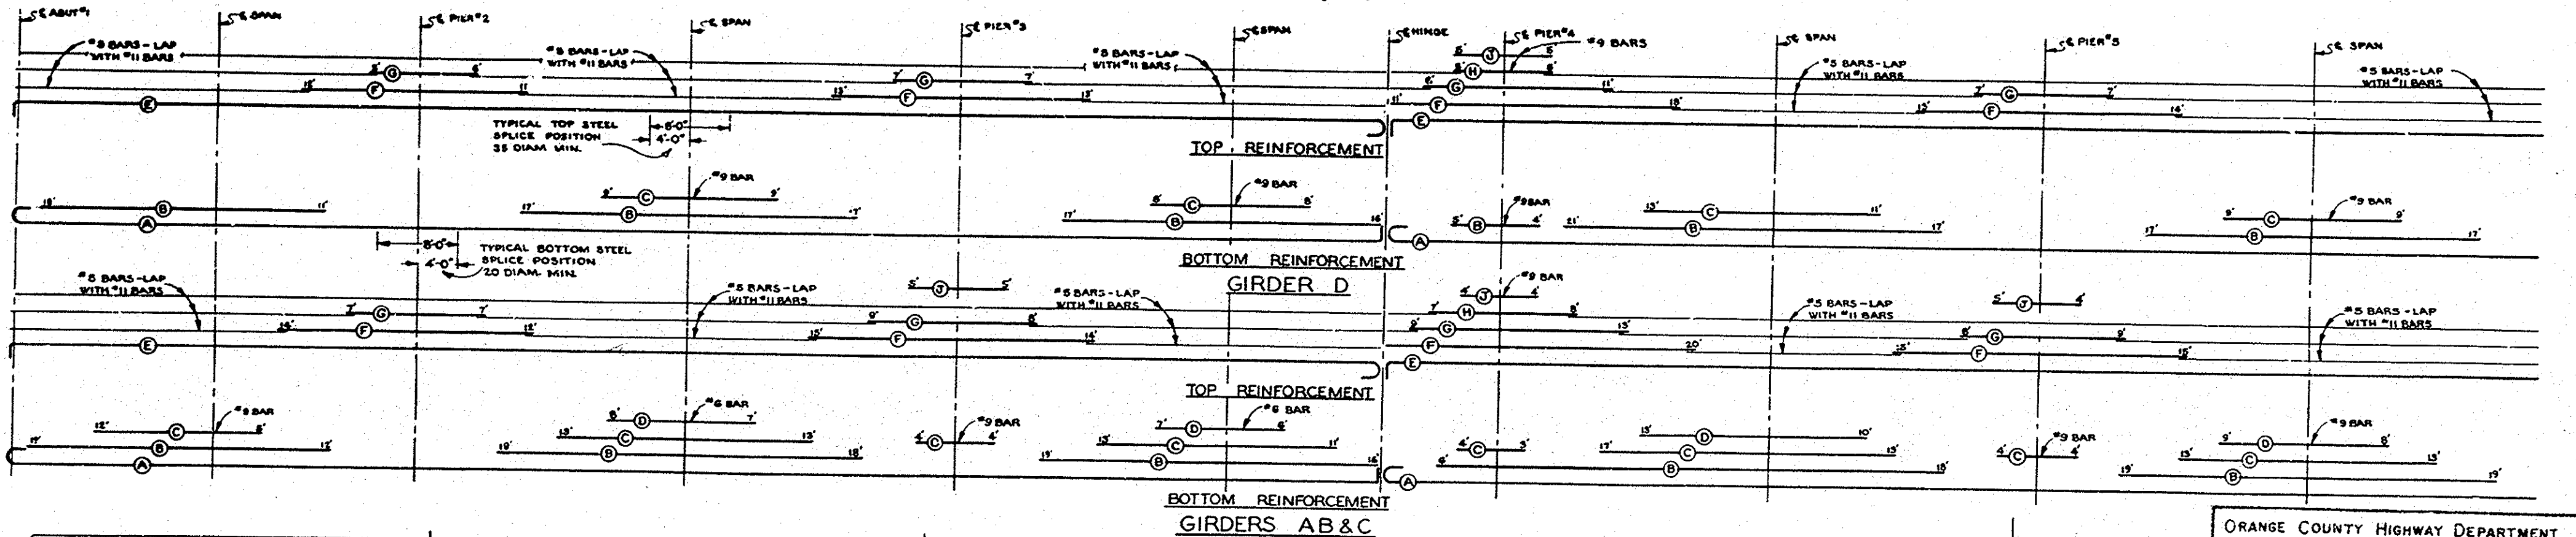
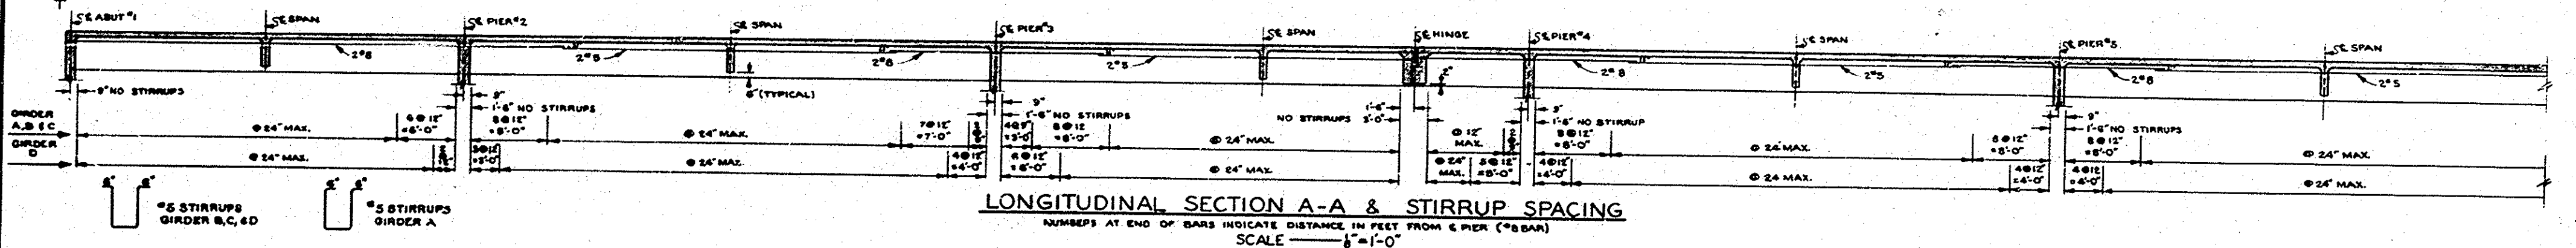



DECK REINF:
#5 @ 10'
#5 @ 10'

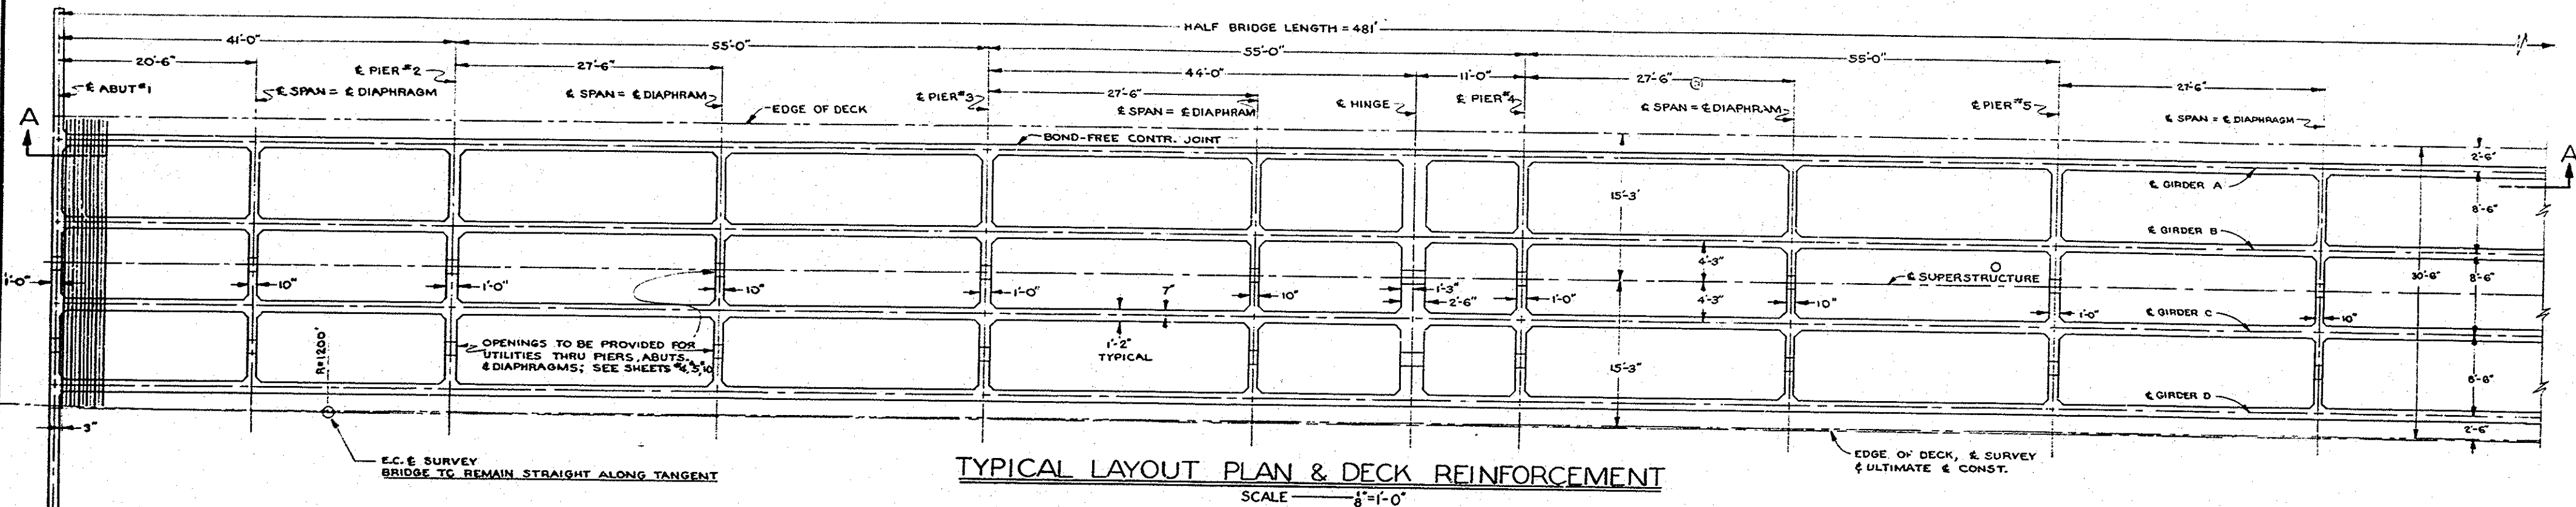

GIRDER REINFORCEMENT

TOP BARS DIM. FROM E PIER
ALL STEEL #11 EXCEPT AS NOTED
SCALE 1/8" = 1'-0"

Bridge No. 54-1-P
Dowling Ave. Bridge
Sheet 2 of 17
Red. 22.5:1 Scale 1/8" = 1'-0"
Vellum

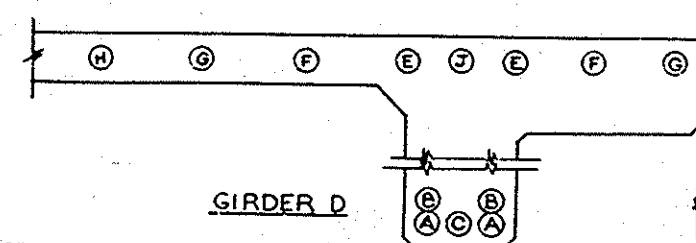

AS BUILT

ORANGE COUNTY HIGHWAY DEPARTMENT
DOWLING AVENUE BRIDGE
ACROSS
SANTA ANA RIVER
SUPERSTRUCTURE & REINFORCEMENT
SCALE AS NOTED
SHEET 6 OF 17

SA-8