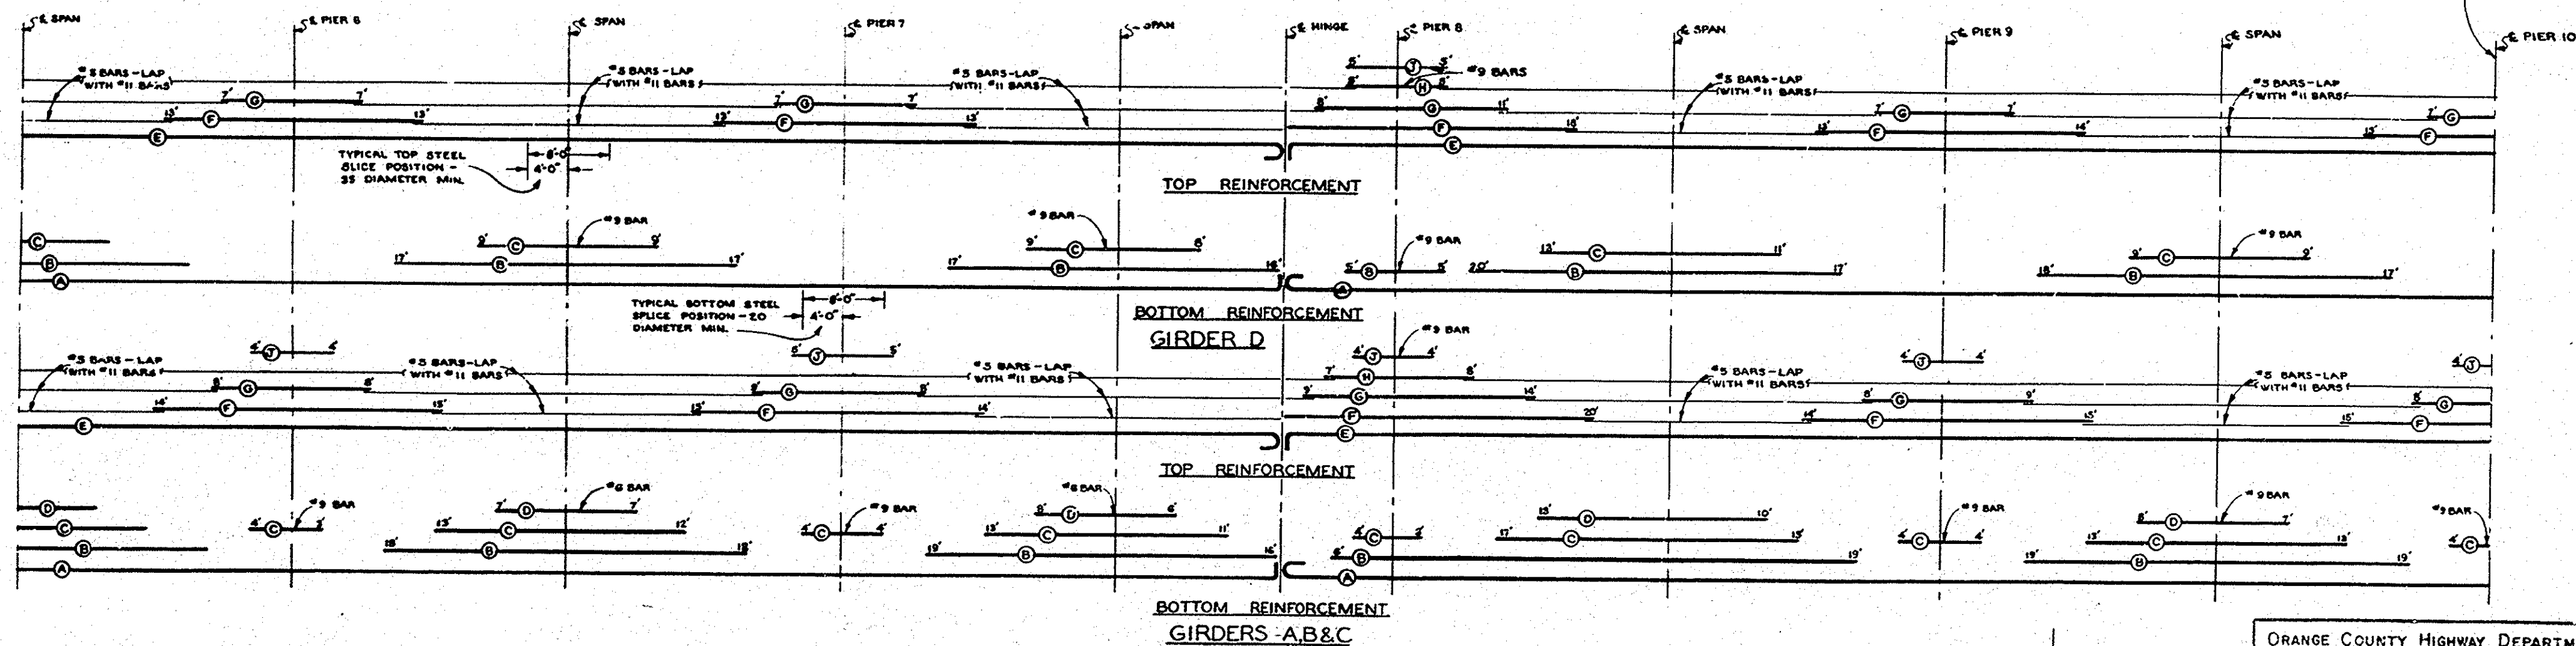
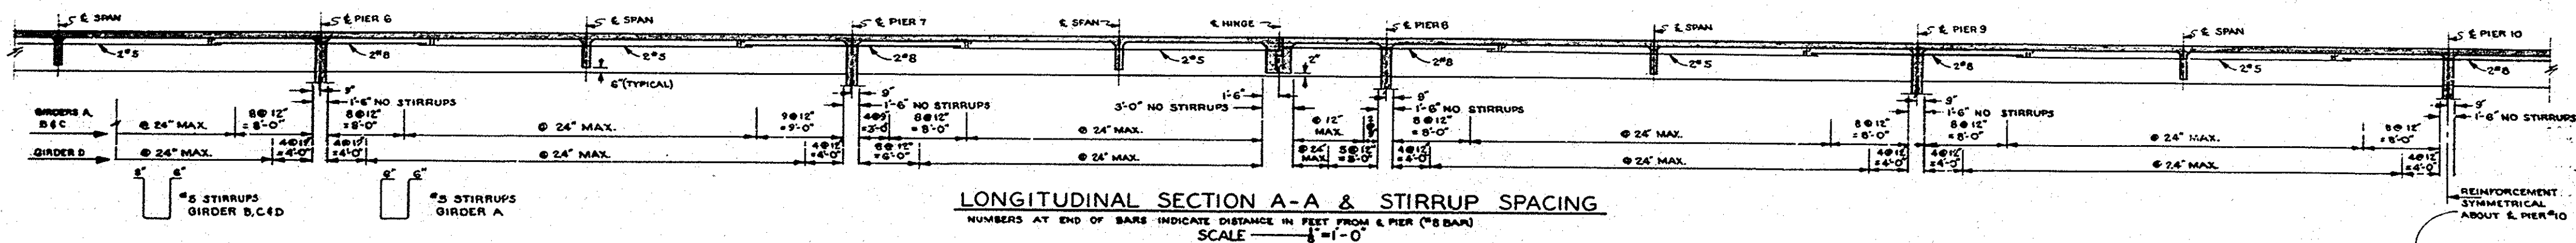
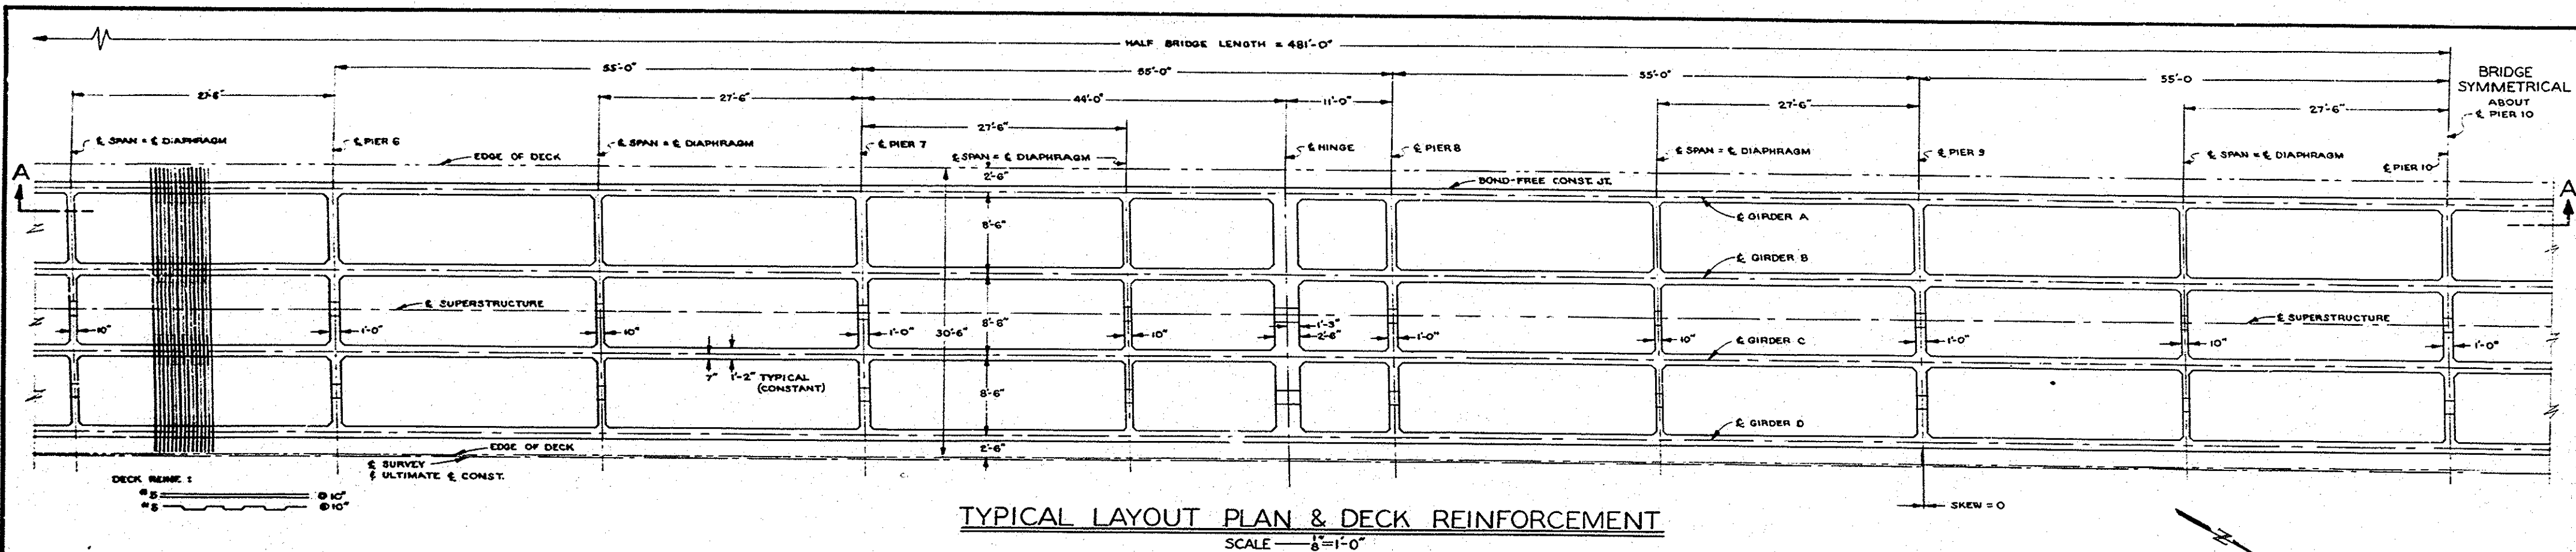


AS BUILT

SURVEY MICROFILMED

DEC 28 1964

ORANGE COUNTY HIGHWAY DEPARTMENT

8.4
63 DOWLING AVENUE BRIDGE

ACROSS

SANTA ANA RIVER

SUPERSTRUCTURE &
REINFORCEMENT

SCALE AS NOTED SHEET 7 OF 17

SA-P