



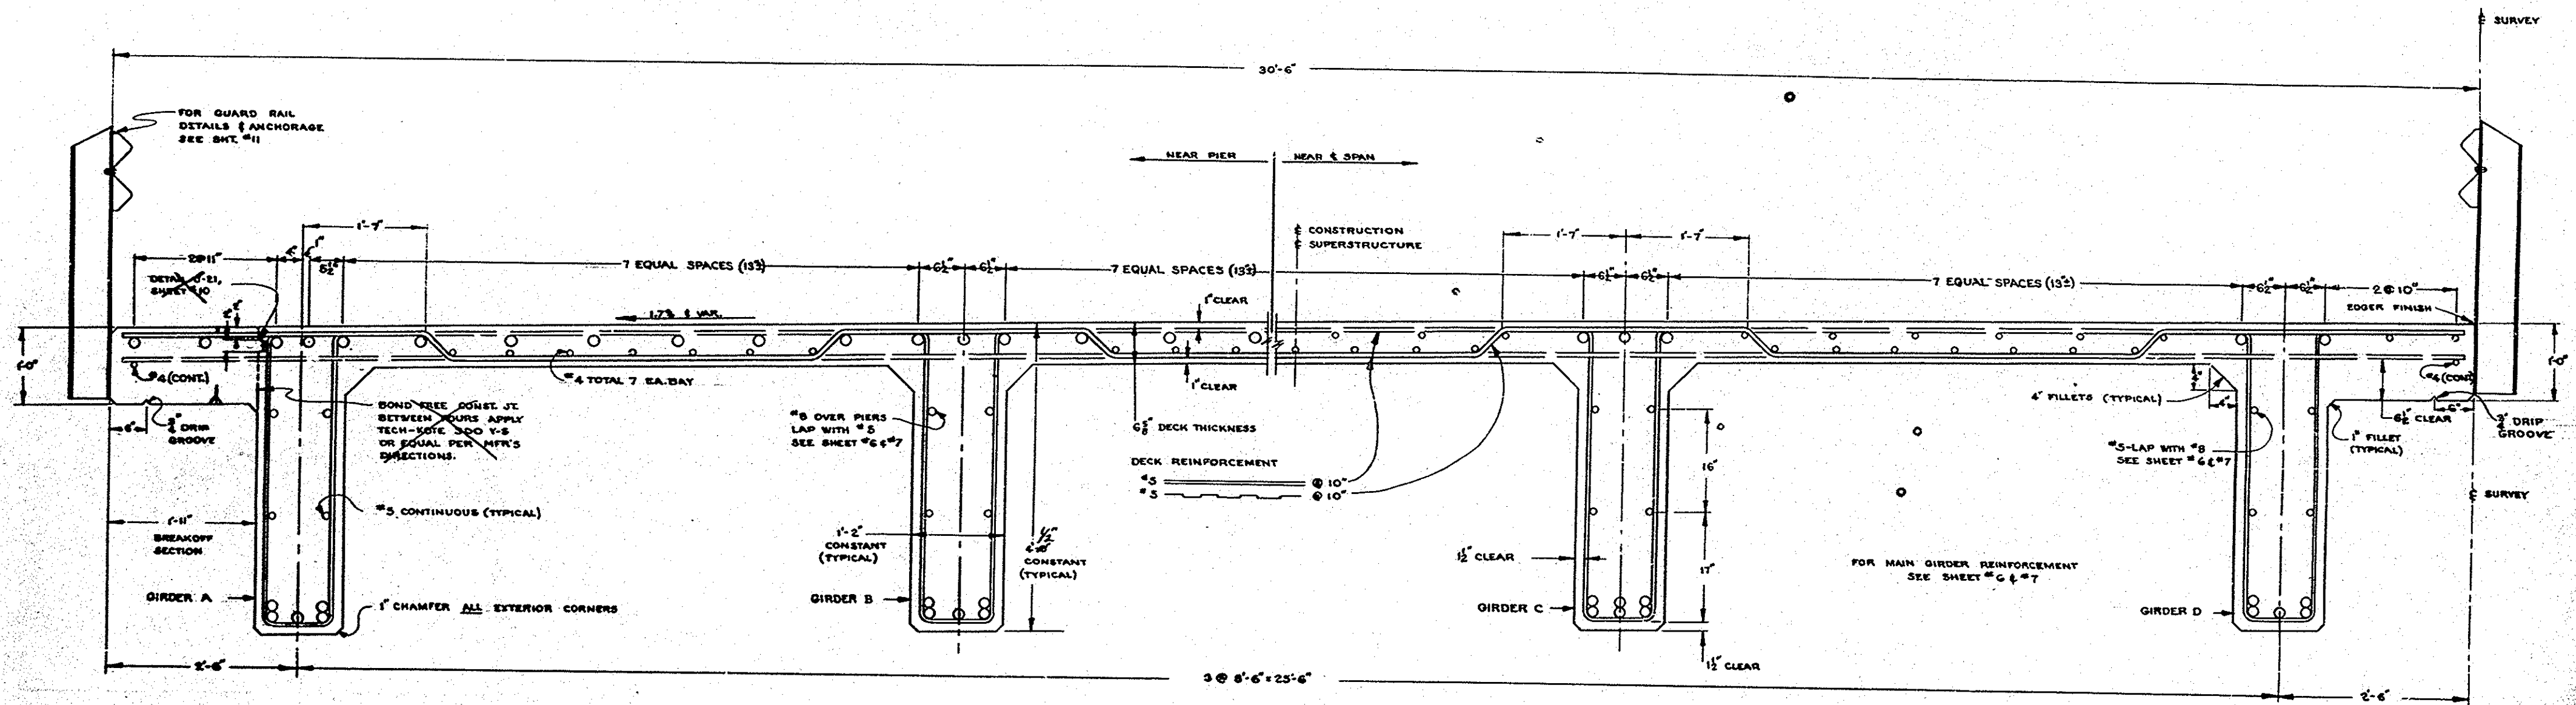


TYPICAL SECTION
SCALE 1"=1'-0"

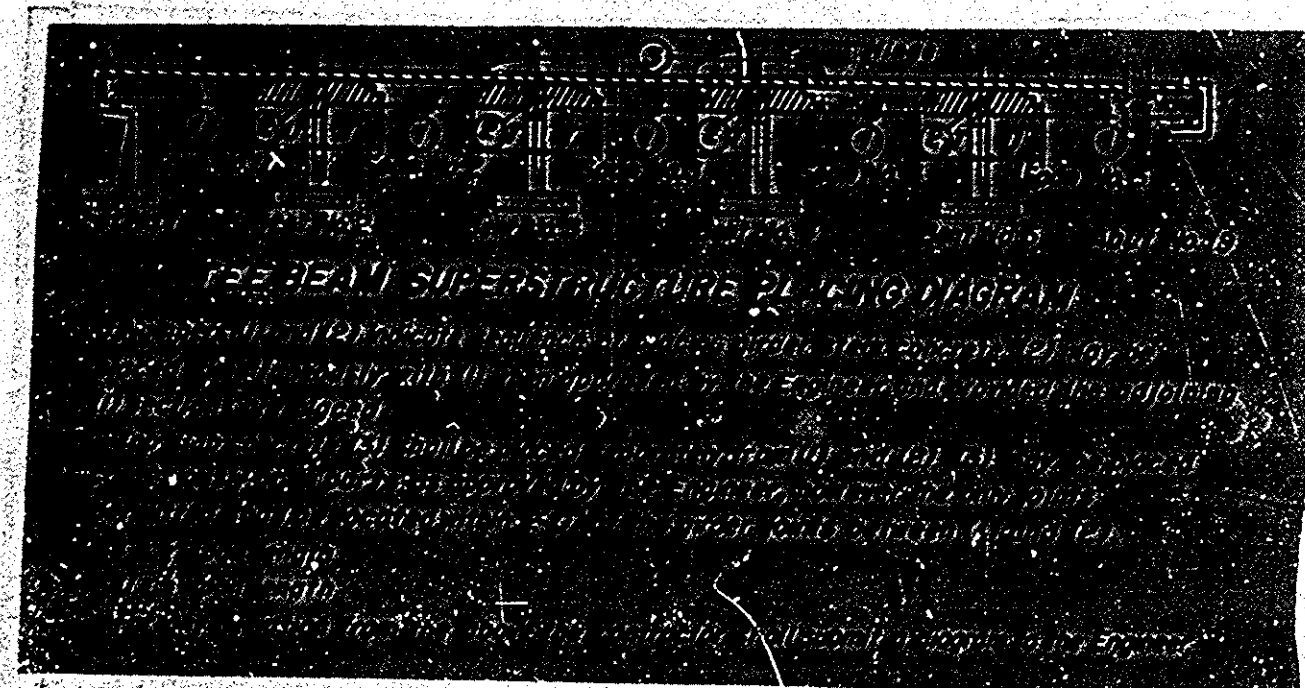

PLACED MONOLITHICALLY

Bridge No. Sa. -8
Dowling Ave. Bridge
Sheet 8 of 17
Ed. 22.5.1 Scale 1"=1'-0"
Vellum

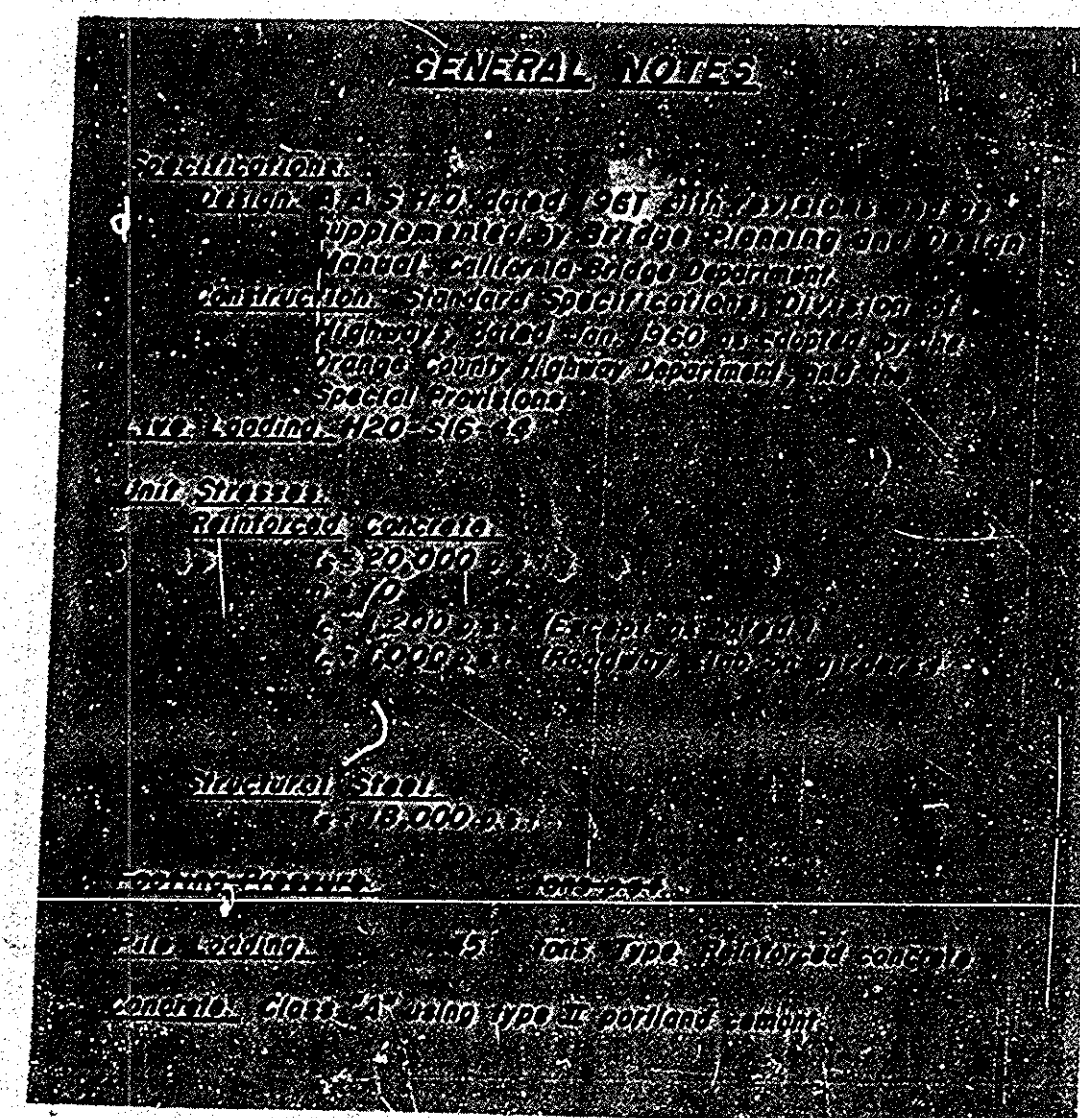

AS BUILT

MICROFILMED
DEC 28 1964

ORANGE COUNTY HIGHWAY DEPARTMENT	
DOWLING AVENUE BRIDGE ACROSS SANTA ANA RIVER	
TYPICAL SECTION	
SCALE AS NOTED	SHEET 8 OF 17

SA-8