

EXACT®


STRAIGHT EDGE RULE SE-48

ORANGE COUNTY
ROAD DEPARTMENT
STATE OF CALIFORNIA

PLANS FOR CONSTRUCTION OF
GLASSELL STREET BRIDGE APPROACHES
TO
BRIDGE SA-8A
ACROSS SANTA ANA RIVER
CHANNEL E-01

INDEX

- 1 TITLE SHEET
- 2 APPROACHES - PLAN
- 3 MISC. DETAILS
- 4.5 CROSS-SECTIONS

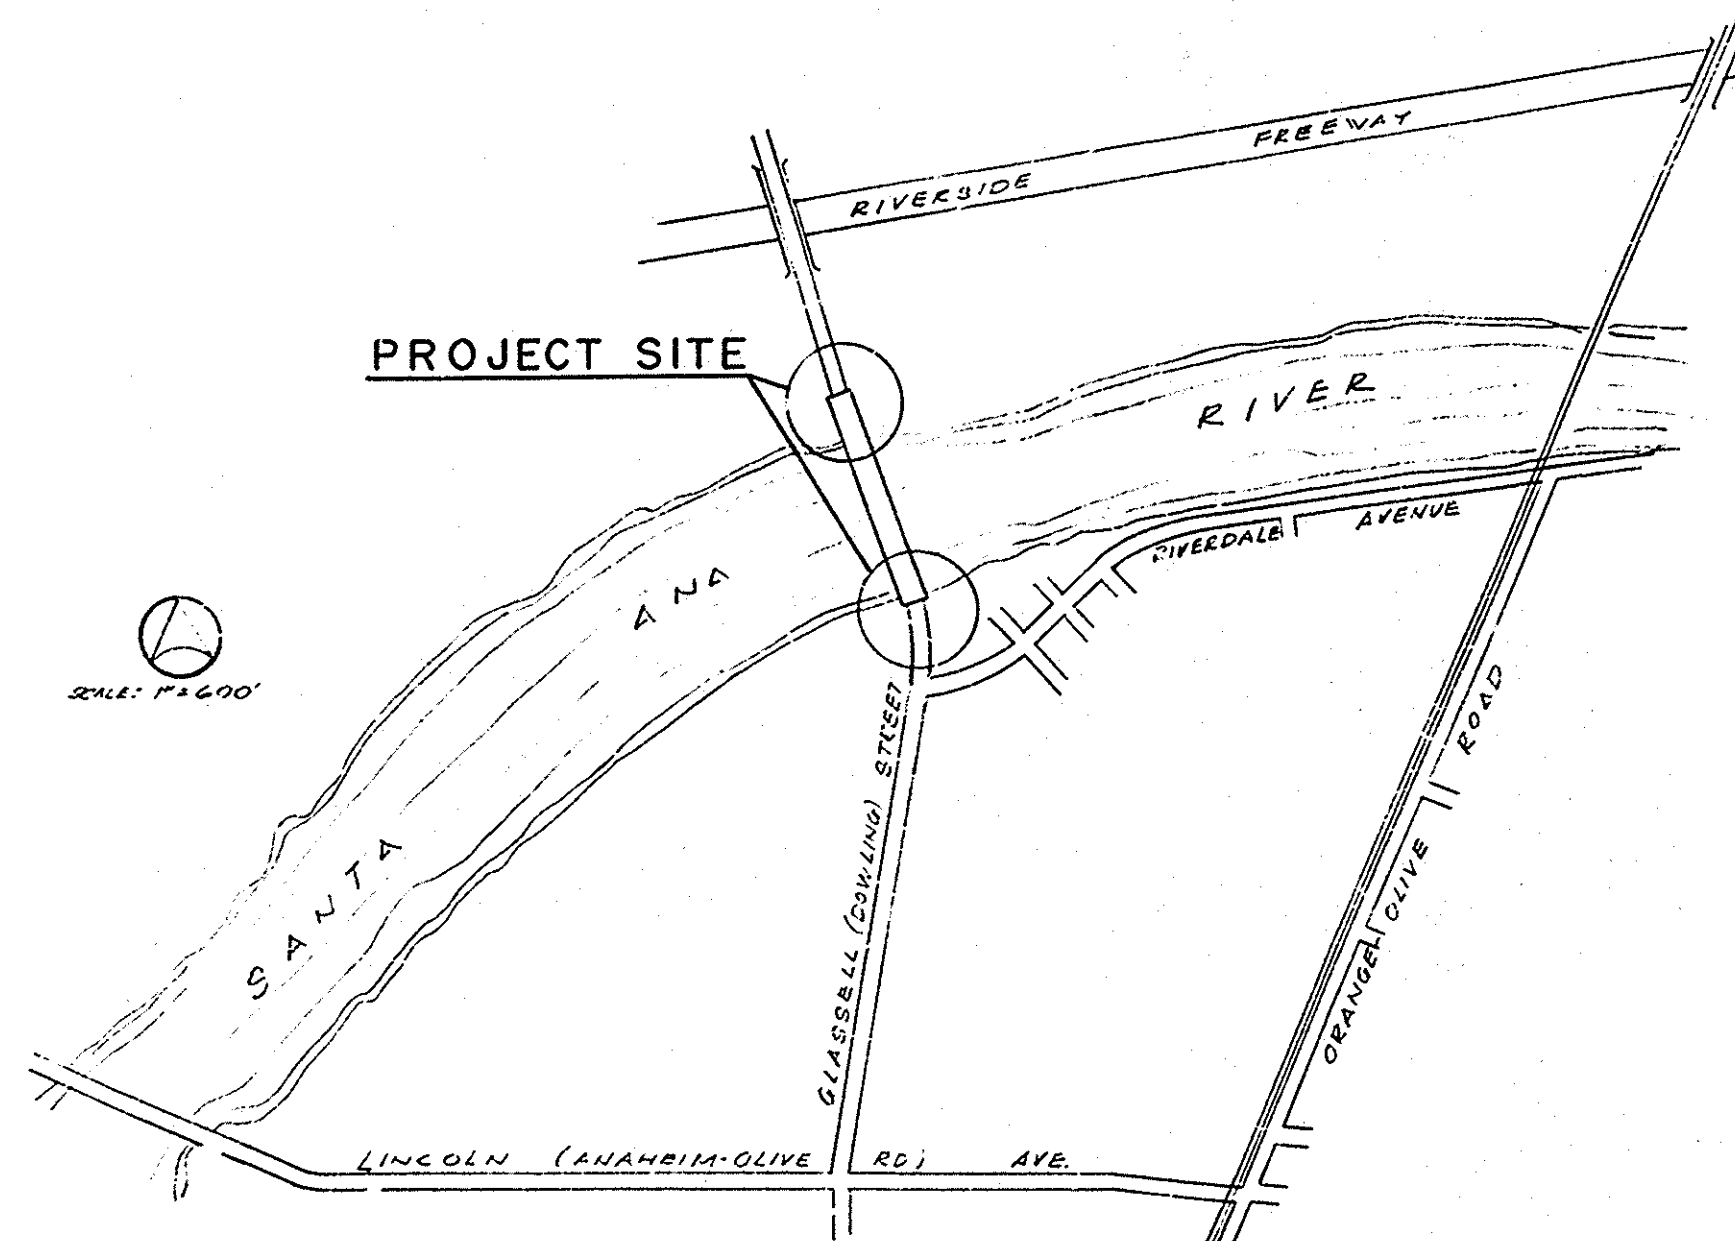

ALL WORK WITHIN THE FLOOD CONTROL DISTRICT RIGHT OF WAY SHALL BE PERFORMED ACCORDANCE WITH THE PROVISIONS OF THE CONSTRUCTION PERMIT GRANTED BY ORANGE COUNTY FLOOD CONTROL DISTRICT AND THE PLANS STAMPED WITH THE APPROVAL OF ORANGE COUNTY FLOOD CONTROL DISTRICT. CONTRACTOR SHALL HAVE A COPY OF SAID PERMIT AND STAMPED PLANS ON THE JOB SITE.

CONSTRUCTION PLANS
Glassell Street Bridge
Sheet 1 of 2
Ref. 22, File Scale: as shown
Tollum

AS BUILT

PREPARED BY

SALKIN ENGINEERING
1045 WEST COLLINS
ORANGE, CALIF
714-633-7261

APPROVED

ROAD COMMISSIONER

#10511
GLASSELL ST. BR. APPROACHES
B.R. SA-8A.

RCE 13420

27 AUGUST 1970

DR. 7 (10511)