
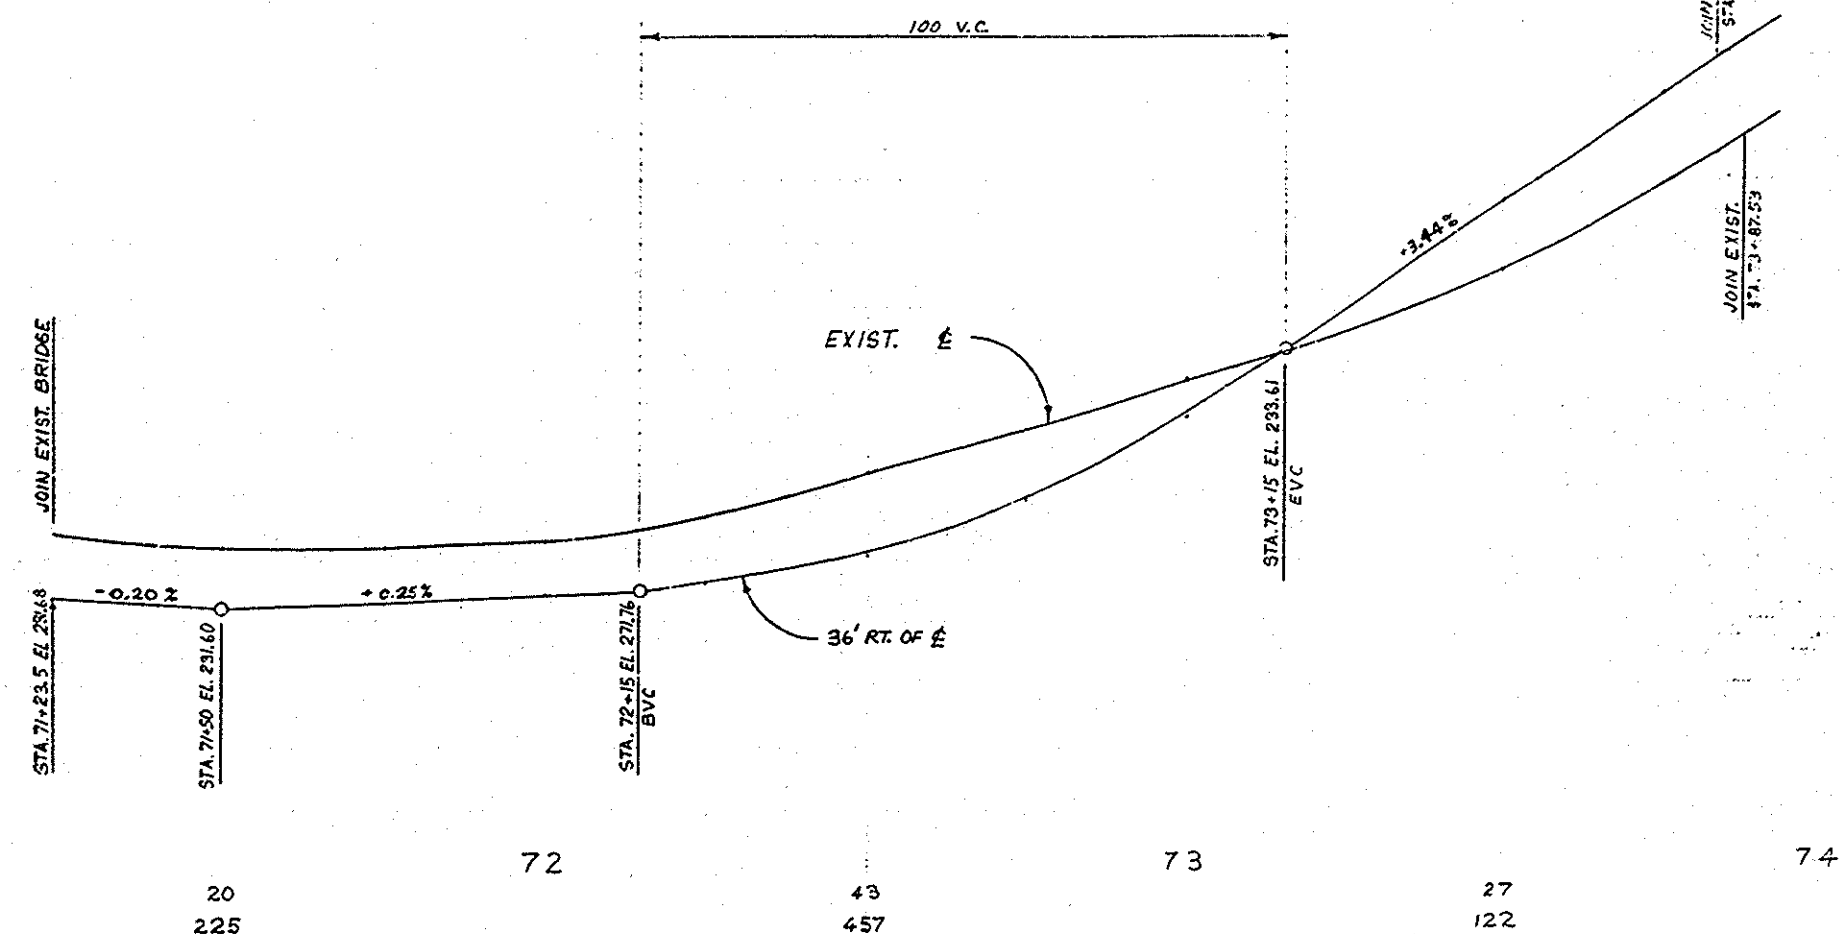
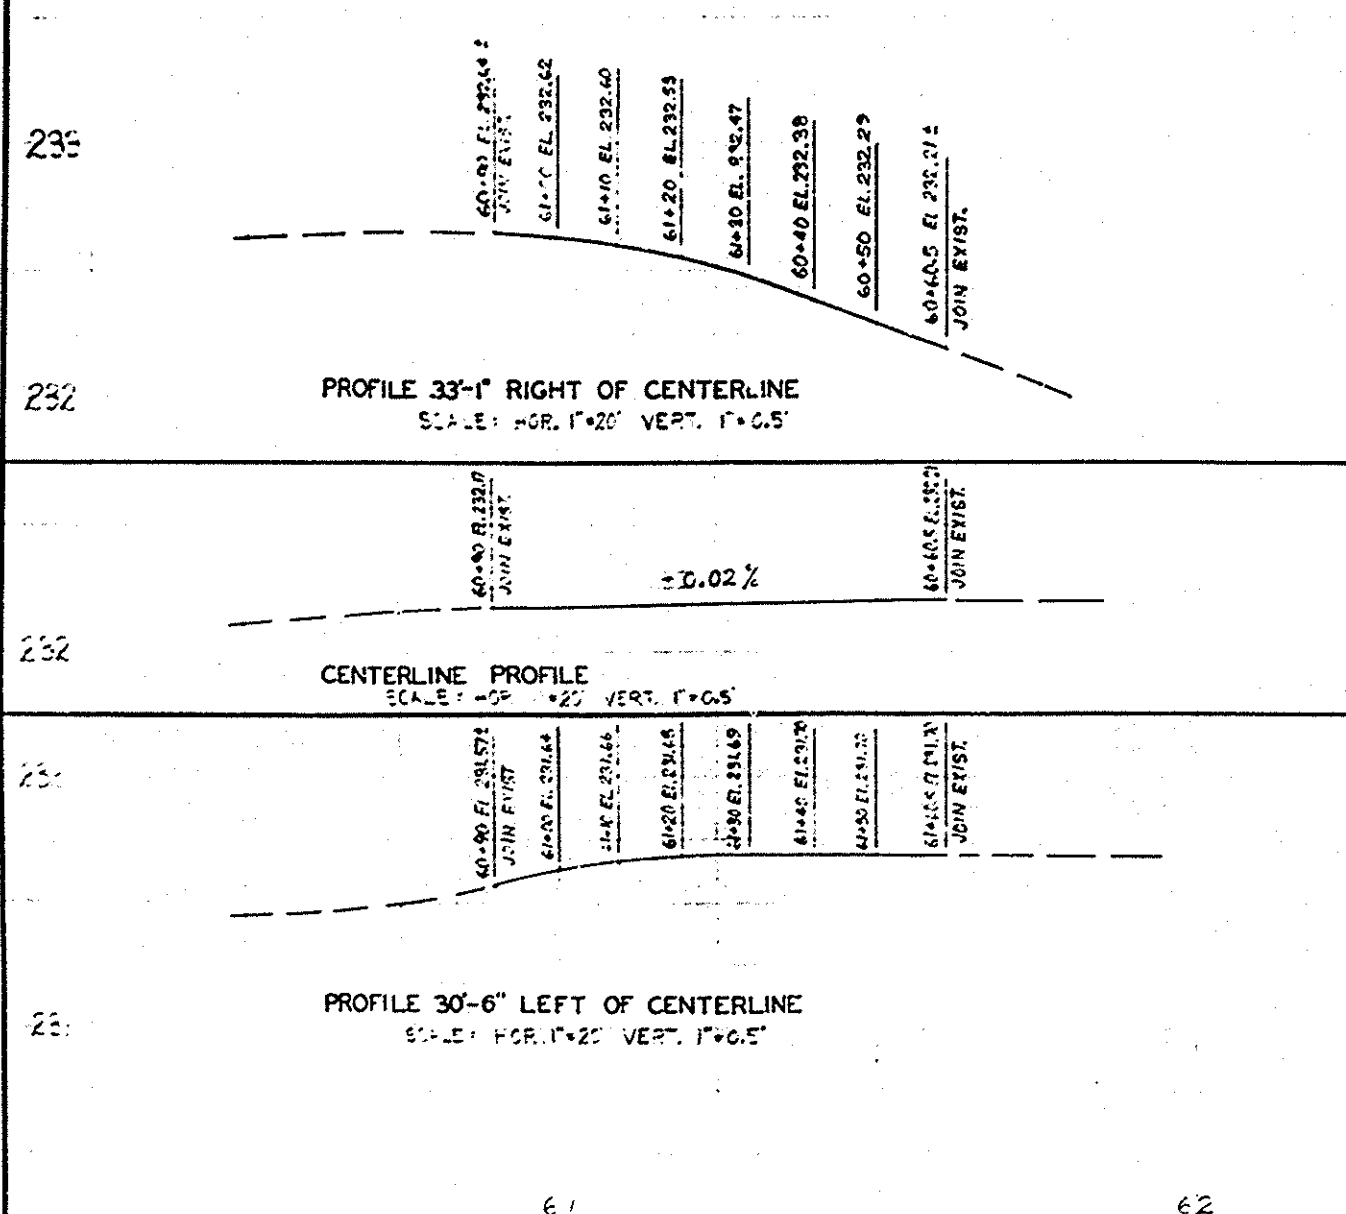


EXACT®

STRAIGHT EDGE RULE SE-48

ORANGE COUNTY ROAD DEPARTMENT
PROJECT GLASSELL APPROACHES
LIMITS AT SANTA ANA RIVER
SCALE 1" = 20' SHEET 2 OF 5

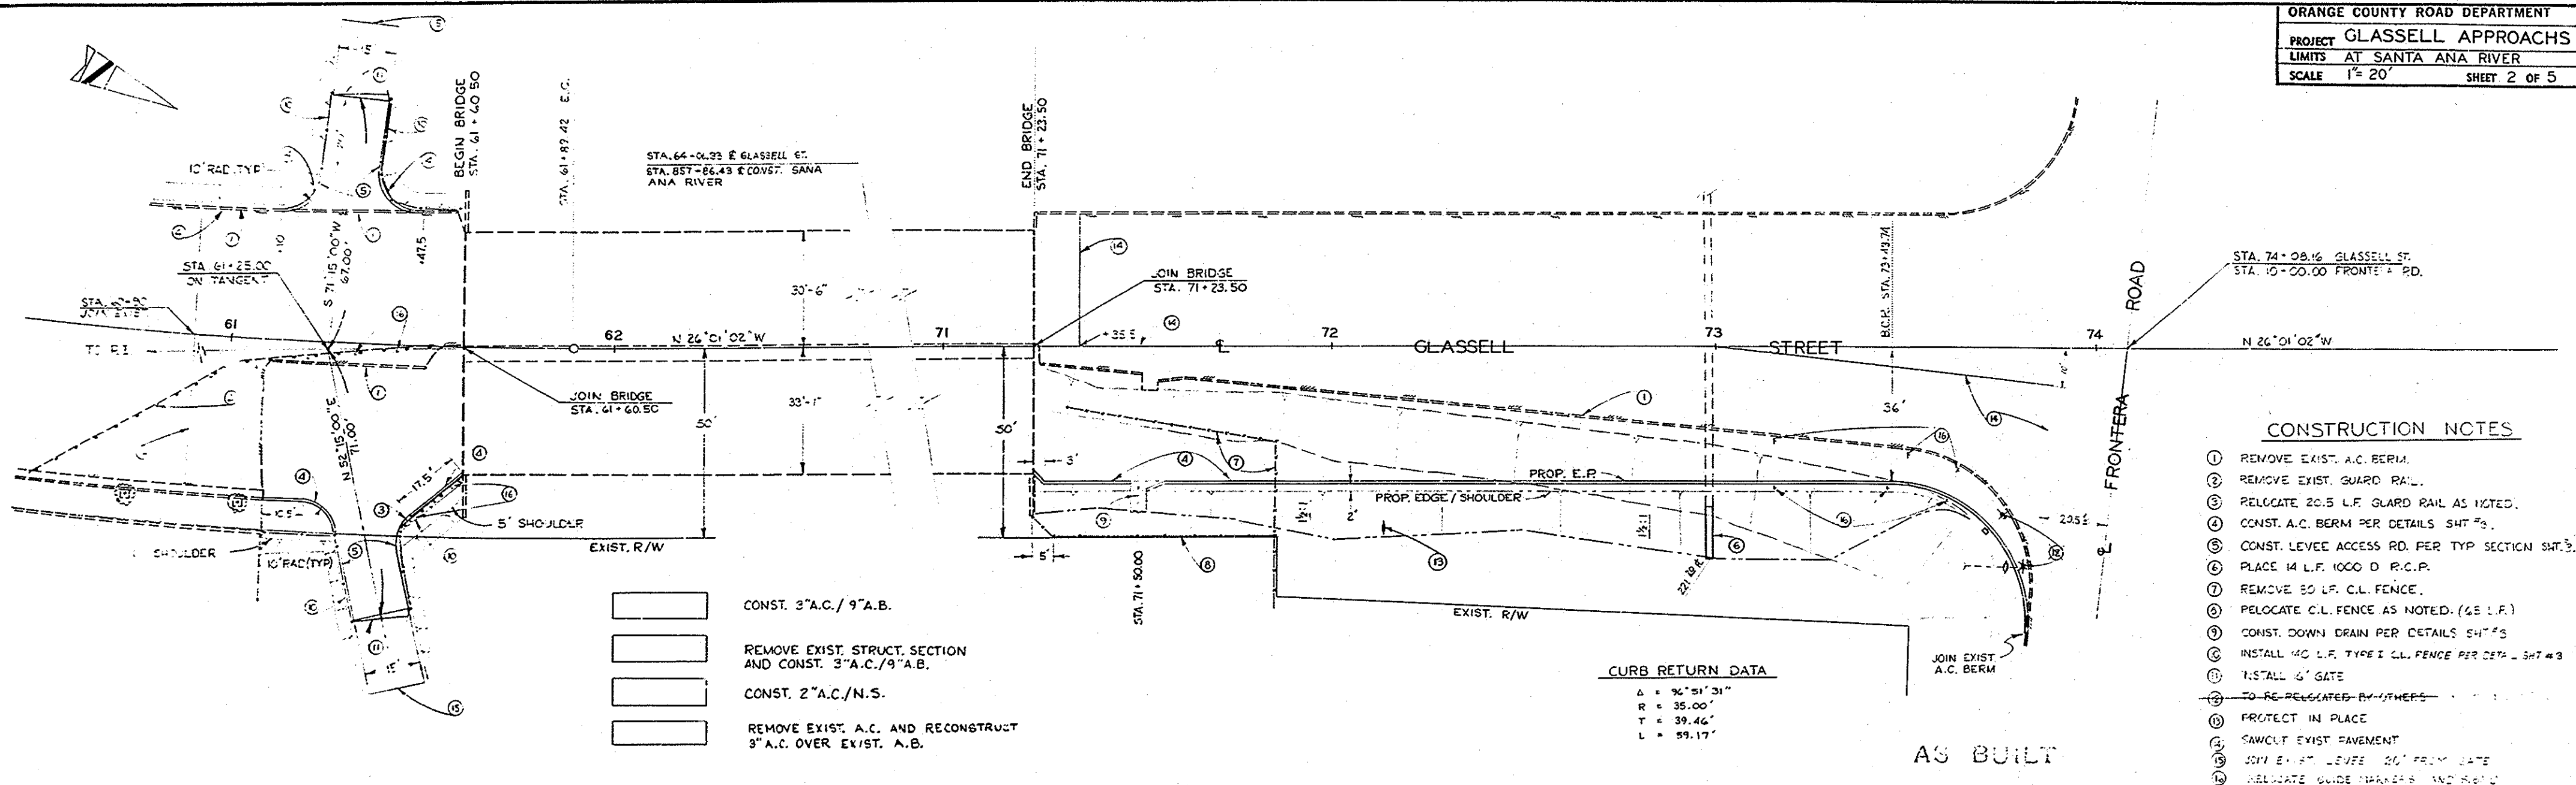

CONSTRUCTION PLANS
GLASSELL ST. BRIDGE
SHEET 2 OF 5
R.D. 20, 711' SOUTHERN AS SHOWN
VOLUME

DR. 7 (10511)