


GLASSELL APPROACHES
AT SANTA ANA RIVER
1"=5' 4 5

AS BUILT

Construction Plans
Glaskell Co., Inc.
SANTA ANA, CALIF.
Filed for Record
March 19, 1910

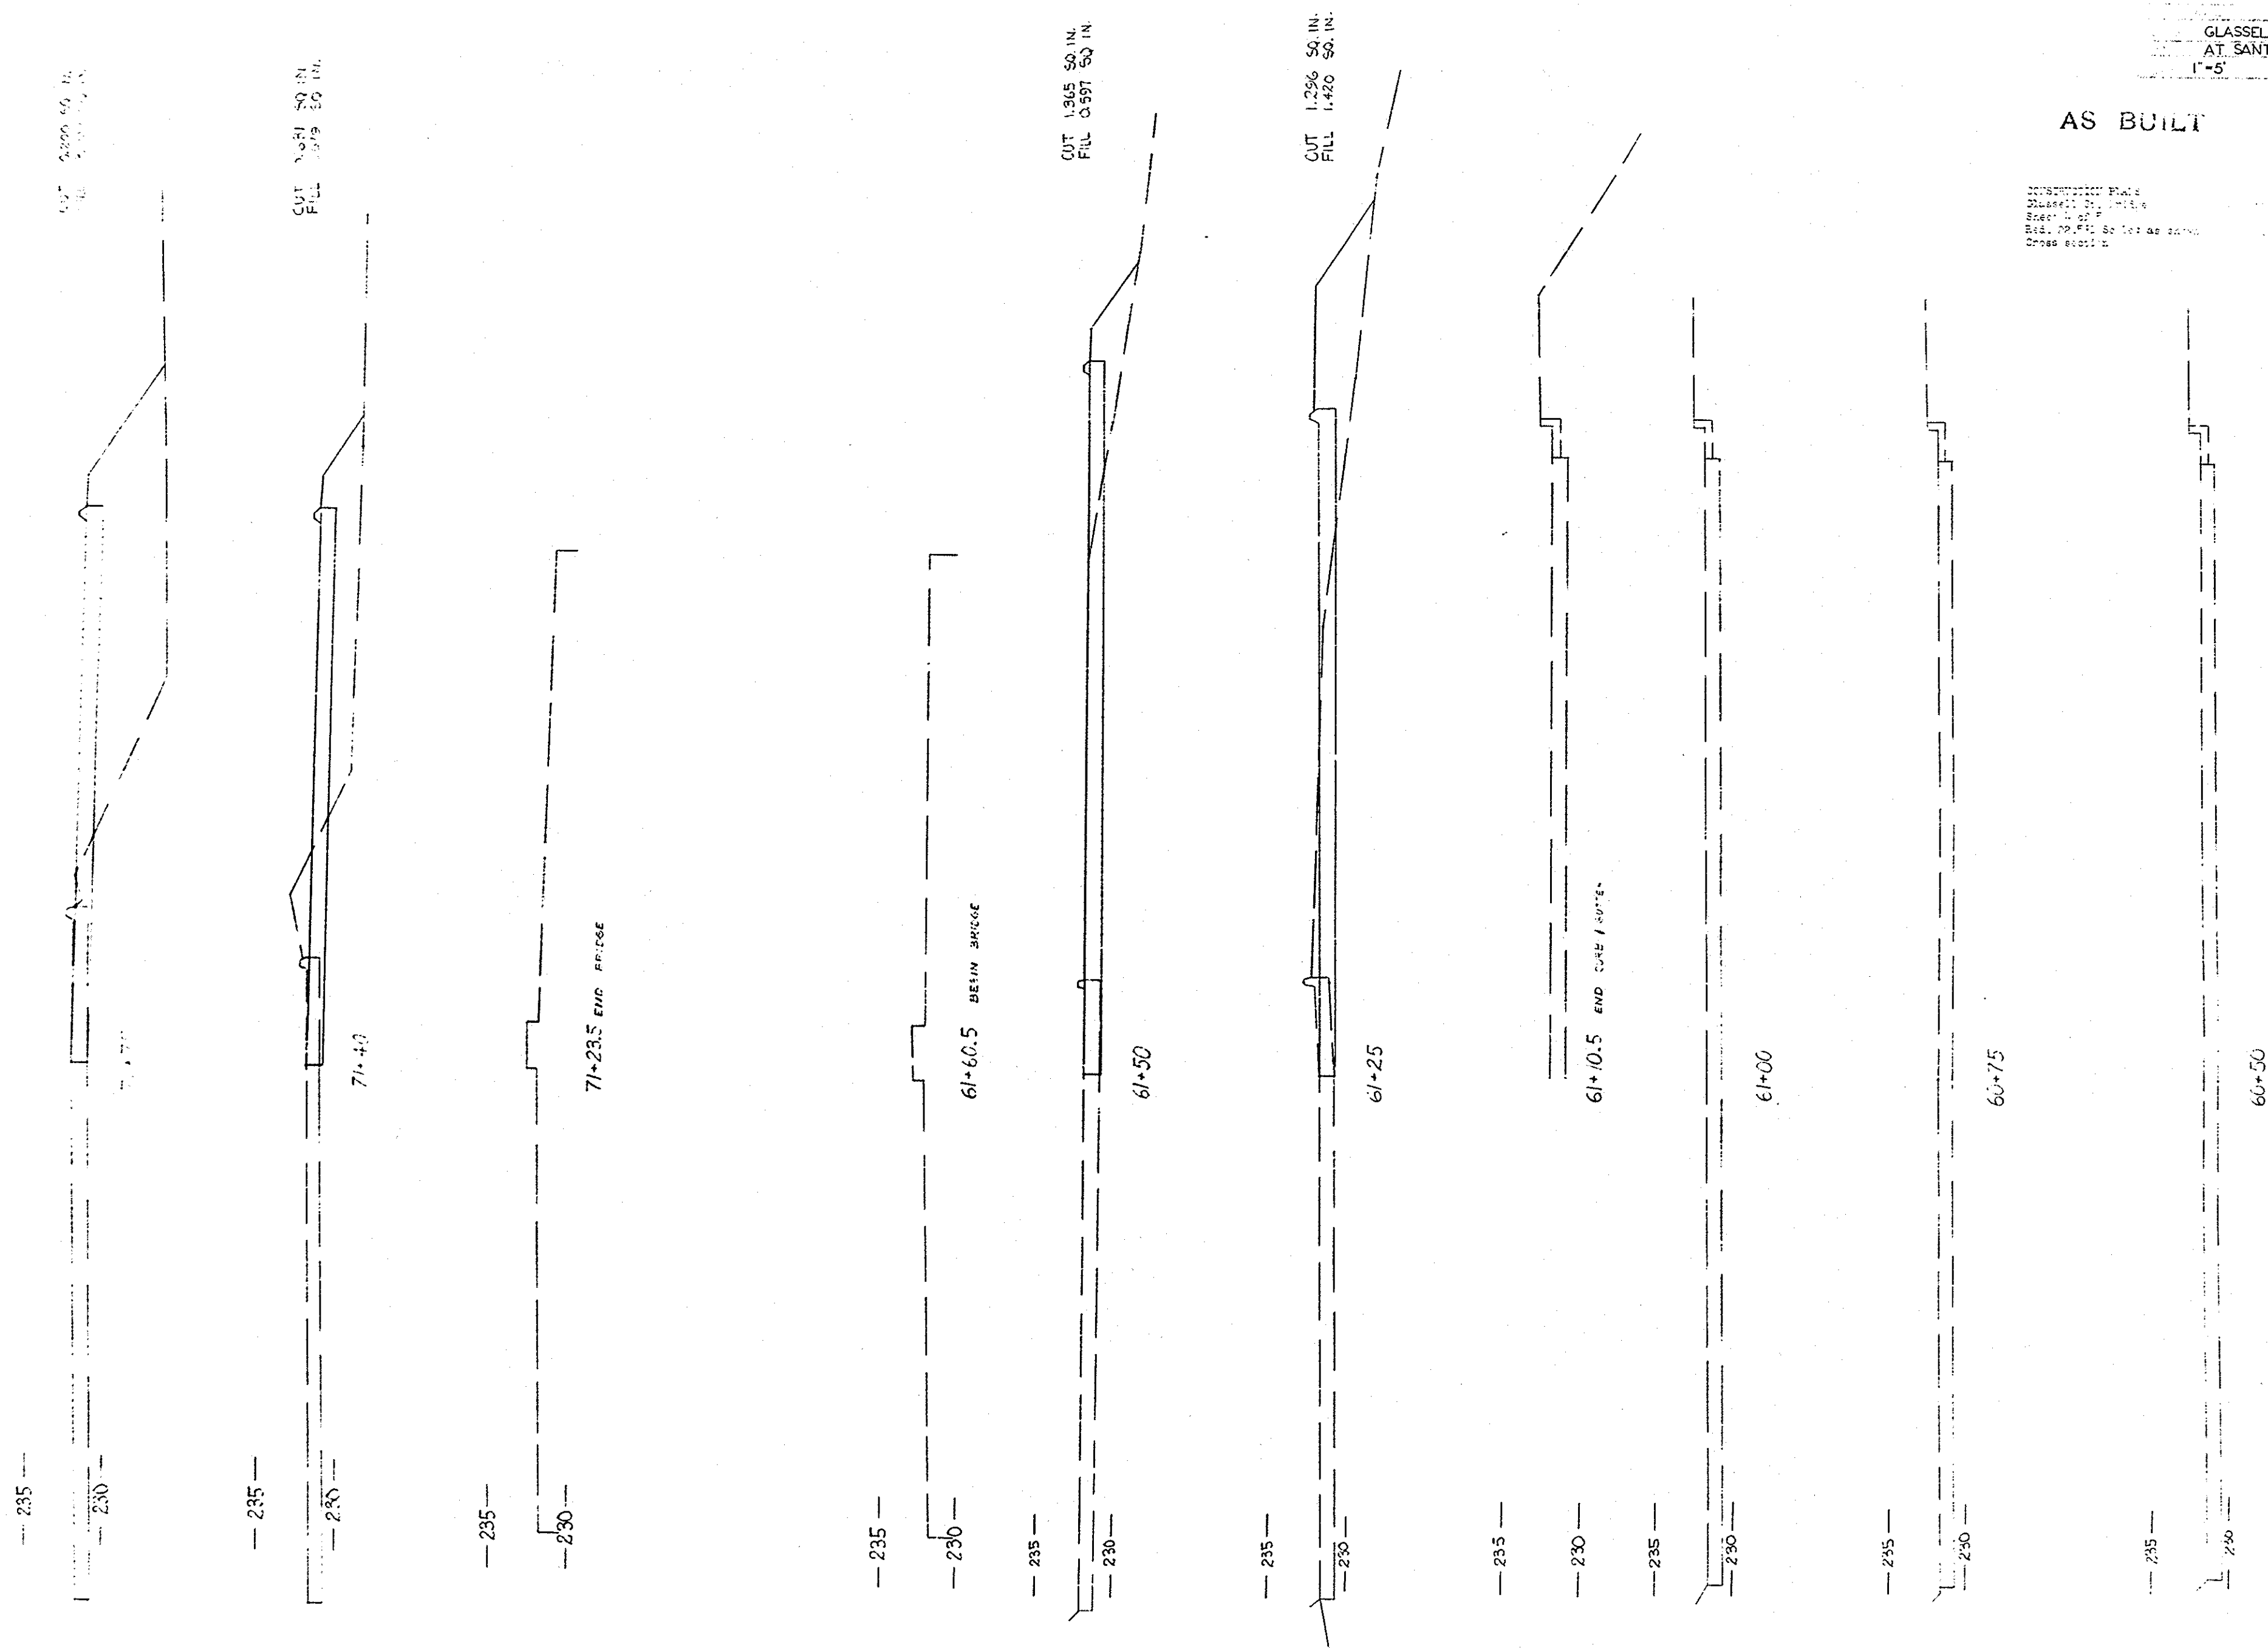

DR.7 (10511)