

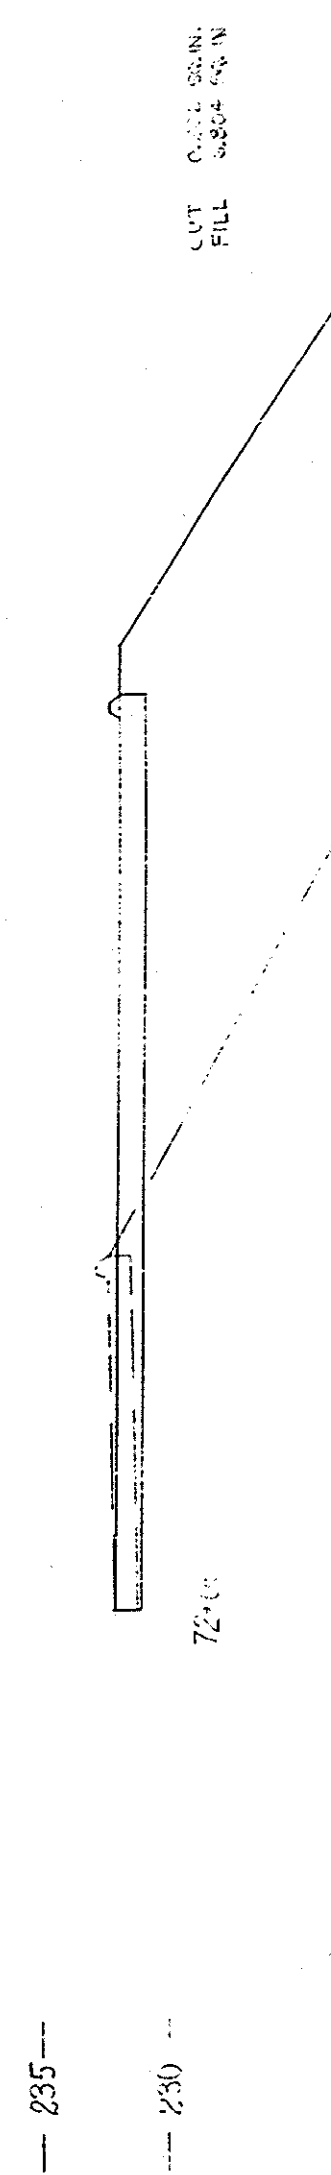
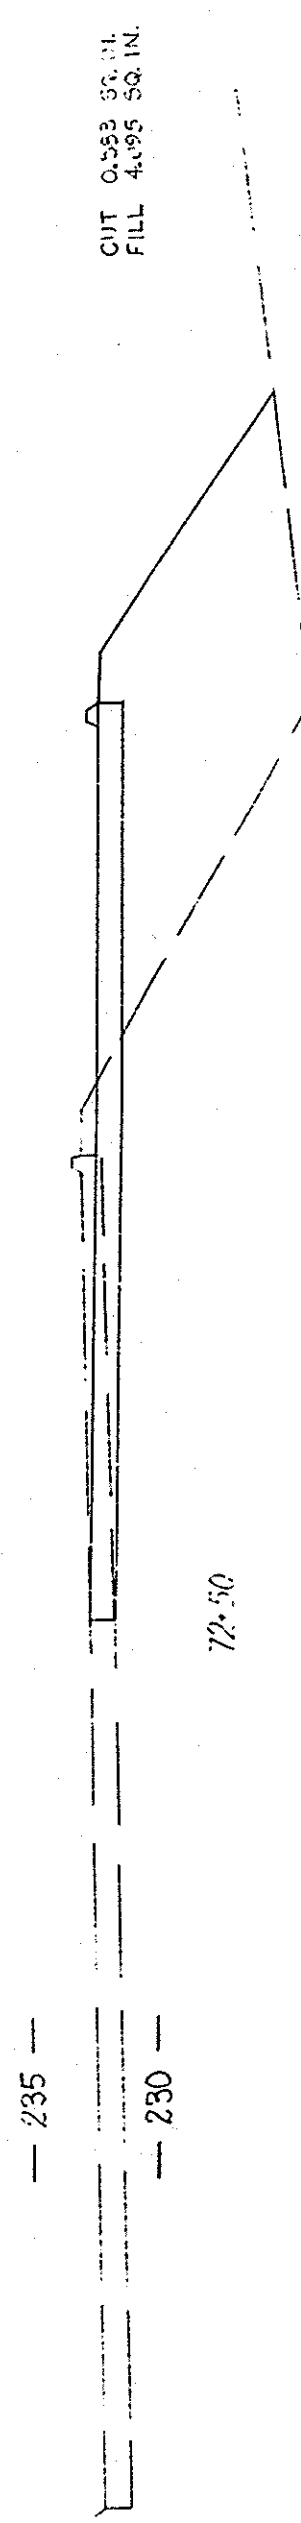
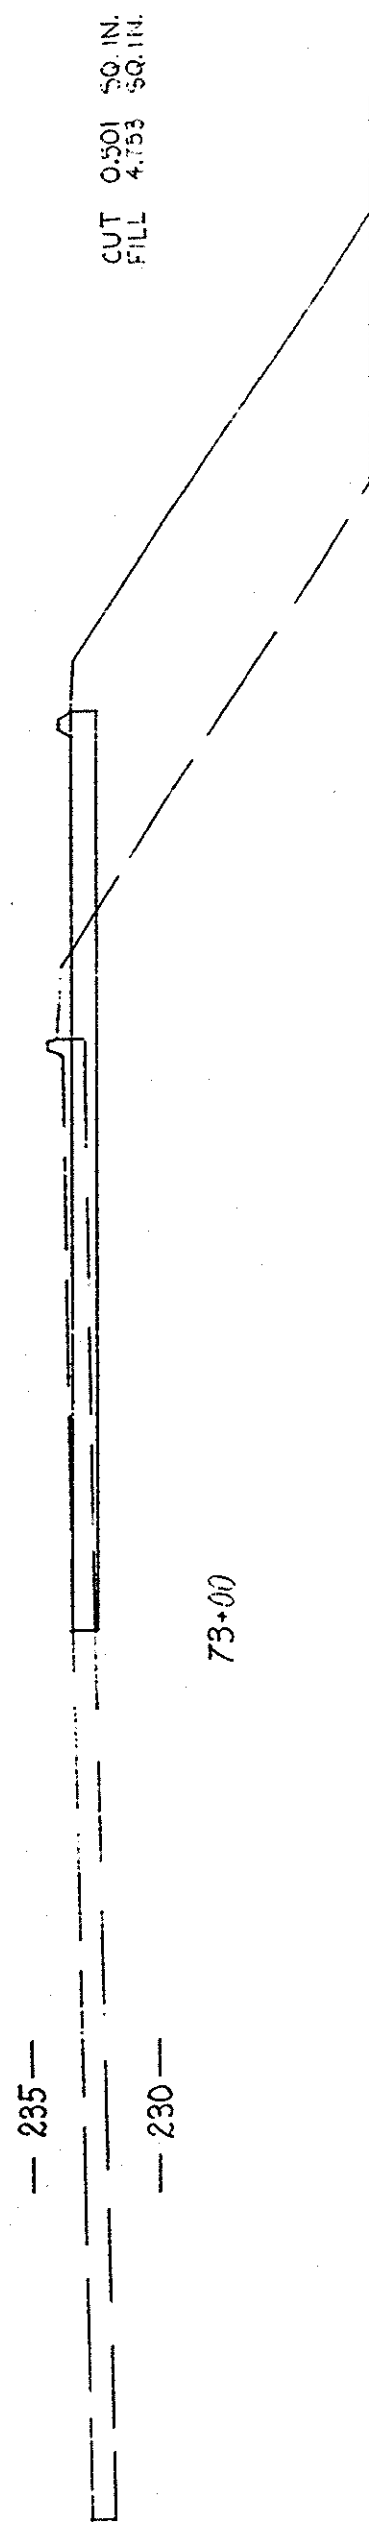


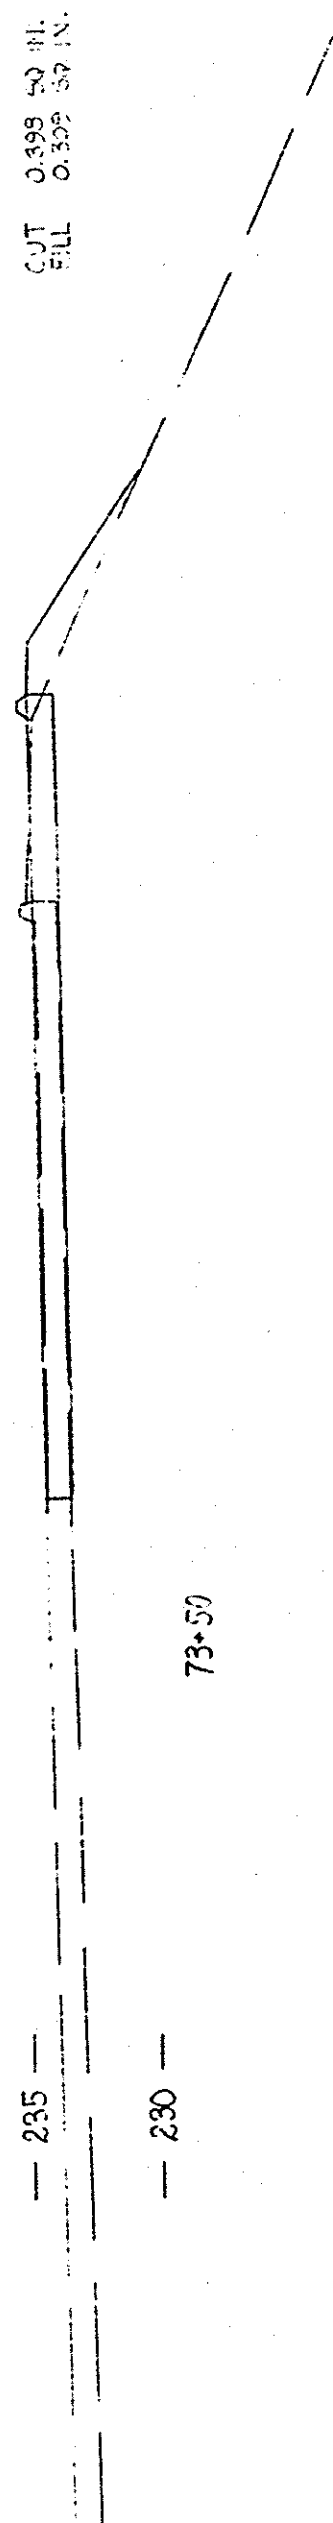

GLASSELL APPROACHES
AT SANTA ANA RIVER
1"=5'

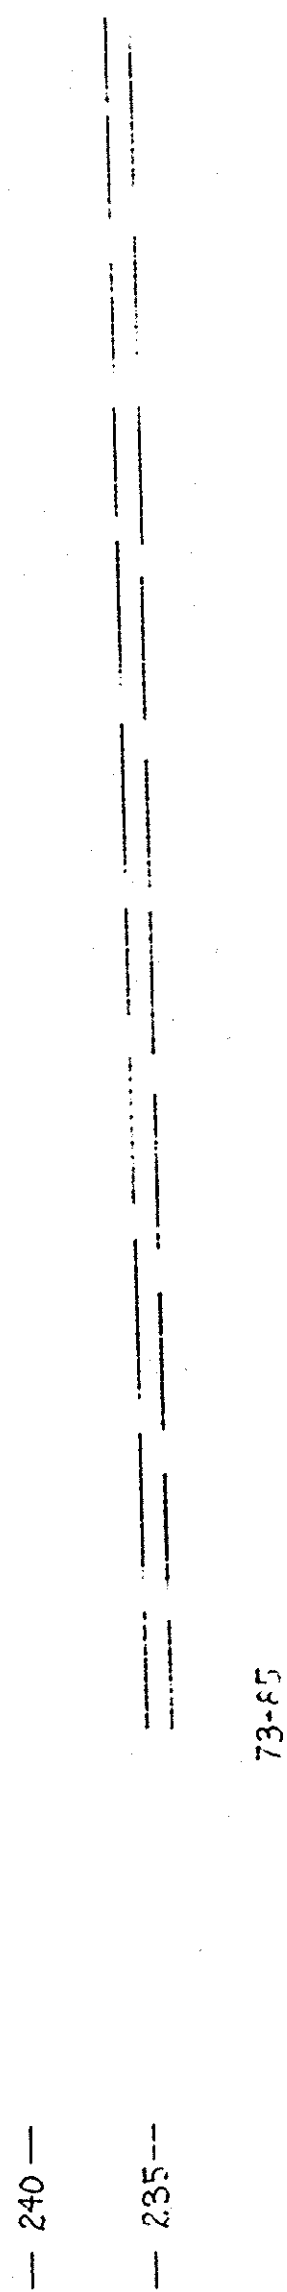

AS BUILT

CONSTRUCTION PLANS
GlasSELL Approaches
at Santa Ana River
Sheet 7 of 7
Scale: 1"=5' (unless otherwise noted)
Drawn: [illegible]
Checked: [illegible]
Date: [illegible]

Dr. 7 (10511)