

EXACT®


STRAIGHT EDGE RULE SE-48

ORANGE COUNTY
ROAD DEPARTMENT
STATE OF CALIFORNIA


PLANS FOR CONSTRUCTION OF

GLASSELL STREET BRIDGE

SA-8A
ACROSS SANTA ANA RIVER
CHANNEL E-01
TOTAL LENGTH 0.18 MILE

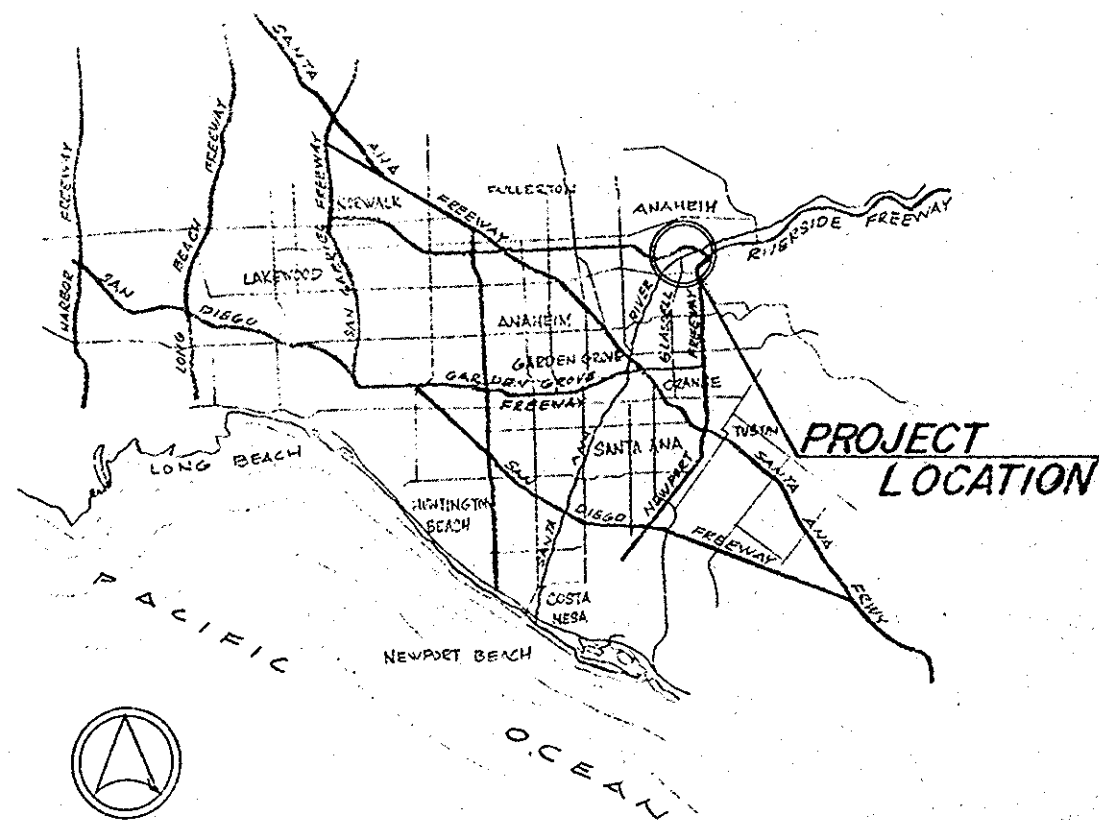

LOCATION MAP

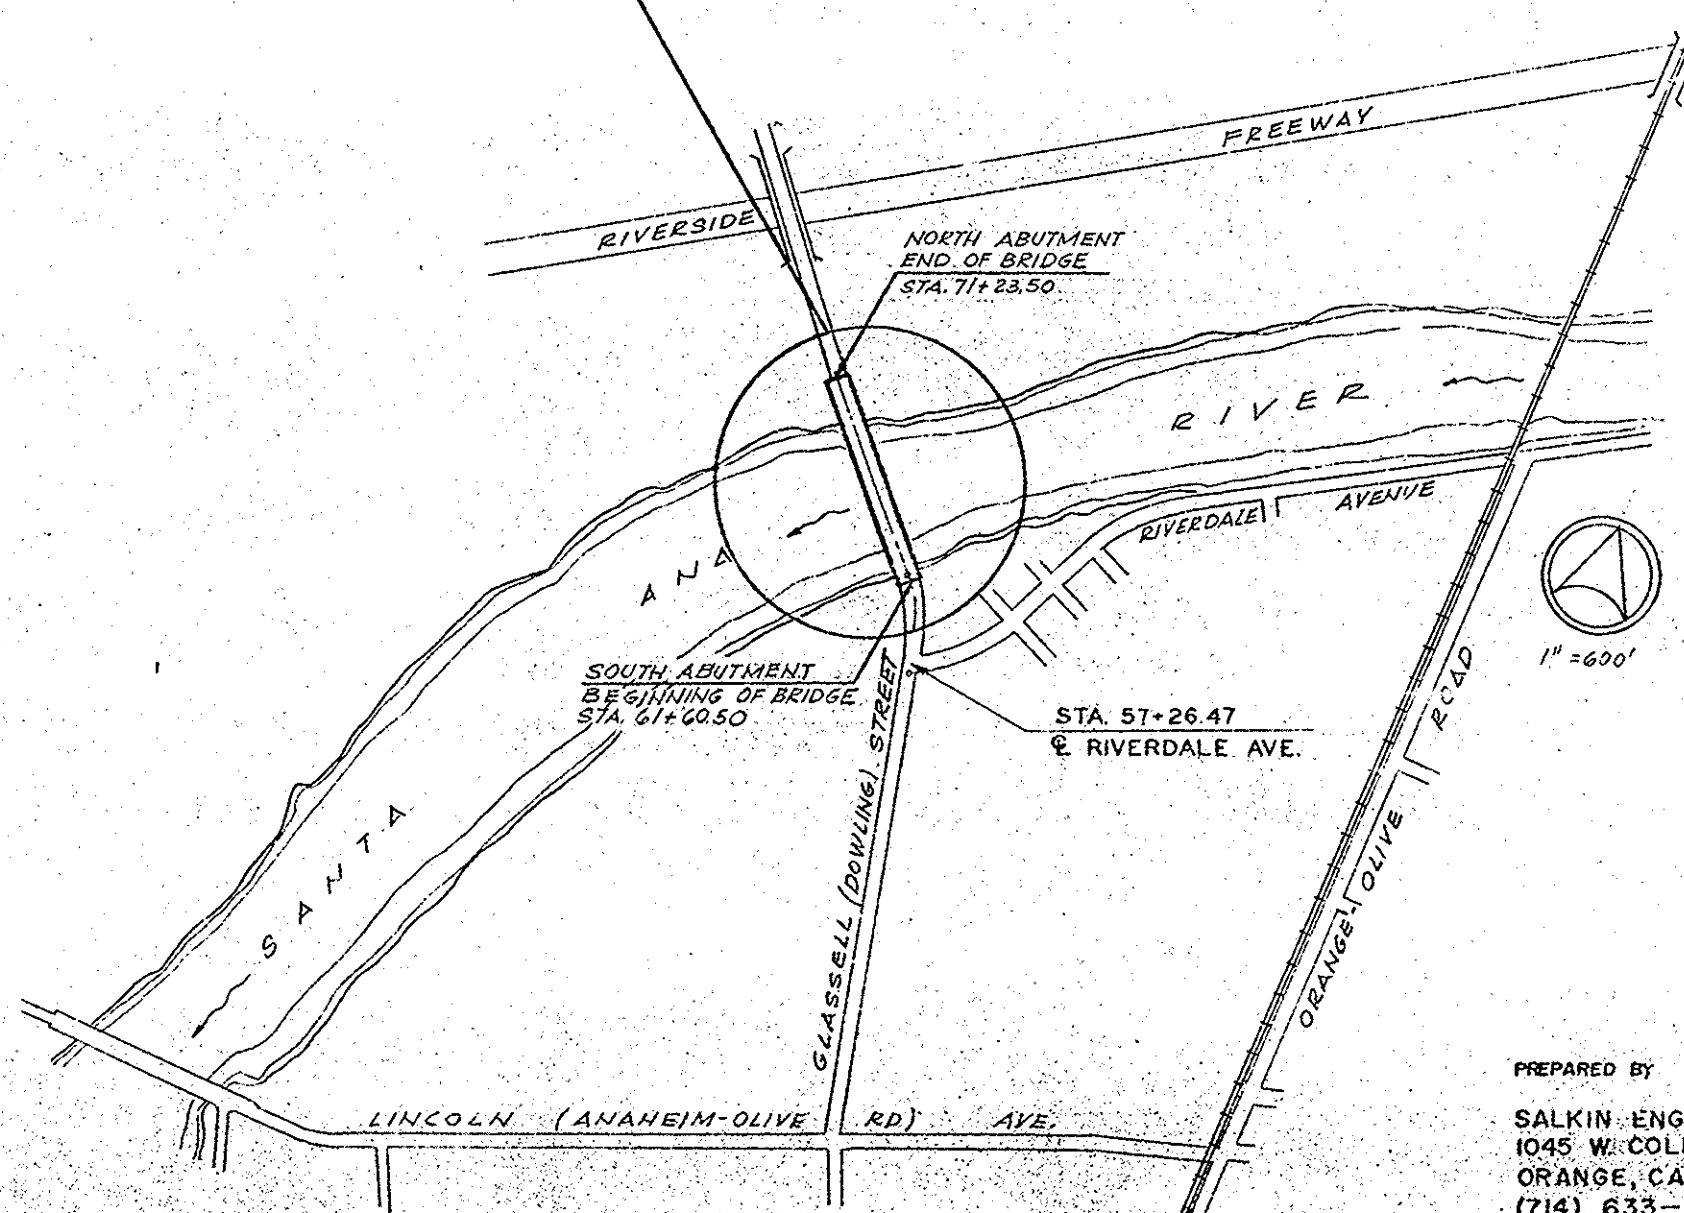

AS BUILT

ALL WORK WITHIN THE FLOOD CONTROL DISTRICT RIGHT OF WAY SHALL BE PERFORMED IN ACCORDANCE WITH THE PROVISIONS OF THE CONSTRUCTION PERMIT GRANTED BY ORANGE COUNTY FLOOD CONTROL DISTRICT AND THE PLANS STAMPED WITH THE APPROVAL OF ORANGE COUNTY FLOOD CONTROL DISTRICT. CONTRACTOR SHALL HAVE A COPY OF SAID PERMIT AND STAMPED PLANS ON THE JOB SITE.

APPROVED: *Robert S. Schneider* 4-29-70
AS TO PORTION ASSISTANT CITY ENGINEER DATE
WITHIN CITY OF ORANGE

APPROVED: *James W. Dunn* 9-27-70
SECRETARY MANAGER O.C.W.D. DATE

APPROVED: *Allen S. Koch* 1-28-70
ROAD COMMISSIONER R.C.E. 7872 DATE

PREPARED BY
SALKIN ENGINEERING CORP.
1045 W. COLLINS
ORANGE, CALIFORNIA
(714) 633-7261

MICROFILMED
APR 1971

10343
GLASSELL ST BR
WIDENING OVER SAR 1970
550-130 SA-8A
THS-769-G.3

- 1 TITLE SHEET
- 2 GENERAL PLAN
- 3 FOUNDATION PLAN
- 4 ABUTMENT DETAILS
- 5 PIER DETAILS #2-9
- 6 PIER DETAILS #10-18
- 7 PIER EXTENSION DETAILS #3-8
- 8-9 SUPERSTRUCTURE LAYOUT & REINFORCEMENT
- 10 SUPERSTRUCTURE LAYOUT-MISC. DETAILS
- 11 TYPICAL SECTION
- 12 MISCELLANEOUS DETAILS
- 13 HINGE DETAILS
- 14 EARTHWORK & RAIL DETAILS
- 15 LOG OF TEST BORINGS

+5 SHTS.

TOTAL = 20 SHTS (#10343 + #10511)