



EXACT®

STRAIGHT EDGE RULE SE-48

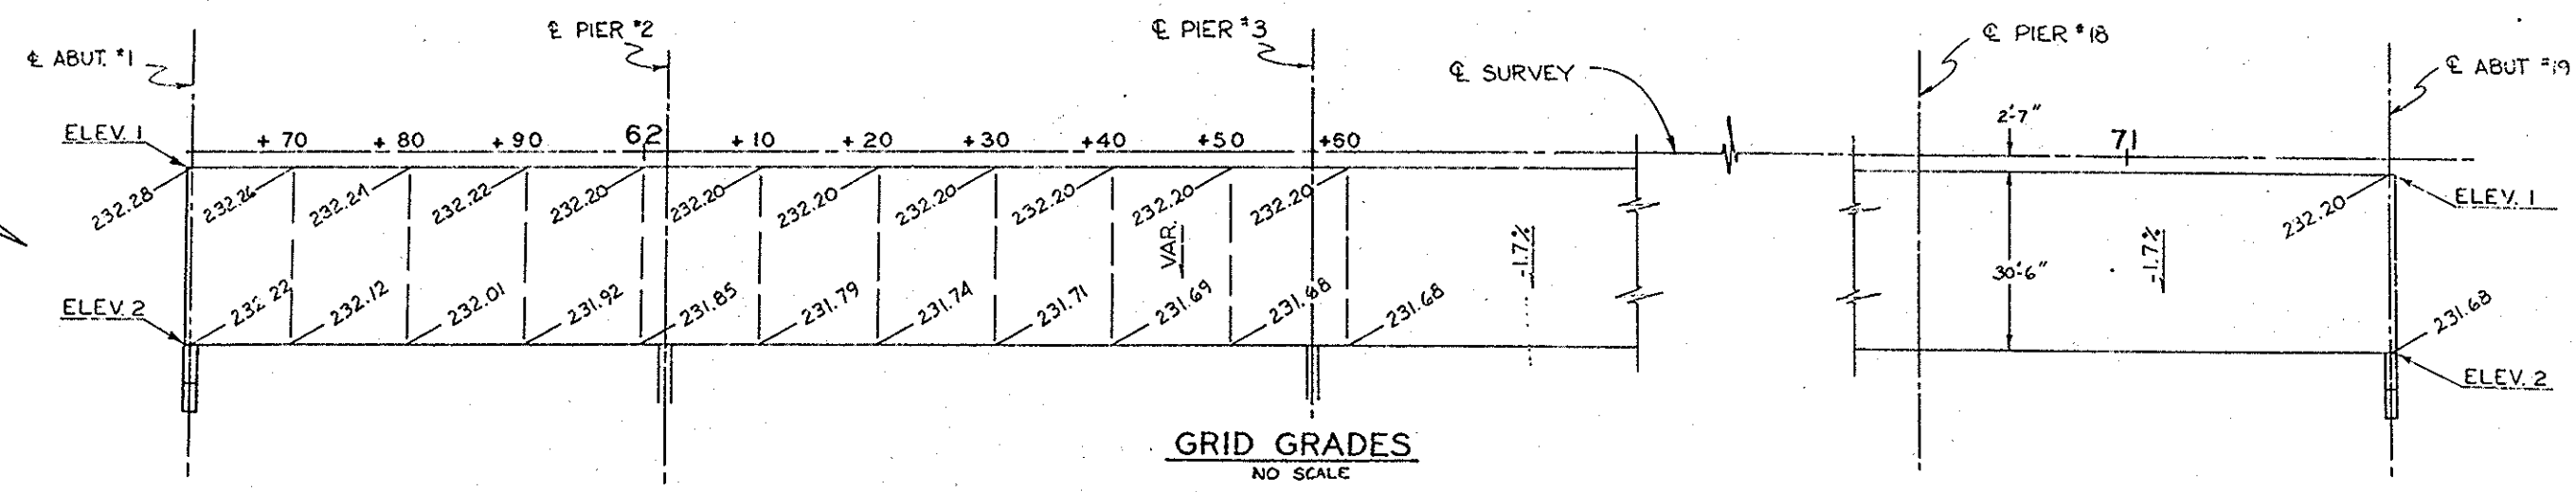


GRID GRADES
NO SCALE


TOTAL LENGTH = 963'-0" ALONG E SURVEY
16 SPANS @ 55'-0" = 880'-0"

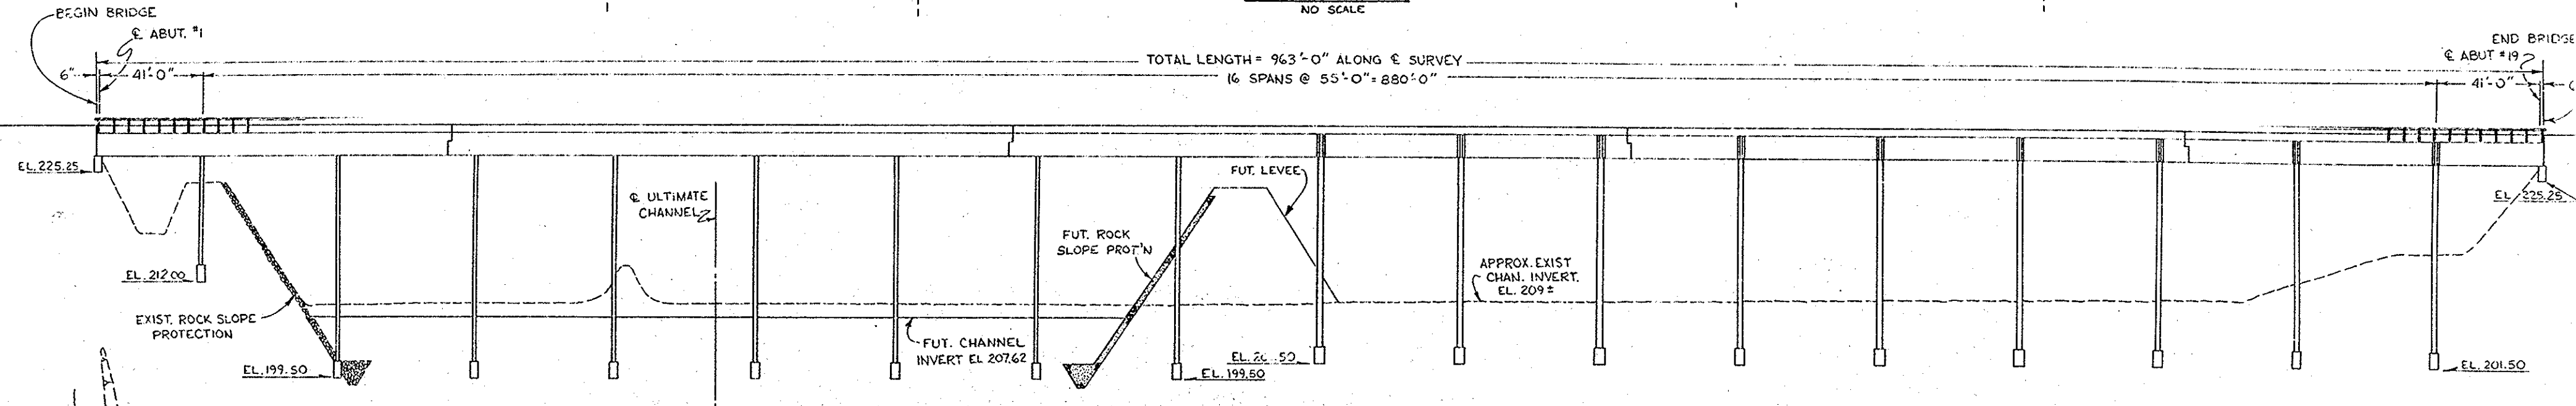

ELEVATION
SCALE 1" = 30' HOR.
1" = 10' VERT.
PILING NOT SHOWN

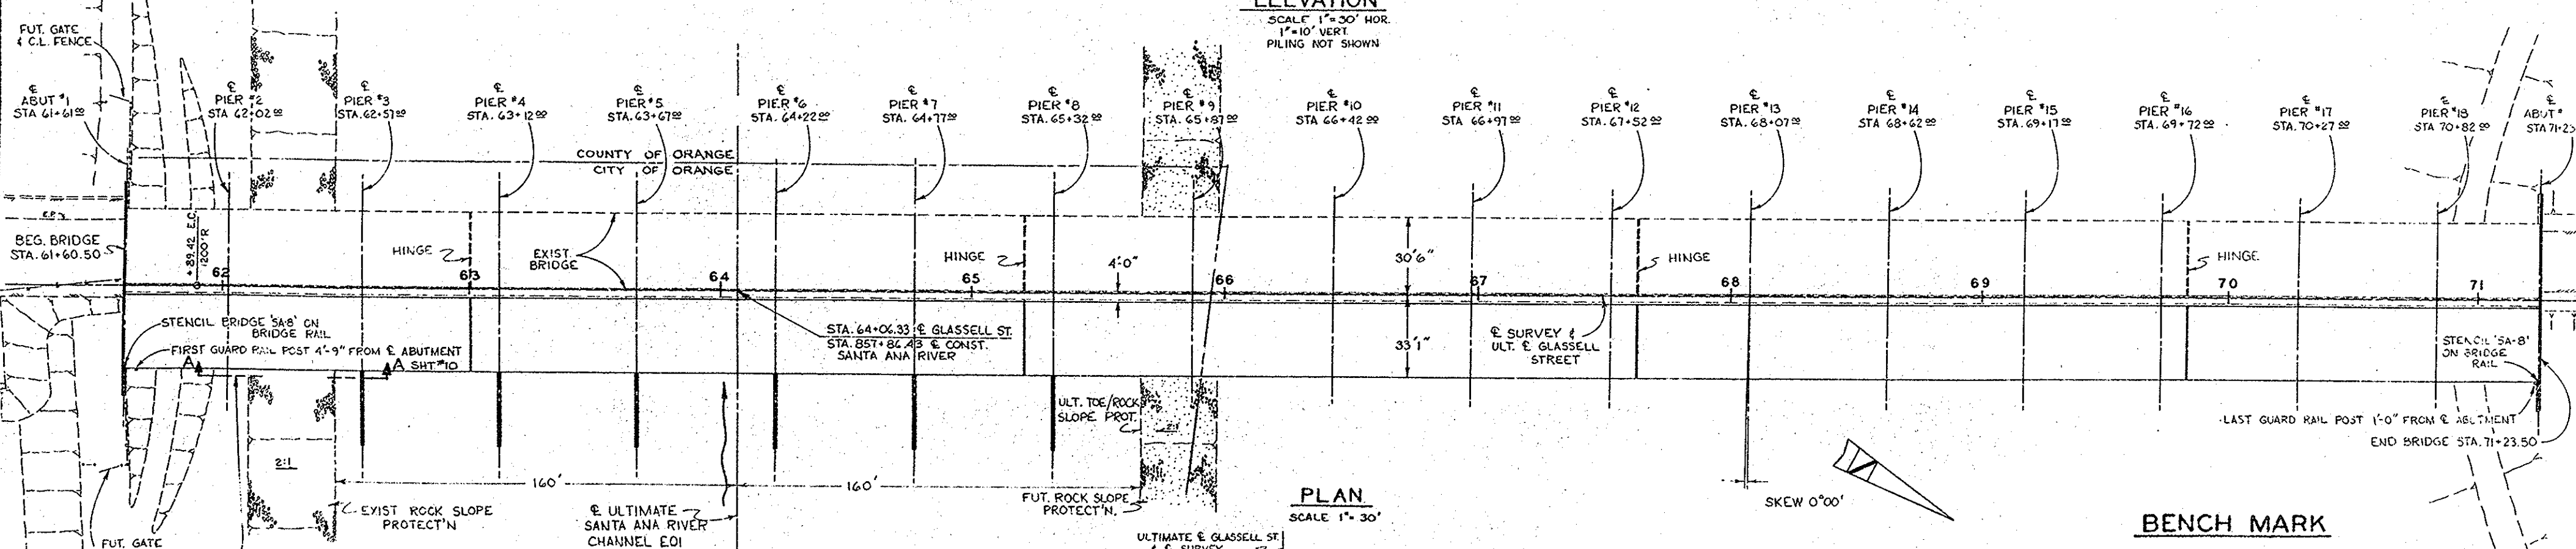

PLAN
SCALE 1" = 30'

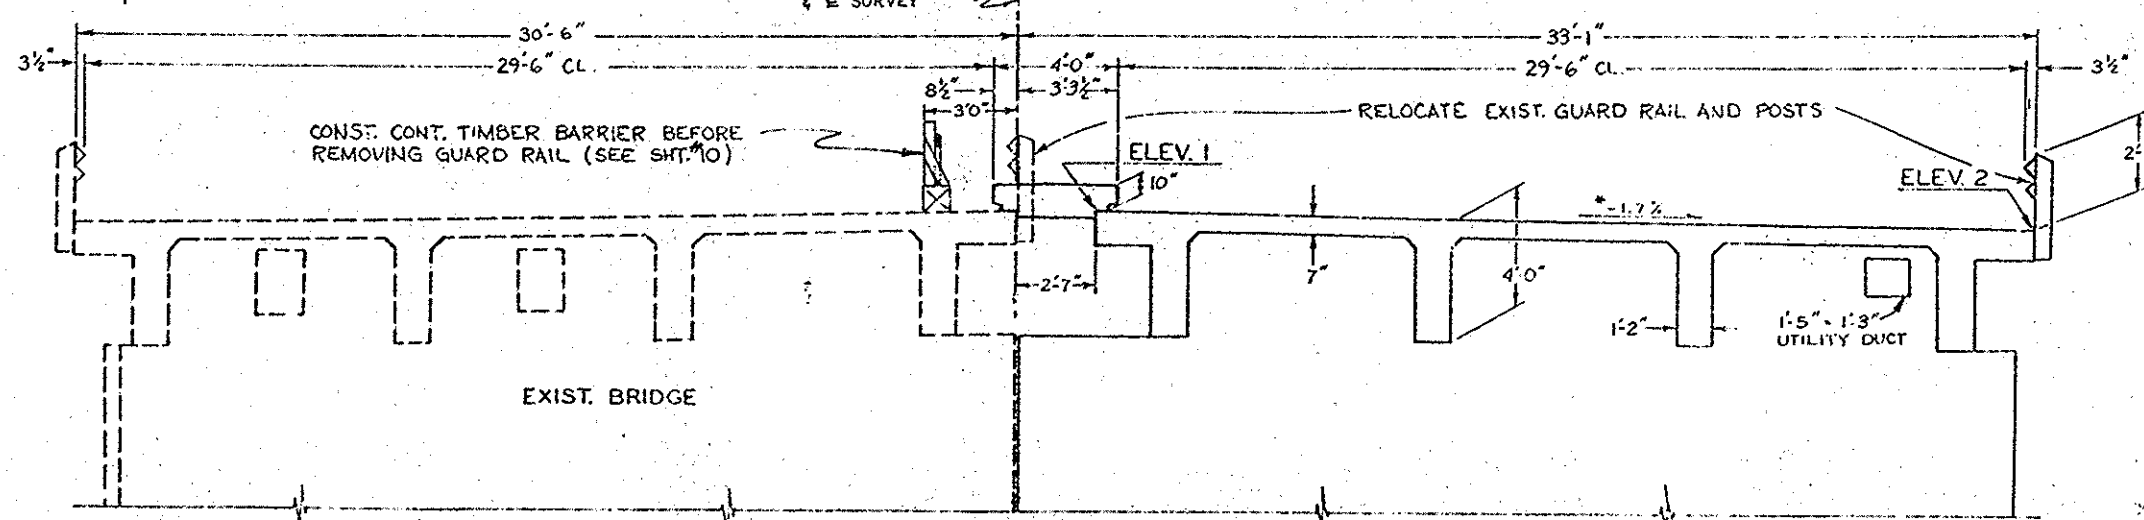

TYPICAL SECTION
SCALE 1/4" = 1'-0"

* EXCEPT AS DETAILED
IN GRID GRADES ABOVE.

BENCH MARK

1K-14-65
STD. O.C.S. MONUMENT AT THE C/L INT. OF
LINCOLN AVE. & DOWLING AVE. (GLASSELL
ST.), TOP OF HEXAGON BAR IN CAPPED WELL
1' BELOW SURFACE.

AS BUILT

ORANGE COUNTY ROAD DEPARTMENT	
GLASSELL STREET BRIDGE SA-8A ACROSS SANTA ANA RIVER	
GENERAL PLAN	
AS NOTED	SHEET 2 OF 15

DR 7 (1034-3)