



EXACT®

STRAIGHT EDGE RULE SE-48

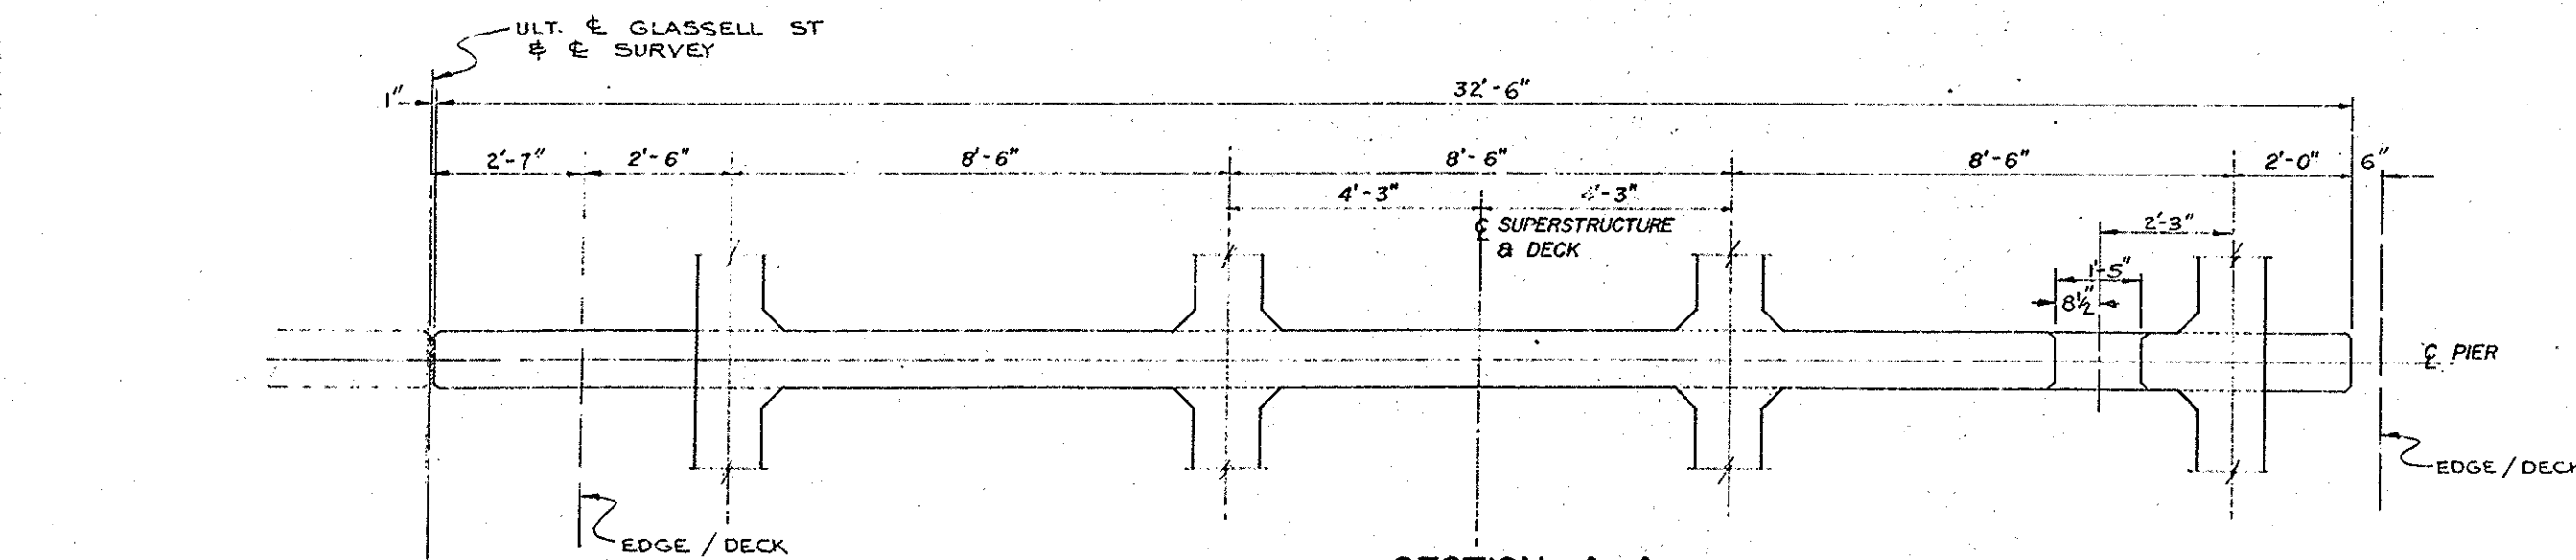


SECTION A-A

Scale 1/2" = 1'-0"

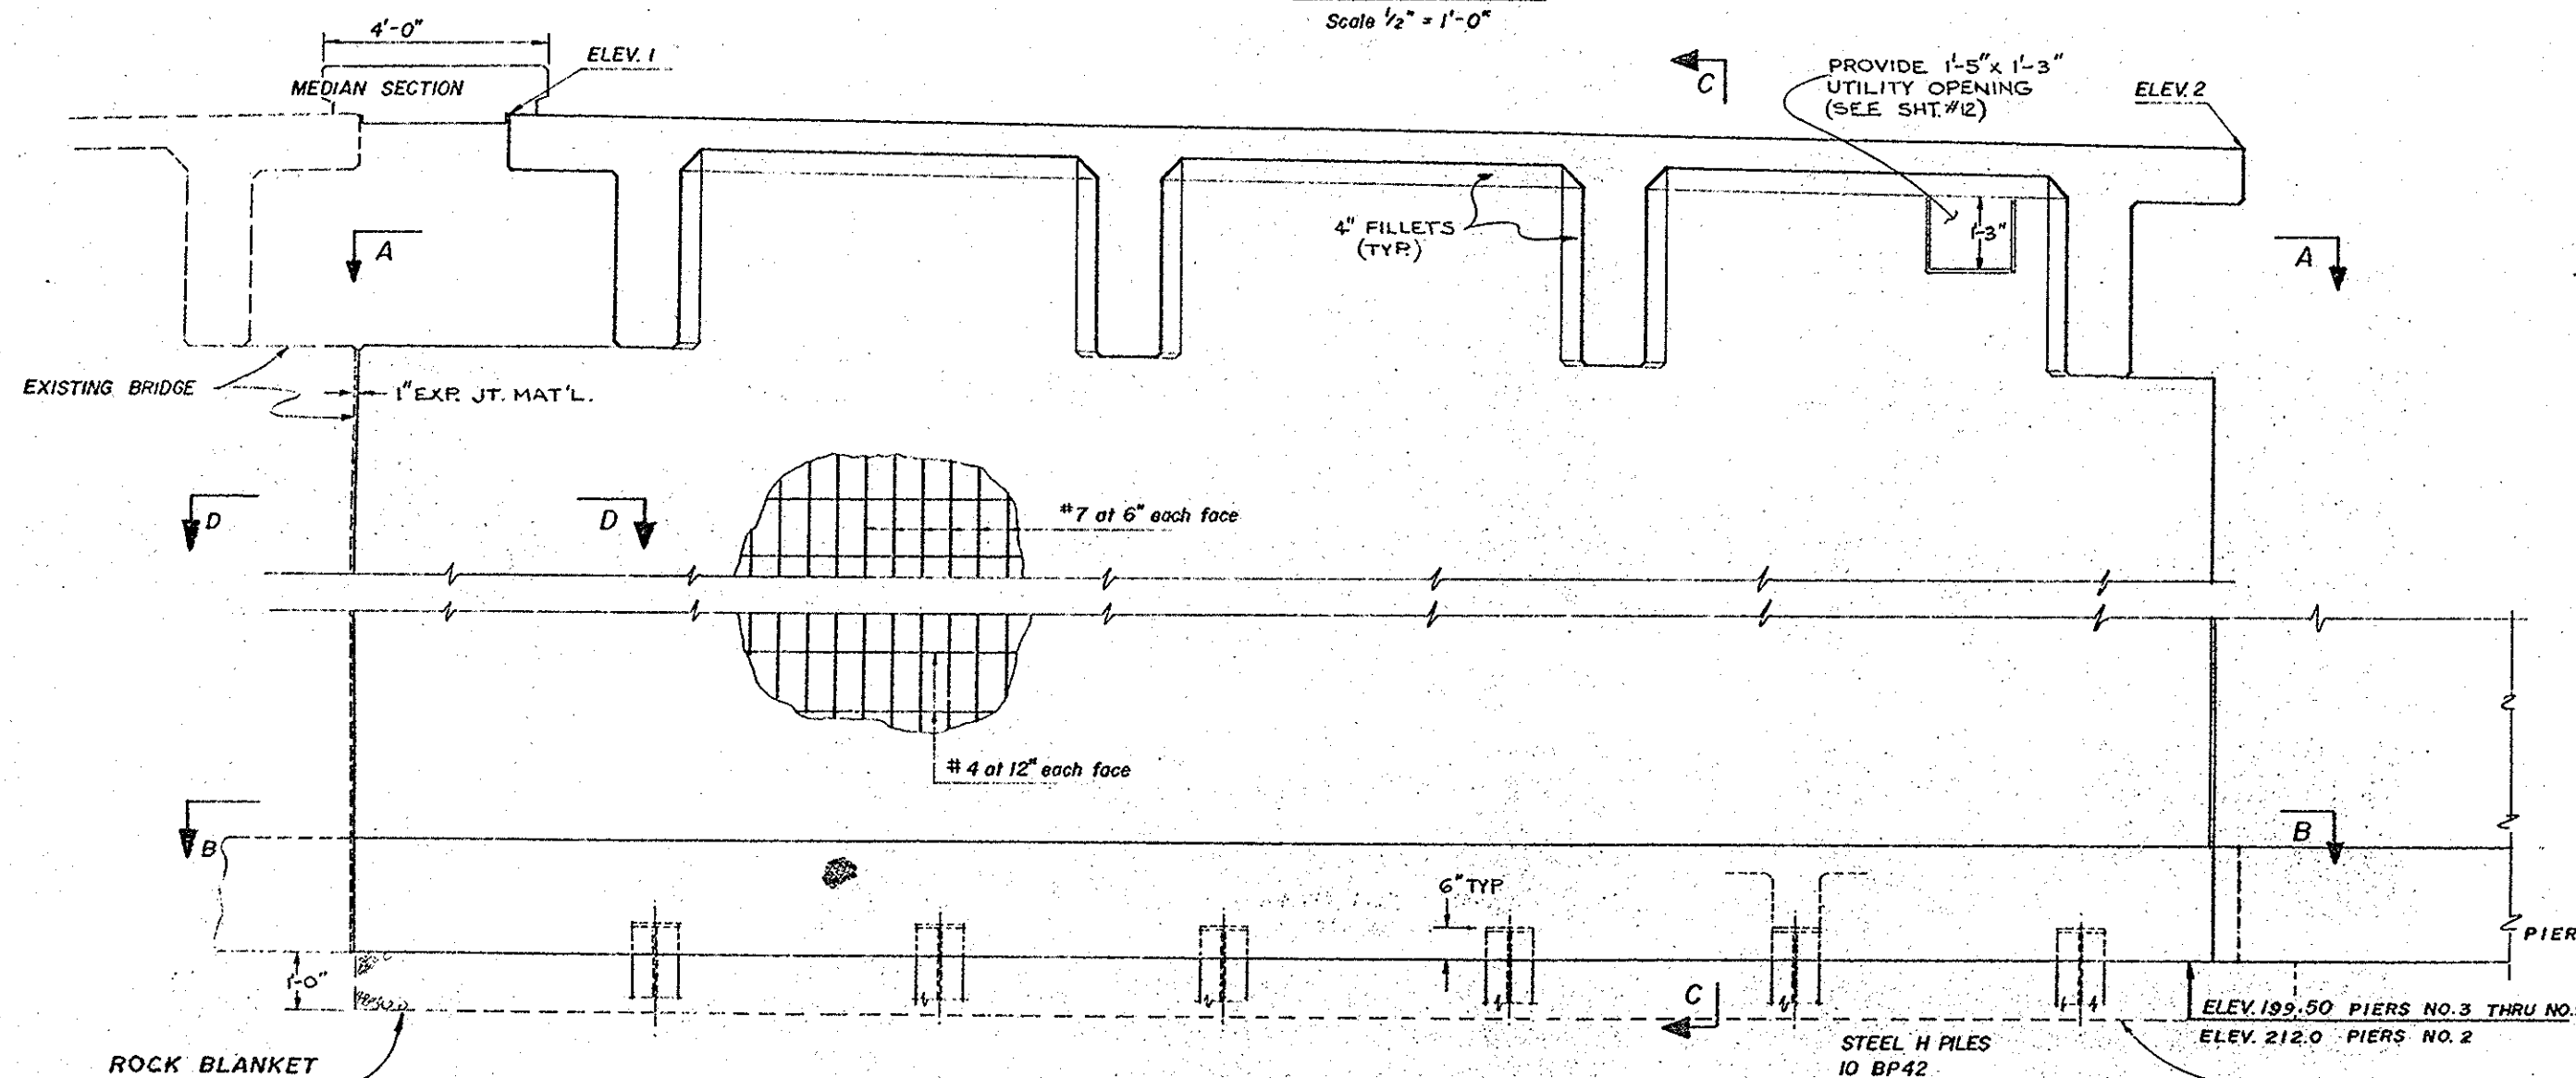


TYPICAL PIER DETAIL

Scale 1/2" = 1'-0"
PIERS NO. 2 THRU NO. 9

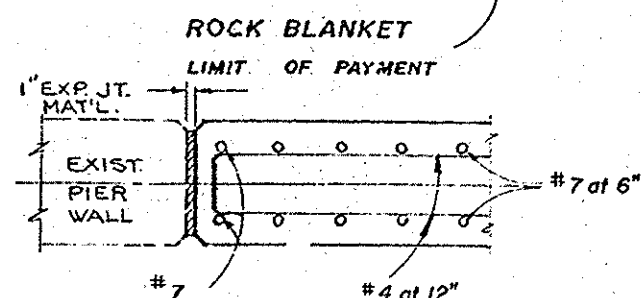


SECTION D-D

Scale 1" = 1'-0"

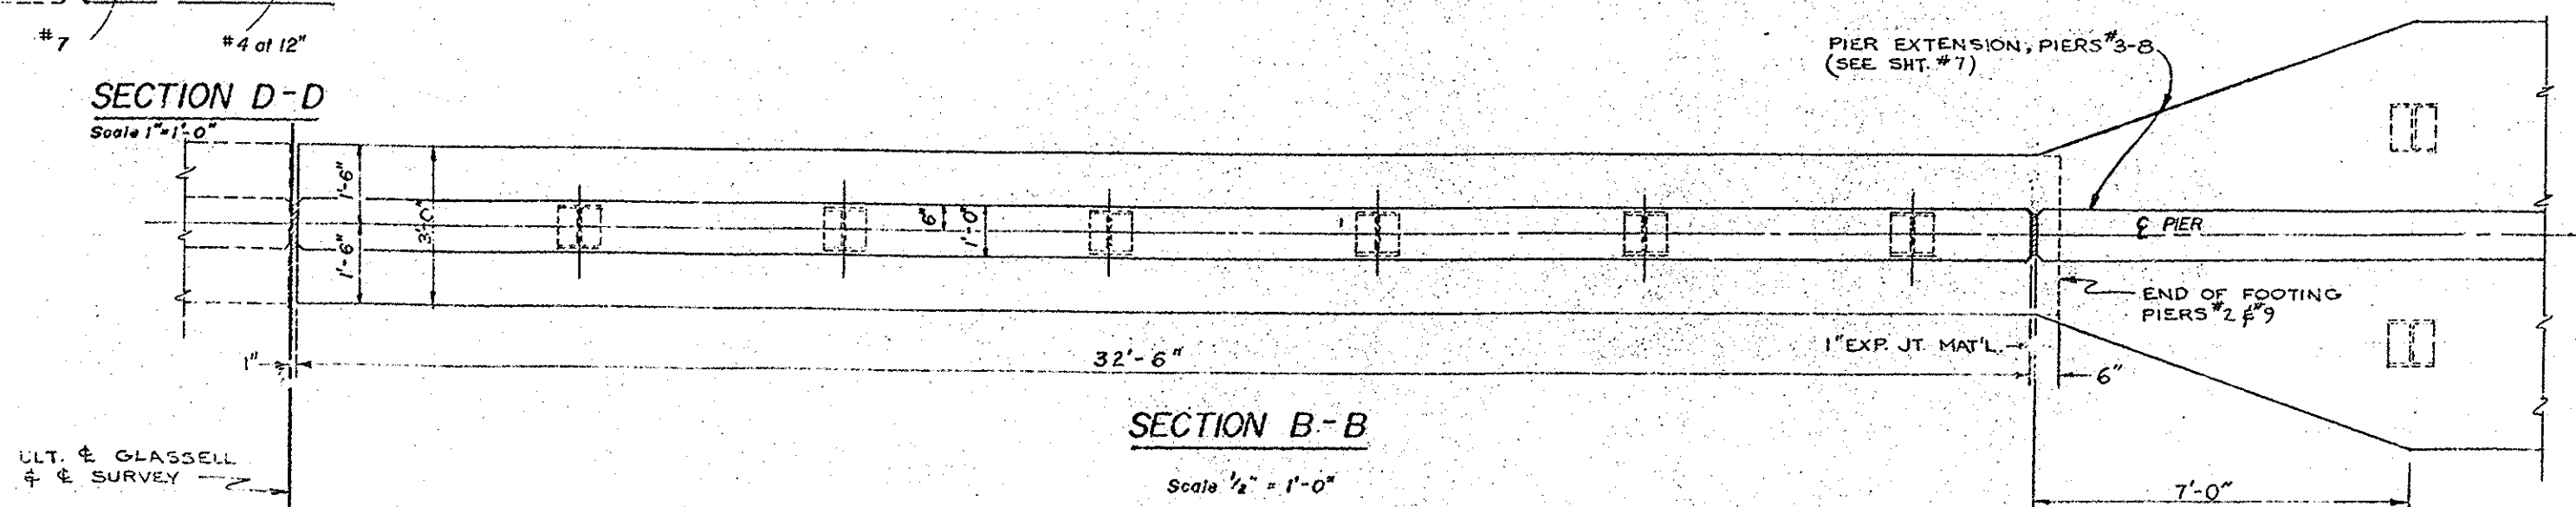

SECTION B-B

Scale 1/2" = 1'-0"

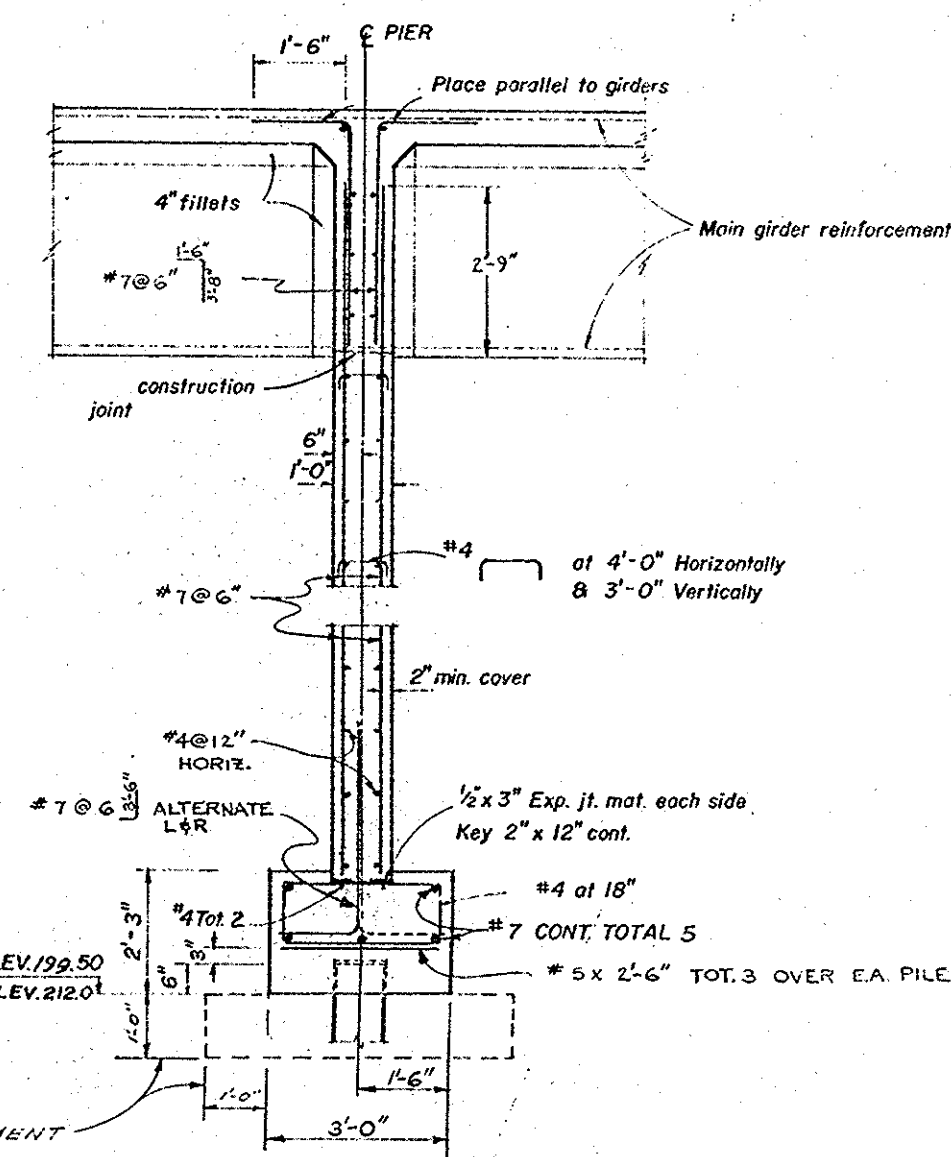

SECTION C-C

Scale 1/2" = 1'-0"

AS BUILT

GLASSELL ST. BRIDGE
ACROSS
SANTA ANA RIVER

PIER DETAILS #2-#9

1/2" = 1'-0"

DR 7 (1031)