
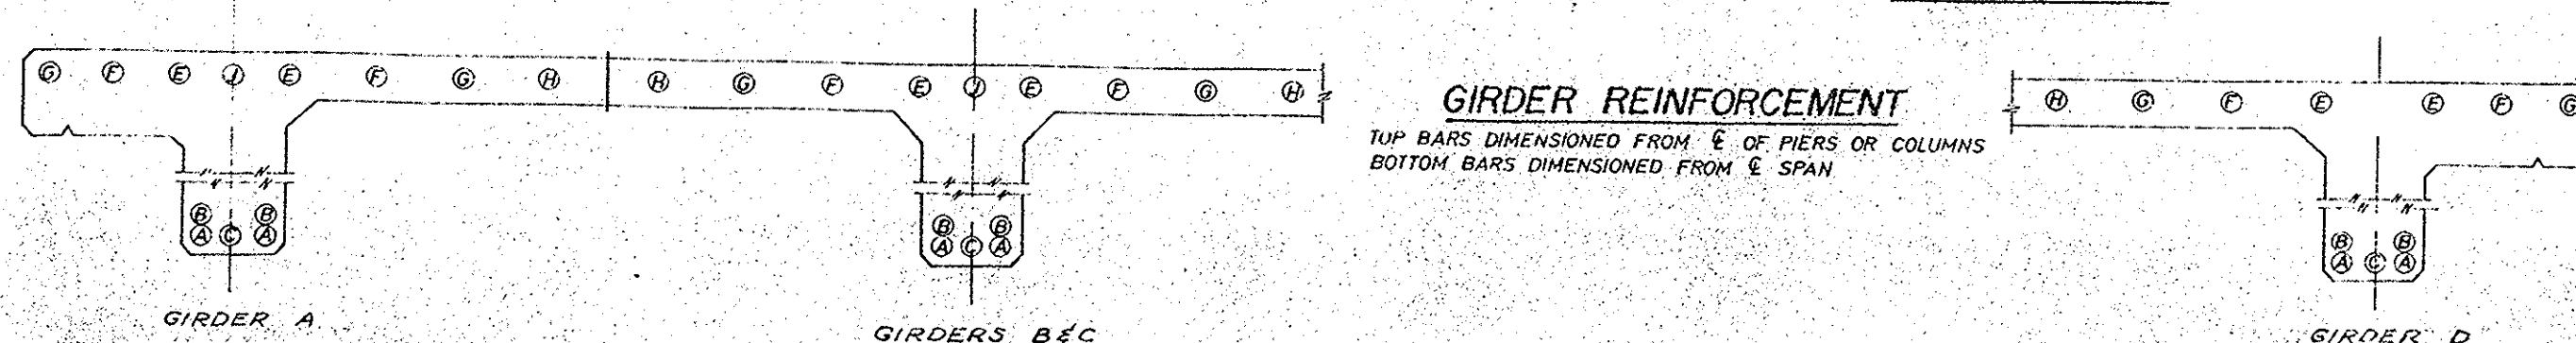
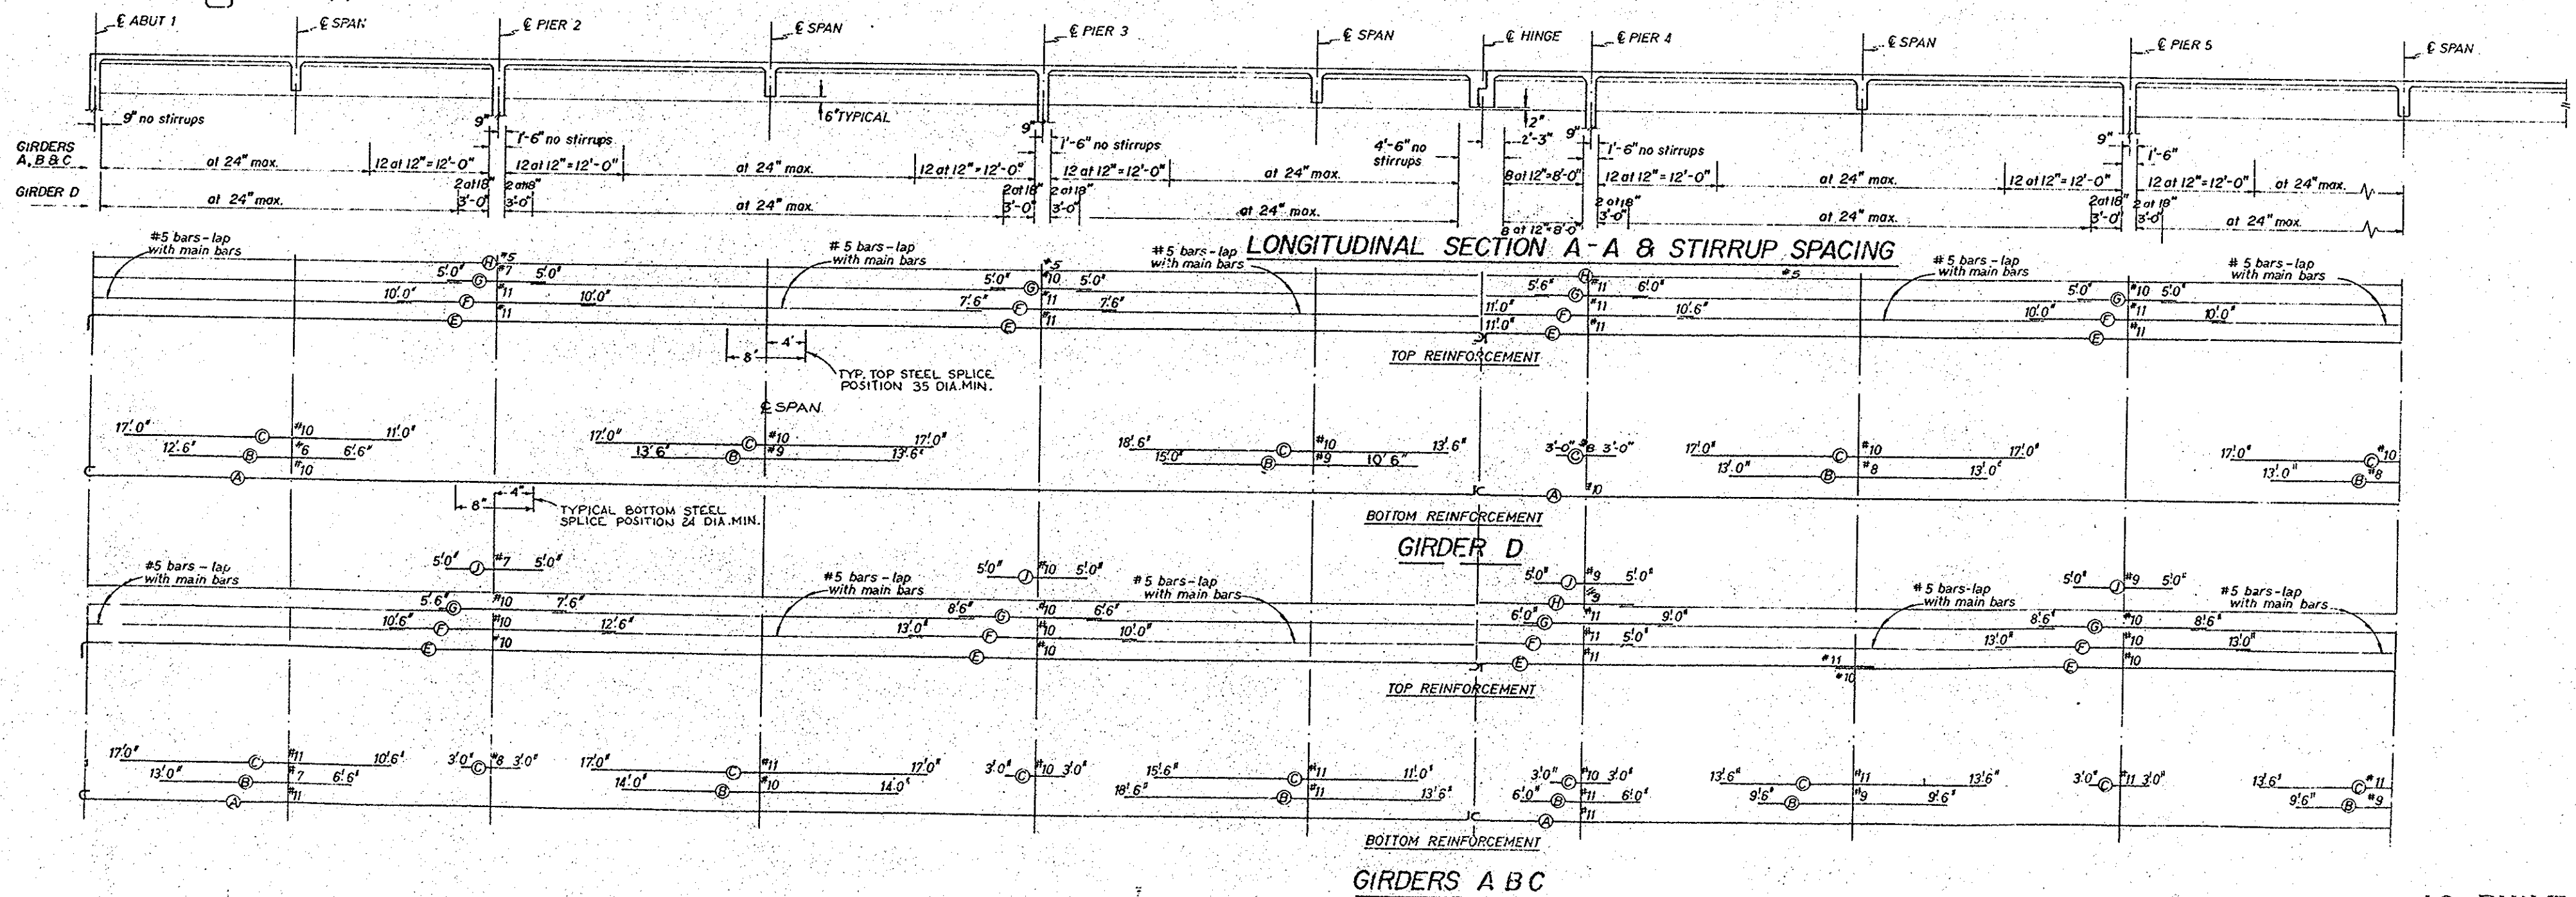


EXACT®

STRAIGHT EDGE RULE SE-48

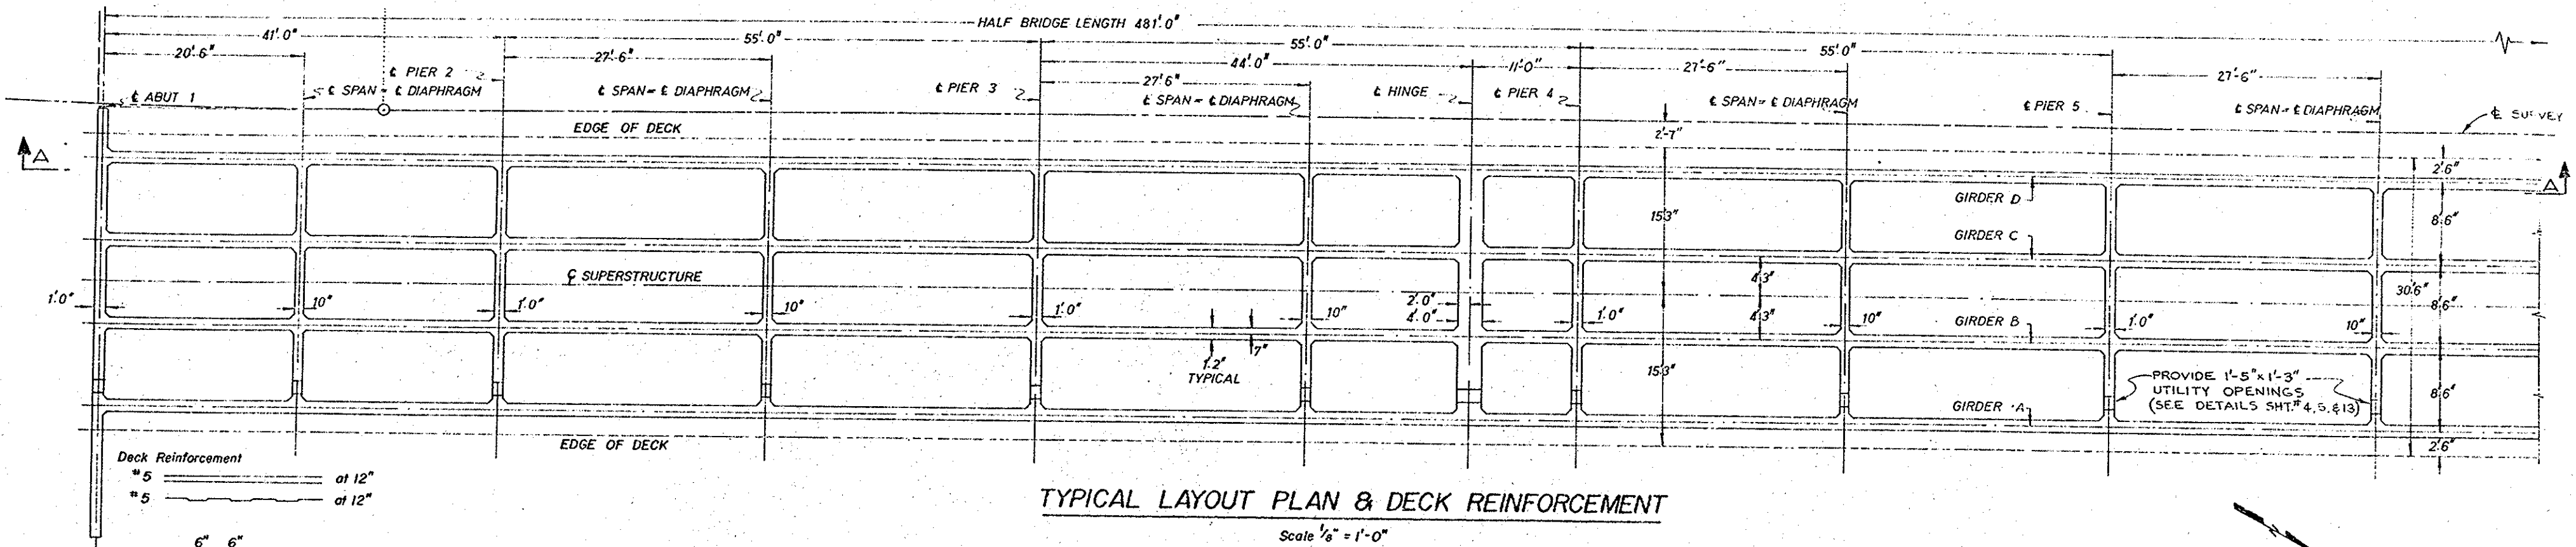

AS BUILT

GLASSSELL ST. BRIDGE
ACROSS
SANTA ANA RIVER
SUPERSTRUCTURE LAYOUT
REINFORCEMENT
1/8" = 1'-0"

DR 7-103