



EXACT®


STRAIGHT EDGE RULE SE-48

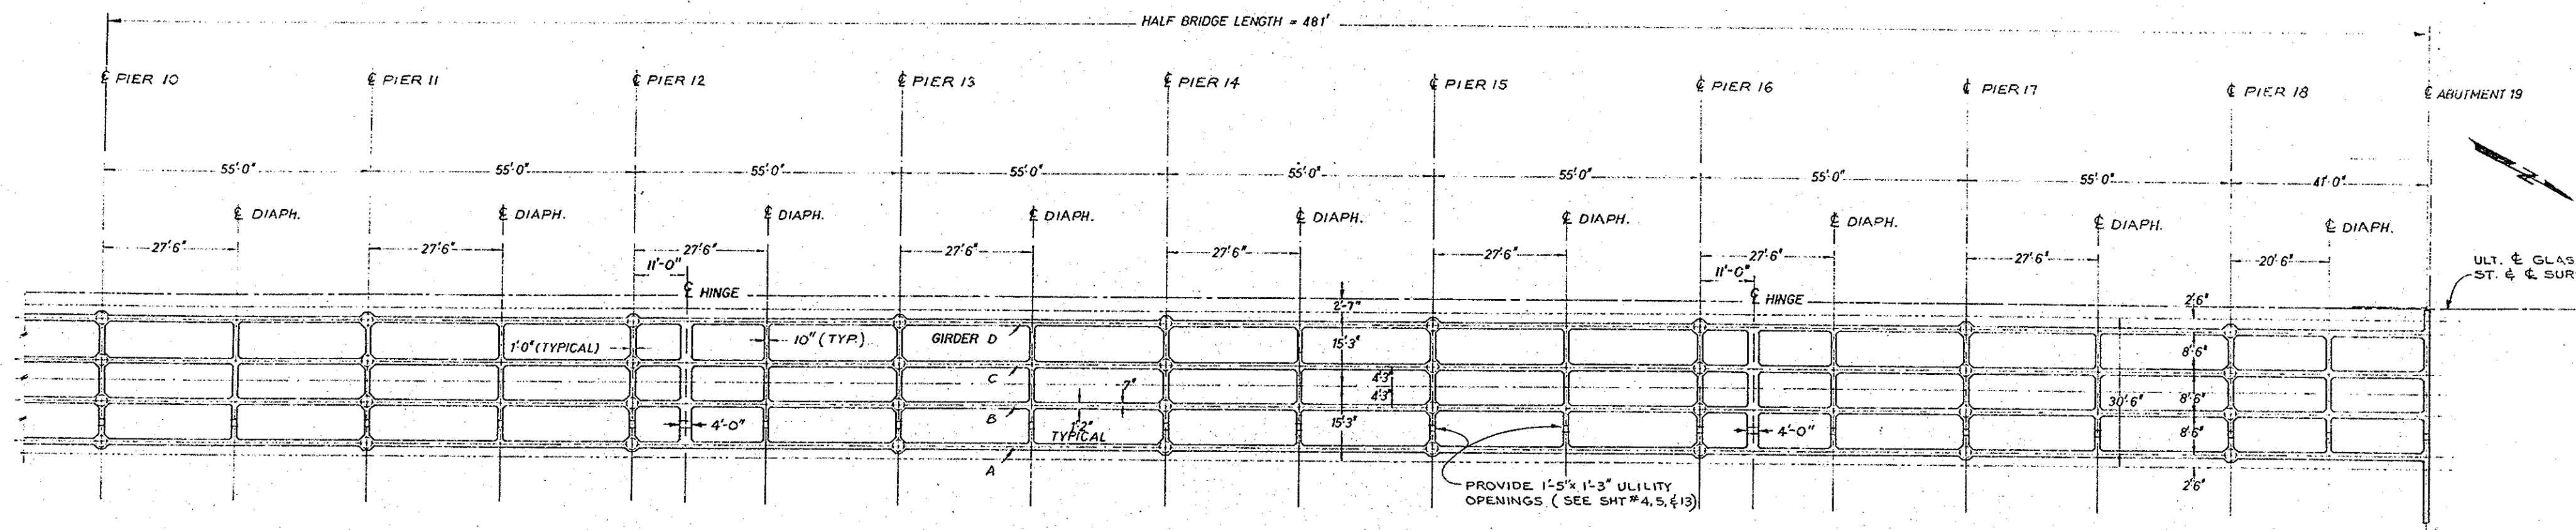

TYPICAL LAYOUT PLAN
SCALE 1/16" = 1'-0"

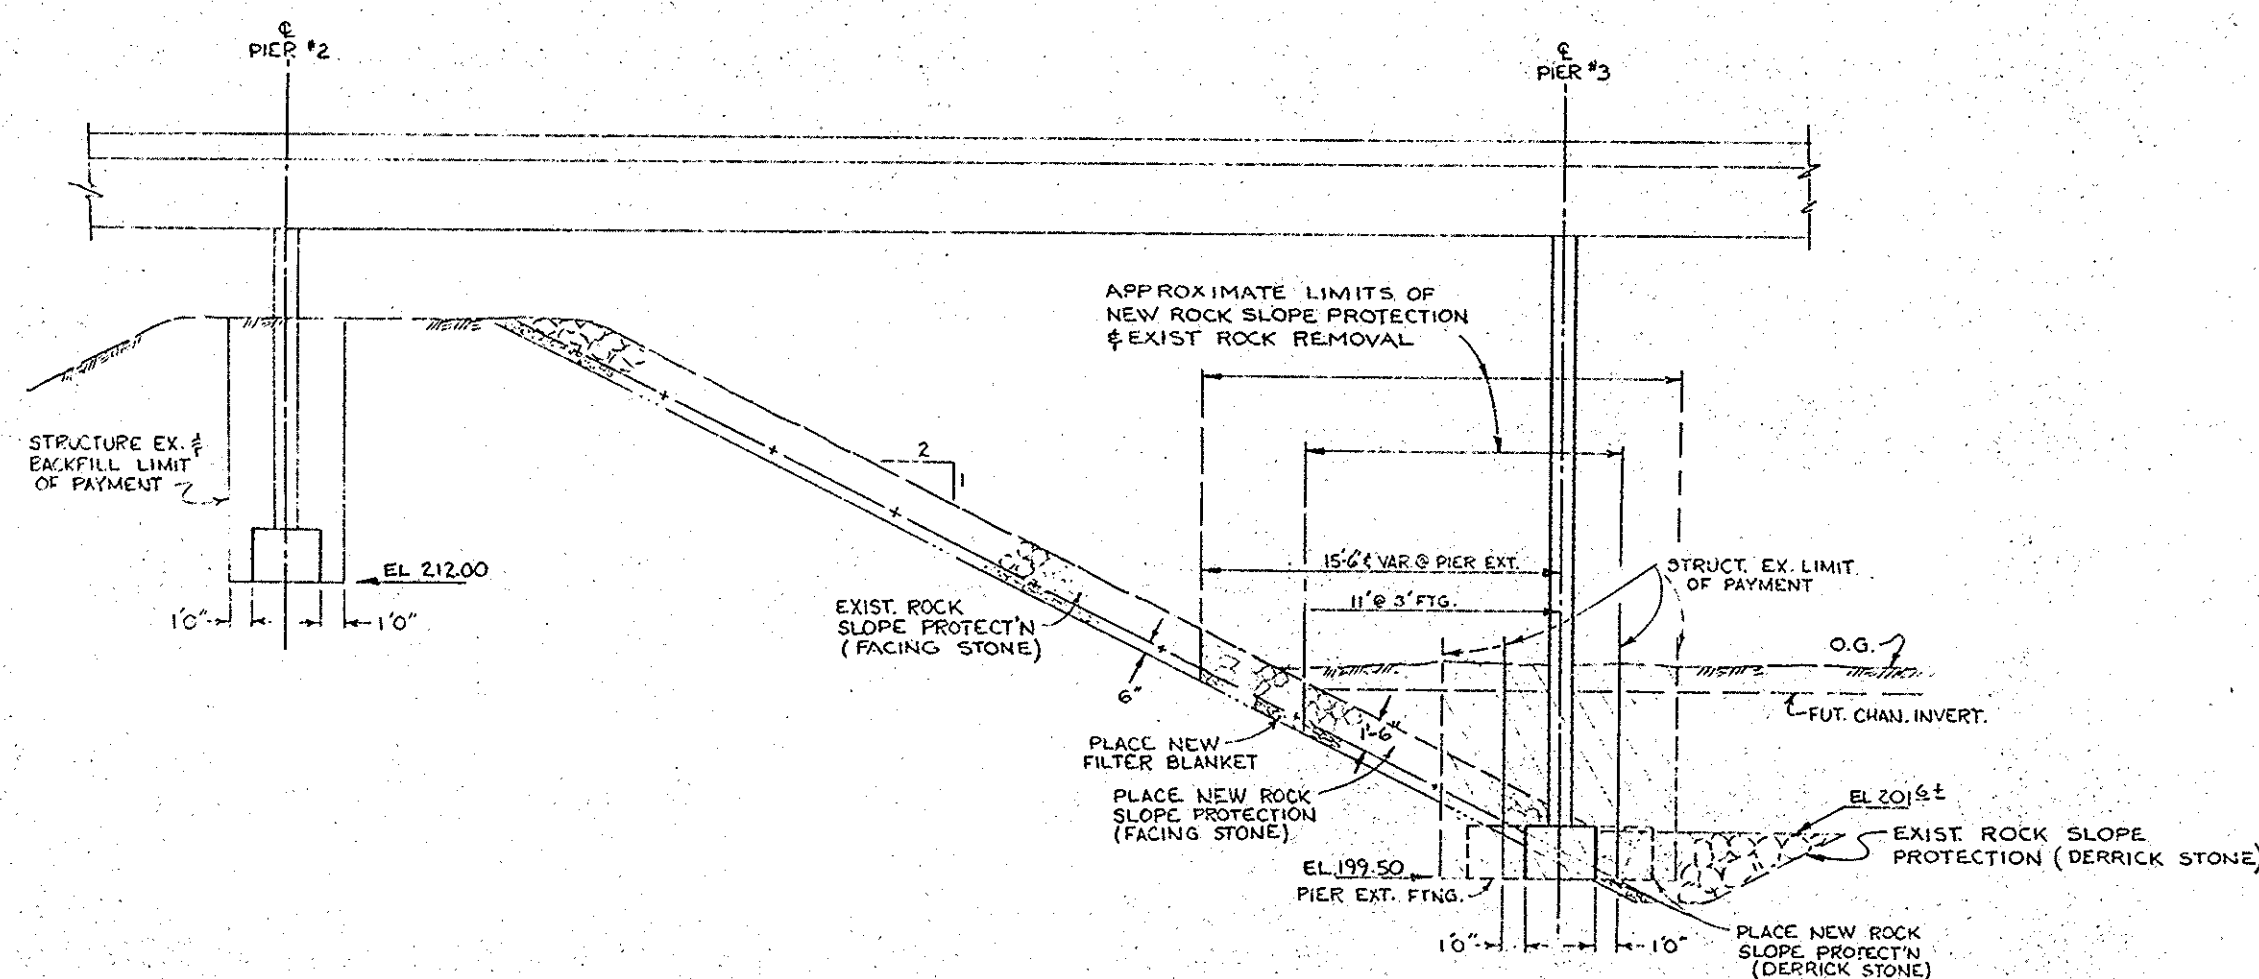

SECTION A-A
ROCK SLOPE PROTECTION
(SEE SHEET #2)
SCALE 3/16" = 1'-0"

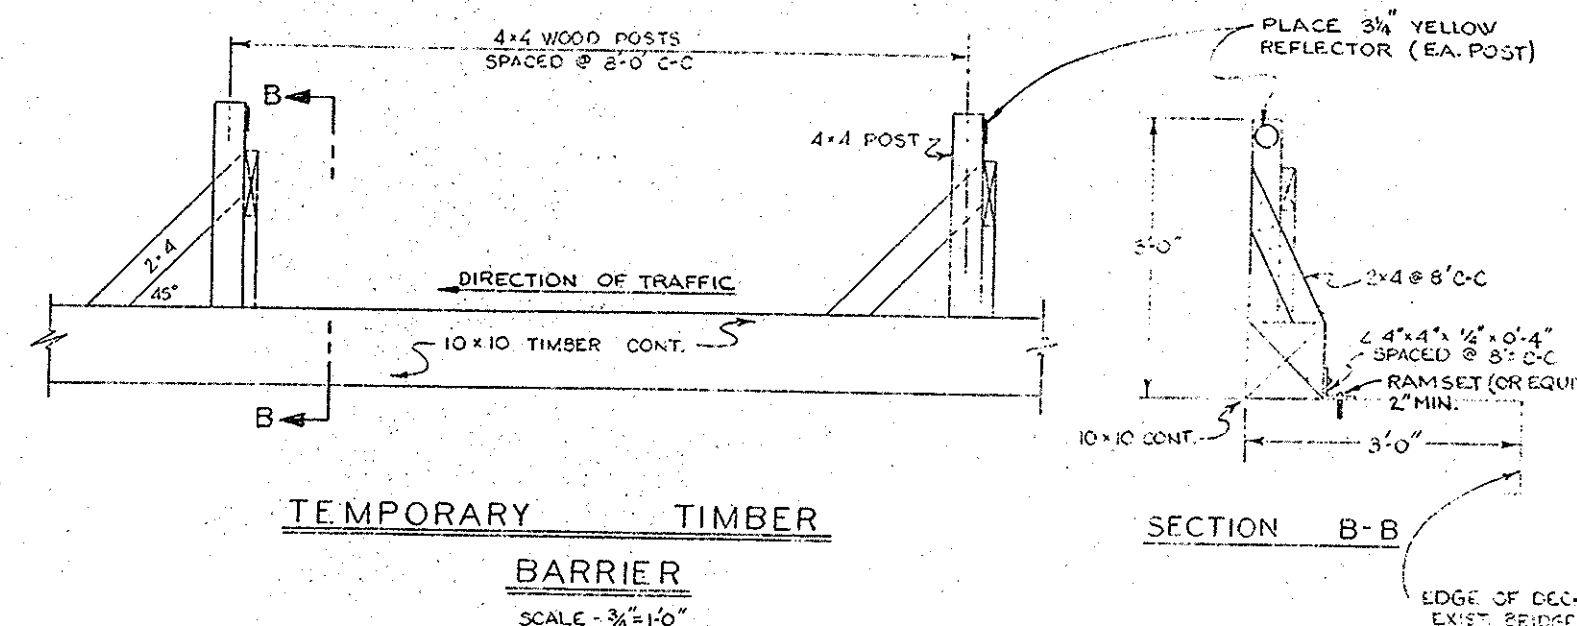

AS BUILT

GLASSELL STREET
BRIDGE SA 8A
ACROSS
SANTA ANA RIVER
SUPERSTRUCTURE PIER 10 -
ABUT 19;
MISCELLANEOUS DETAILS
AS NOTED

DR 103