


EXACT®

EXACT LEVEL & TOOL MFG. CO., Inc. HIGH BRIDGE, N. J., U. S. A.

STRAIGHT EDGE RULE SE-48

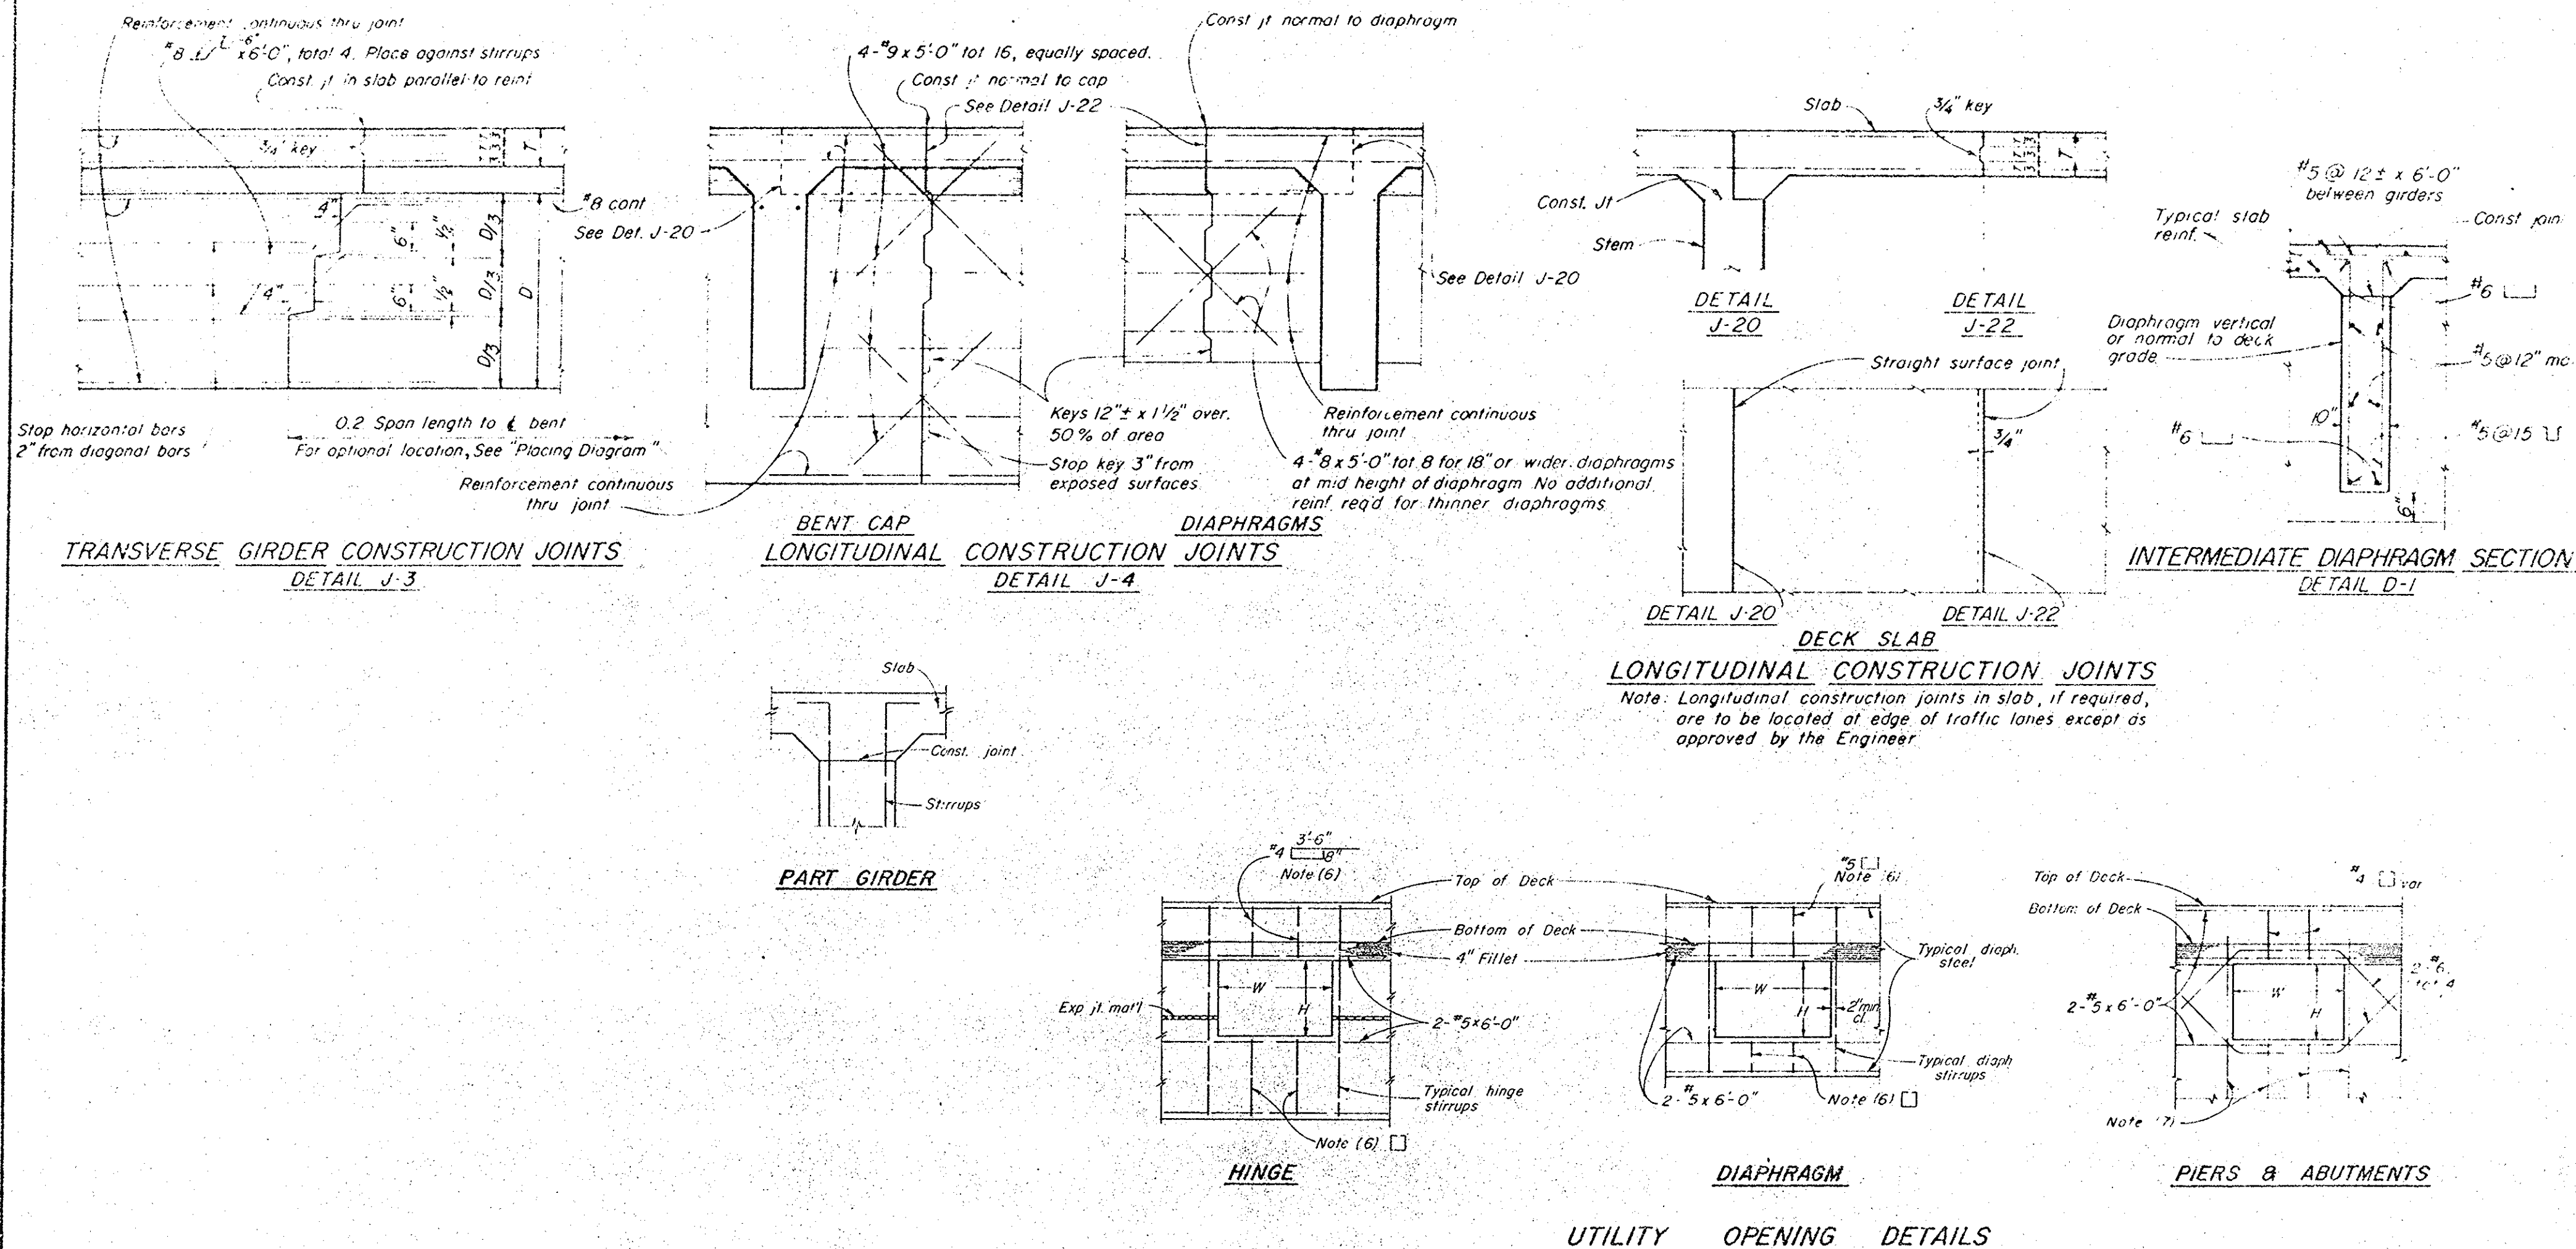

NOTES

- (1) For exact location and direction of openings see other sheets
- (2) Location and size of utility openings may be modified as directed by the Engineer, provided minimum dimensions are maintained
- (3) Girders not shown, see other sheets
- (4) Seal ground utilities at abutments to be of sufficient strength to withstand earth pressure
- (5) All reinforcement detailed to be placed in addition to reinforcement shown on other sheets
- (6) Stirrups are same size as adjacent stirrups shown on other sheets
- (7) Main reinforcement to clear opening as detailed on other sheets

AS BUILT

ORANGE COUNTY ROAD DEPARTMENT	
GLASSELL STREET BRIDGE SA-8A ACROSS SANTA ANA RIVER	
MISCELLANEOUS DETAILS	
AS NOTED	SHEET 12 OF 15