



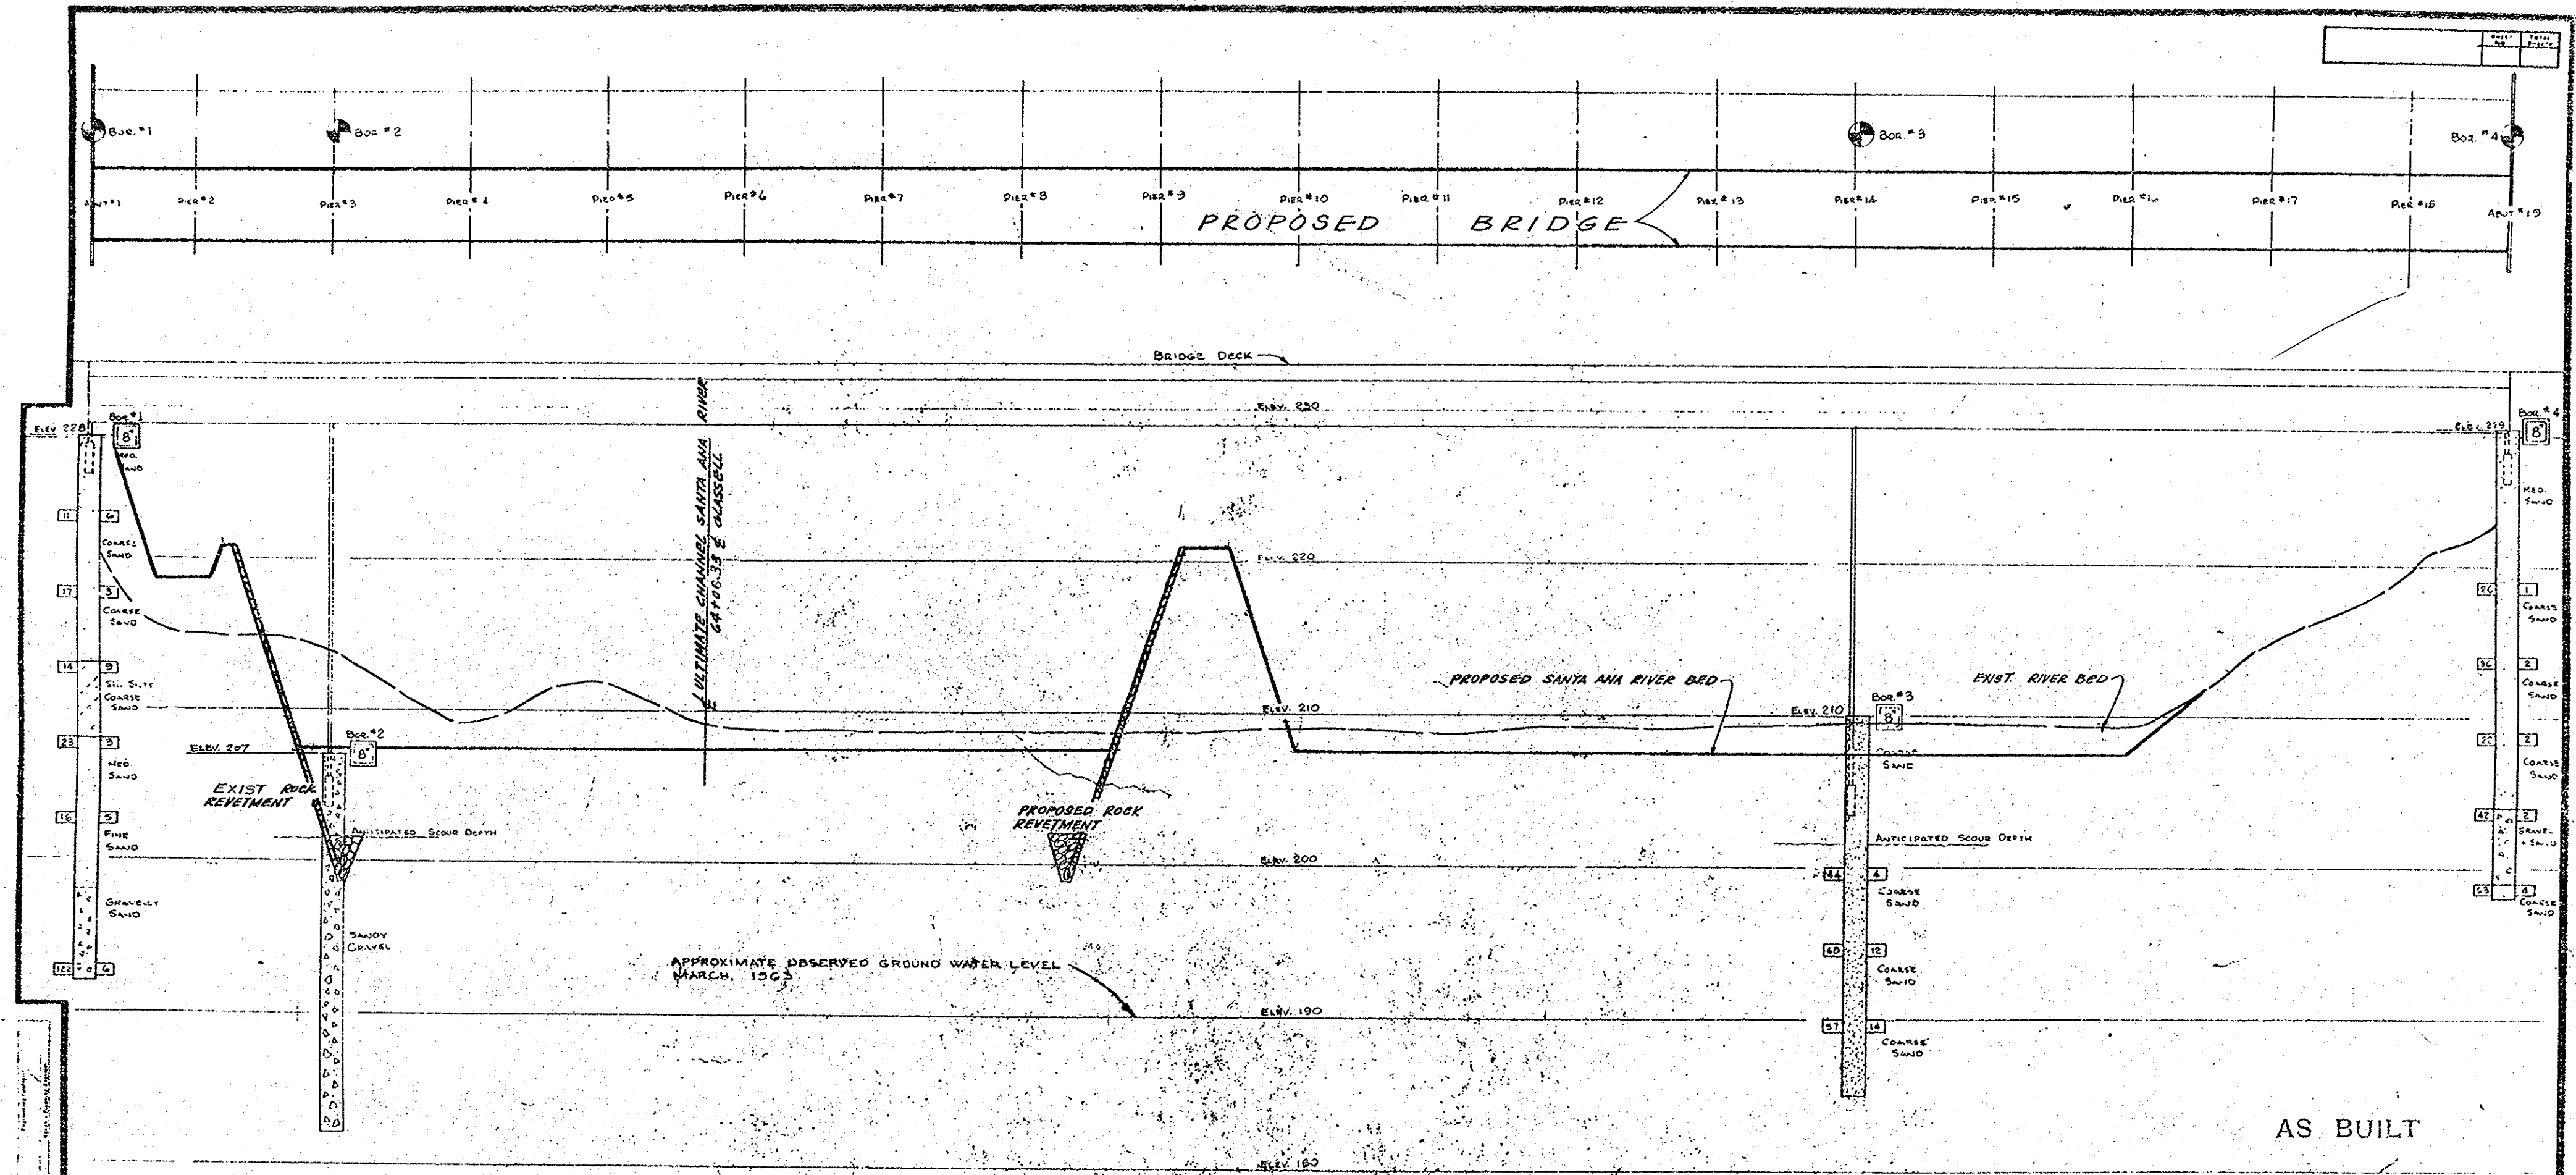

AS BUILT

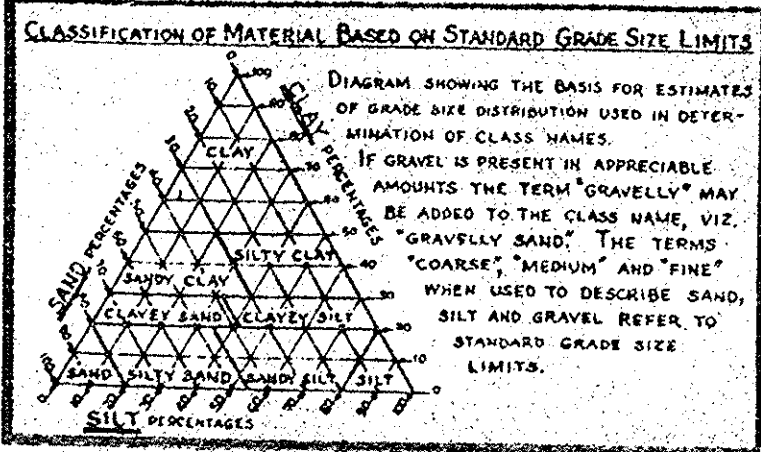

LEGEND OF EARTH MATERIALS

GRAVEL	SILTY CLAY OR CLAYEY SILT
SAND	PEAT AND/OR ORGANIC MATTER
SILT	FILL MATERIAL
CLAY	IGNEOUS ROCK
SANDY CLAY OR CLAYEY SAND	SEDIMENTARY ROCK
SANDY SILT OR SILTY SAND	METAMORPHIC ROCK

LEGEND OF BORING OPERATIONS

- PLAN OF ANY BORING
- PENETROMETER
- 2 1/4" CONE PENETROMETER
- 2 1/2" SAMPLER BORING (DRY)
- 2 1/2" ROTARY BORING (WET)
- AUGER BORING (DRY)
- JET BORING
- CORE BORING
- TEST PIT

Top Hole El. B-NR
Casing driven
Blows per foot (Using 140 lb hammer with 30" drop or as noted)
Description of material
Moisture
Date of measurement
Unconformable material change
Unconformable material change

Top Hole El. B-NR
Pushed
Blows per foot
Date of measurement
Unconformable material change
Unconformable material change

ROTARY BORING
PENETRATION BORING

NOTES

The contractor's attention is directed to Section 2-105 of the Standard Specifications and to the Special Provisions accompanying this set of plans. Classification of earth material as shown on this sheet is based upon field inspection and is not to be construed to imply mechanical analysis.

ORANGE COUNTY ROAD DEPARTMENT
GLASSELL ST. BRIDGE
ACROSS
SANTA ANA RIVER
LOG OF TEST BORINGS

SCALE: HORIZ. 1"=50'
VERT. 1"=5'

BRIDGE 5A-B-1964 FILE SHEET 15 OF 15