




DIST	COUNTY	ROUTE	POST MILES	SHEET	TOTAL
12	ORA	FAUMOO7	TOTAL PROJECT	NO.	SHEETS
REGISTERED CIVIL ENGINEER <i>Denis H. Morgan</i> No. 35153 Exp. 9-30-93 CIVIL STATE OF CALIFORNIA PLANS APPROVAL DATE KERCHEVAL ENGINEERS CIVIL/STRUCTURAL ENGINEERING CONSTRUCTION MANAGEMENT 4740 MURPHY CANYON RD. SAN DIEGO, CA. 92123 (619) 571-0520					

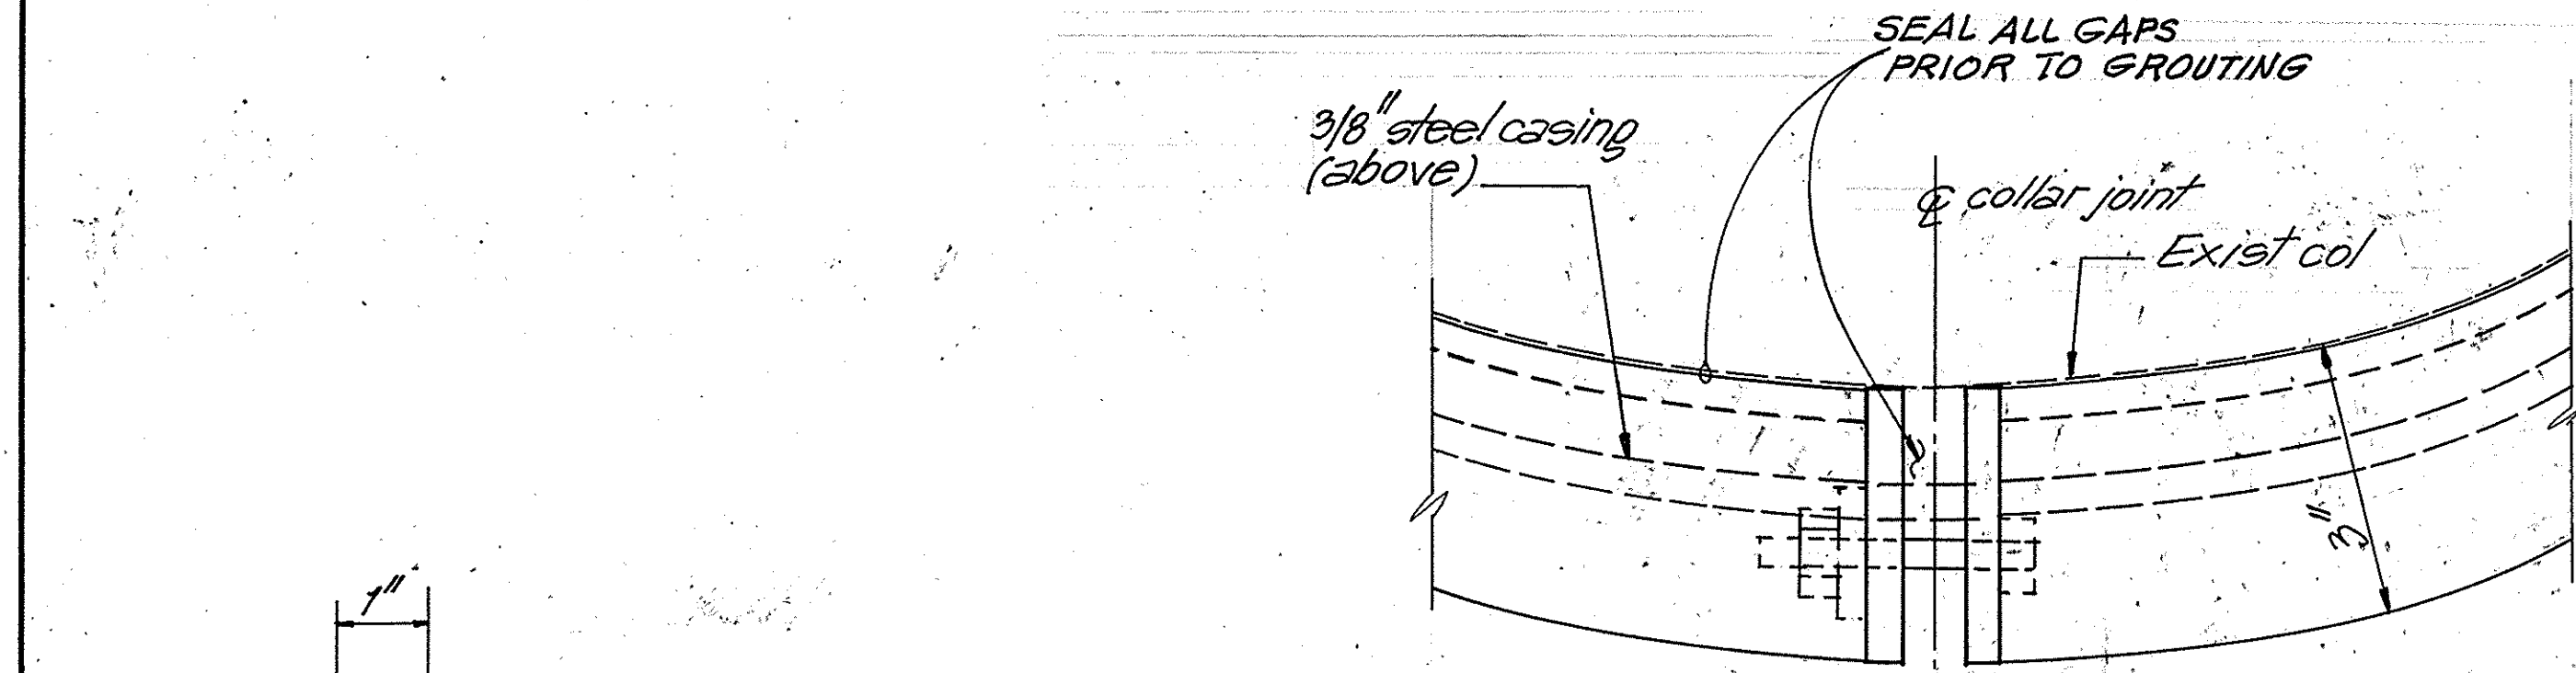

PLAN
NO SCALE

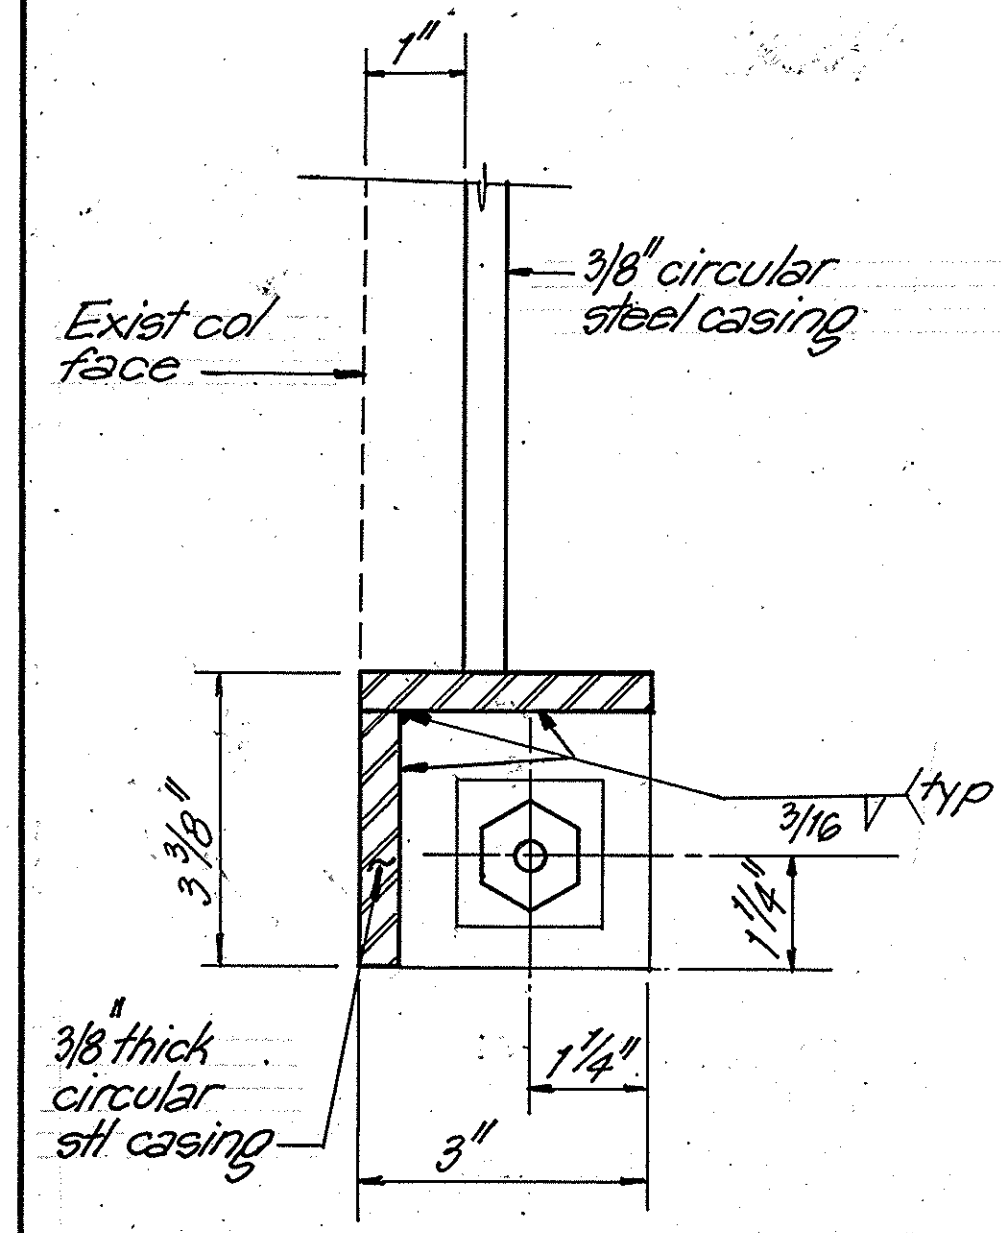


SECTION B-B (TYP)
NO SCALE

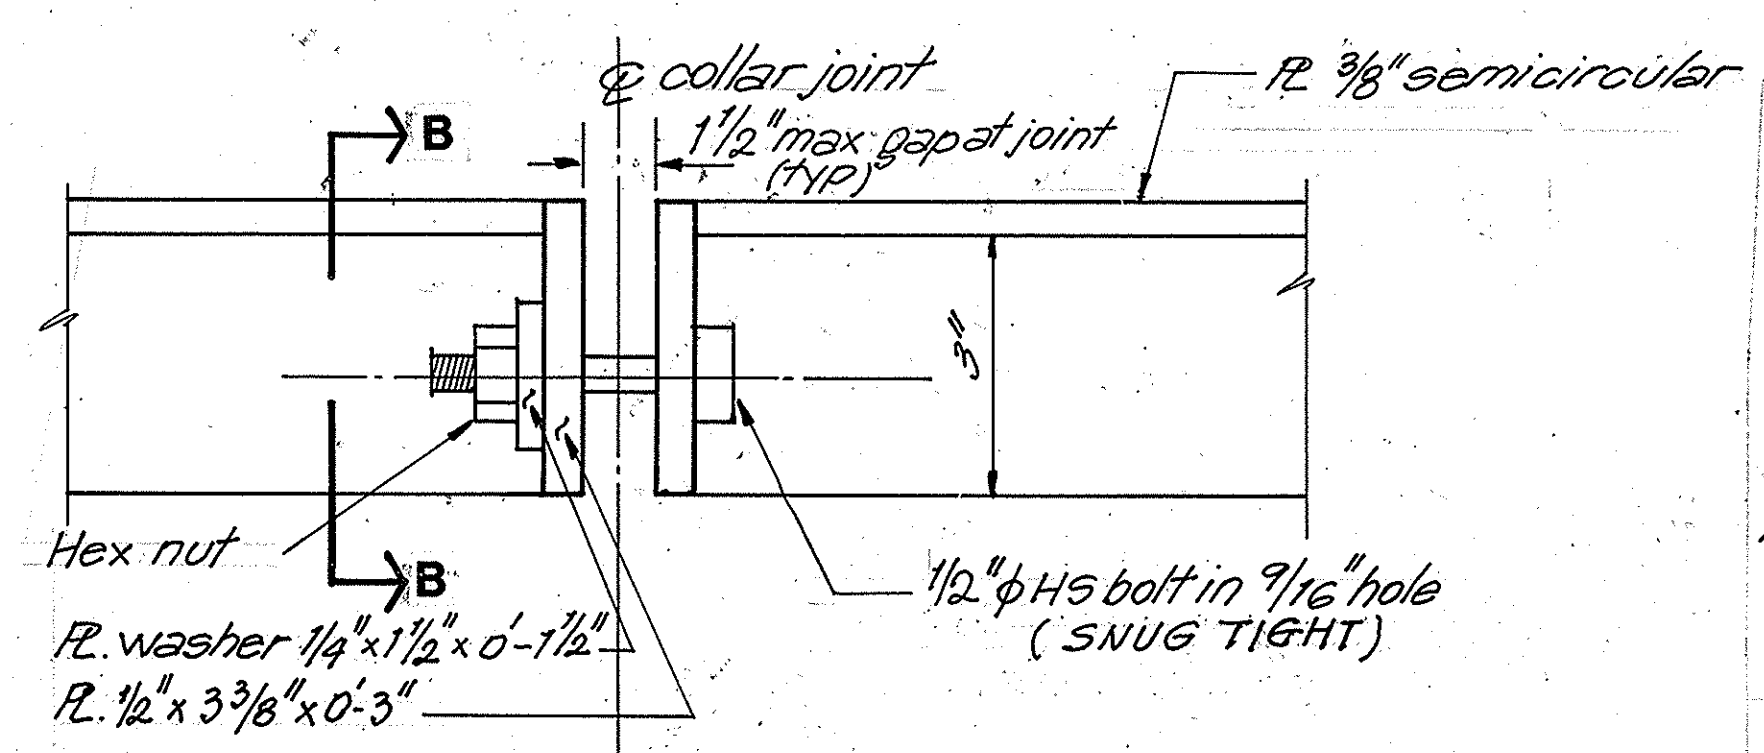


ELEVATION
NO SCALE


COLUMN CASING RETAINING COLLAR DETAILS 1

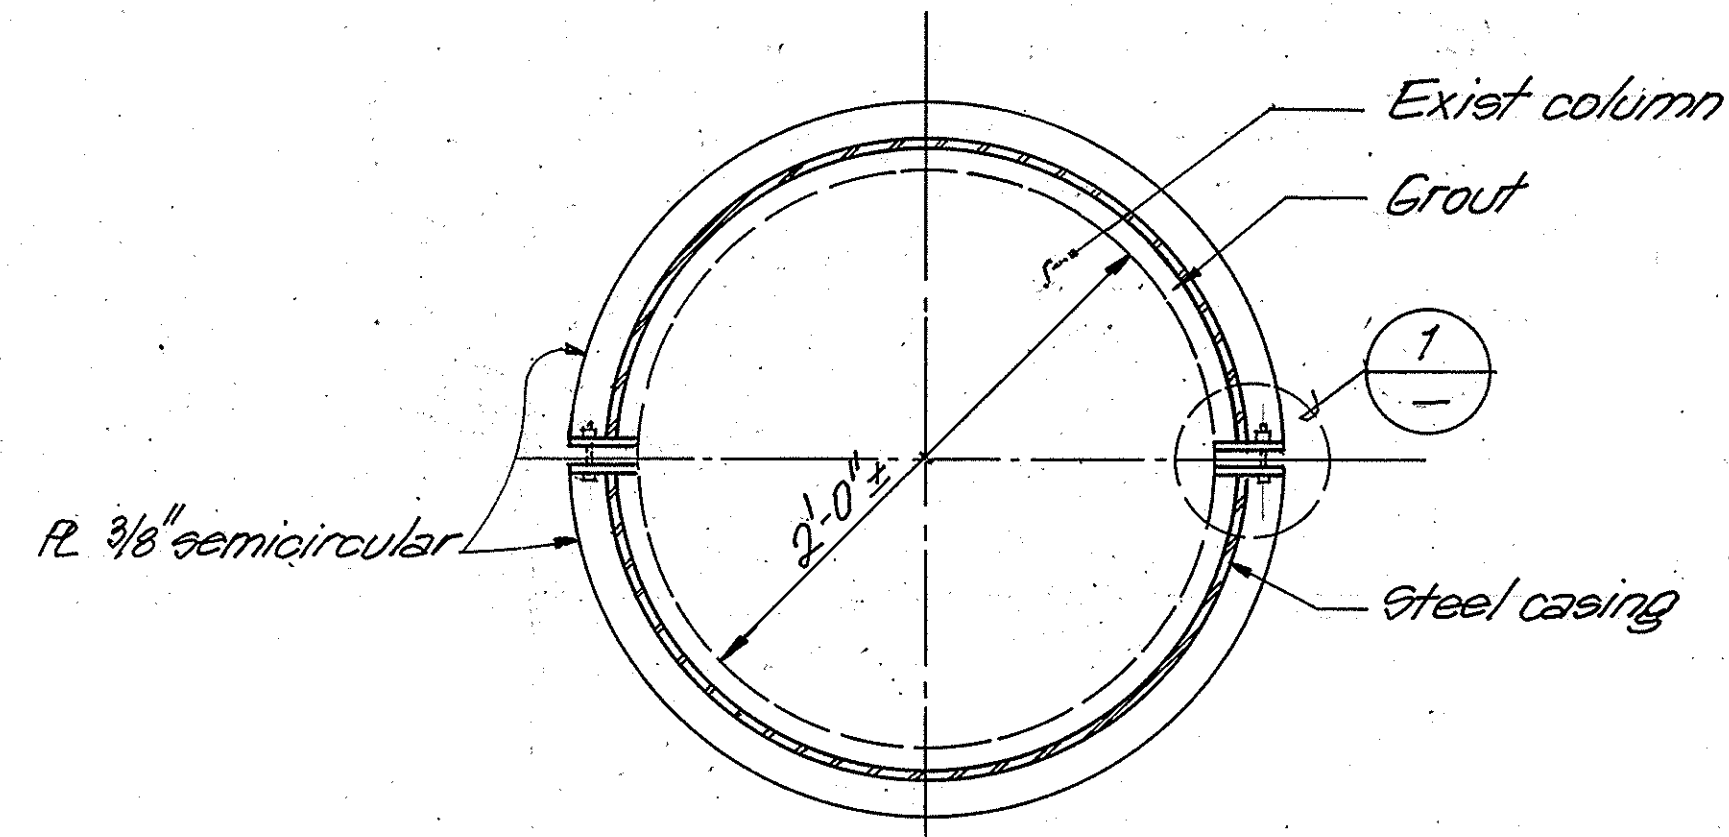


SECTION A-A (TYP)
1 1/2" = 1'-0"

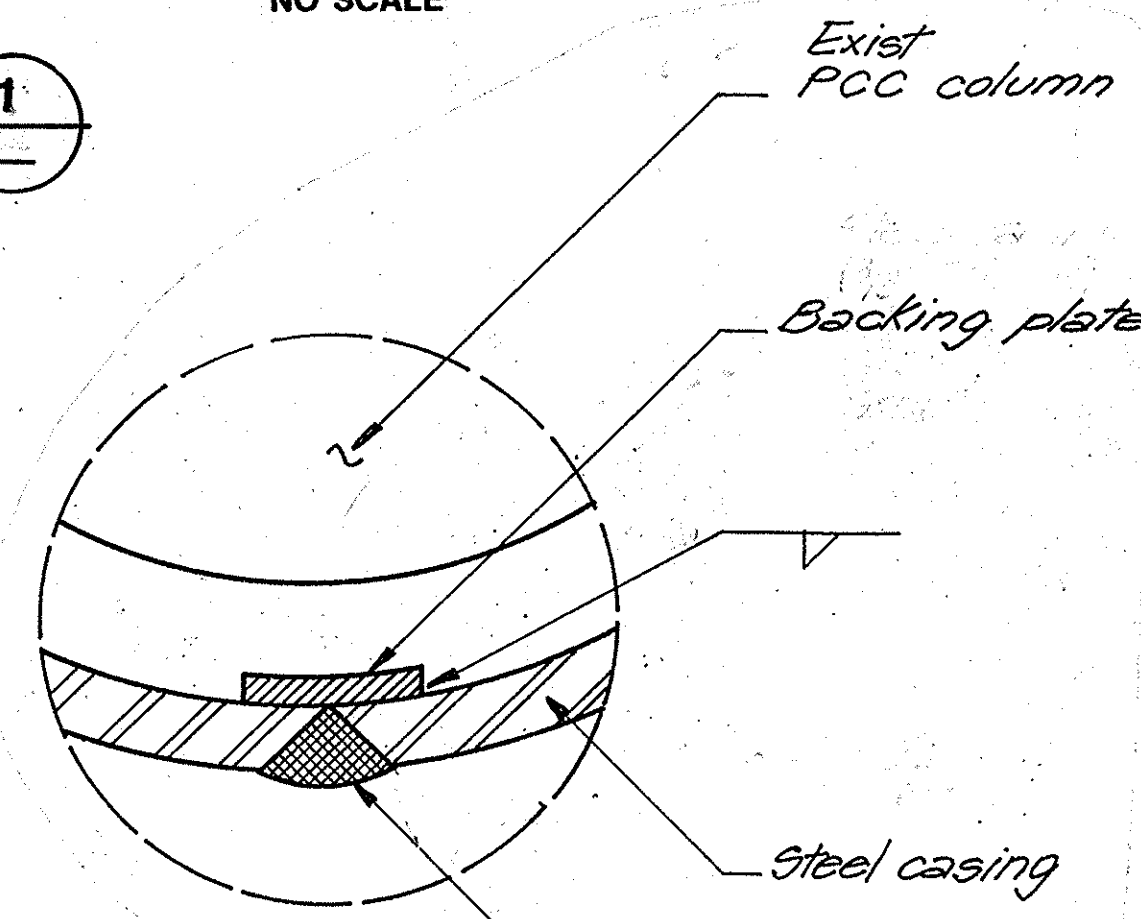

DETAIL A
NO SCALE

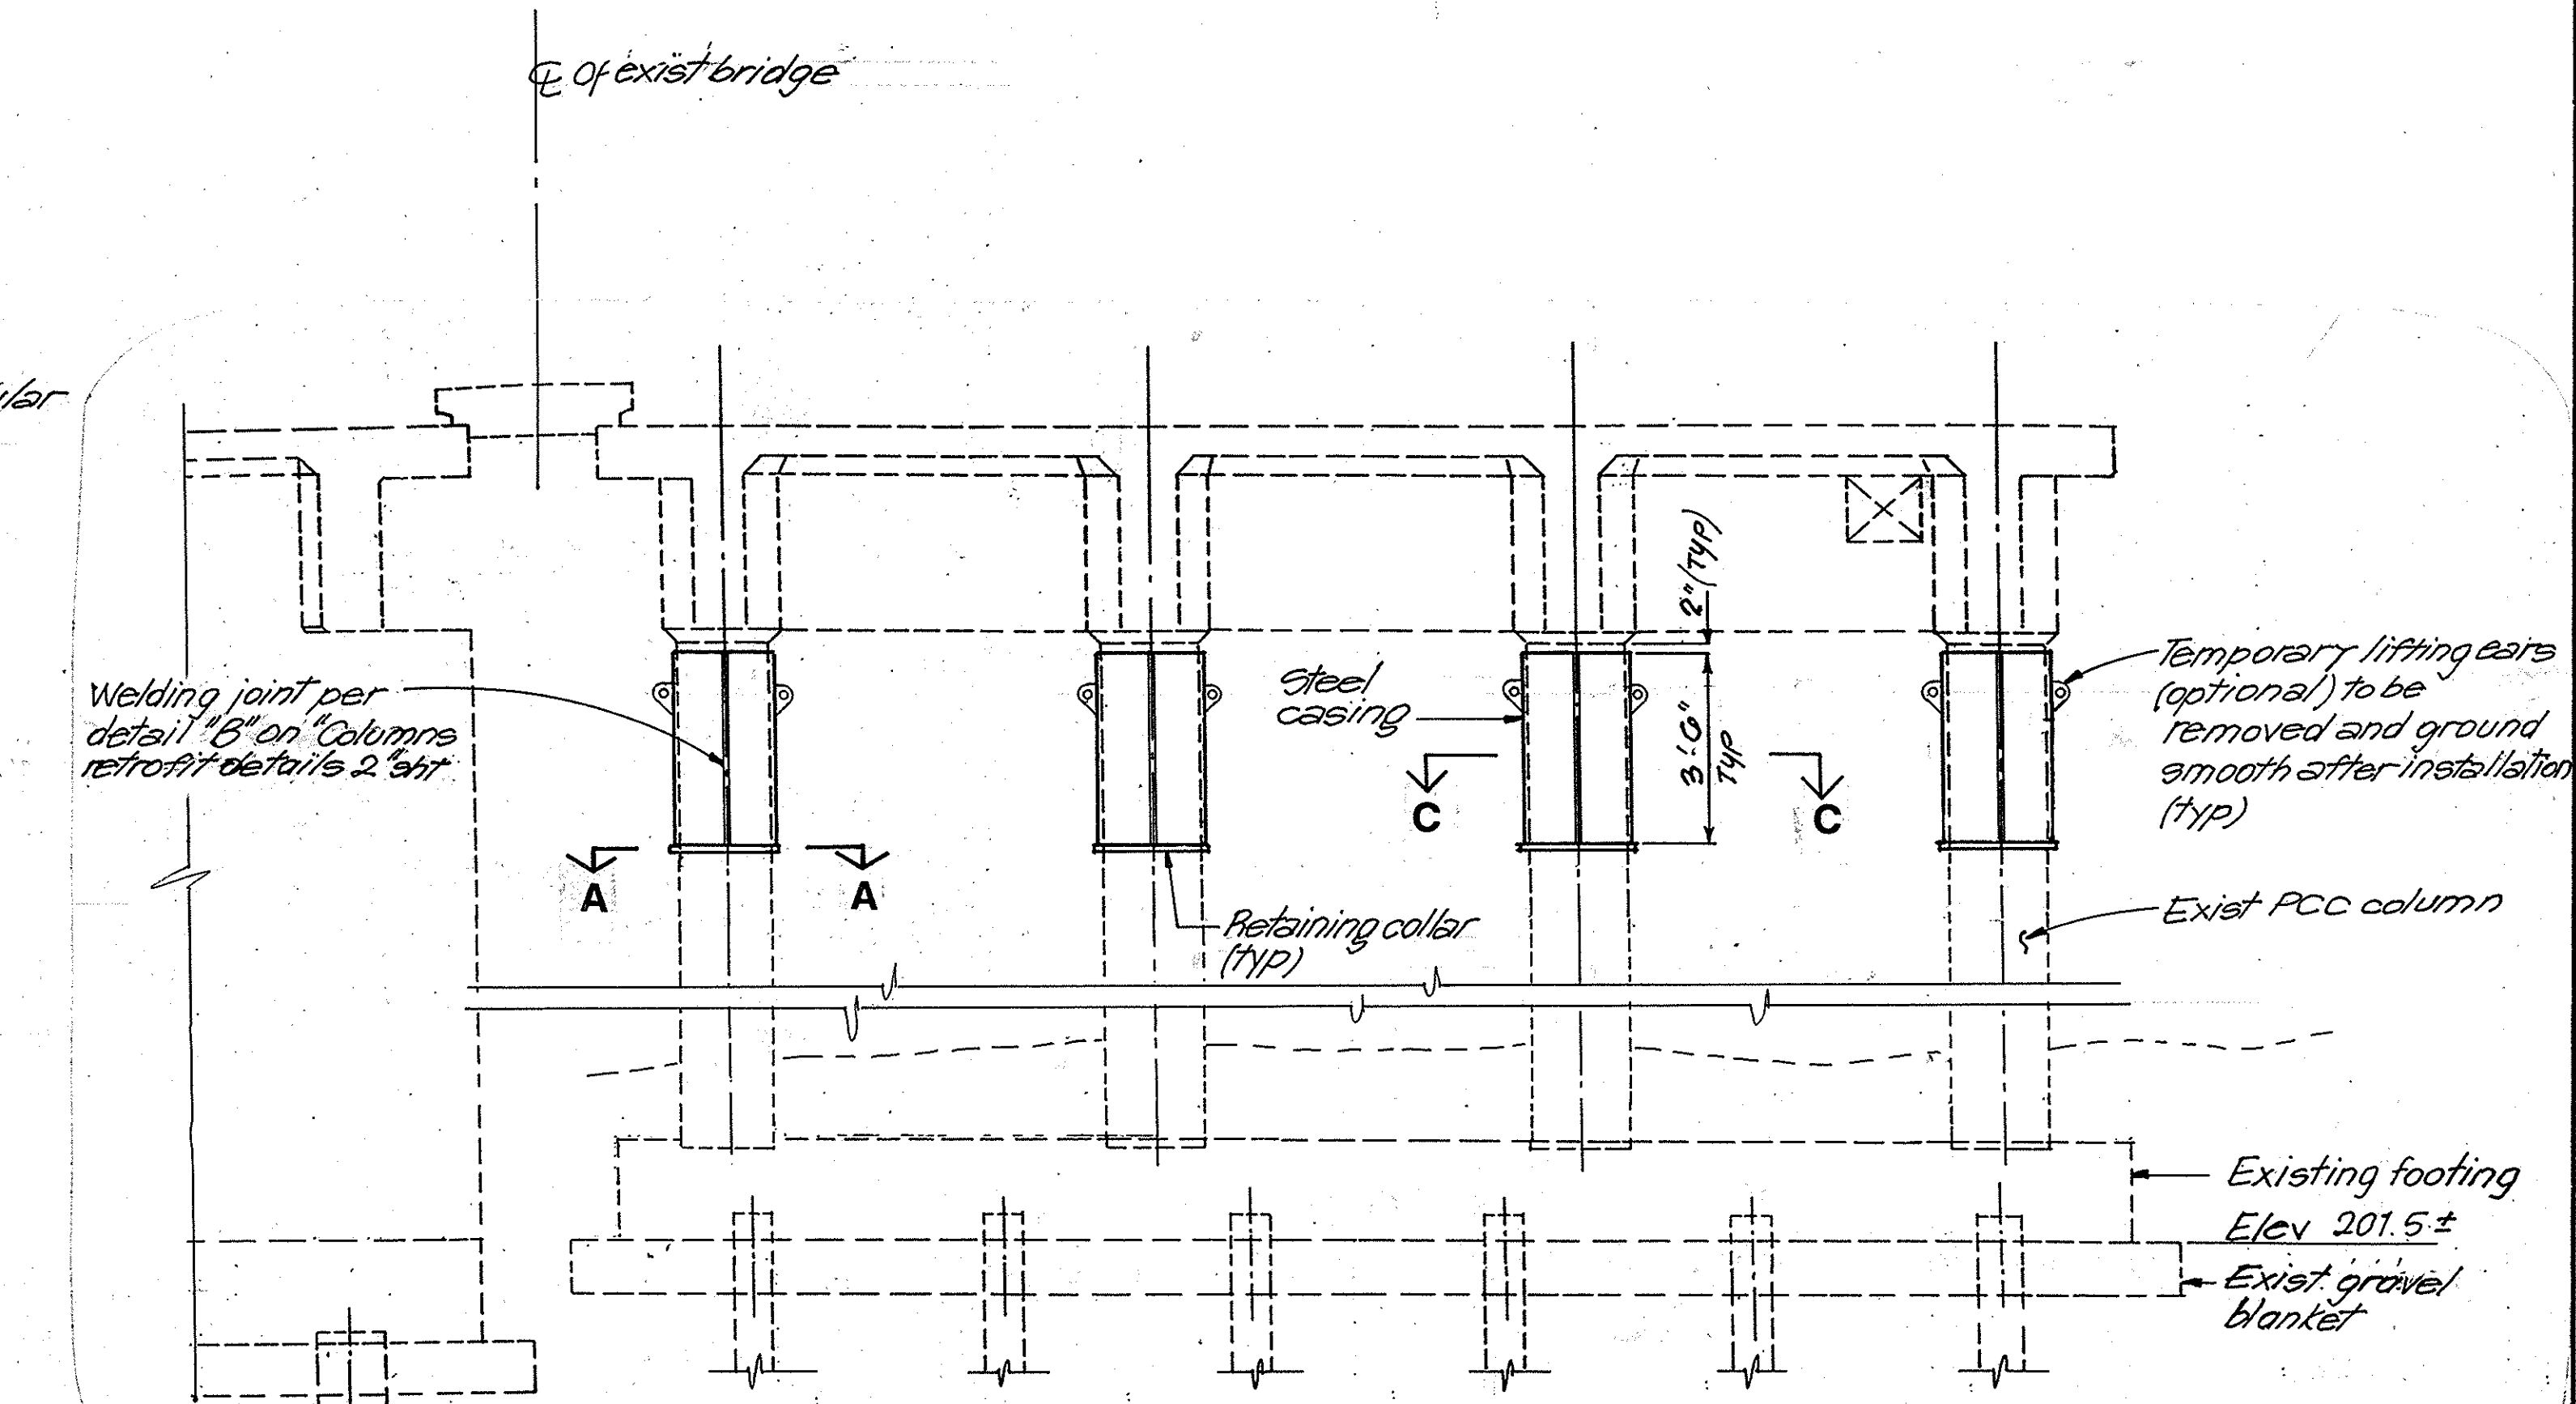

TYPICAL ELEVATION
NO SCALE

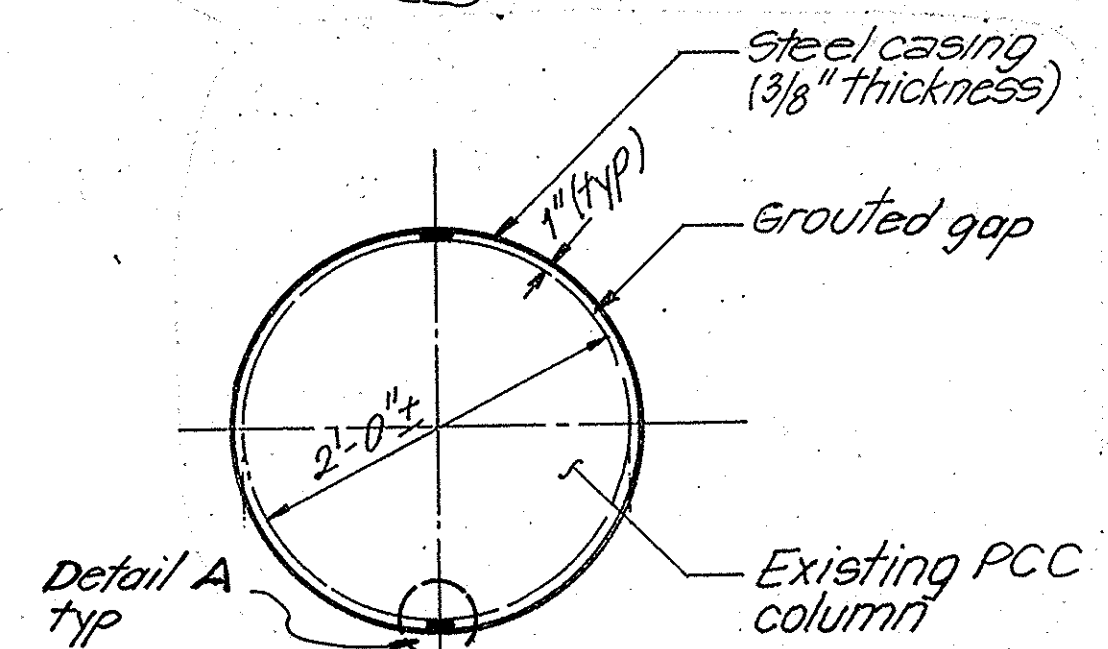

SECTION C-C
NO SCALE

NO RECORD DRAWING CHANGES
RECORD DRAWING
DATE : 04/15/1996

NOTES:
THE CONTRACTOR SHALL VERIFY ALL CONTROLLING FIELD DIMENSIONS BEFORE ORDERING OR FABRICATING ANY MATERIAL

PARTIAL HEIGHT CLASS "F" COLUMN RETROFIT

DESIGN BY CHIN C. CHEN CHECKED DENIS H. MORGAN				PREPARED FOR THE STATE OF CALIFORNIA DEPARTMENT OF TRANSPORTATION		BRIDGE NO. 55C-0130		SEISMIC RETROFIT PROJECT C46			
DETAILS BY GABRIELA GEORGESCU CHECKED LIMIN HE				PROJECT ENGINEER CHIN C. CHEN		POST MILE 5.4		GLASSELL STREET BRIDGE			
QUANTITIES BY LIMIN HE CHECKED K. KRISHNAN				CU 59N758-6 EA EQC-046		DISREGARD PRINTS BEARING EARLIER REVISION DATES		COLUMN RETROFIT DETAILS 1			
ORIGINAL SCALE IN INCHES FOR REDUCED PLANS				0 1 2 3		REVISION DATES (PRELIMINARY STAGE ONLY)		SHEET OF			
						12/20/92 4/22/93 7/7/93 2-22-95		3 7			