
ORANGE COUNTY

RESOURCES & DEVELOPMENT MANAGEMENT DEPARTMENT

SANTA ANA, CALIFORNIA BRYAN G. SPEEGLE, DIRECTOR

PLANS FOR CONSTRUCTION OF GLASSELL STREET BRIDGE WIDENING OVER SANTA ANA RIVER CHANNEL BRIDGE NO. 55C-0130

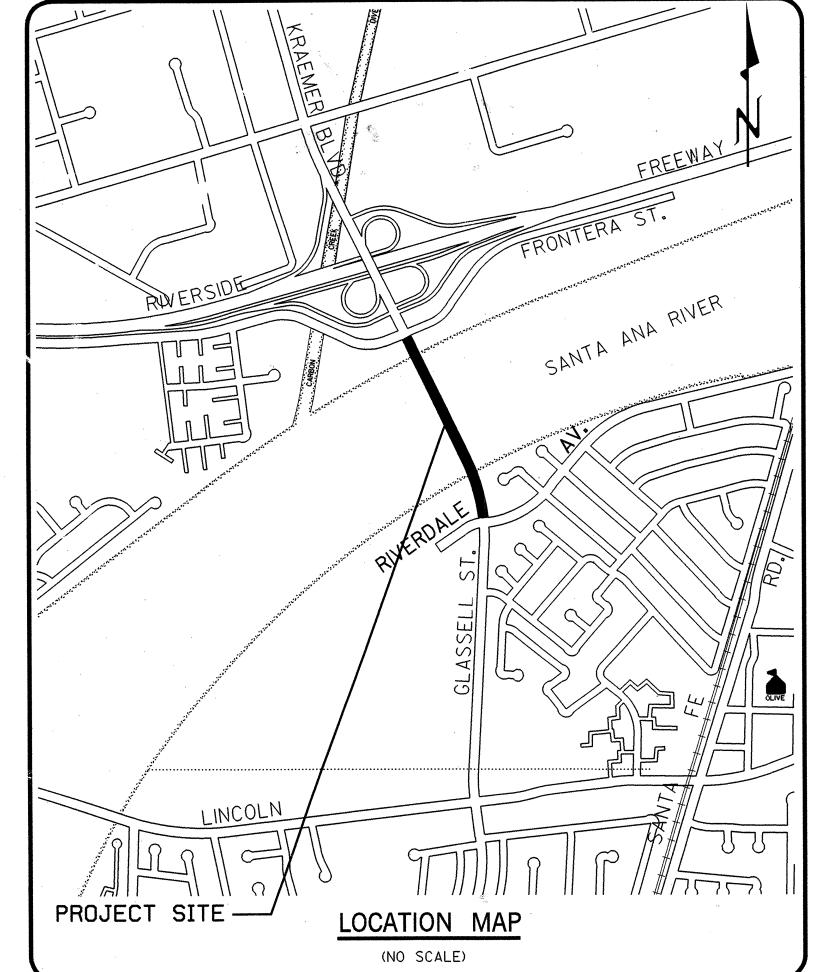

FUNDED BY: COUNTY ROAD FUNDS, HBRR, SAREEF AND CITY OF ORANGE (HBRR: FEDERAL PROJECT# BHLS-5955(045); STATE EA# 12-931660)

MAINTAINED BY

THE COUNTY WILL OWN AND MAINTAIN THE BRIDGE AND STREET IMPROVEMENTS WITHIN THE UNINCORPORATED COUNTY LIMITS WITH EXCEPTION OF MAINTENANCE AND ENERGY CHARGES FOR ALL STREET LIGHTS WHICH WILL BE BORNE BY THE CITY OF ORANGE PER AGREEMENT NO. D00-104. AT PROJECT'S NOTICE OF COMPLETION, THE CITY OF ORANGE AND THE CITY OF ANAHEIM WILL OWN AND MAINTAIN BRIDGE AND OR STREET IMPROVEMENTS WITHIN THEIR RESPECTIVE CITY LIMITS.

COST REDUCTION INCENTIVE PROPOSAL CRIP)

BRIDGE PRE-CAST ELEMENTS REPLACED WITH CAST-IN-PLACE ALTERNATIVE FOR THE SUPERSTRUCTURE PER CONTRACT CHANGE ORDER NO.3 TO AGREEMENT NO.DO4-0.65.

APPROVED:

DIRECTOR PUBLIC WORKS/CHIEF ENGINEER, RDMD

APPROVED

PUBLIC WORKS DIRECTOR/CITY ENGINEER, CITY OF ORANGE DATE

APPROVED:

DATE

THE ELEVATIONS NOTED HERON ARE IN TERMS OF NGVD OF 1929, BASED LOCALLY **UPON OCS 1976 ADJUSTMENT FOR BENCHMARK** OCS BM 1L-61-82: ELEVATION 232.099

BENCH MARK

RECORD DRAWINGS

START: 2/4/05

COMPLETED : 7/17/06

RE: BRYAN MCKINNEY

INSP: CALOPEZ/B VALLE

APPROVALS 4-12-04 APPROVED: BURLIC WORKS DIRECTOR/CITY ENGINEER APPROVED FOR WORK WITHIN THE CITY OF ANAHEIM LIMITS DIRECTOR PUBLIC WORKS/CITY ENGINEER RCP 2002-03318 APPROVED FOR WORK WITHIN OCWD RIGHT-OF-WAY

RESOURCES & DEVELOPMENT MANAGEMENT APPROVED FOR WORK WITHIN THE UNINCORPORAT **COUNTY LIMITS** SUBMITTED: **RECOMMENDED:** APPROVED: RECTOR PUBLIC WORKS/CHIEF ENGINEER

PREPARED BY W. Koo & Associates, Inc. 600 The City Parkway West, Suite 310 FAX: (714) 456-0295

NO. **DESCRIPTION** APPROVED DATE REVISIONS

INDEX OF SHEETS

DESCRIPTION

KEY MAP AND PROJECT CONTROL

SURVEY CONTROL SCHEMATIC

RETAINING WALL DETAILS

TRAFFIC HANDLING PLAN

LIGHTING PLAN

UTILITY PLAN

SIGNING AND STRIPING PLAN

CIVIL GENERAL NOTES AND ABBREVIATIONS

MAINTENANCE ROAD/BIKEWAY (MR/BW) GRADING PLAN

MAINTENANCE ROAD/BIKEWAY (MR/BW) DRAINAGE PLAN

MAINTENACE ROAD/BIKEWAY (MR/BW) DRAINAGE DETAILS GLASSELL APPROACH DRAINAGE PLAN AND PROFILE

GLASSELL APPROACH TYPICAL SECTIONS GLASSELL APPROACH MODIFICATION PLAN

GLASSELL APPROACH DRAINAGE DETAILS

(714) 744-5536

(714) 744-4129

(714) 765-5259

(714) 765-4271

(909) 549-3977

(714) 378-3329

(714) 593-7318

(714) 666-5467

(818) 701-4546

(714) 536-6854

DESIGN DEVIATION

MIKE JOUHARI

MARK KOMOTO

TIMOTHY BASS MARK O'MARA

BOB CHENOWITH

RON DIETL

ANITA VALKO

4/24/04

LESLIE WOOLSLAIR

TITLE SHEET

21-23

27-28

31-32

CITY OF ORANGE, TRAFFIC

SBC (Formerly Pacific Bell)

LEVEL 3 COMMUNICATIONS

TO MINIMIZE PONDING.

CITY OF ORANGE WATER DEPARTMENT

CITY OF ANEHEIM WATER DEPARTMENT

CITY OF ANEHEIM SEWER DEPARTMENT CITY OF ANEHEIM ELECTRIC DEPARTMENT

ORANGE COUNTY SANITATION DISTRICT

SEMPRA ENERGY (Formerly The Gas Company) (714) 634-3034

COMCAST (Formerly AT&T Broadband)

THE GAS COMPANY - TRANSMISSION

SCE TRANSMISSION - REAL ESTATE

SOUTHERN CALIFORNIA EDISON **ORANGE COUNTY WATER DISTRICT**

UTILITY OWNER

W. O. NO. ER08933 DWG. NO.