


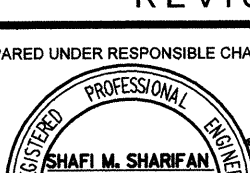

MARK	DATE	DESCRIPTION	
REVISIONS			
PREPARED UNDER RESPONSIBLE CHARGE OF: 			
			DATE

ORANGE COUNTY
PUBLIC FACILITIES AND RESOURCES DEPARTMENT

GLASSELL STREET BRIDGE WIDENING
OVER SANTA ANA RIVER

RETAINING WALL NO. 1

STRUCTURE PLAN

DESIGNED <u>G. BUELOW</u>	SHEET
DRAWN <u>G. BUELOW</u>	14
SCALE AS SHOWN	OF 70
DATE 7/19/02	
	CHECKED <u>S. SHARIFAN</u> DRAWING NO.