
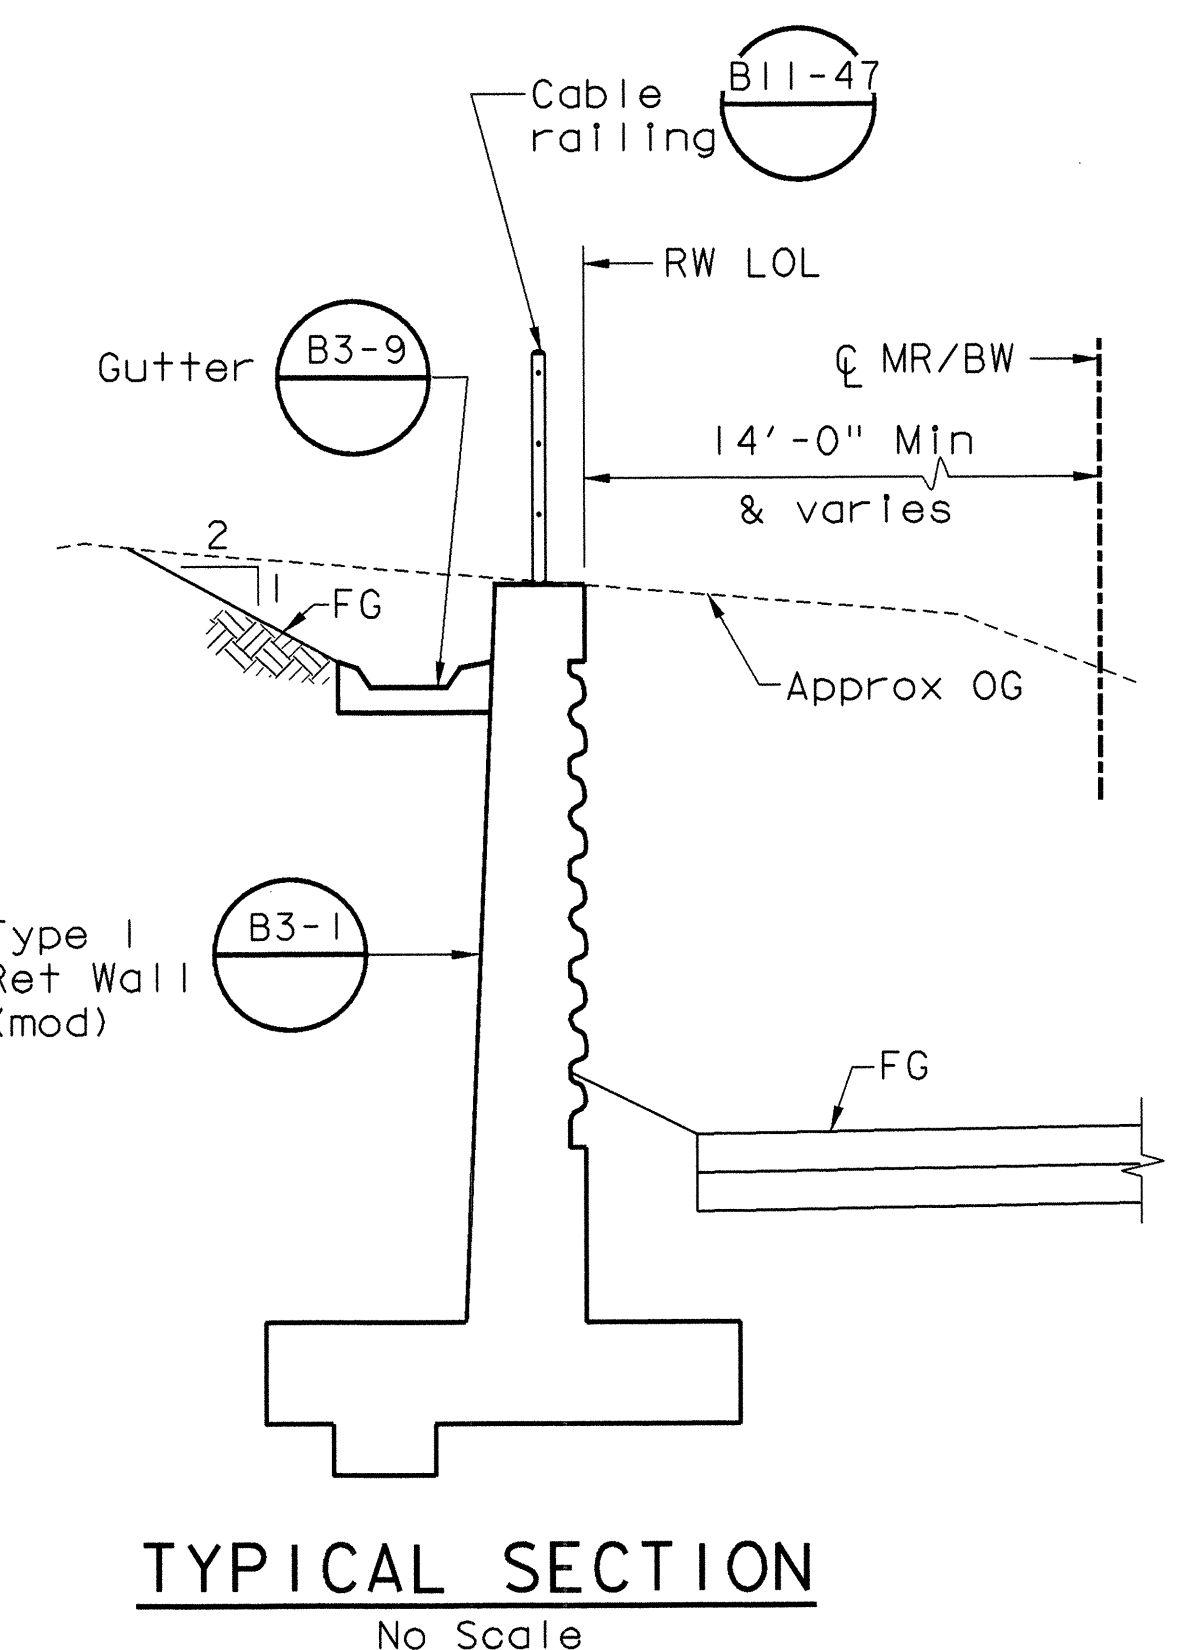
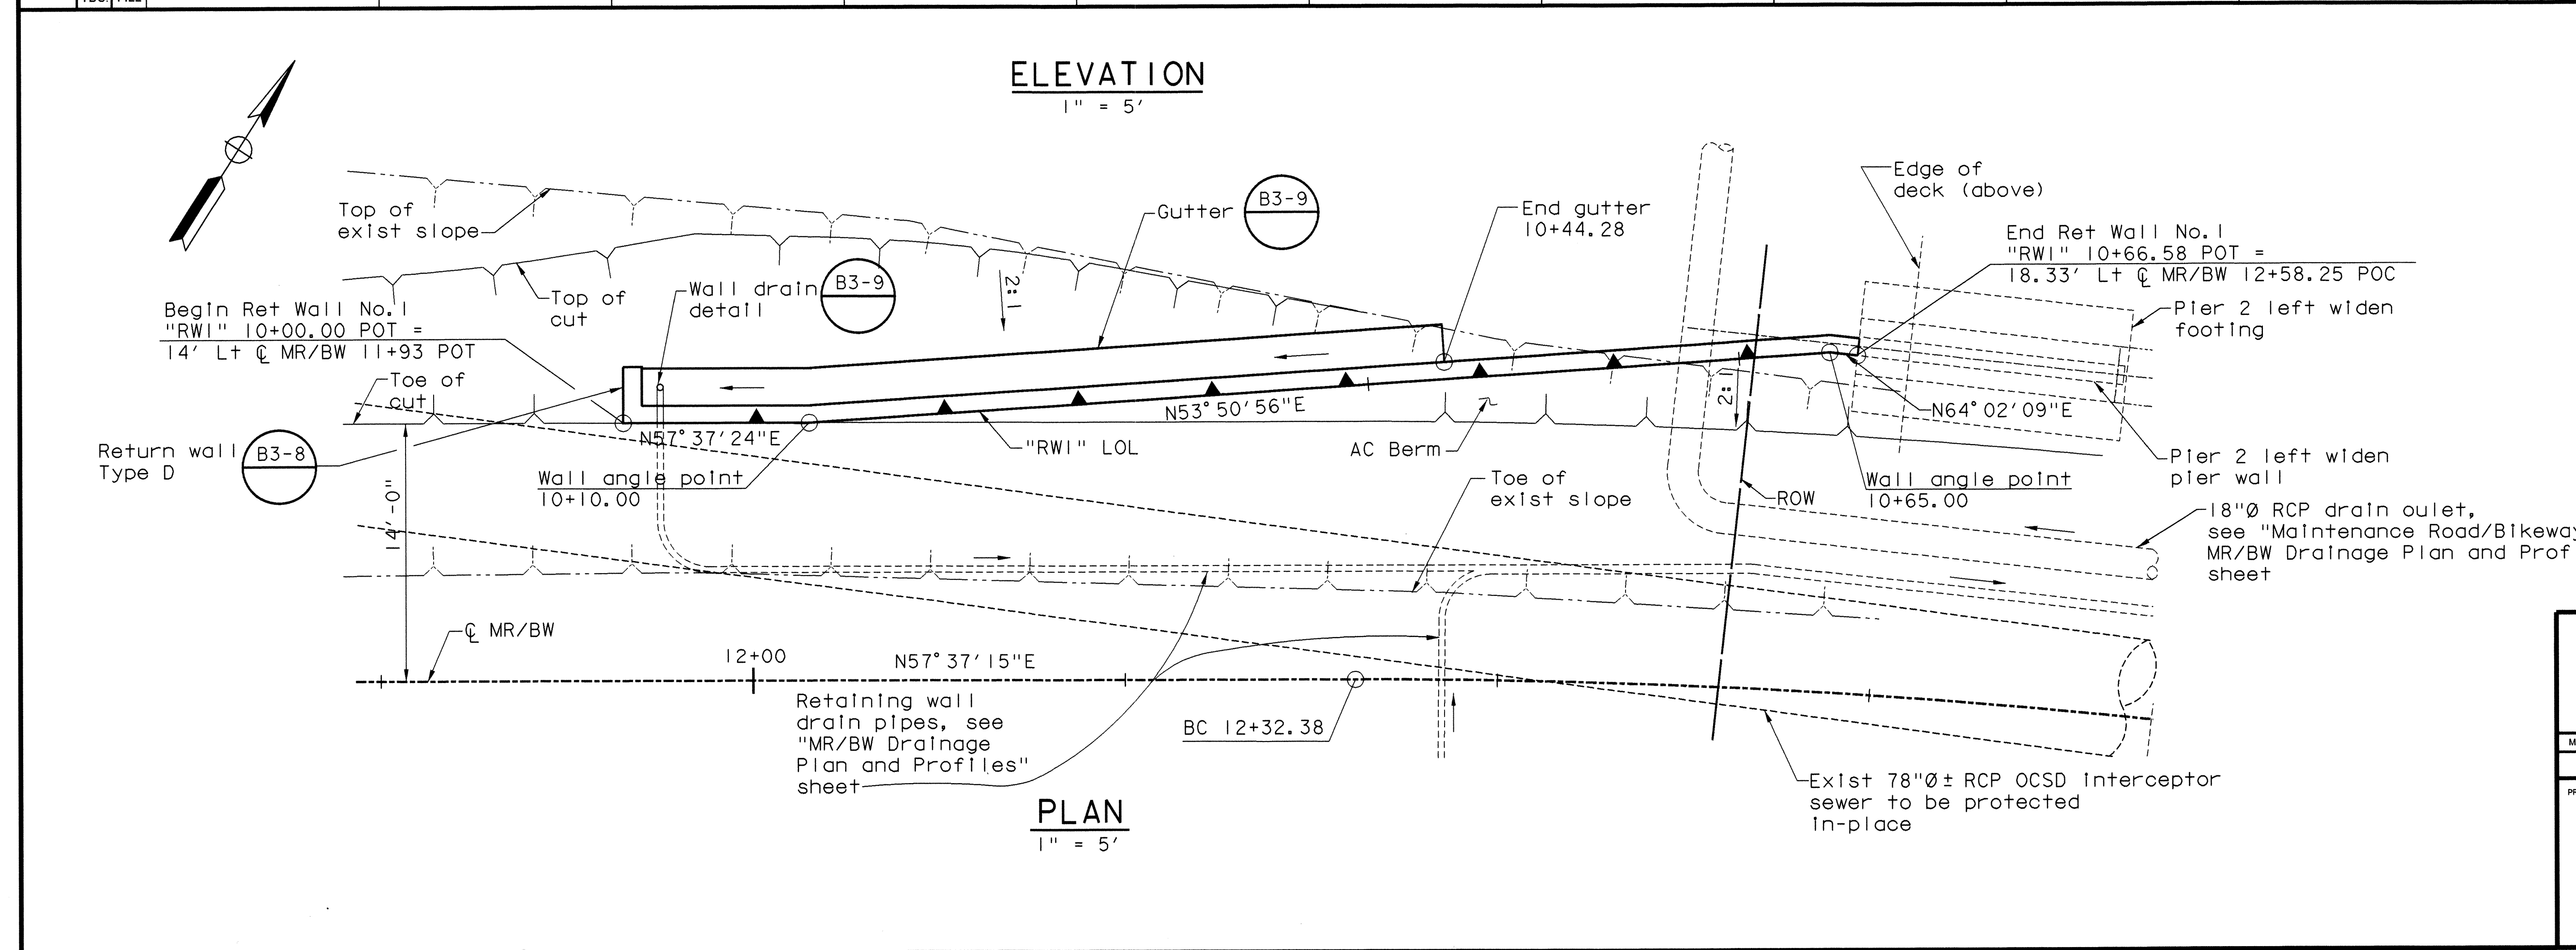


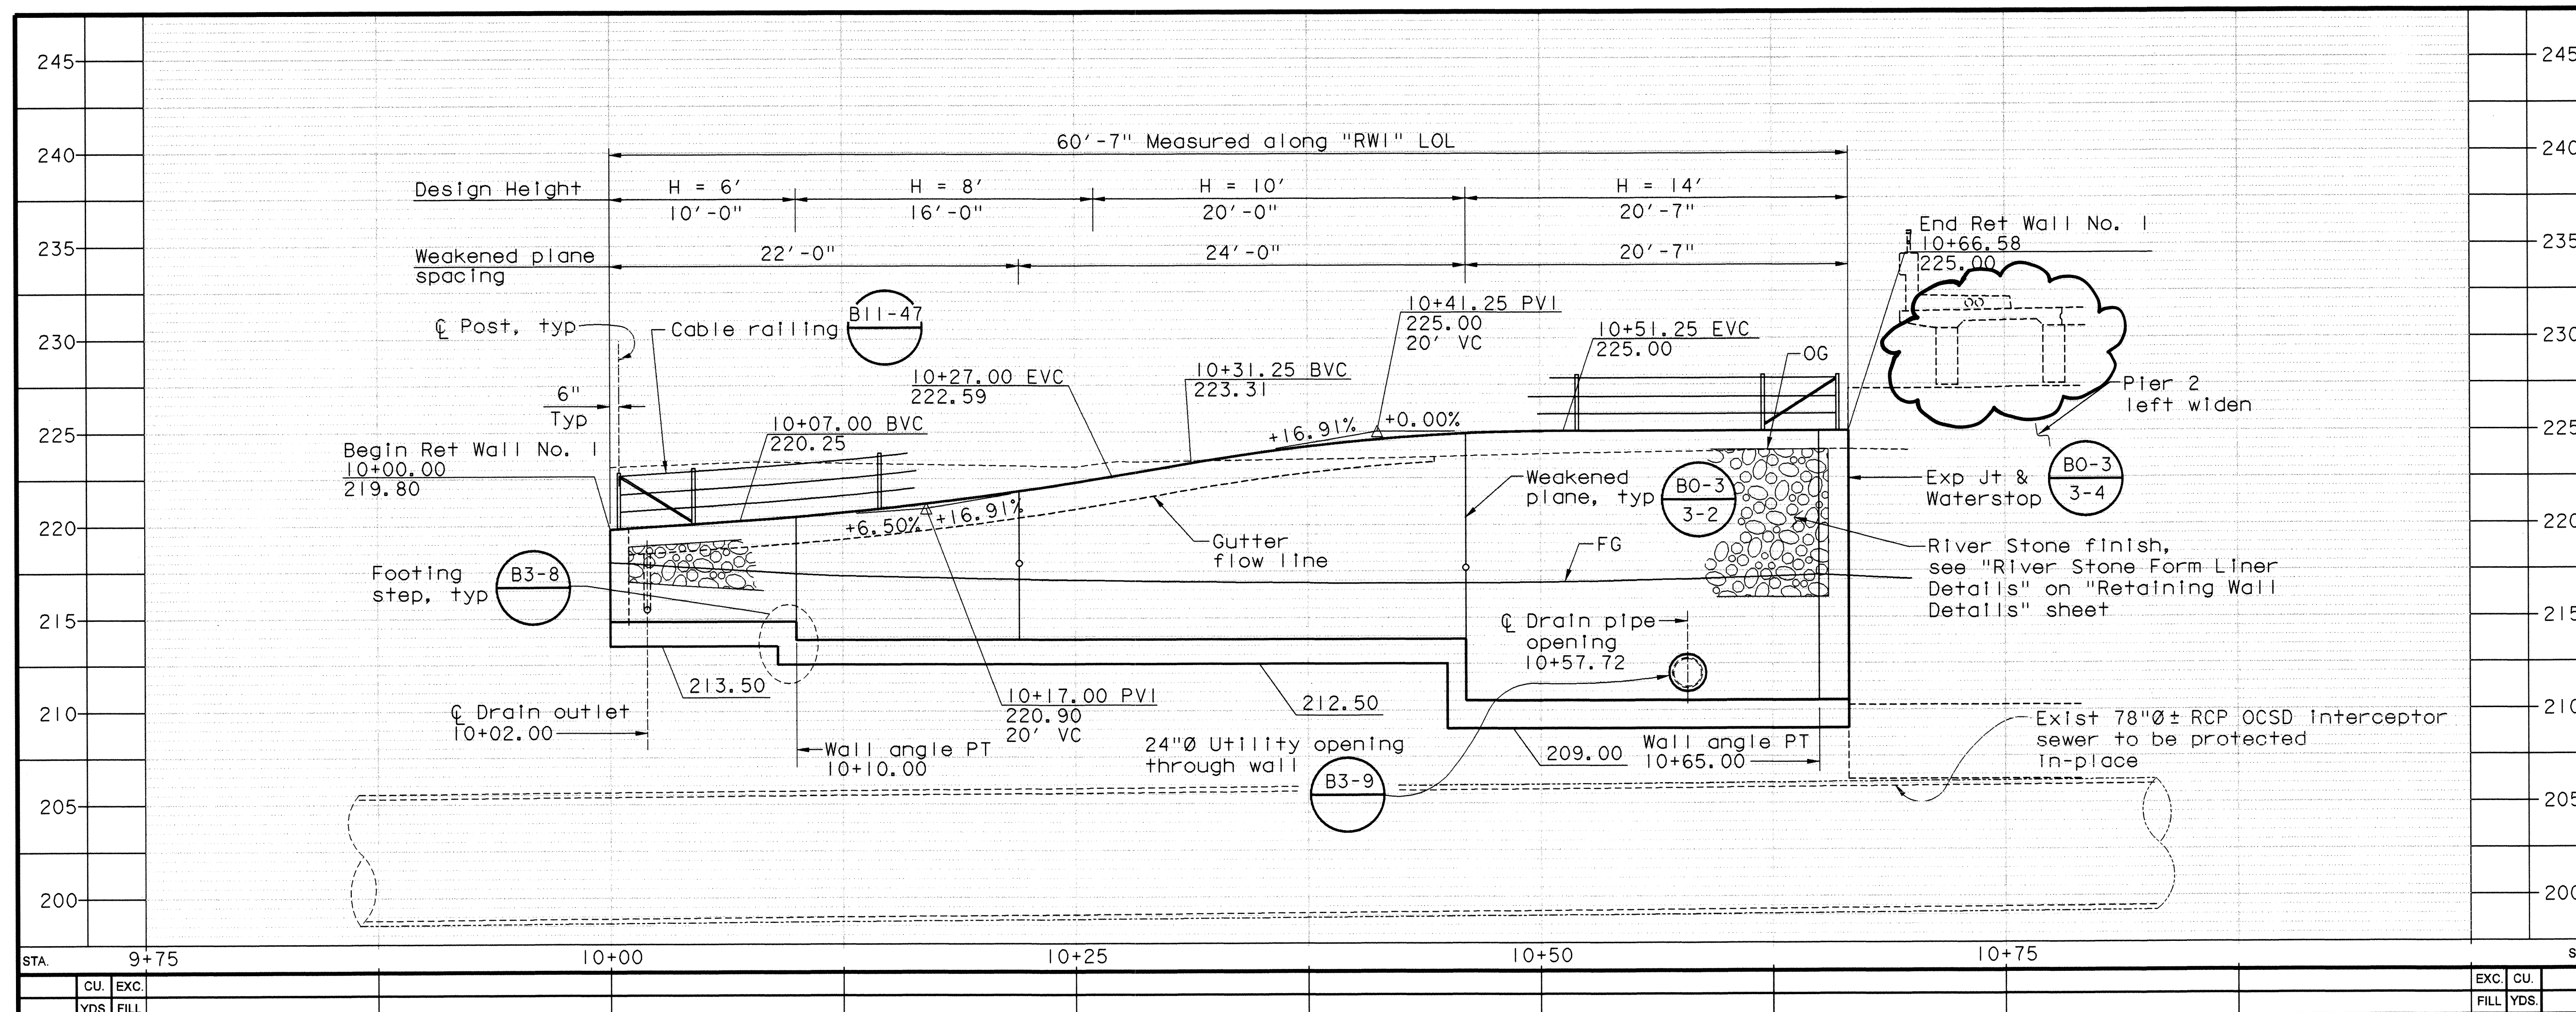

W. Koo & Associates, Inc.
600 The City Parkway West, Suite 310
Orange, CA 92668
PH: (714) 456-0280
FAX: (714) 456-0295

ORANGE COUNTY RESOURCES AND DEVELOPMENT MANAGEMENT DEPARTMENT		
GLASSELL STREET BRIDGE WIDENING OVER SANTA ANA RIVER		
RETAINING WALL NO. 1 STRUCTURE PLAN		
MARK	DATE	DESCRIPTION
REVISIONS		
PREPARED UNDER RESPONSIBLE CHARGE OF:		
DESIGNED	G. BUELOW	SHEET
DRAWN	G. BUELOW	14R
CHECKED	S. SHARIFAN	OF 70
SCALE	DATE	DRAWING NO.
AS SHOWN	7/19/02	