


PROFILE

Horiz: 1"=10'
Vert: 1'=5'

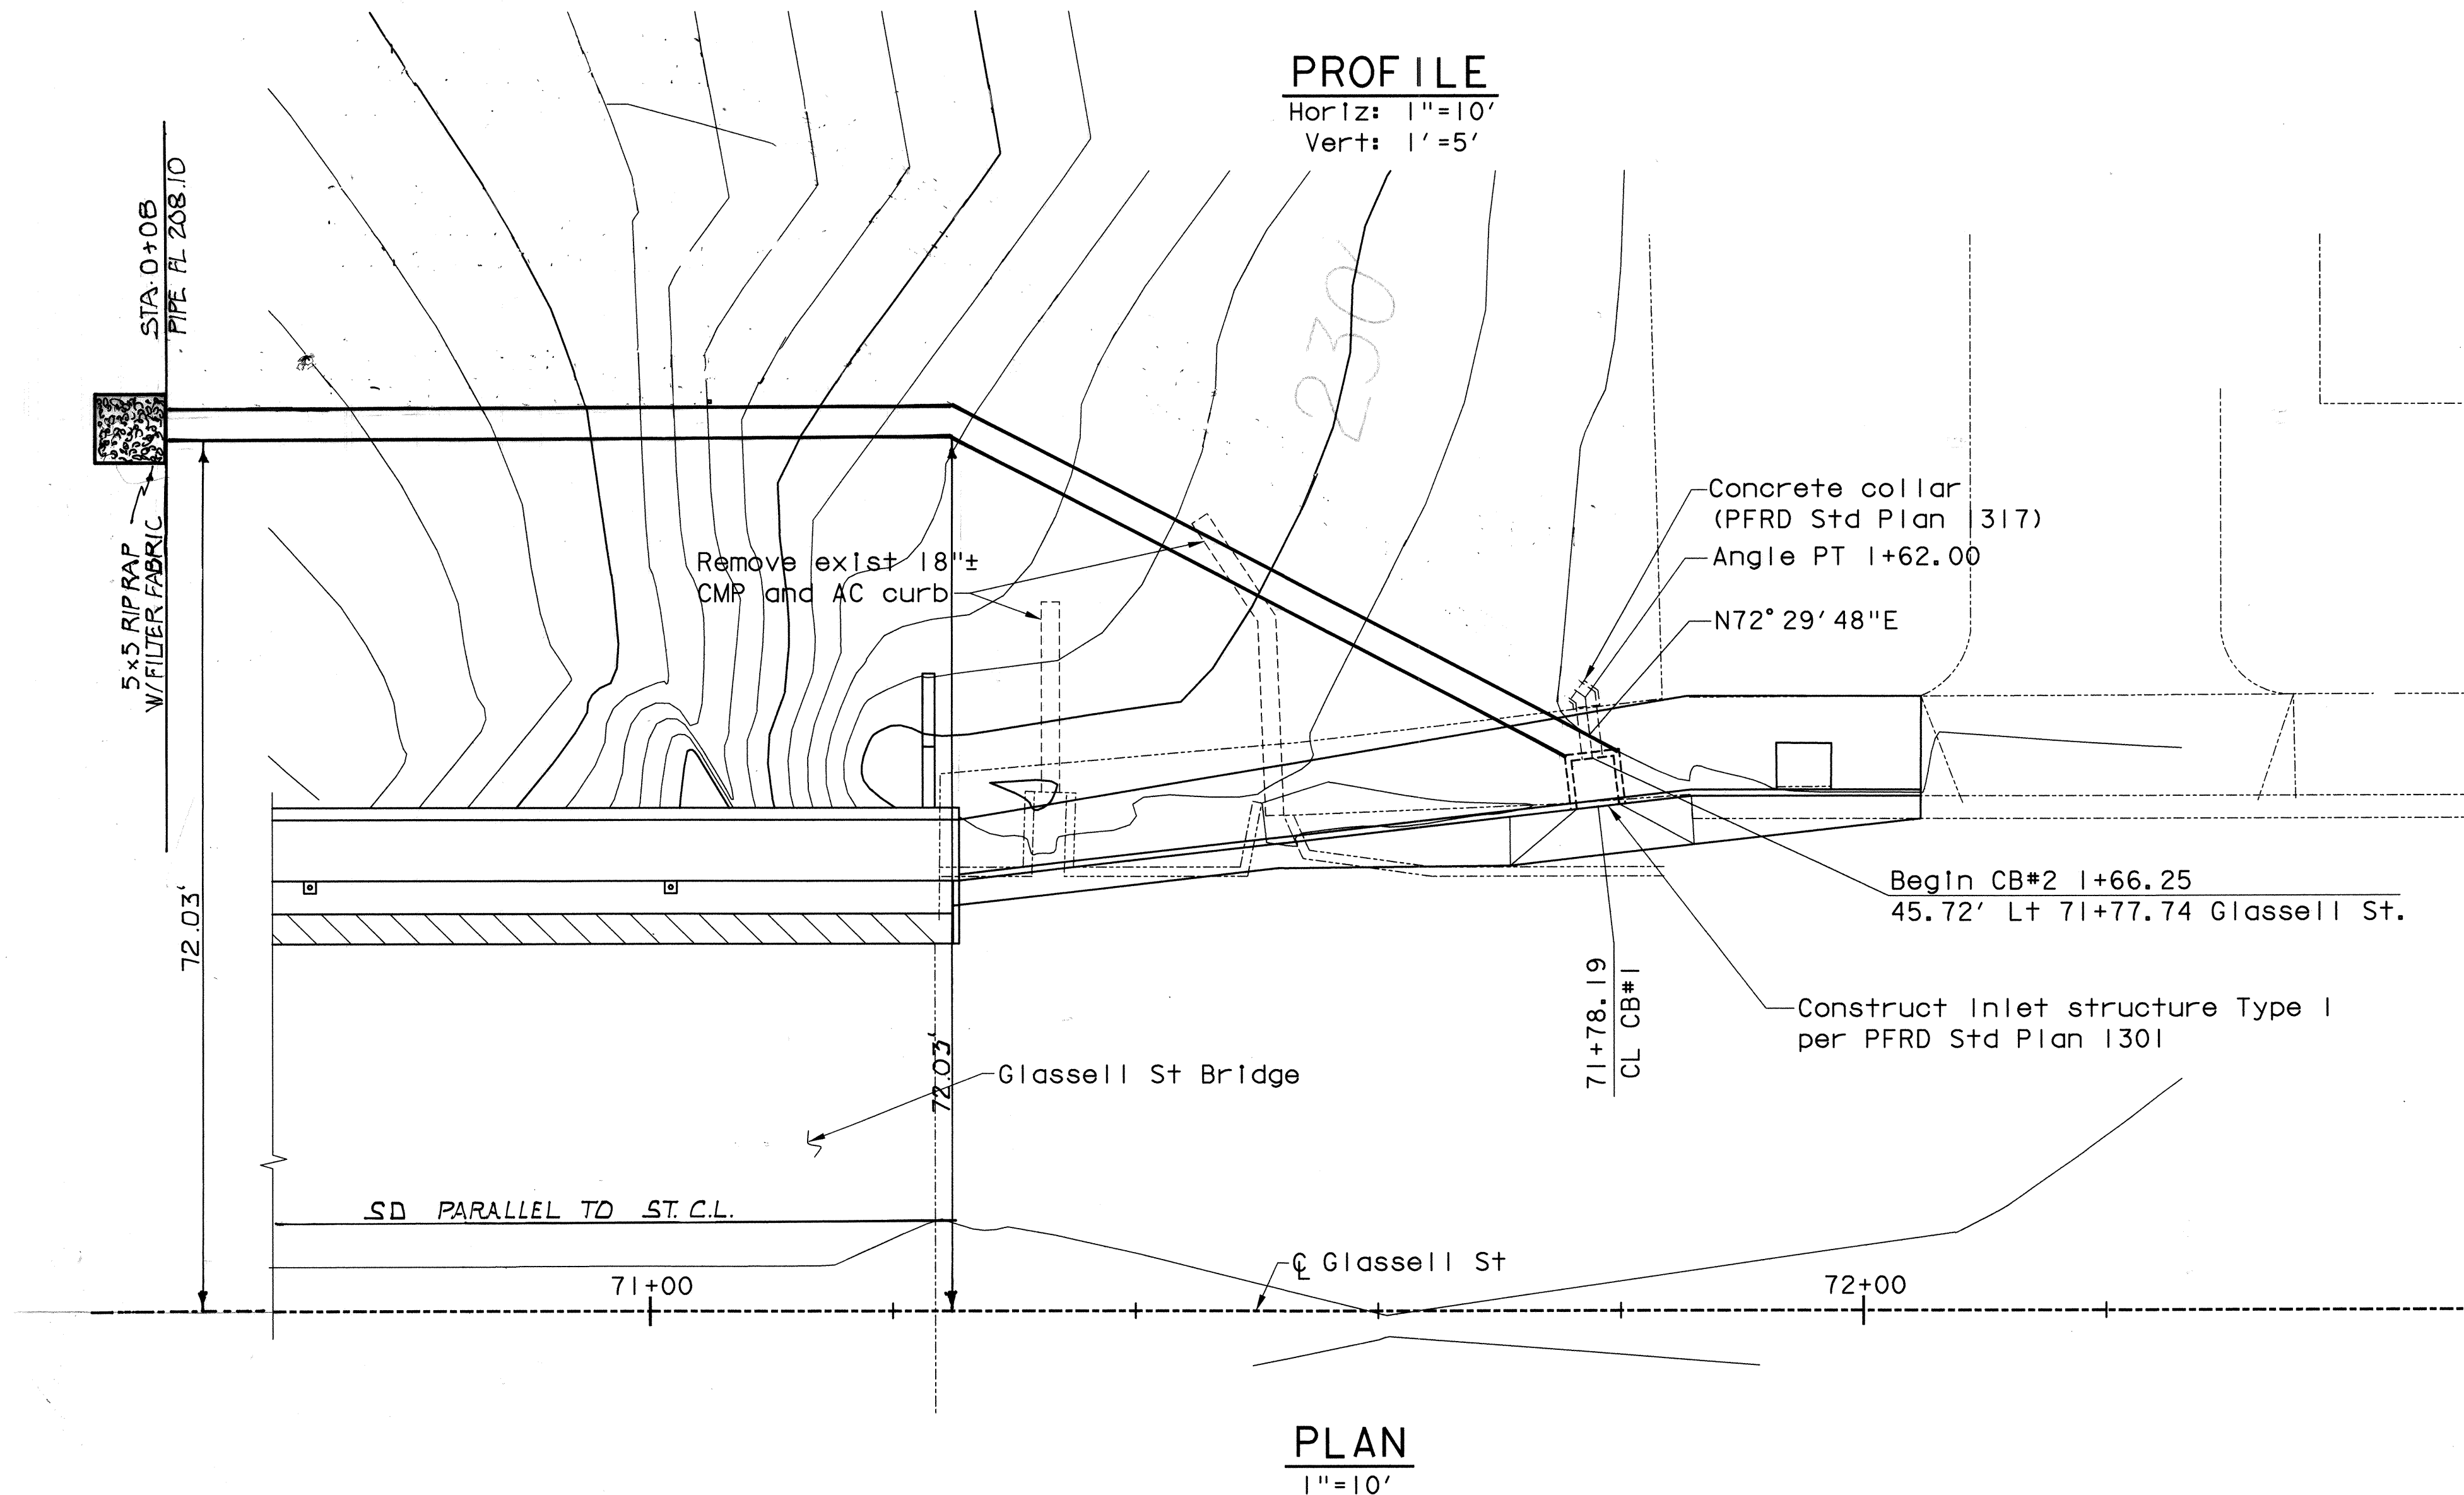

PLAN

1"=10'



W. Koo & Associates, Inc.
600 The City Parkway West, Suite 310
Orange, CA 92668
PH: (714) 456-0280
FAX: (714) 456-0295

ORANGE COUNTY
PUBLIC FACILITIES AND RESOURCES DEPARTMENT

GLASSELL STREET BRIDGE WIDENING
OVER SANTA ANA RIVER

GLASSELL APPROACH STORM DRAIN PLAN AND PROFILE NO.2

MARK	DATE	DESCRIPTION
REVISIONS		
PREPARED UNDER RESPONSIBLE CHARGE OF:		
DESIGNED	G. BUELOW	
DRAWN	G. BUELOW	CHECKED S. SHARIFAN
SCALE	AS SHOWN	DRAWING NO.
DATE	7/19/02	

SHEET

22

OF 70