



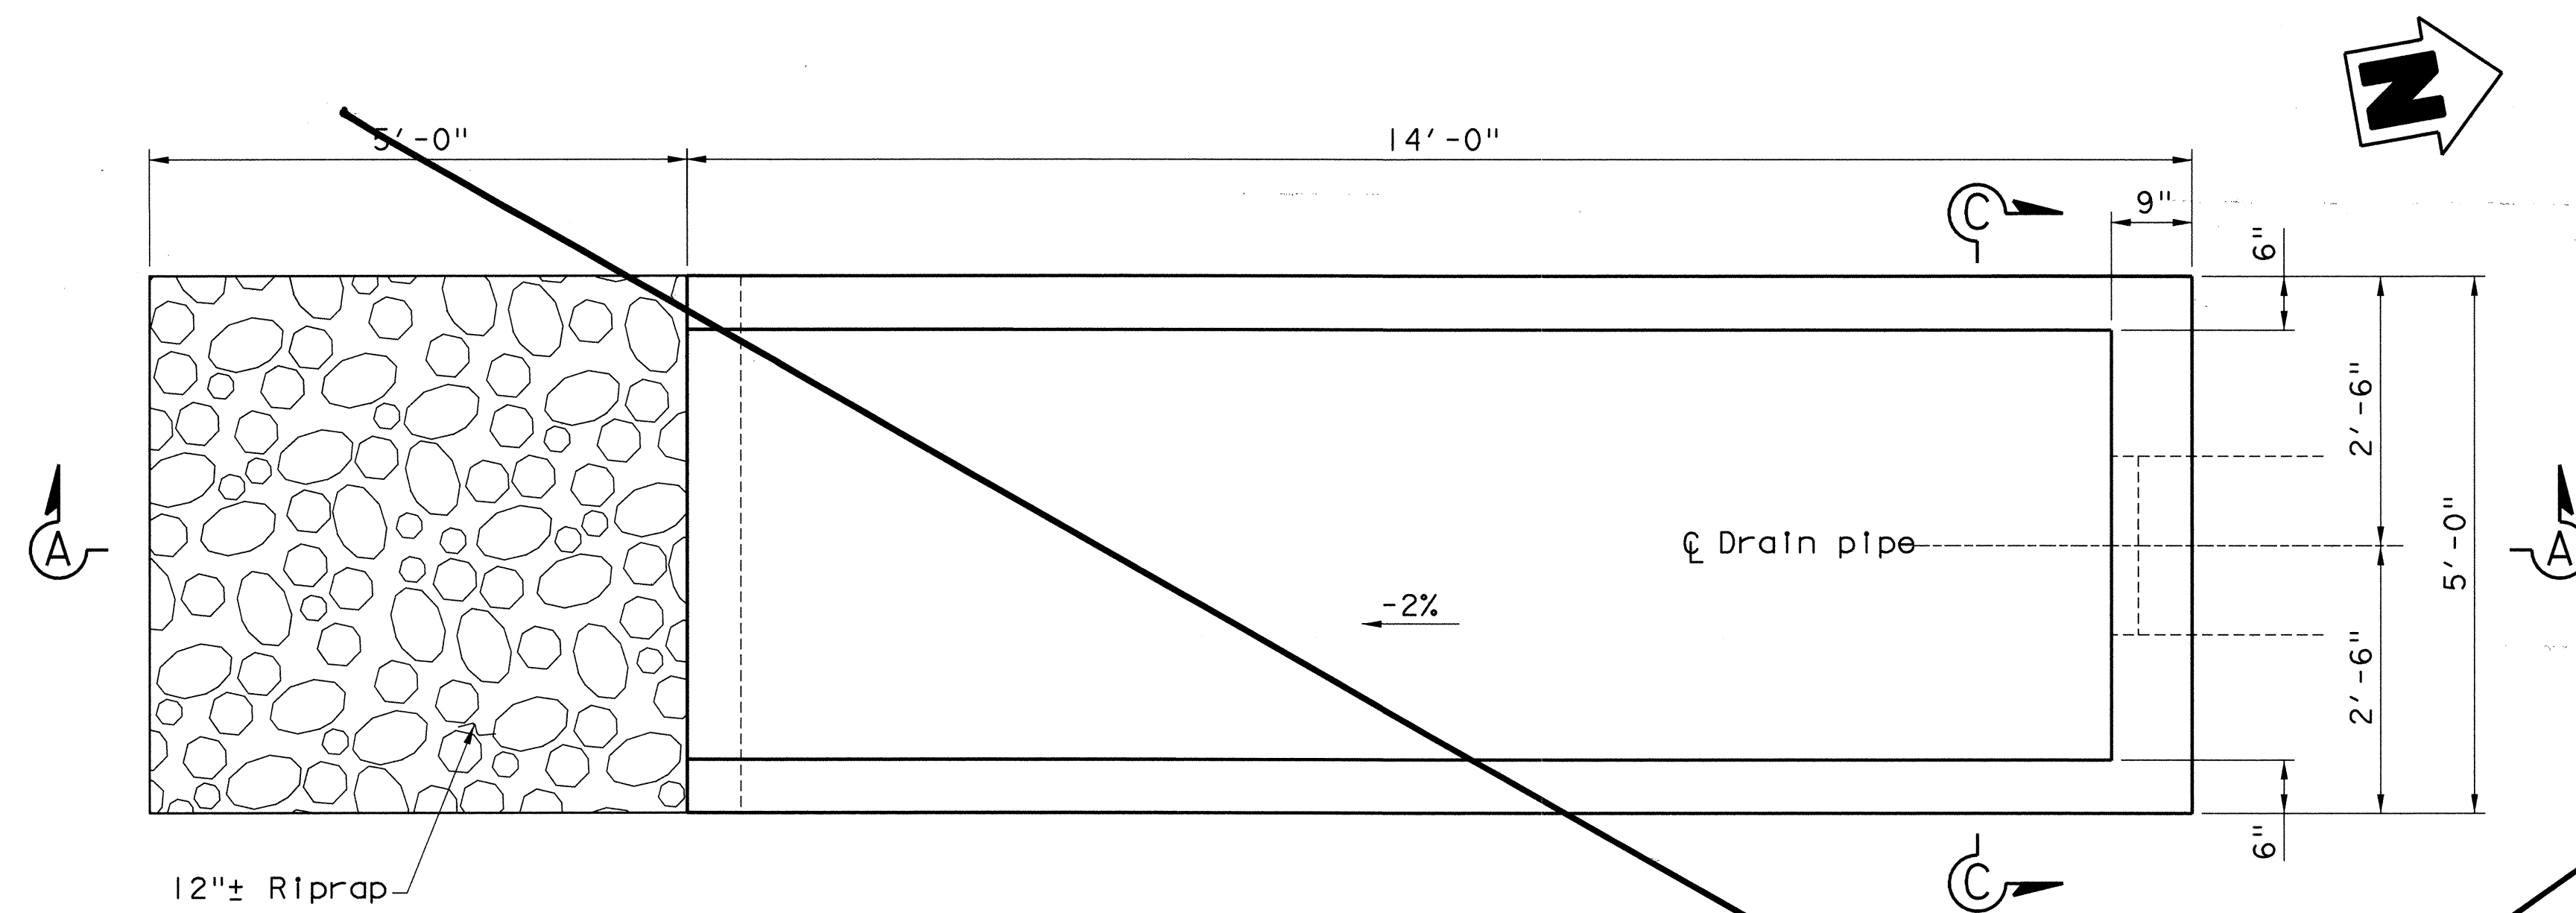

PLAN - OUTLET STRUCTURE (WEST SIDE)


$\frac{3}{4}'' = 1' - 0''$

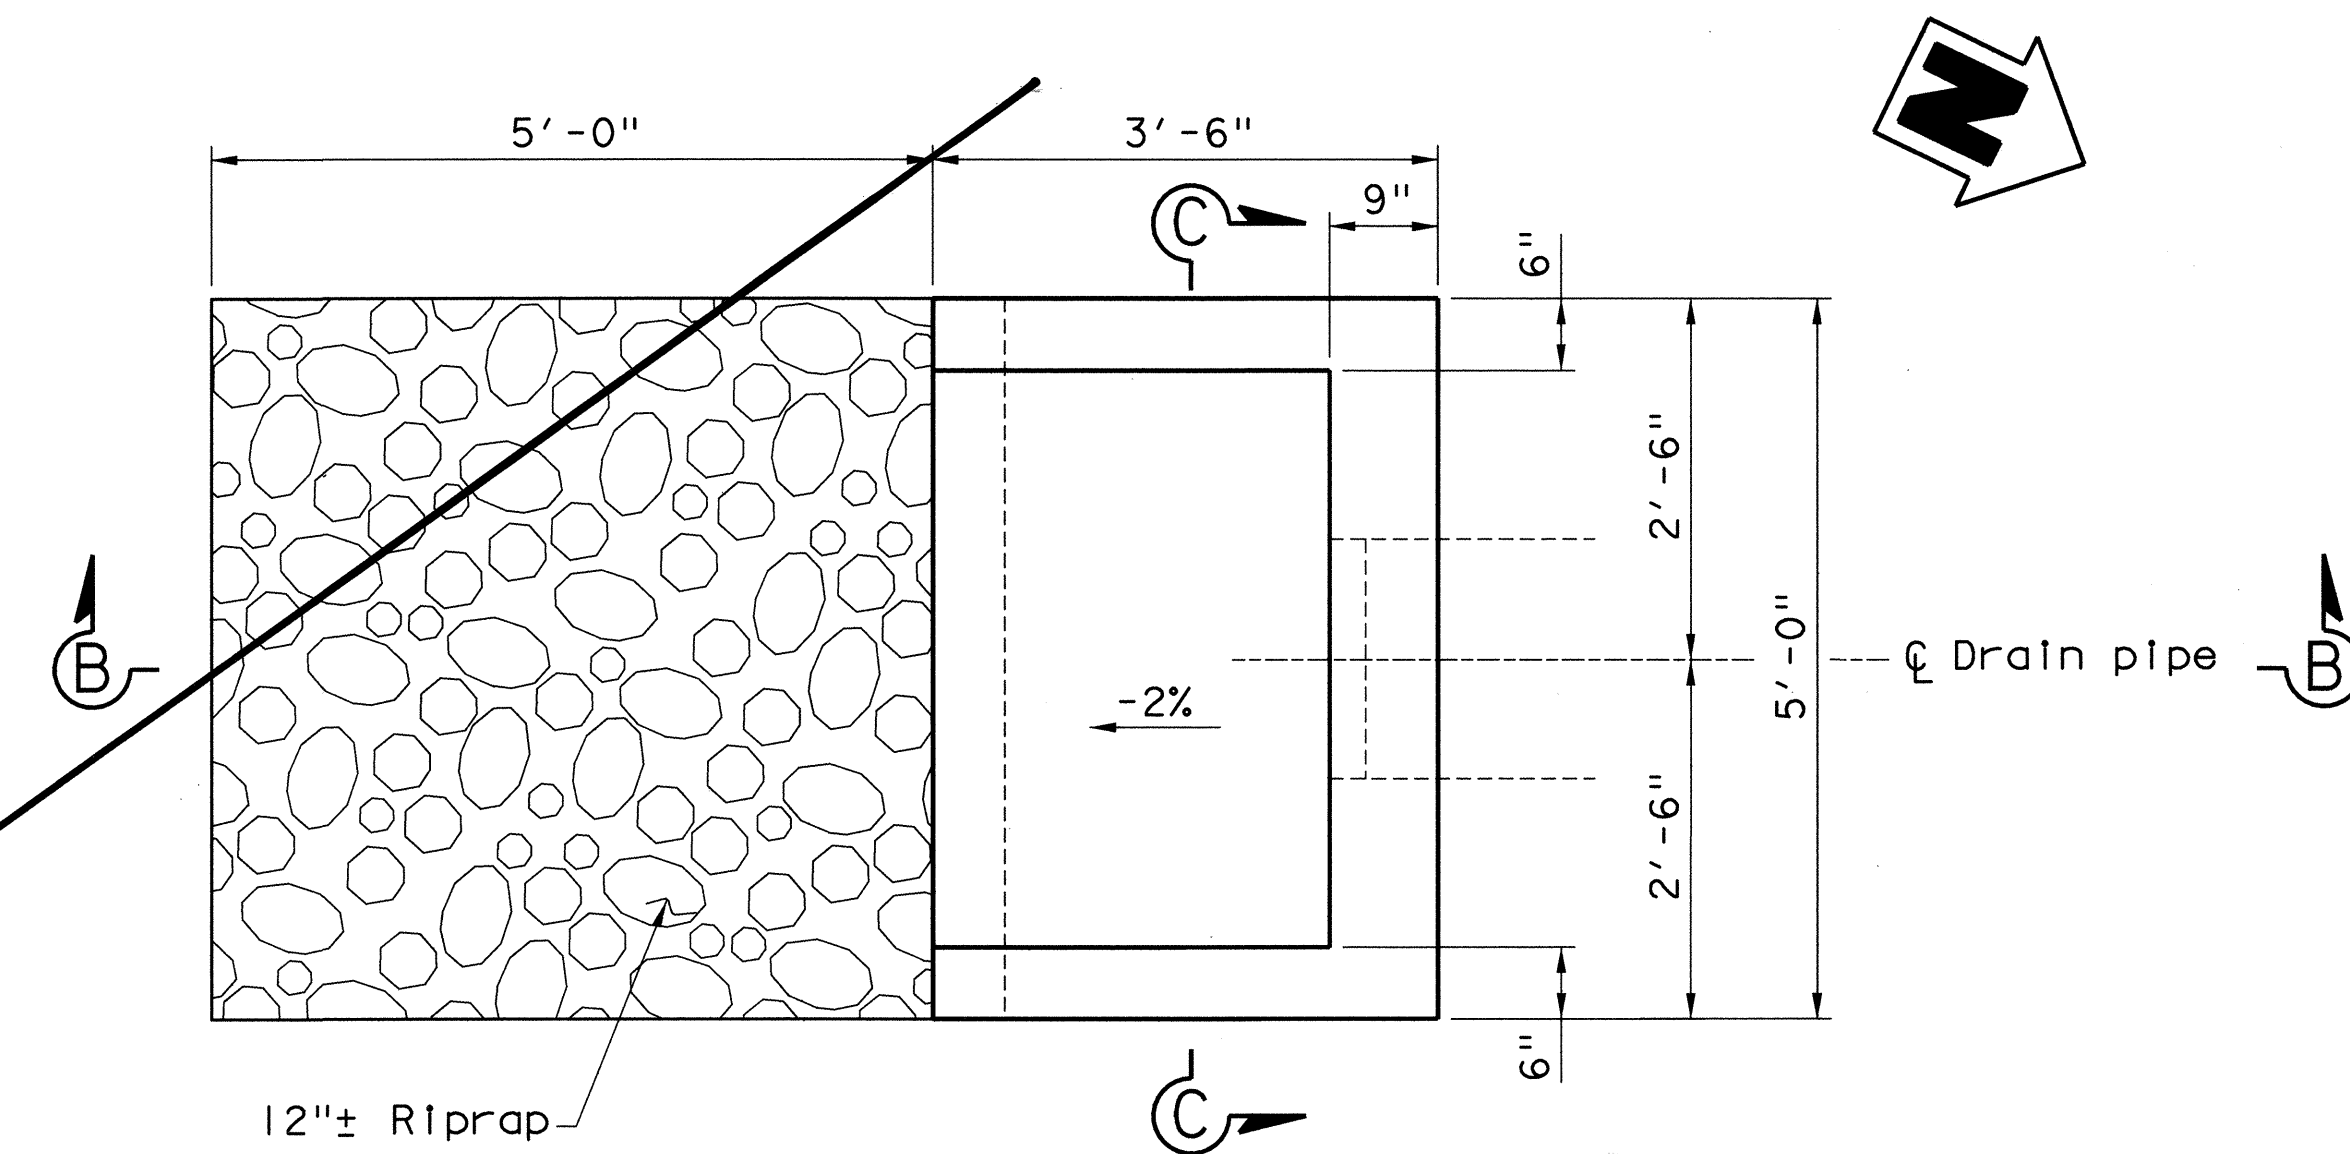

PLAN - OUTLET STRUCTURE (EAST SIDE)


$\frac{3}{4}'' = 1' - 0''$

NOT CONSTRUCTED
PIPES OUTLET AT
TD OF BASIN SLOPE

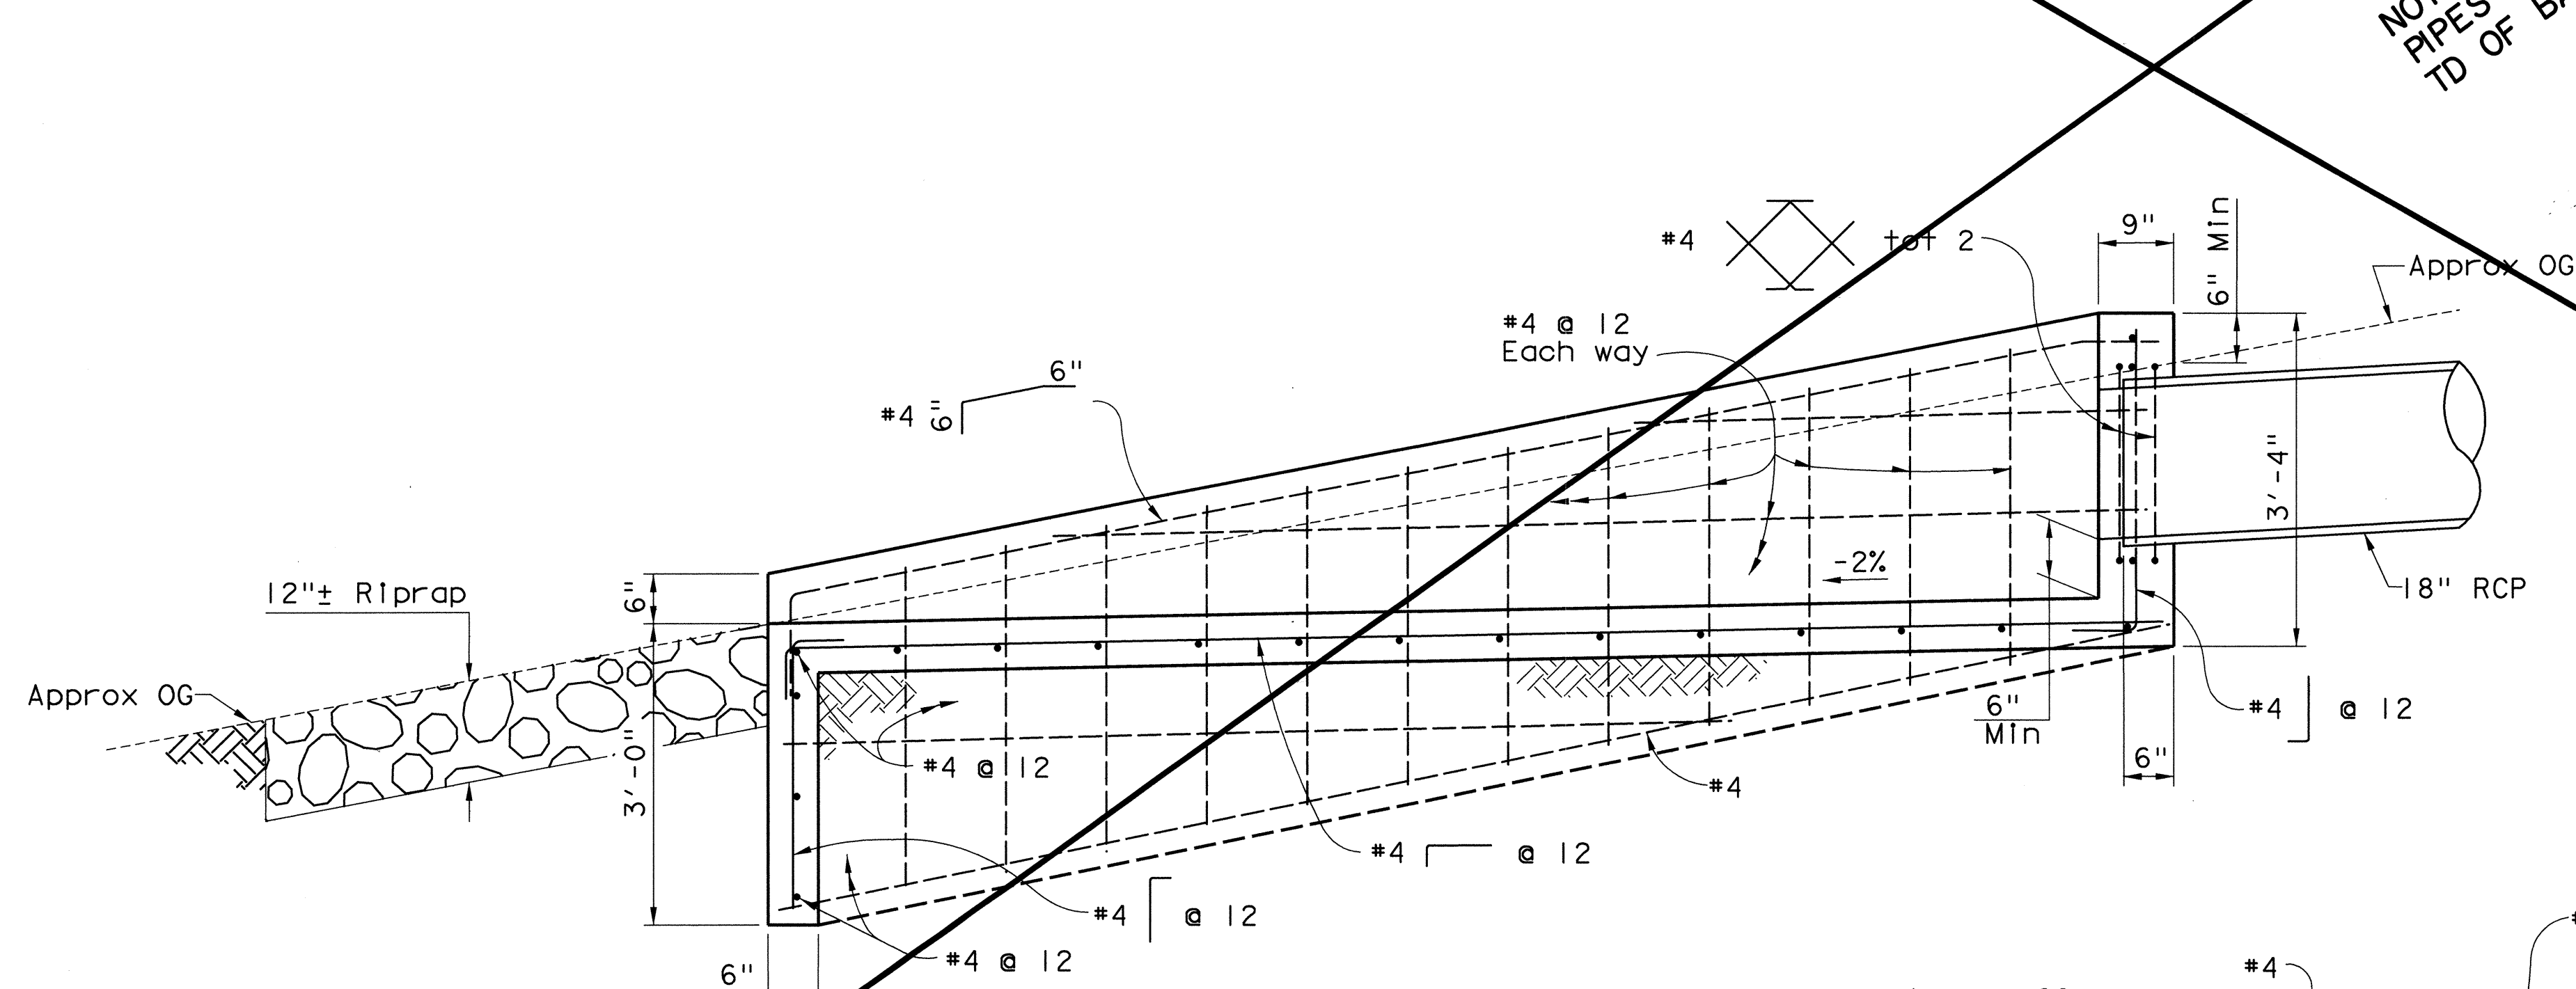


SECTION A-A

$\frac{3}{4}'' = 1' - 0''$

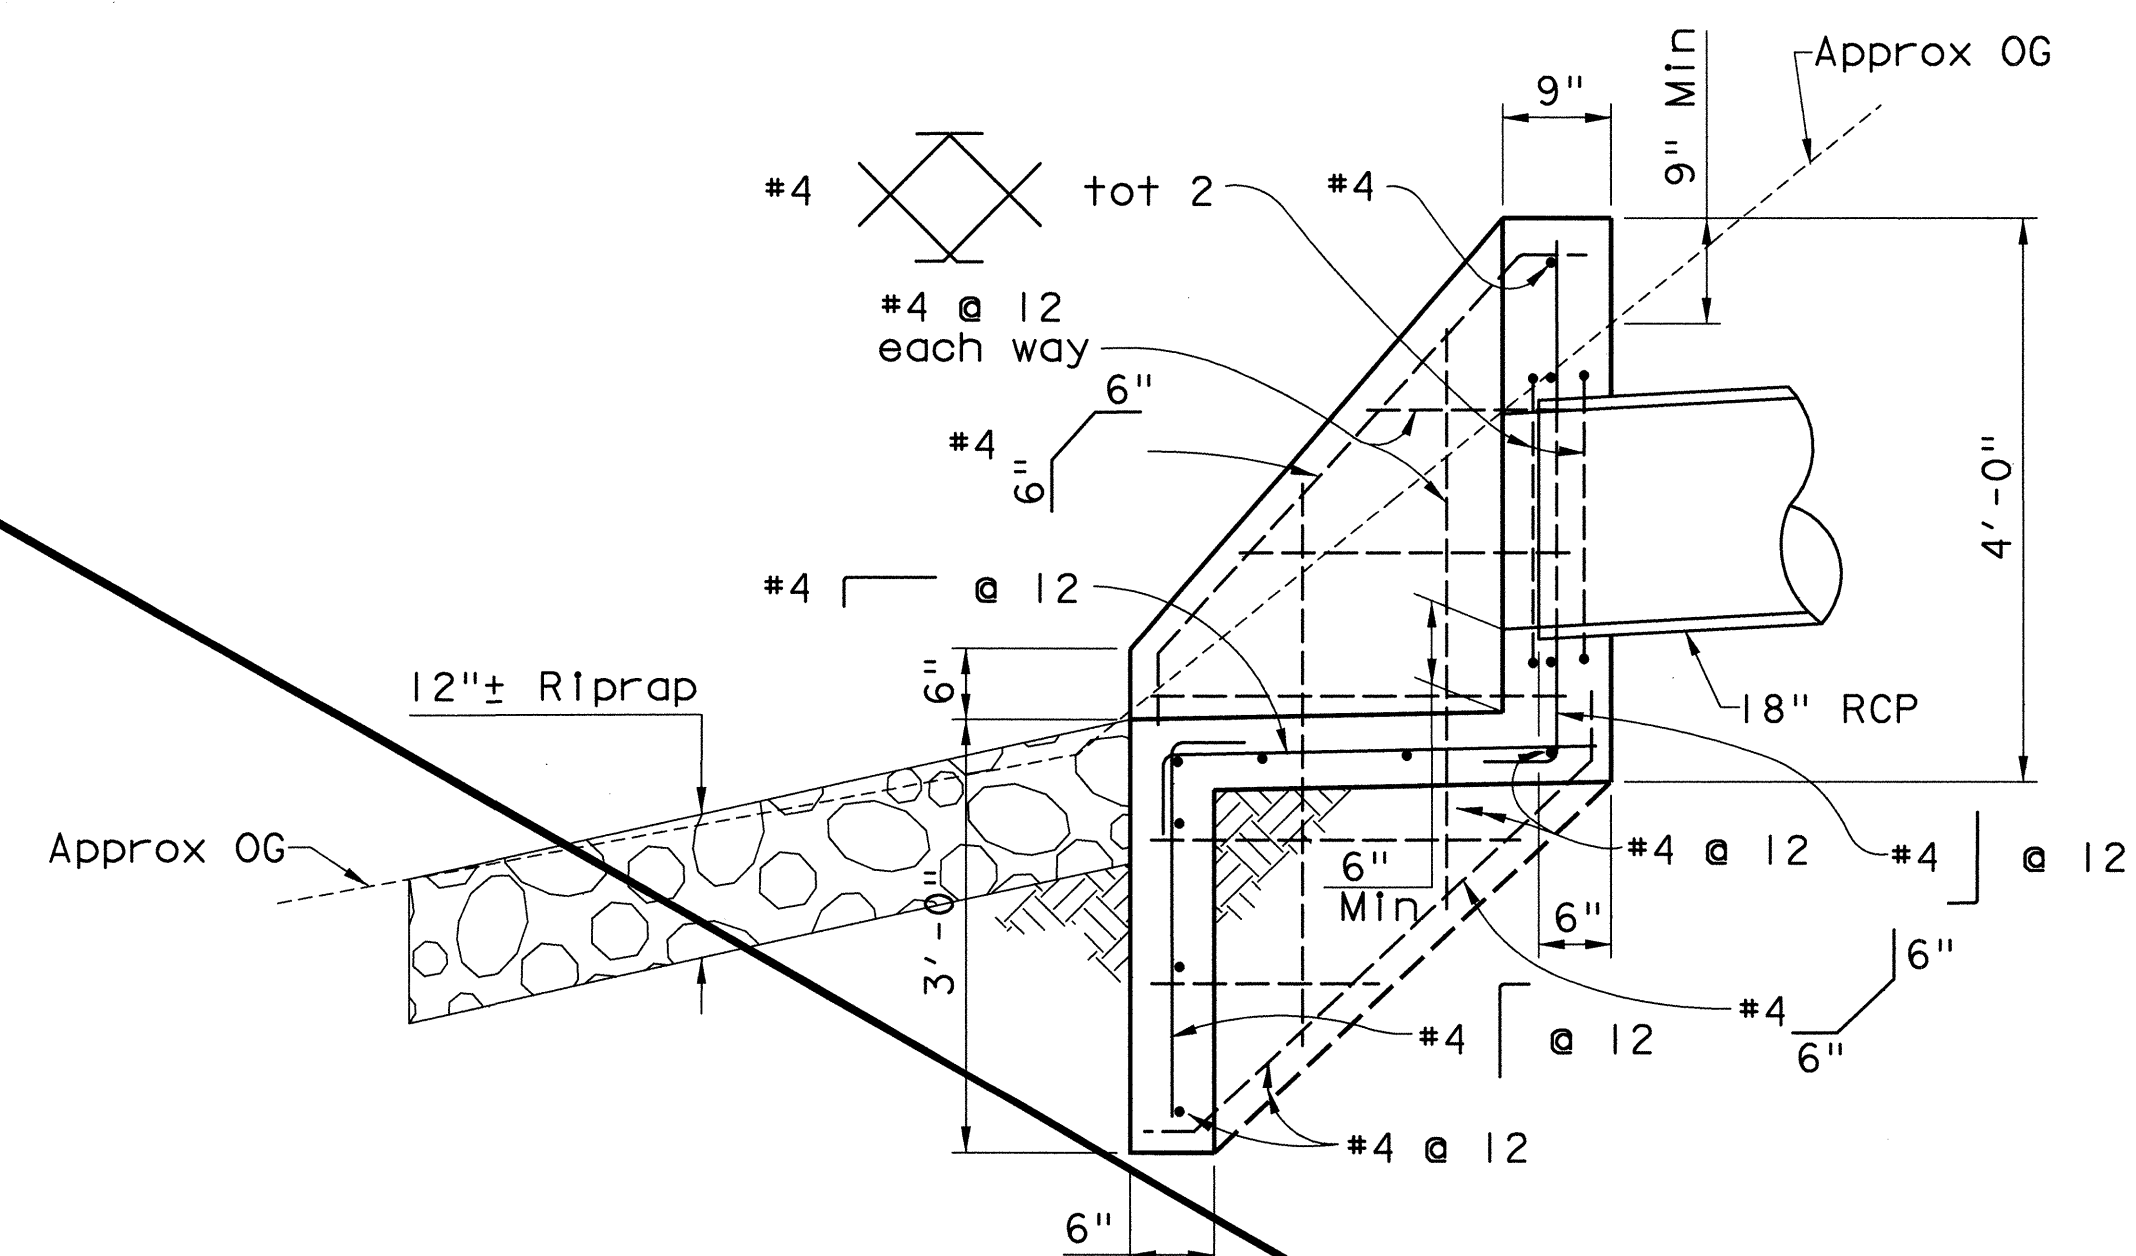

SECTION B-B

$\frac{3}{4}'' = 1' - 0''$

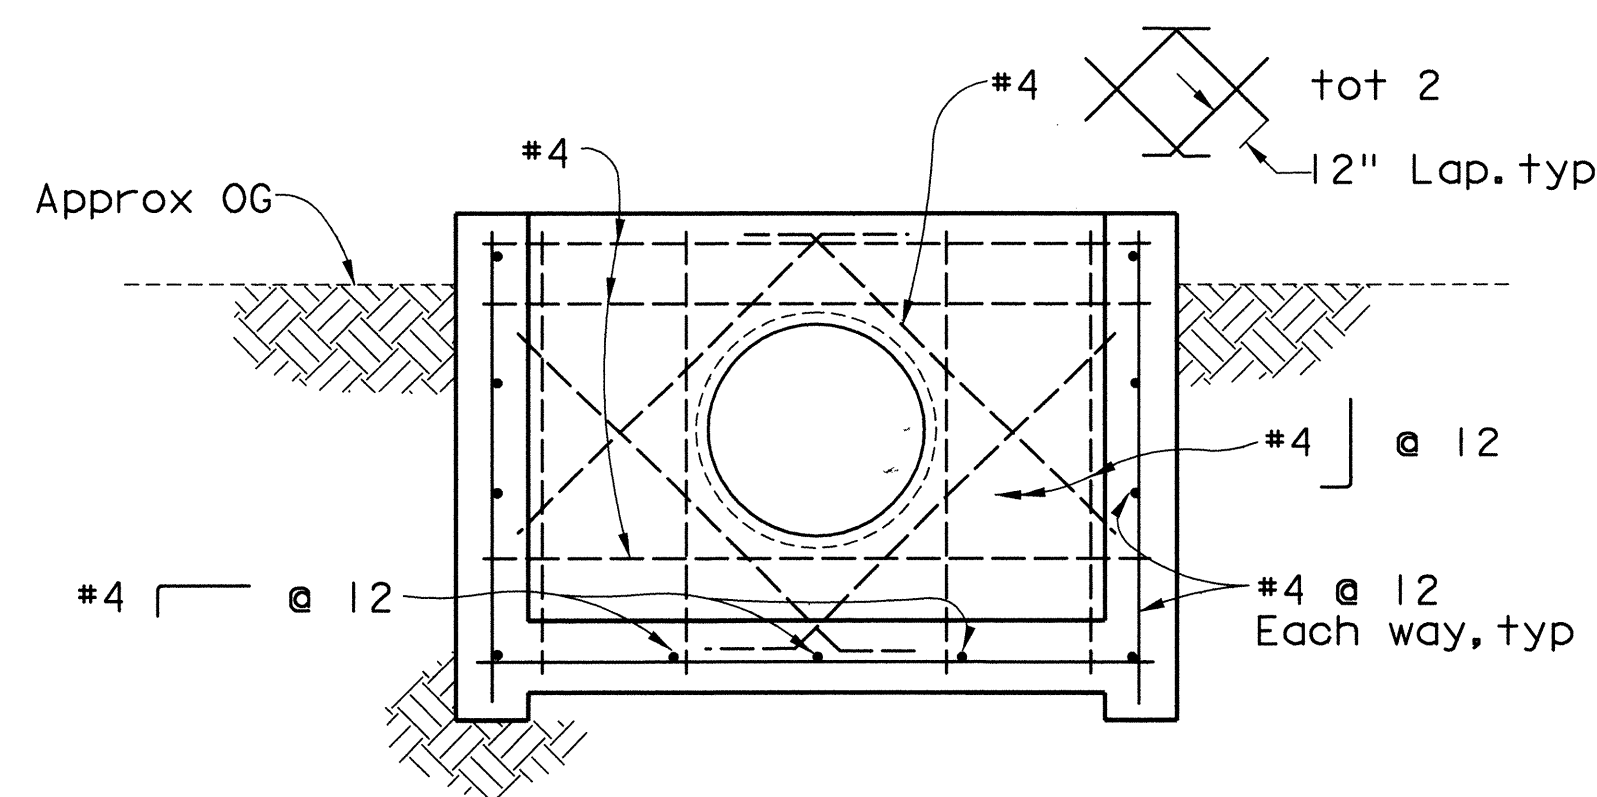

SECTION C-C

$\frac{3}{4}'' = 1' - 0''$

Note: Reinforcement centered in walls and slabs

Note: Contractor shall verify all controlling field dimensions before ordering or fabricating any material

W. Koo & Associates, Inc.
600 The City Parkway West, Suite 310
Orange, CA 92668
PH: (714) 456-0280
FAX: (714) 456-0295

ORANGE COUNTY
PUBLIC FACILITIES AND RESOURCES DEPARTMENT

GLASSELL STREET BRIDGE WIDENING
OVER SANTA ANA RIVER

**GLASSELL APPROACH
DRAINAGE DETAILS**

MARK	DATE	DESCRIPTION
REVISIONS		
PREPARED UNDER RESPONSIBLE CHARGE OF:		
DESIGNED	X. WJ	
DRAWN	G. BUELOW	CHECKED S. SHARIFAN
SCALE	AS SHOWN	DRAWING NO.
DATE	7/19/02	

SHEET
24
OF 70