



STAGE IB - RIVER CONSTRUCTION (SUBSTRUCTURE)

1/8" = 1'-0"

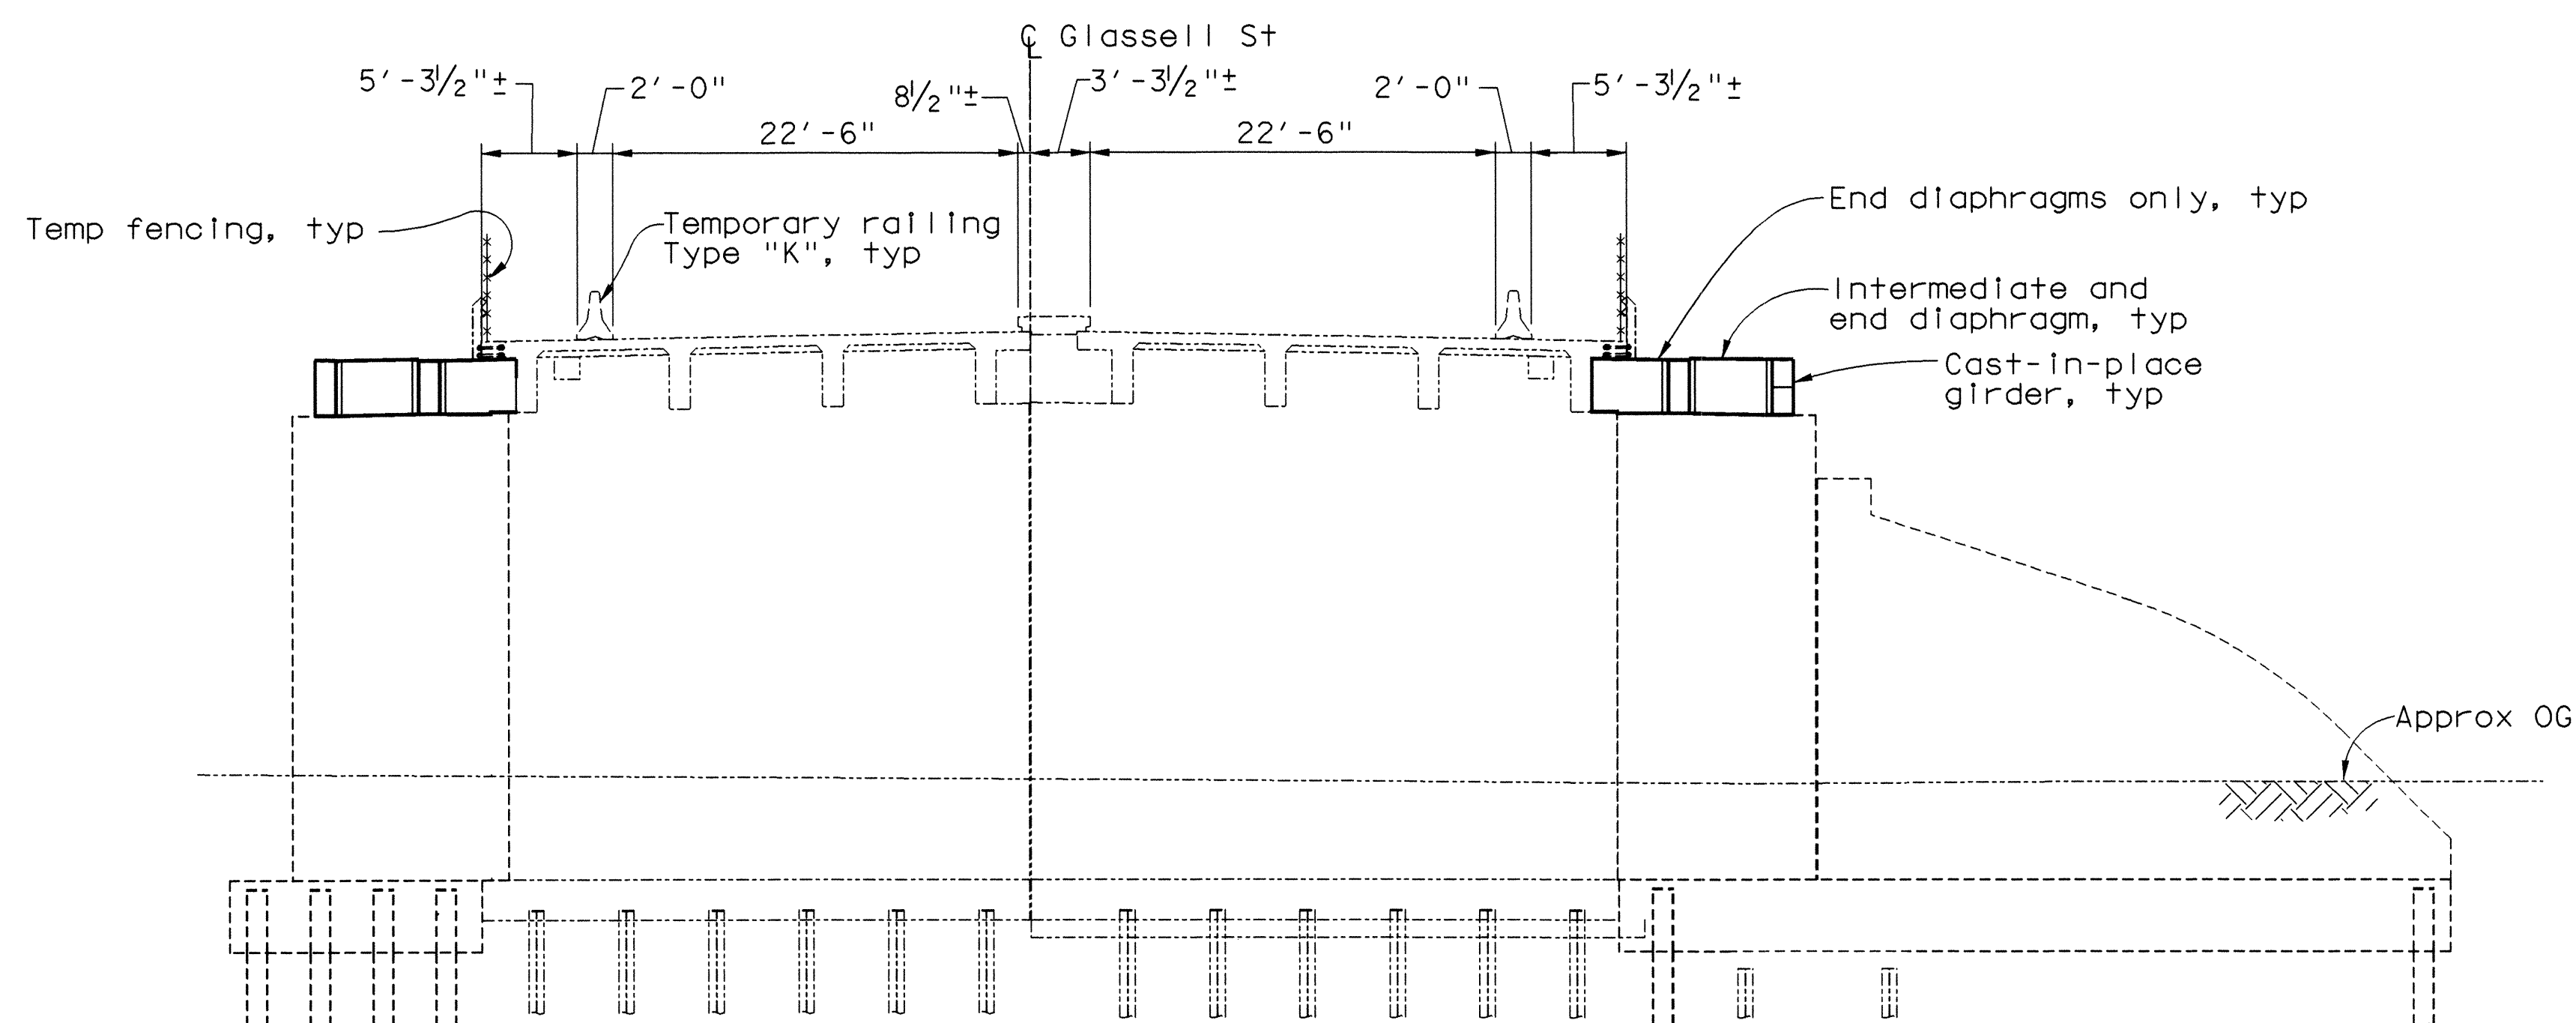


STAGE IC - RIVER CONSTRUCTION (SUPERSTRUCTURE)

1/8" = 1'-0"

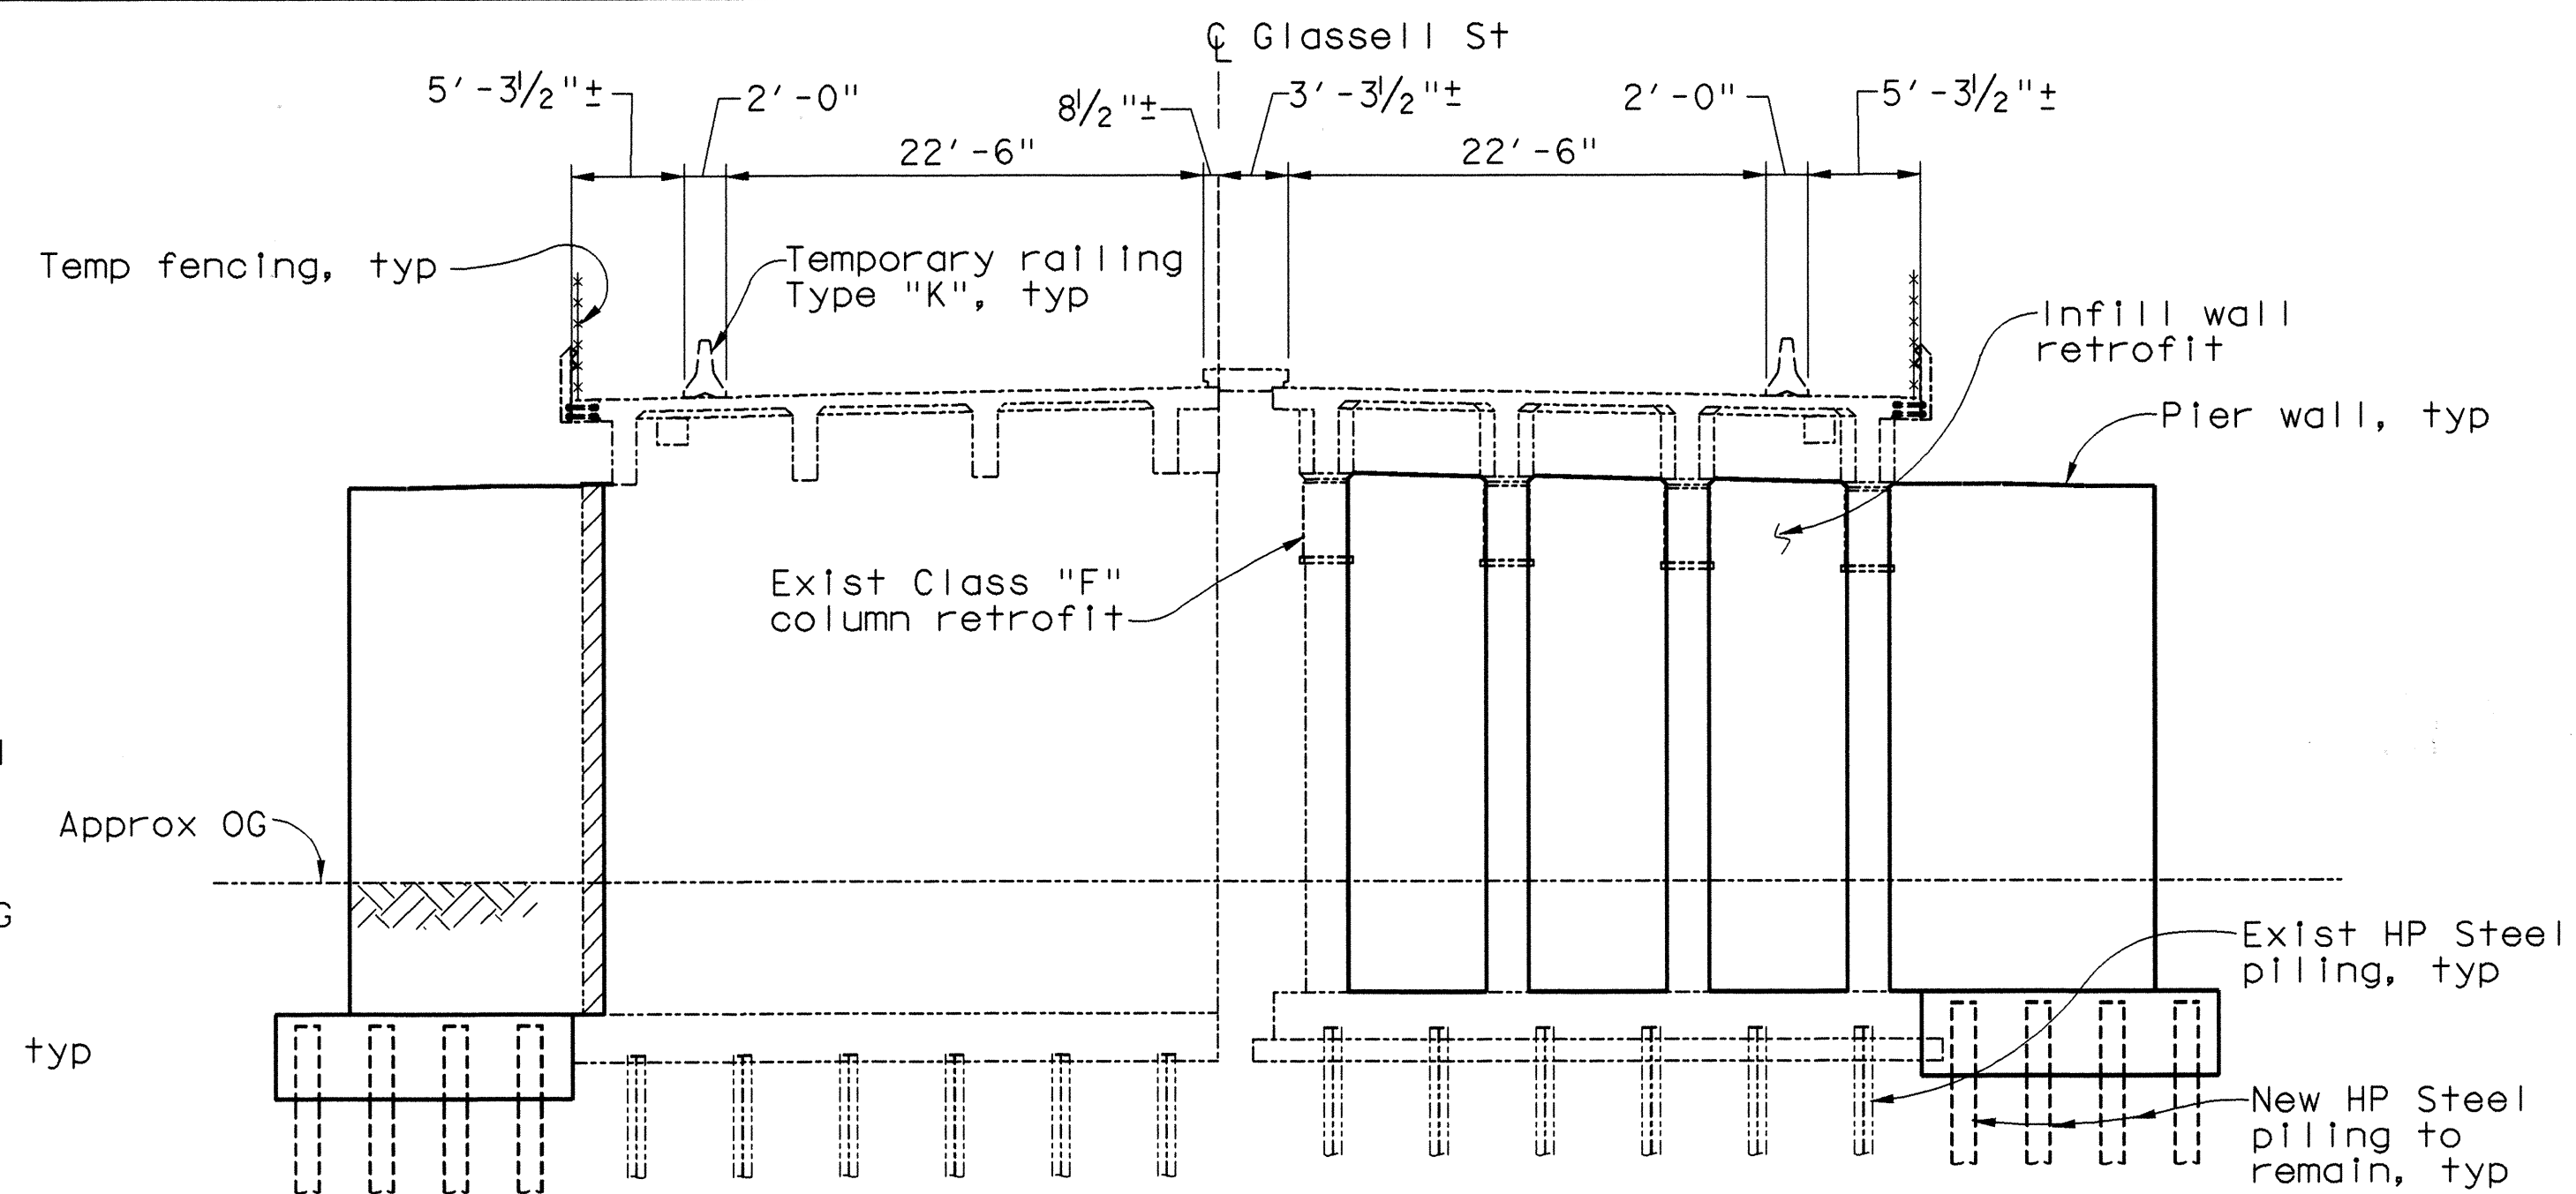

STAGE IB - GLASSELL BASIN CONSTRUCTION (SUBSTRUCTURE)

1/8" = 1'-0"

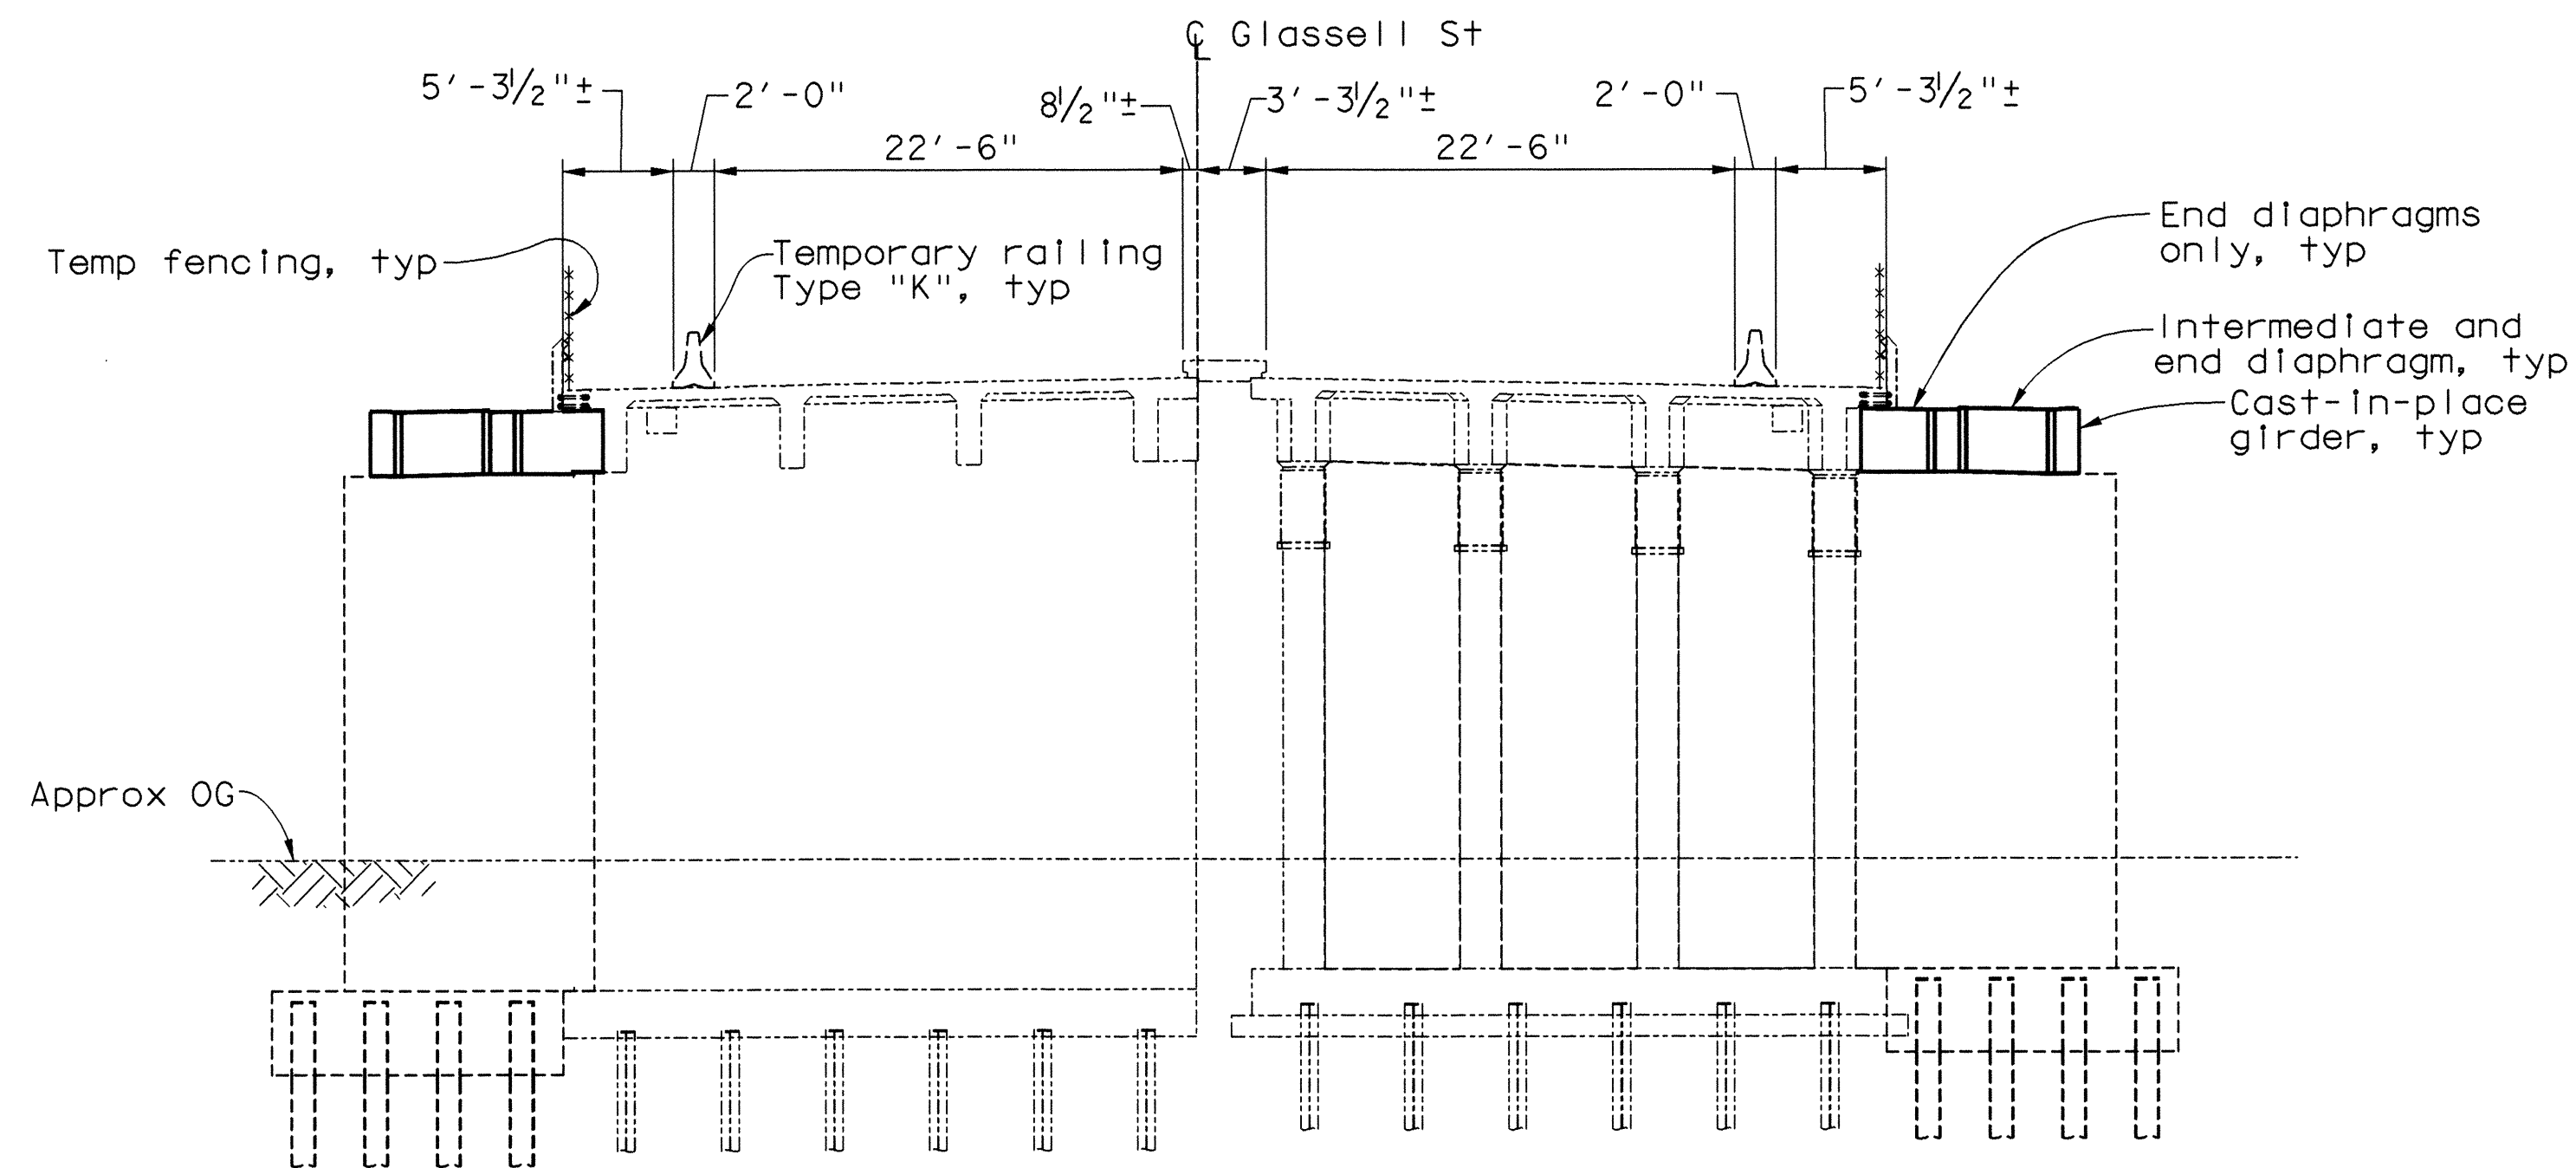

STAGE IC - GLASSELL BASIN CONSTRUCTION (SUPERSTRUCTURE)

1/8" = 1'-0"

LEGEND

- Denotes Bridge Removal (Portion)
- Denotes Existing Structure
- Denotes New Structure
- Denotes New Structure Constructed in previous stage

Note:
Contractor shall verify all controlling field dimensions before ordering or fabricating any material

W. Koo & Associates, Inc.
600 The City Parkway West, Suite 310
Orange, CA 92668
PH: (714) 456-0280
FAX: (714) 456-0295

ORANGE COUNTY RESOURCES AND DEVELOPMENT MANAGEMENT DEPARTMENT		GLASSELL STREET BRIDGE WIDENING OVER SANTA ANA RIVER	
STAGE CONSTRUCTION DETAILS NO. 2			
DESIGNED: X. WU	CHECKED: S. SHARIFAN	SHEET 38R	
DRAWN: G. BUELOW	DATE: 7/19/02	DRAWING NO.	
SCALE: AS SHOWN	DATE: 7/19/02	DATE: 7/19/02	

Date Plotted: 07/25/2005

File Name: t:\cad\010-14\glassell\gl_sc2.dgn

Border sheet last modified 09-Nov-1999