


SUPERSEDED AND REPLACED BY SHEET 39R.

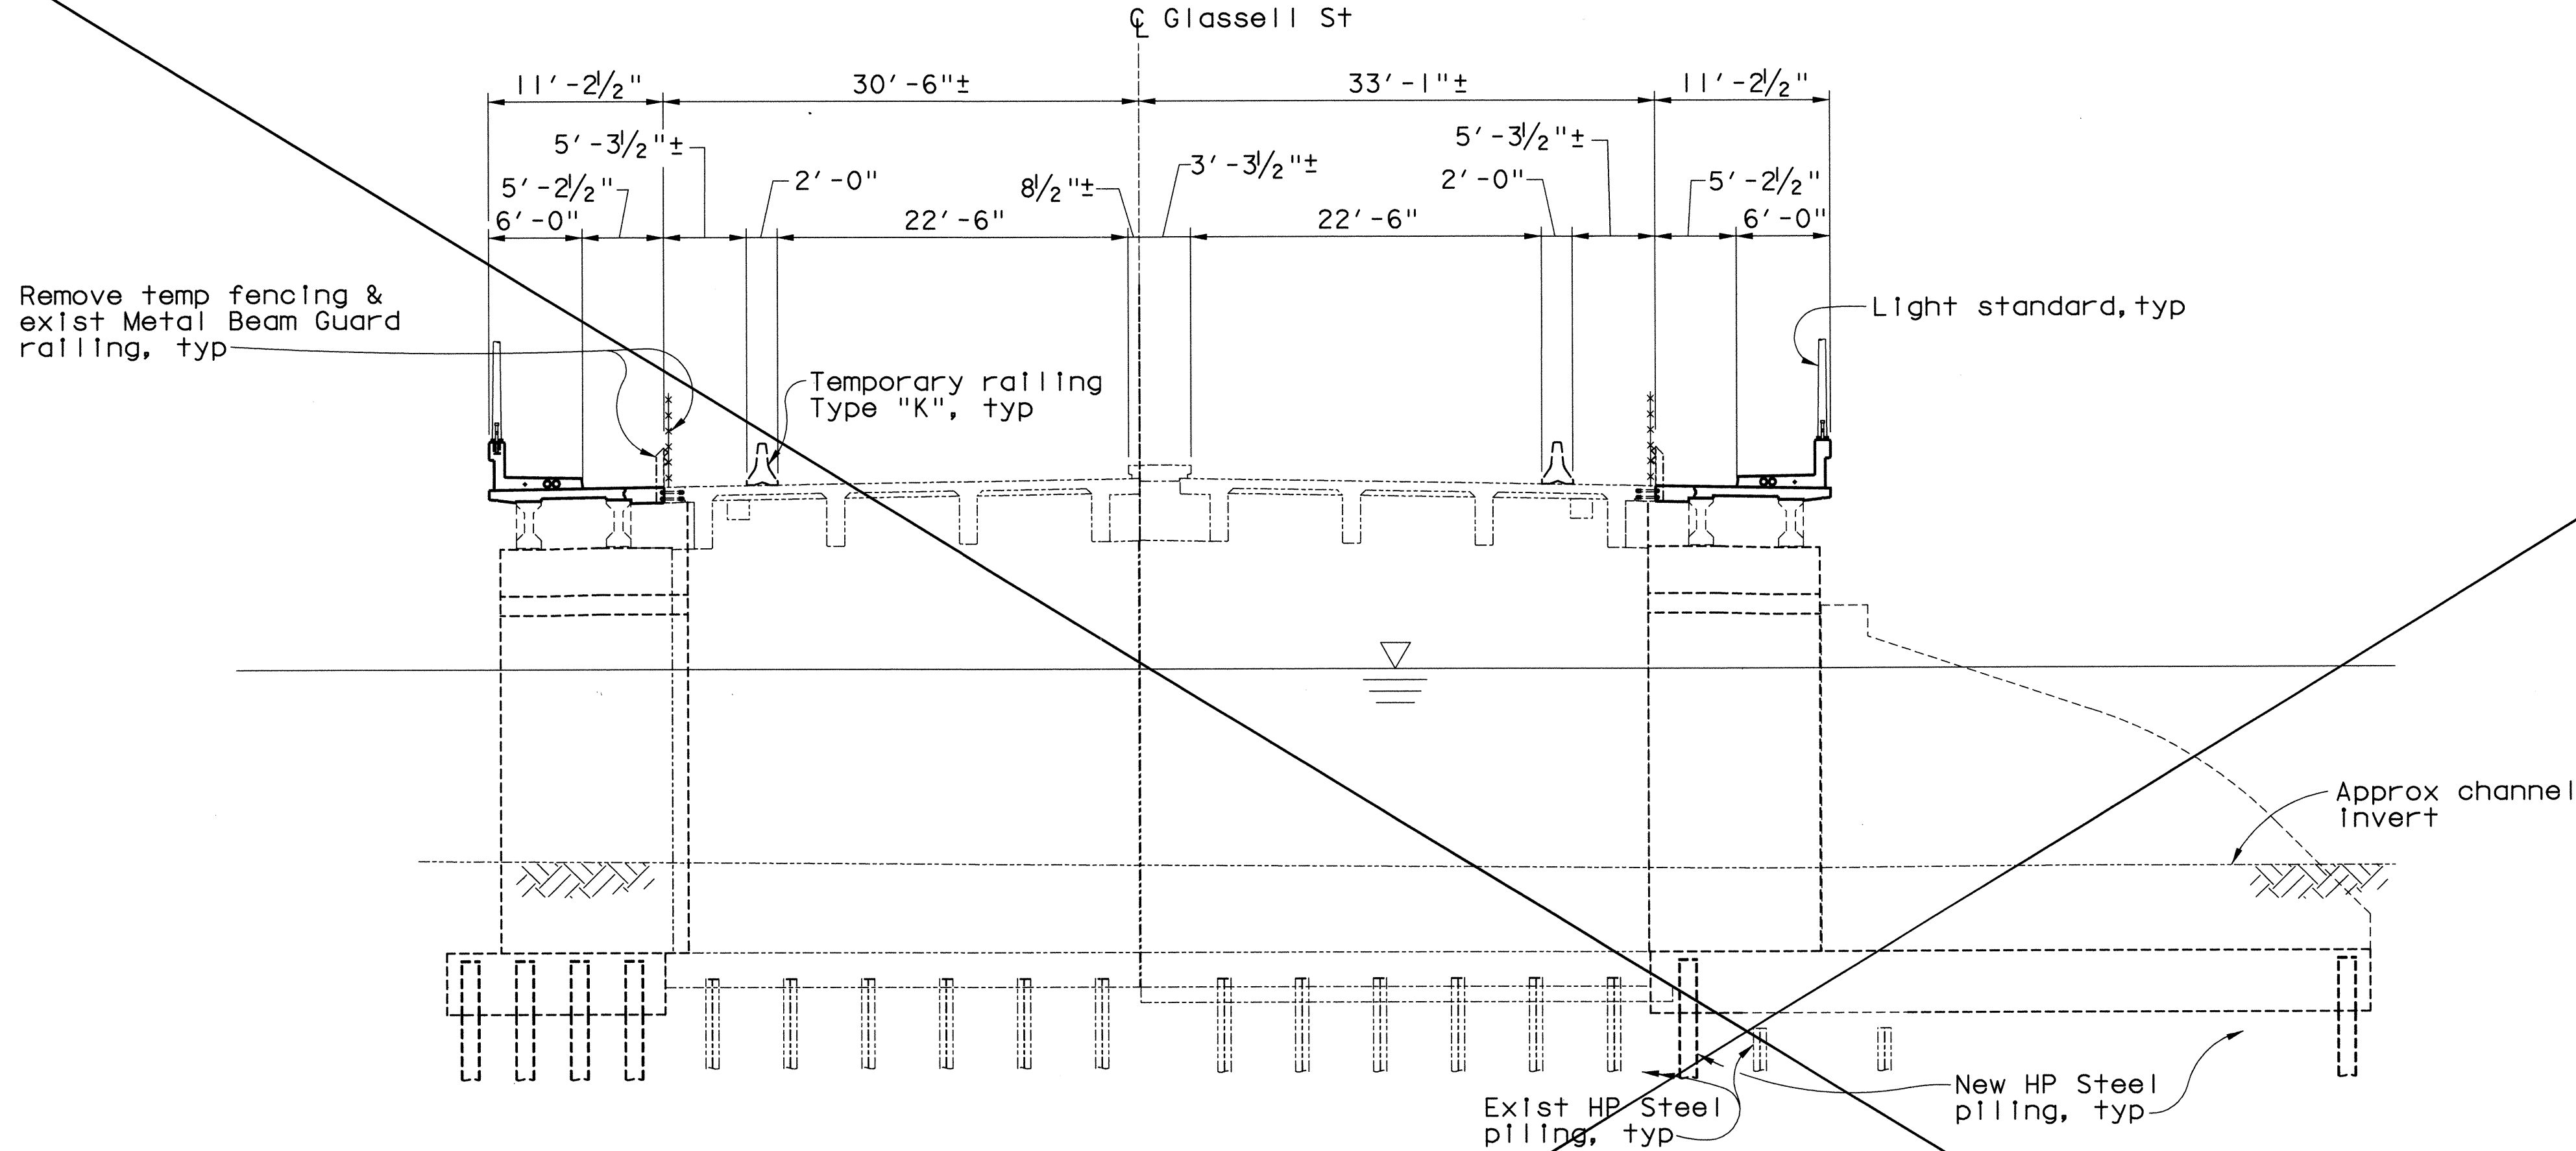

STAGE 3A - DECK CONCRETE PLACEMENT
1/8" = 1'-0"

- Notes:
1. Piers 3 thru 8 shown, Piers 2, 9 thru 18 similar, except for debris nose.
 2. Remove temporary barrier Type "K" & temp fencing after bridge deck and street improvements are completed.

- LEGEND**
- Denotes Existing Structure
 - Denotes New Structure
 - Denotes New Structure Constructed in previous stage

Note:
Contractor shall verify all controlling field dimensions before ordering or fabricating any material

W. Koo & Associates, Inc.
600 The City Parkway West, Suite 310
Orange, CA, 92668
PH: (714) 456-0280
FAX: (714) 456-0295

ORANGE COUNTY PUBLIC FACILITIES AND RESOURCES DEPARTMENT	
GLASSELL STREET BRIDGE WIDENING OVER SANTA ANA RIVER	
STAGE CONSTRUCTION DETAILS NO. 3	
MARK	DATE
REVISIONS	
PREPARED UNDER RESPONSIBLE CHARGE OF:	
DESIGNED: X. WU	
DRAWN: G. BUELOW	
CHECKED: S. SHARIFAN	
SCALE	DATE
AS SHOWN	7/19/02
DRAWING NO.	
SHEET	
39	
OF 70	

Date Plotted: \$DATES\$

File Name: \$FILES\$

Border sheet last modified 03-Nov-1999