


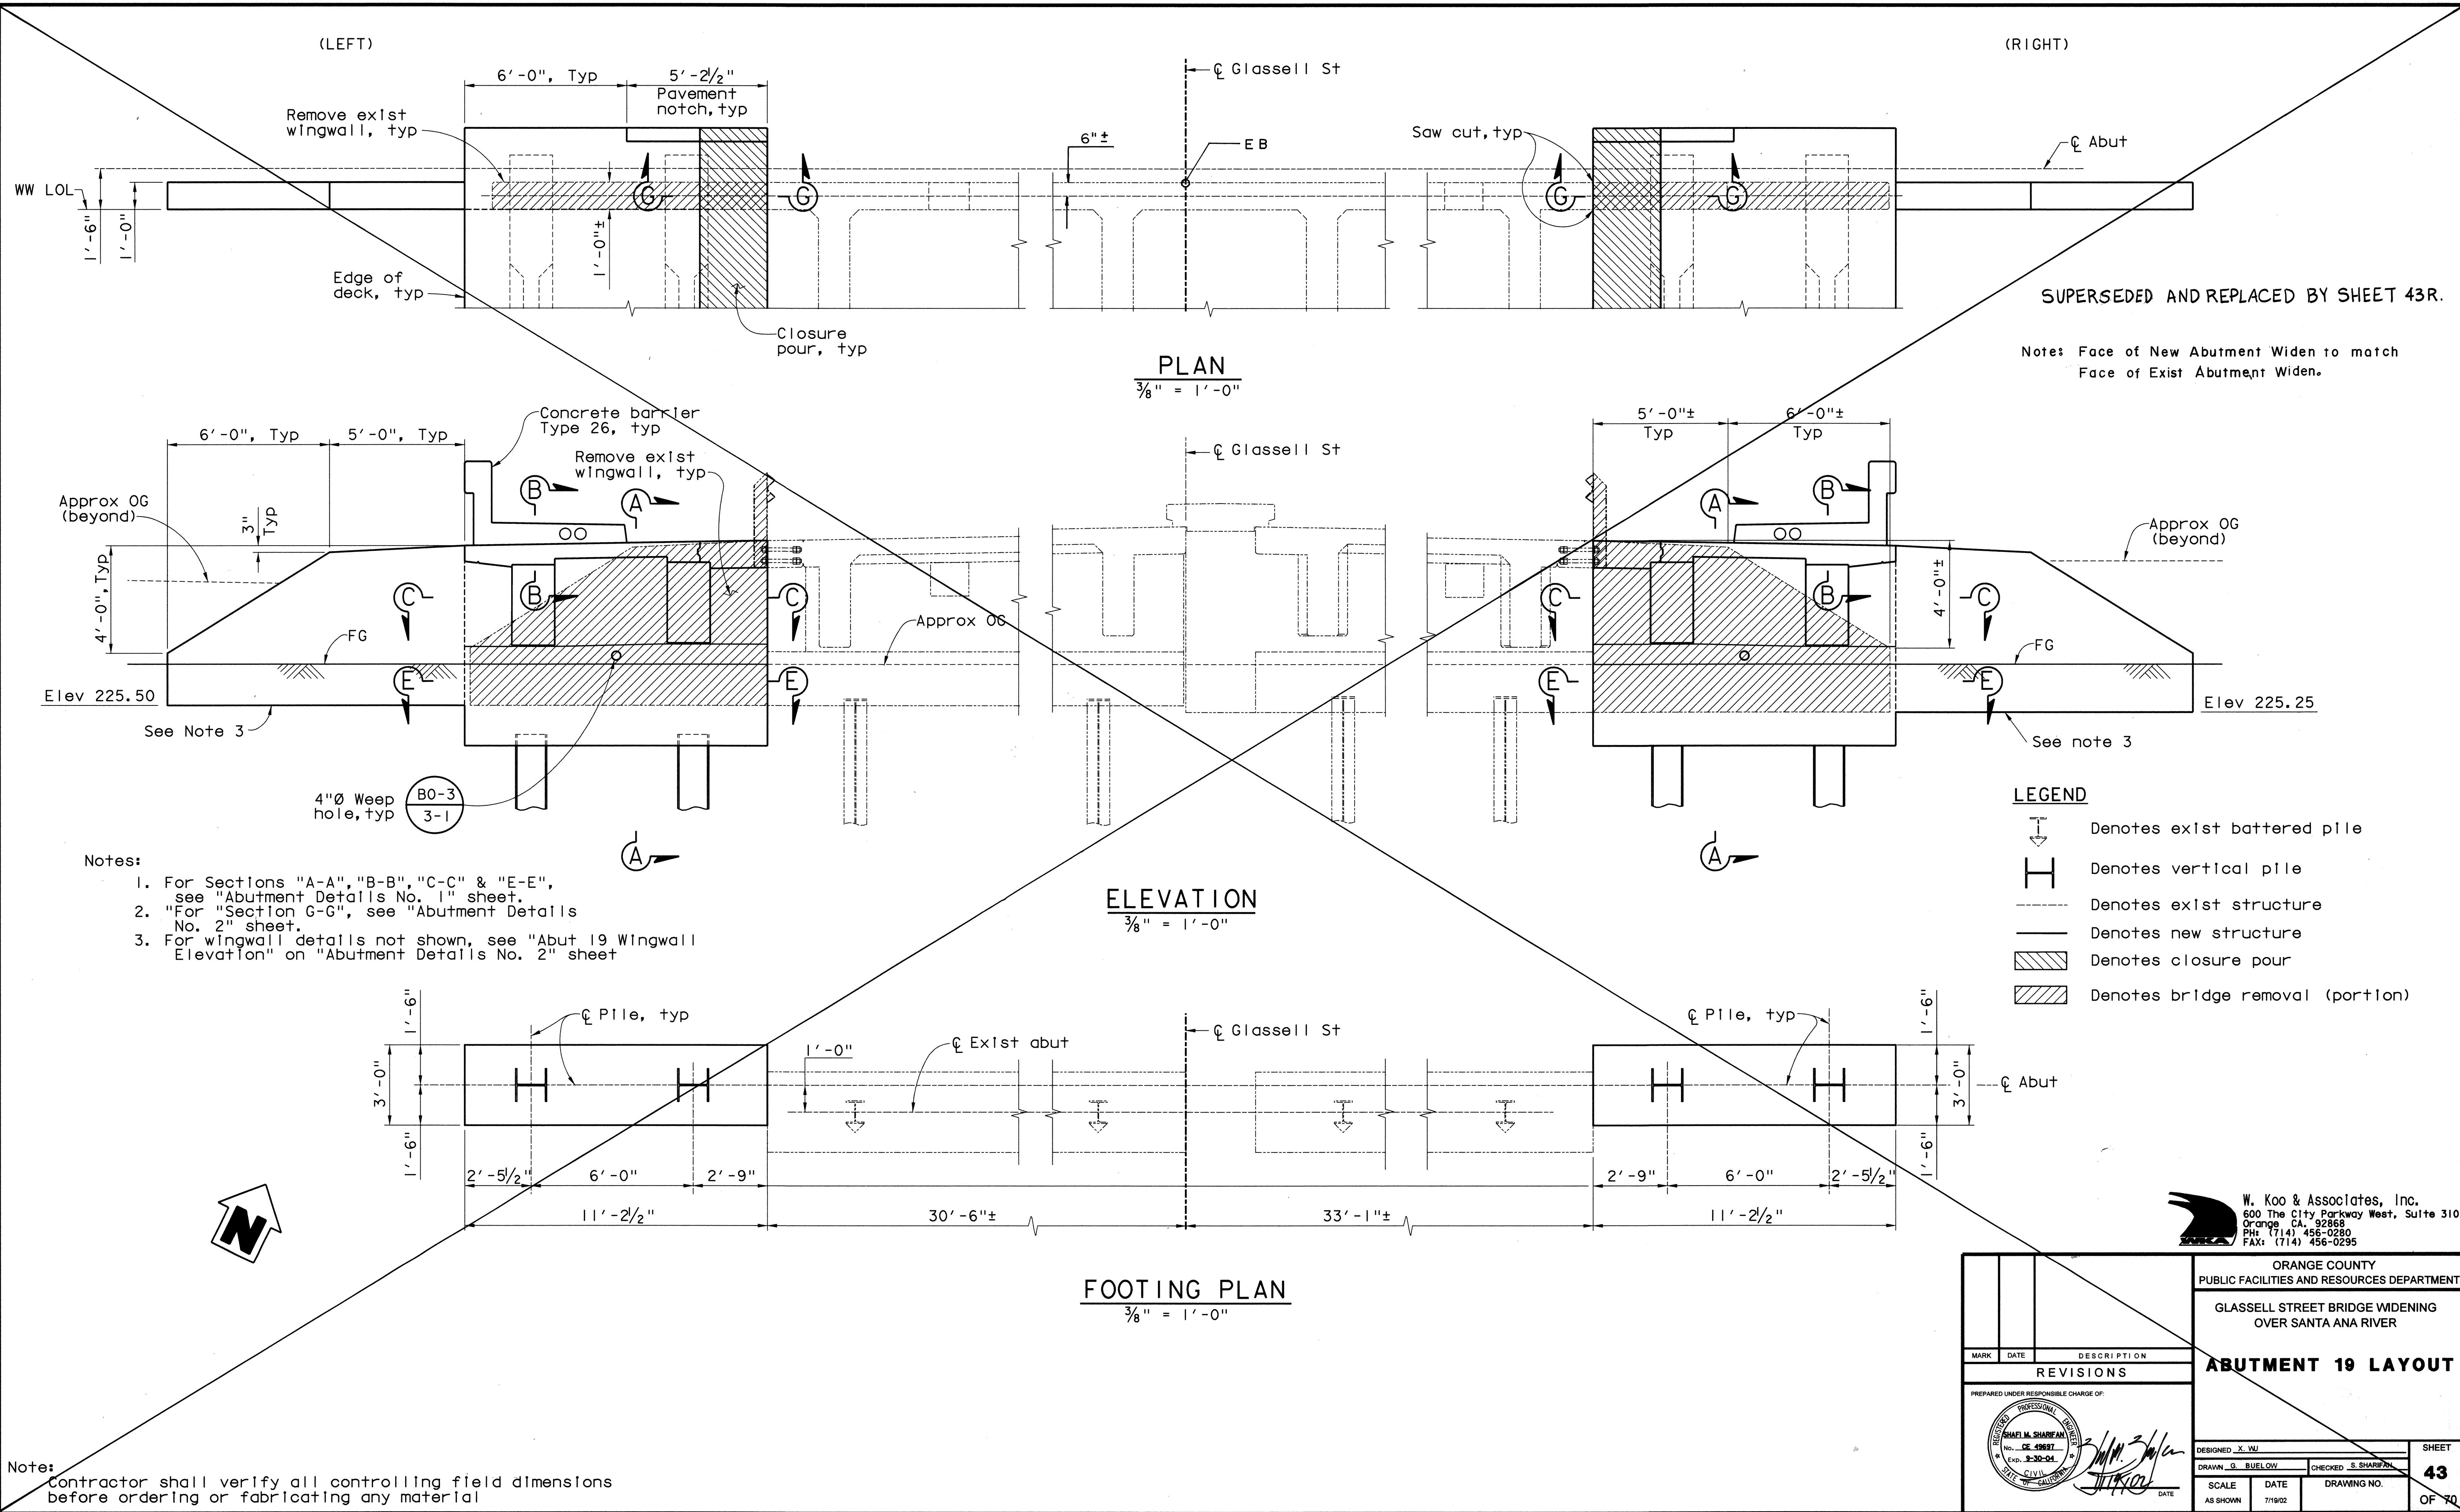

SUPERSEDED AND REPLACED BY SHEET 43R.

Notes: Face of New Abutment Widen to match Face of Exist Abutment Widen.

- LEGEND**
- Denotes exist battered pile
 - Denotes vertical pile
 - Denotes exist structure
 - Denotes new structure
 - Denotes closure pour
 - Denotes bridge removal (portion)

- Notes:**
- For Sections "A-A", "B-B", "C-C" & "E-E", see "Abutment Details No. 1" sheet.
 - For "Section G-G", see "Abutment Details No. 2" sheet.
 - For wingwall details not shown, see "Abut 19 Wingwall Elevation" on "Abutment Details No. 2" sheet

W. Koo & Associates, Inc.
600 The City Parkway West, Suite 310
Orange, CA 92668
PH: (714) 456-0280
FAX: (714) 456-0295

ORANGE COUNTY
PUBLIC FACILITIES AND RESOURCES DEPARTMENT
GLASSELL STREET BRIDGE WIDENING
OVER SANTA ANA RIVER

ABUTMENT 19 LAYOUT

MARK	DATE	DESCRIPTION
REVISIONS		
PREPARED UNDER RESPONSIBLE CHARGE OF:		

DESIGNED: X. WU	CHECKED: S. SHARIF	SHEET
DRAWN: G. BUELOW	DATE: 7/19/02	43
SCALE: AS SHOWN	DRAWING NO.	OF 70

Notes: Contractor shall verify all controlling field dimensions before ordering or fabricating any material