


Notes:

-
- Const J+
- Deck reinf
- Pier
- Bottom of girder
- 2" Clr typ
- #4 @ 12 along perimeter
- #4 @ 12 each way
- #5

SECTION B-B
3/4" = 1'-0"

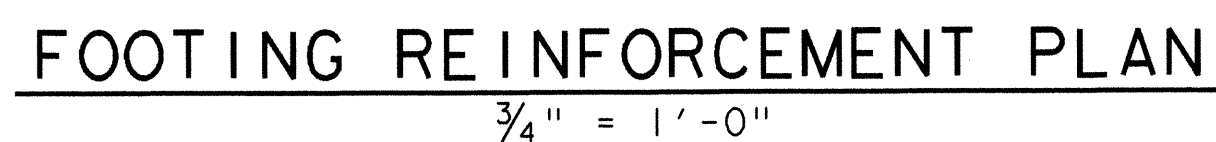

#7 $\frac{1'-9''}{3}$ / $\frac{1'-2''}{3}$ Drill & bond
dowel @ 12 vert
into 12" deep hole

Date Plotted: 07/25/2005

File Name: t:\cad\010-14\glassell\gl_pd2.dgn