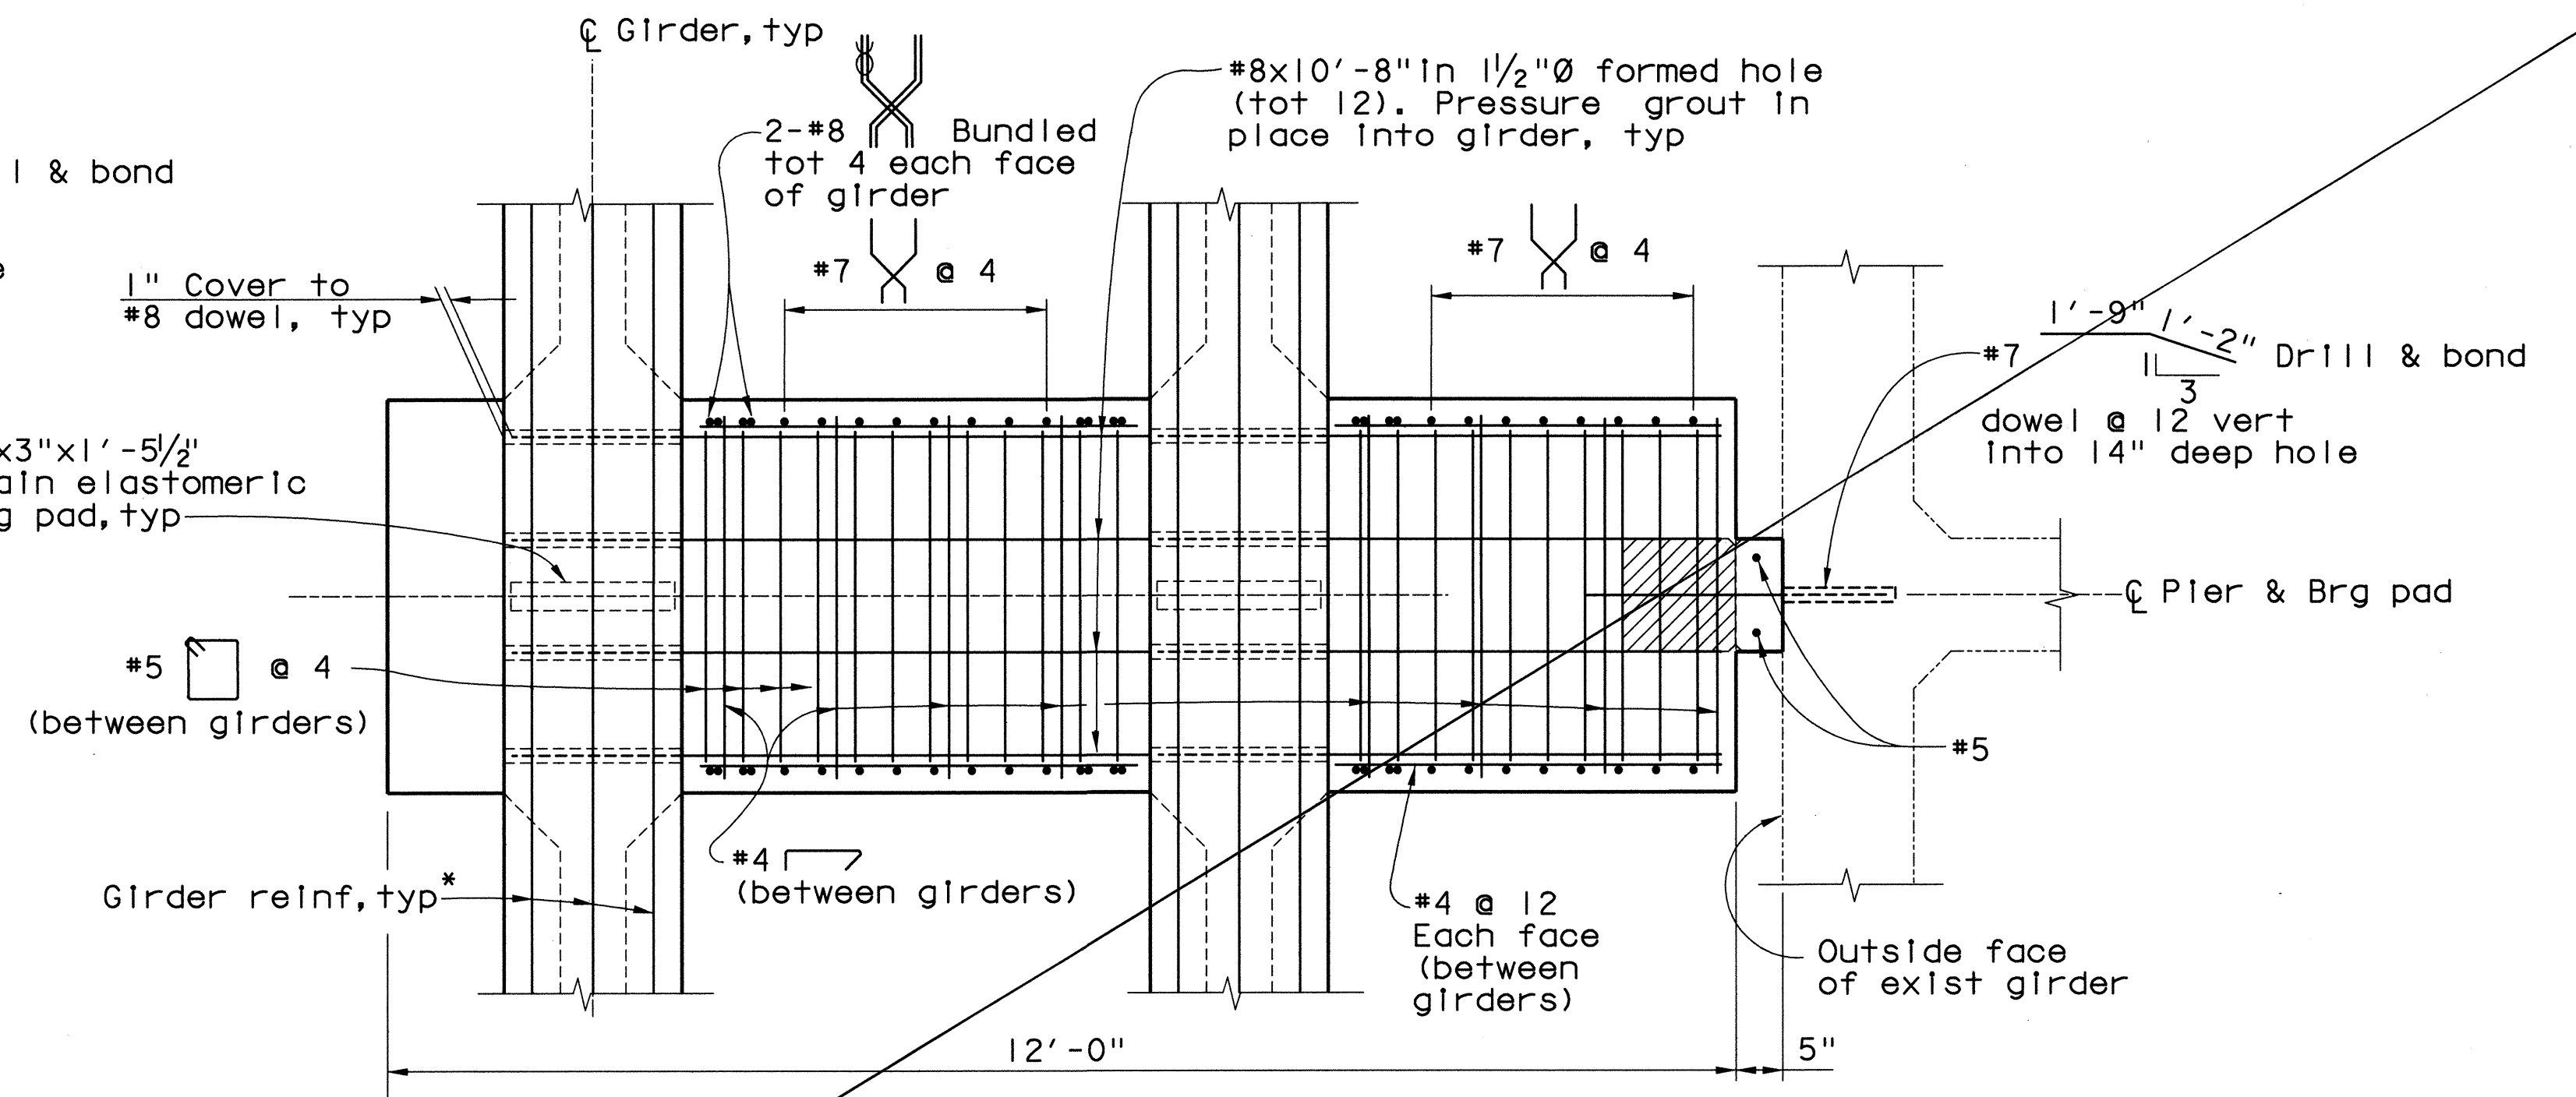
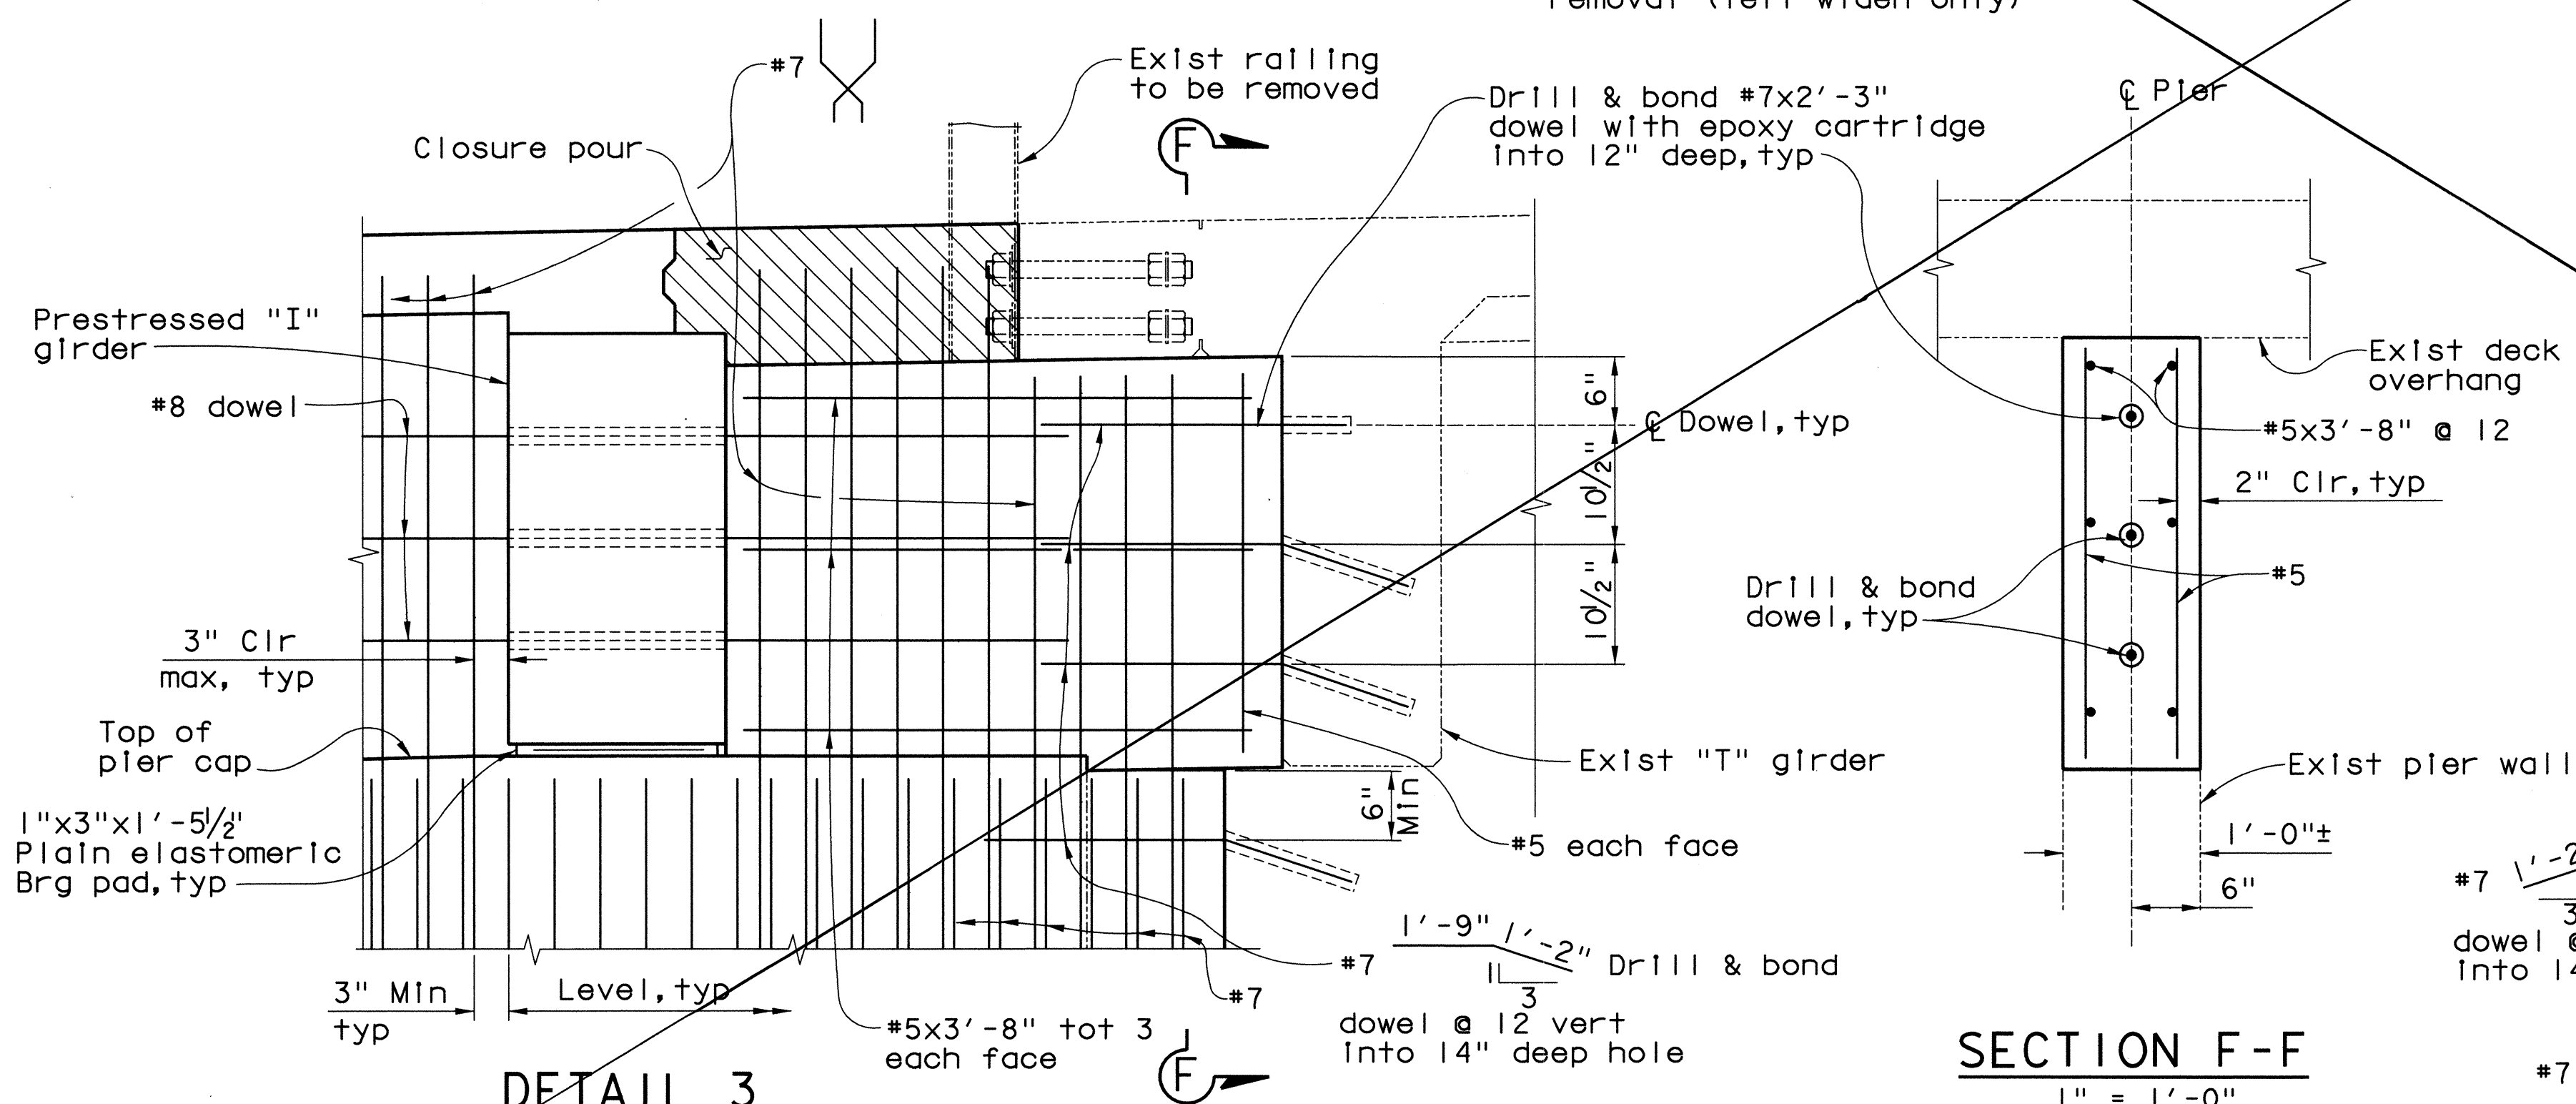


~~SECTION C-C~~

LEGEND

$$\frac{3}{4}'' = 1' - 0''$$


DETAIL 3

SECTION F-F
1" = 1'-0"

SECTION D-D

Technical drawing of a wall extension showing reinforcement details. The drawing includes a cross-section of a wall with an existing pier wall on the right and a new extension on the left. Reinforcement bars are shown with labels: #7 @ 12 vert into 14" deep hole, #7 @ 4, #4 @ 18, and #4 @ 18. Dimensions include 1'-2" | 1'-9", 1'-0"±, and 1'-0"±. Annotations include 'Drill & bond', 'Remove exist 2-#4', 'Exist pierwall', 'Cut-off exist', and 'Remove pierwall extension'.

SECTION E-E

ORANGE COUNTY
PUBLIC FACILITIES AND RESOURCES DEPARTMENT

PIER DETAILS NO. 3

				ORANGE COUNTY PUBLIC FACILITIES AND RESOURCES DEPARTMENT	
				GLASSSELL STREET BRIDGE WIDENING OVER SANTA ANA RIVER	
MARK	DATE	DESCRIPTION		PIER DETAILS NO. 3	
		REVISIONS			
		PREPARED UNDER RESPONSIBLE CHARGE OF:			
		 		DESIGNED <u>X. WU</u> DRAWN <u>G. BUELOW</u> CHECKED <u>S. SHARIFAN</u> SCALE DATE DRAWING NO. AS SHOWN 7/19/02 	
		DATE		SHEET 48 OF 70	

Date Plotted: \$DATES\$

File Name: \$FILES\$

Border sheet last modified 09-Nov-1999