
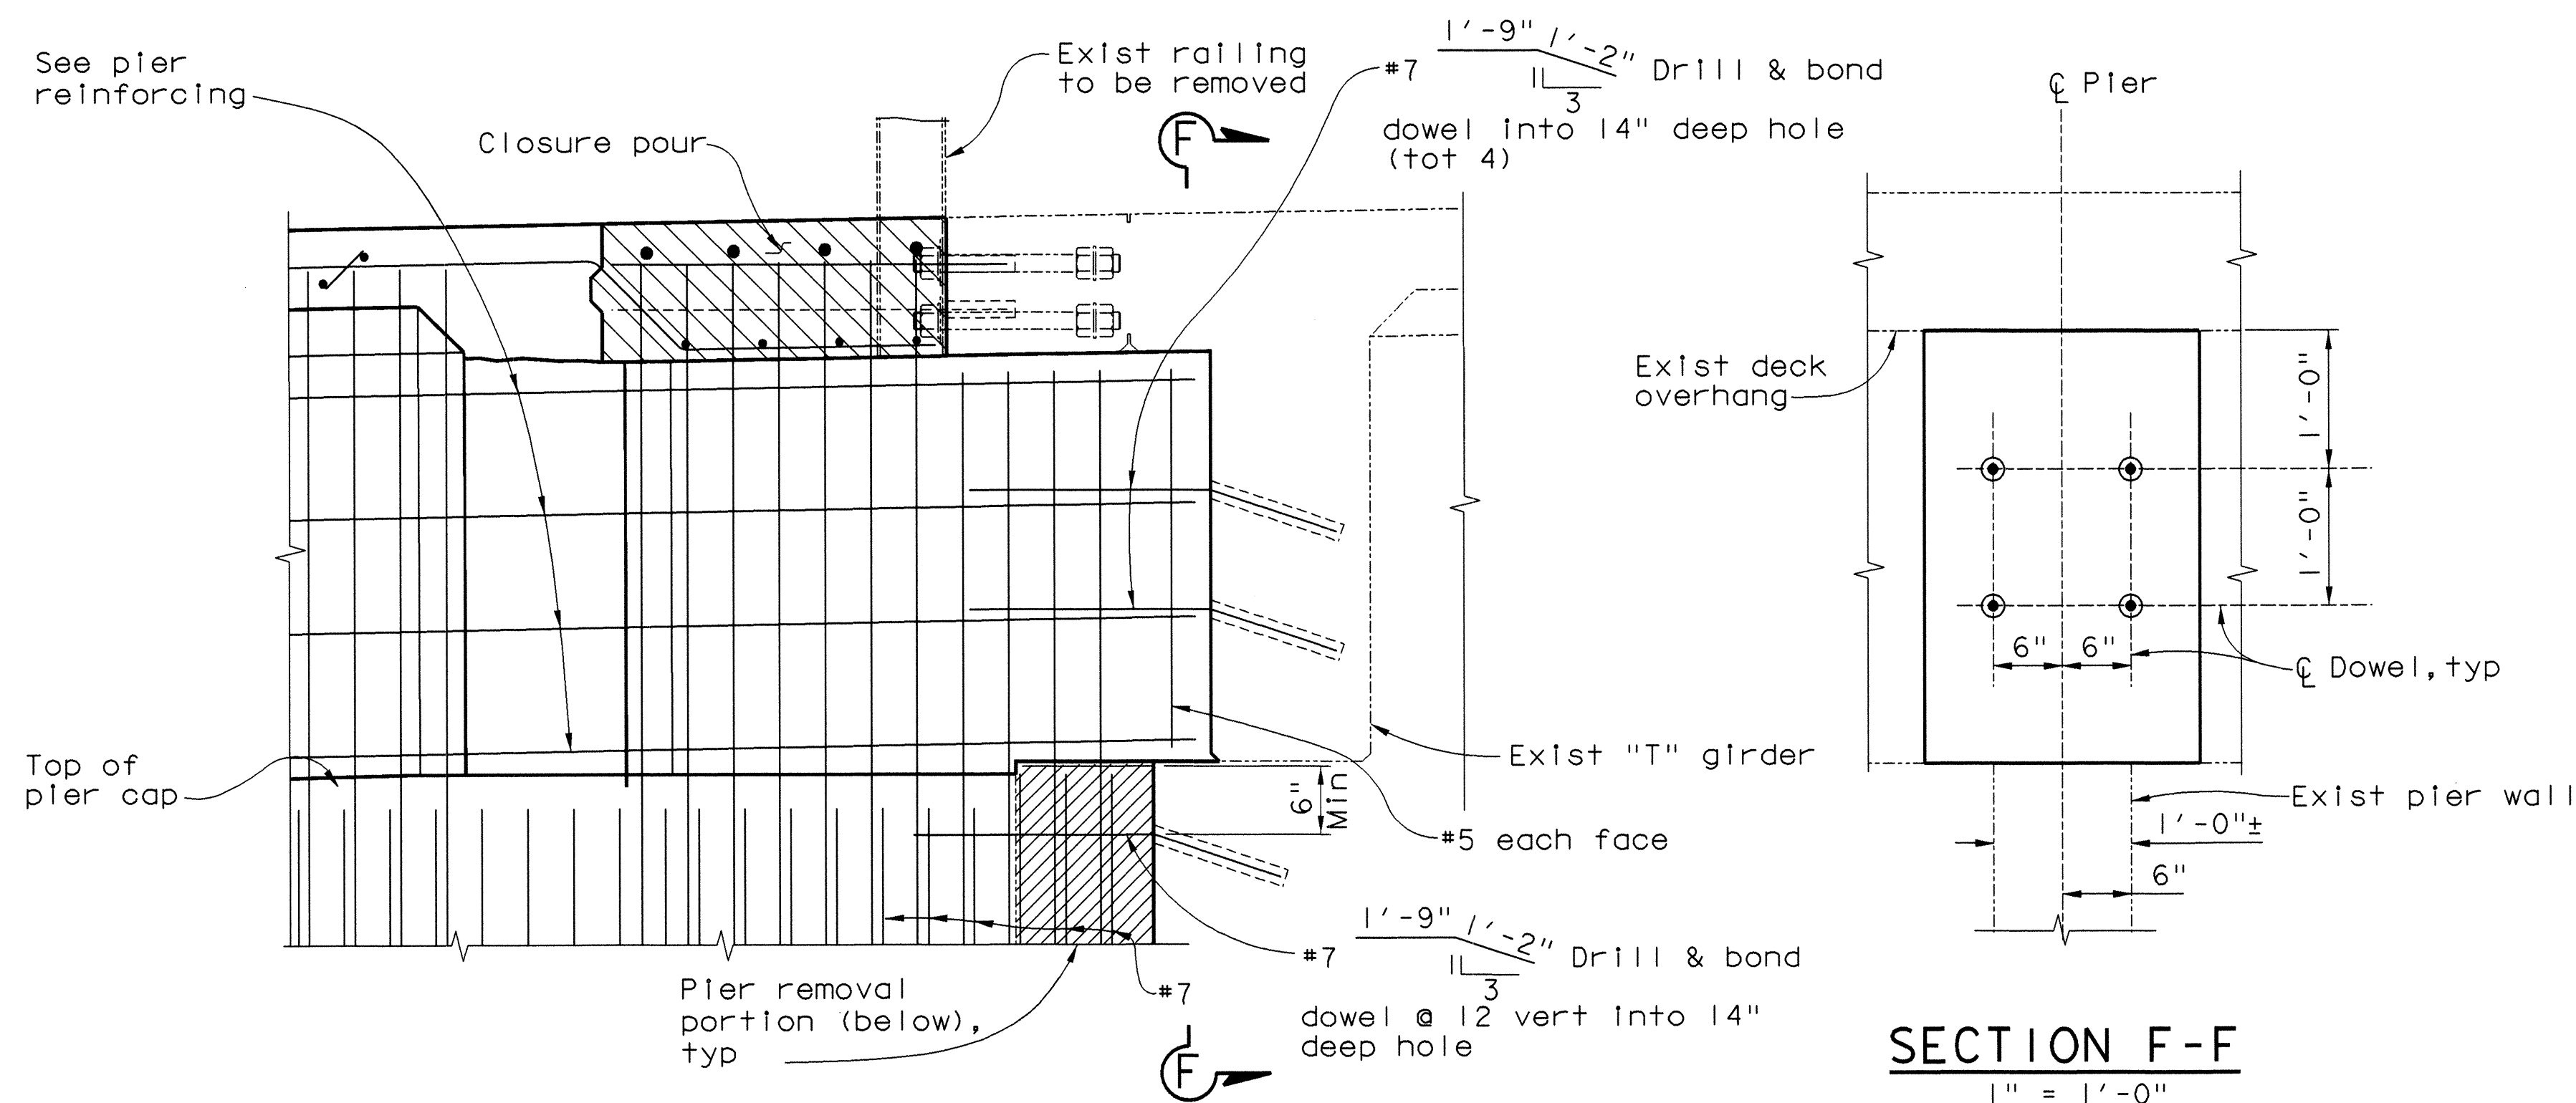
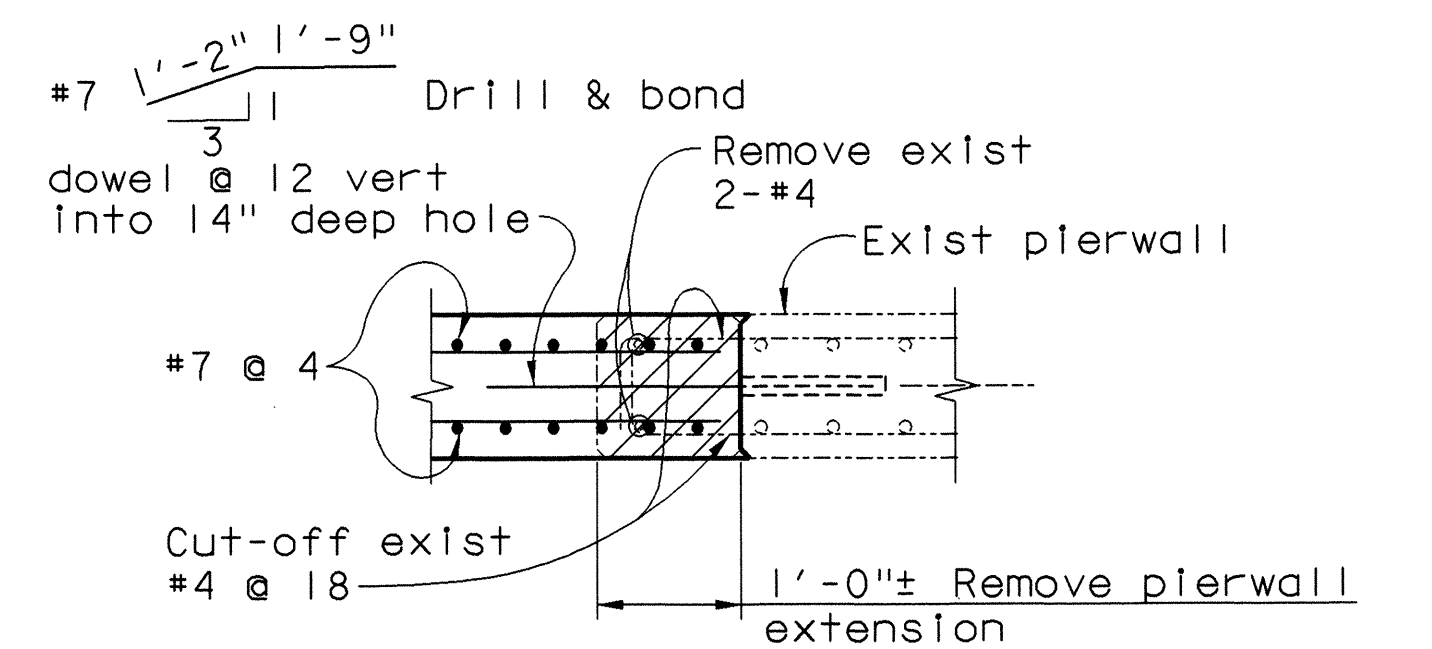
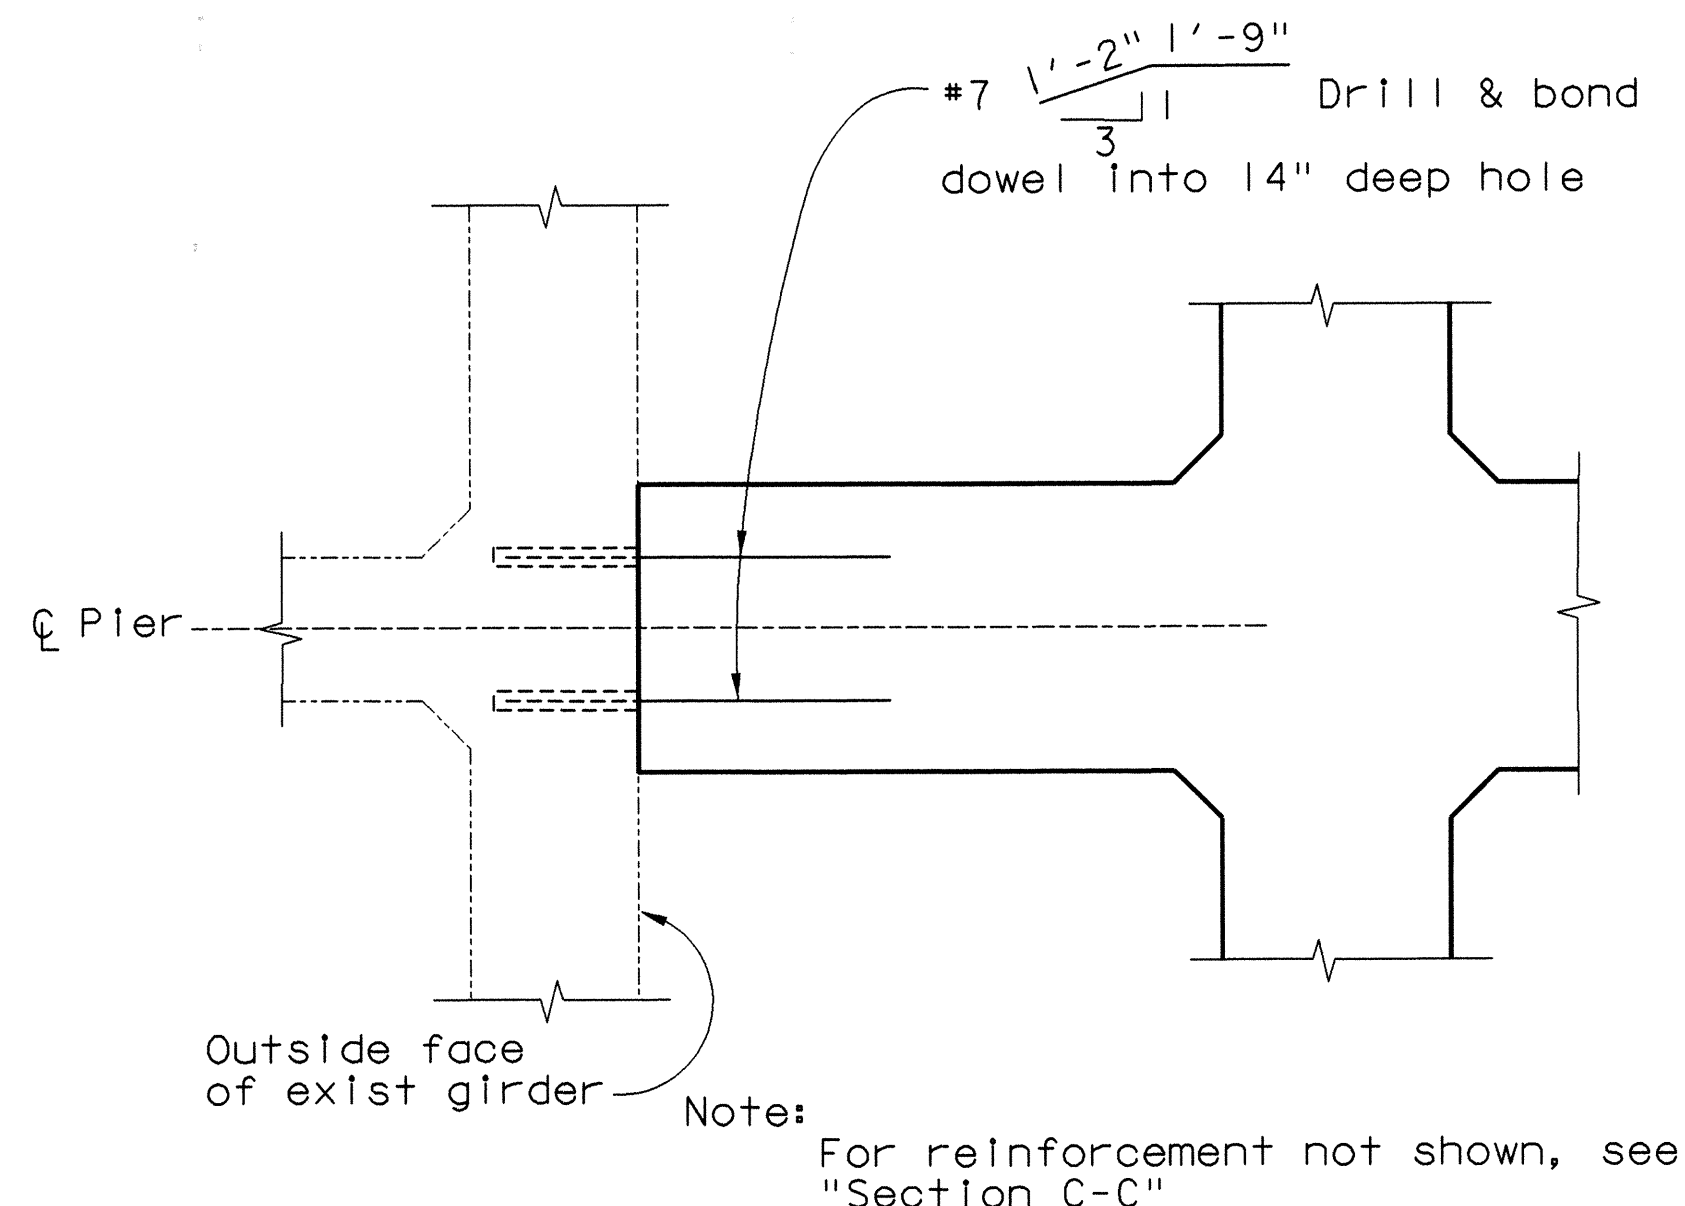


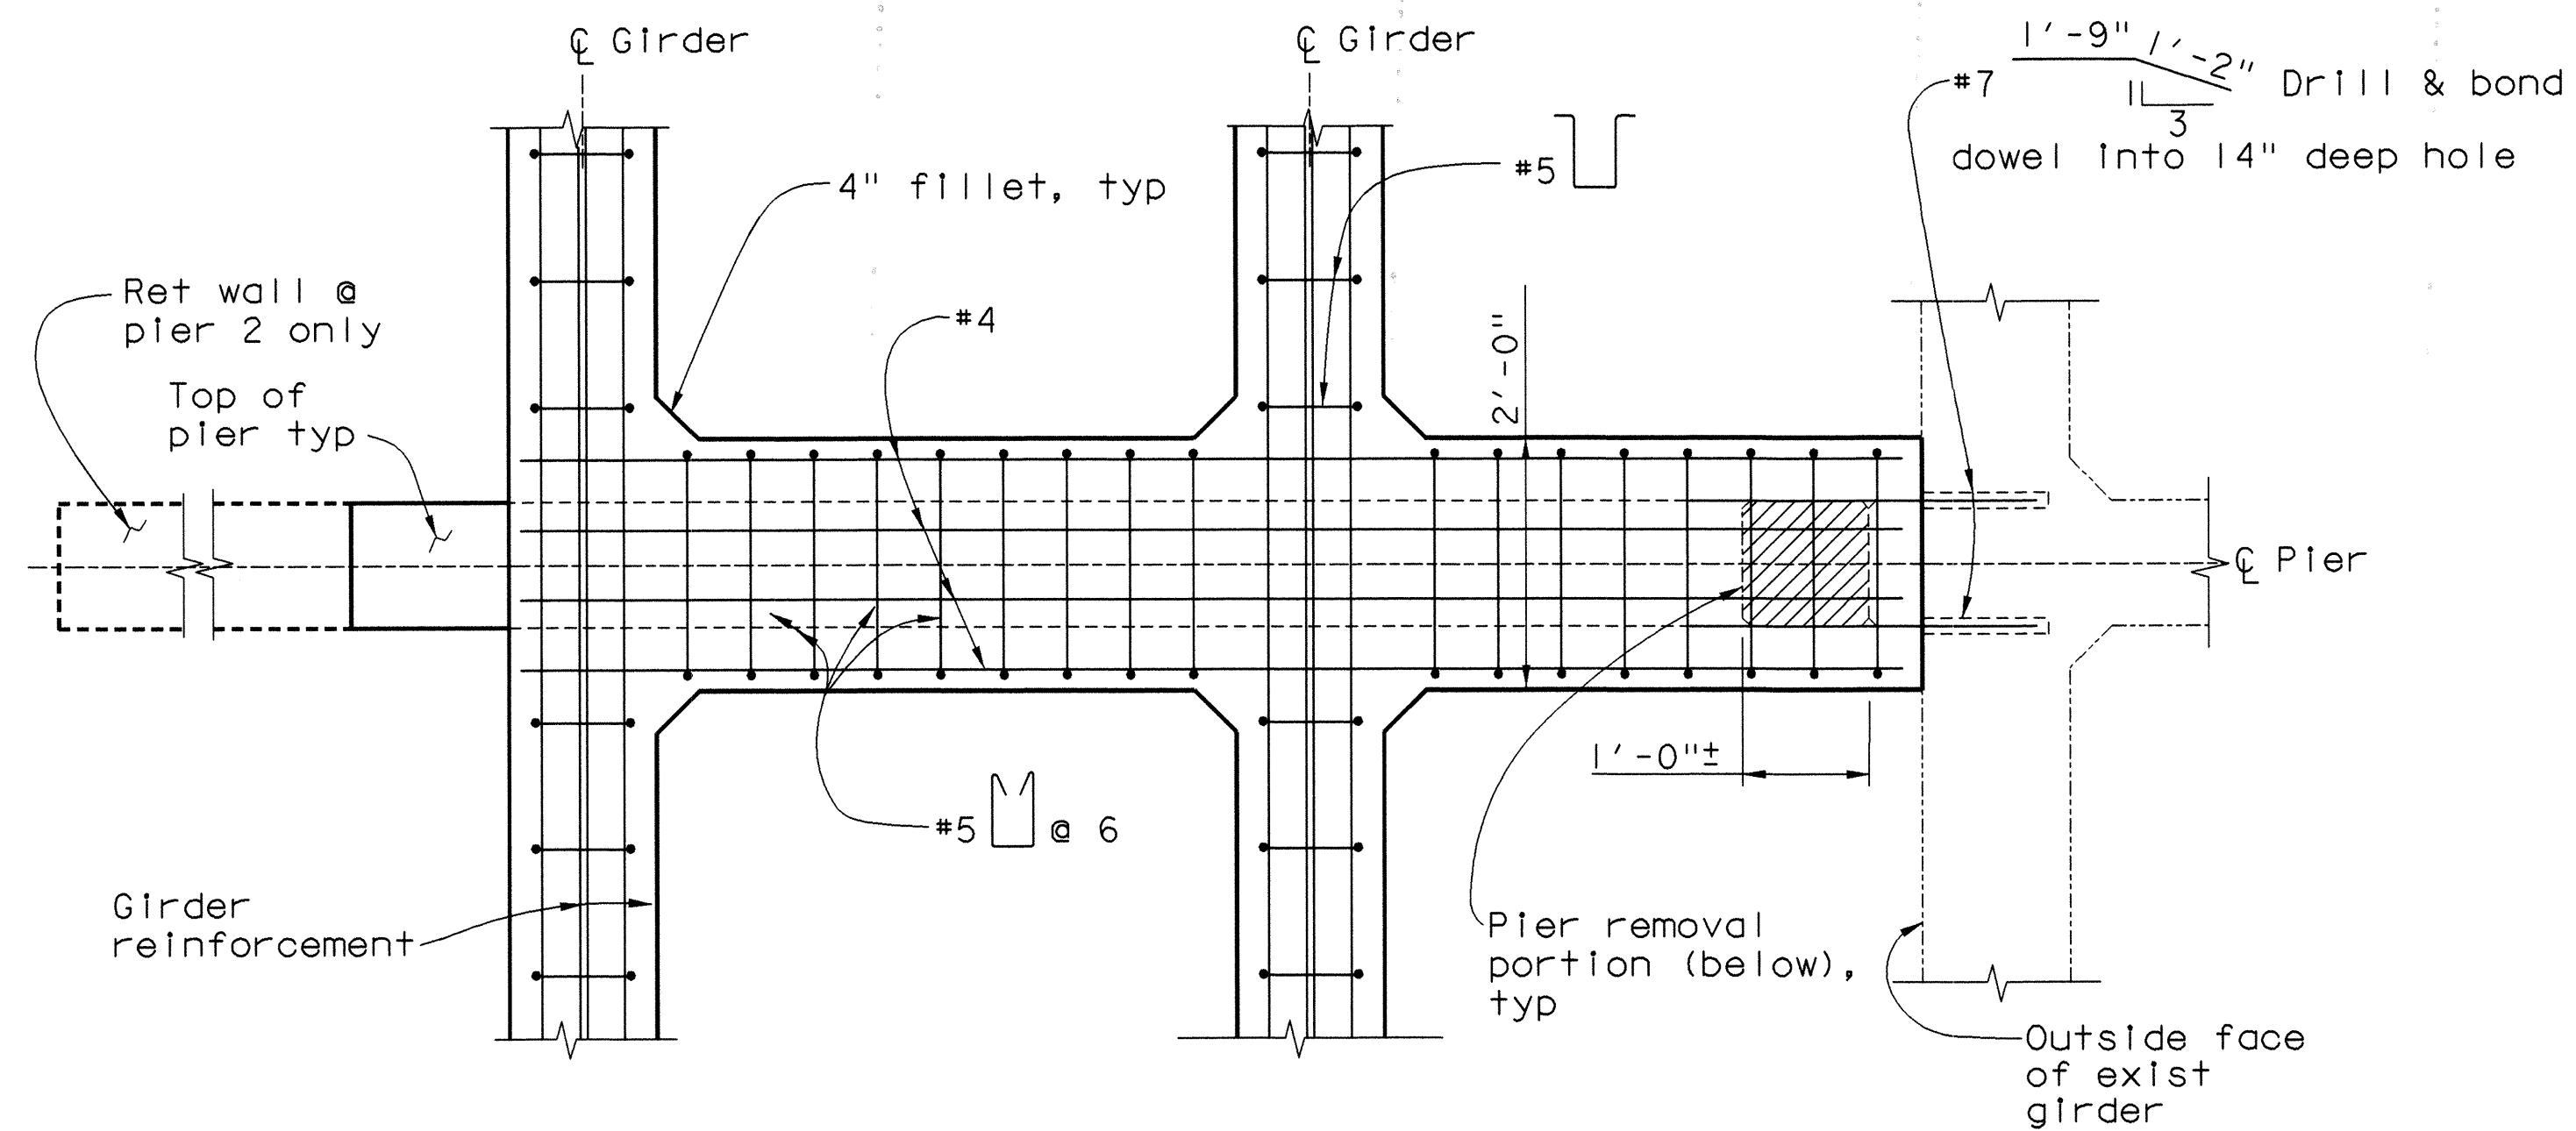

SECTION F-F
1" = 1'-0"

Note:
 Contractor shall verify all controlling field dimensions before ordering or fabricating any material

W. Koo & Associates, Inc.
 600 The City Parkway West, Suite 310
 Orange, CA 92668
 PH: (714) 456-0280
 FAX: (714) 456-0295

ORANGE COUNTY RESOURCES AND DEVELOPMENT MANAGEMENT DEPARTMENT		GLASSELL STREET BRIDGE WIDENING OVER SANTA ANA RIVER	
PIER DETAILS NO. 3		SHEET 48R OF 70	
MARK	DATE	DESCRIPTION	
REVISIONS			
PREPARED UNDER RESPONSIBLE CHARGE OF:			
DESIGNED	X. WU	CHECKED	S. SHARIFAN
DRAWN	G. BUELOW	DATE	7/19/02
SCALE	AS SHOWN	DRAWING NO.	

Date Plotted: 07/25/2005

File Name: t:\cad\010-14\glassell\gl_p3.dgn

Border sheet last modified 08-Nov-1999