



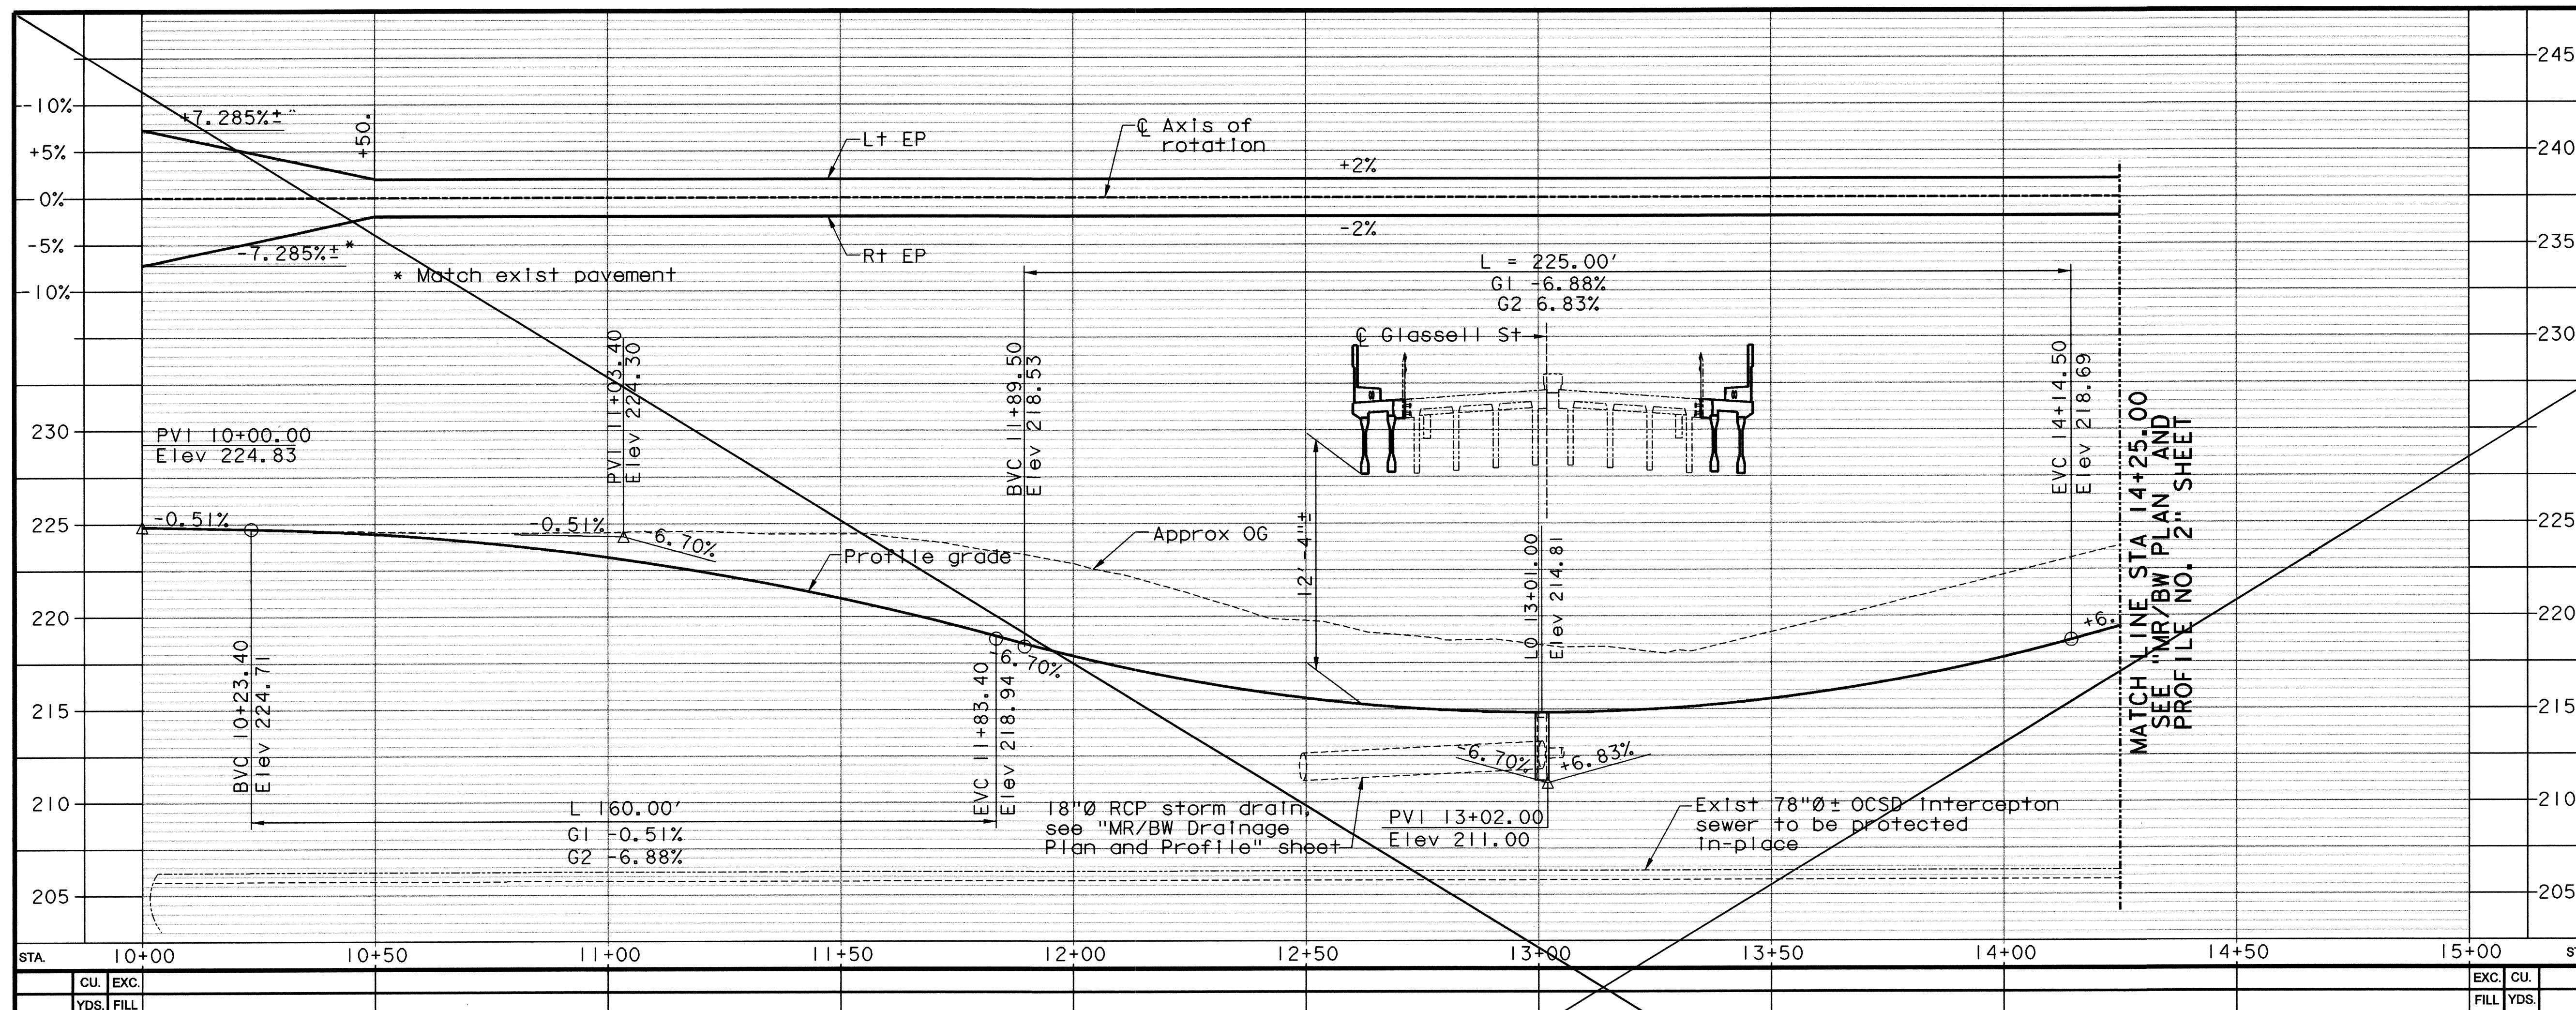

SUPERSEDED AND REPLACED BY SHEET 8R.

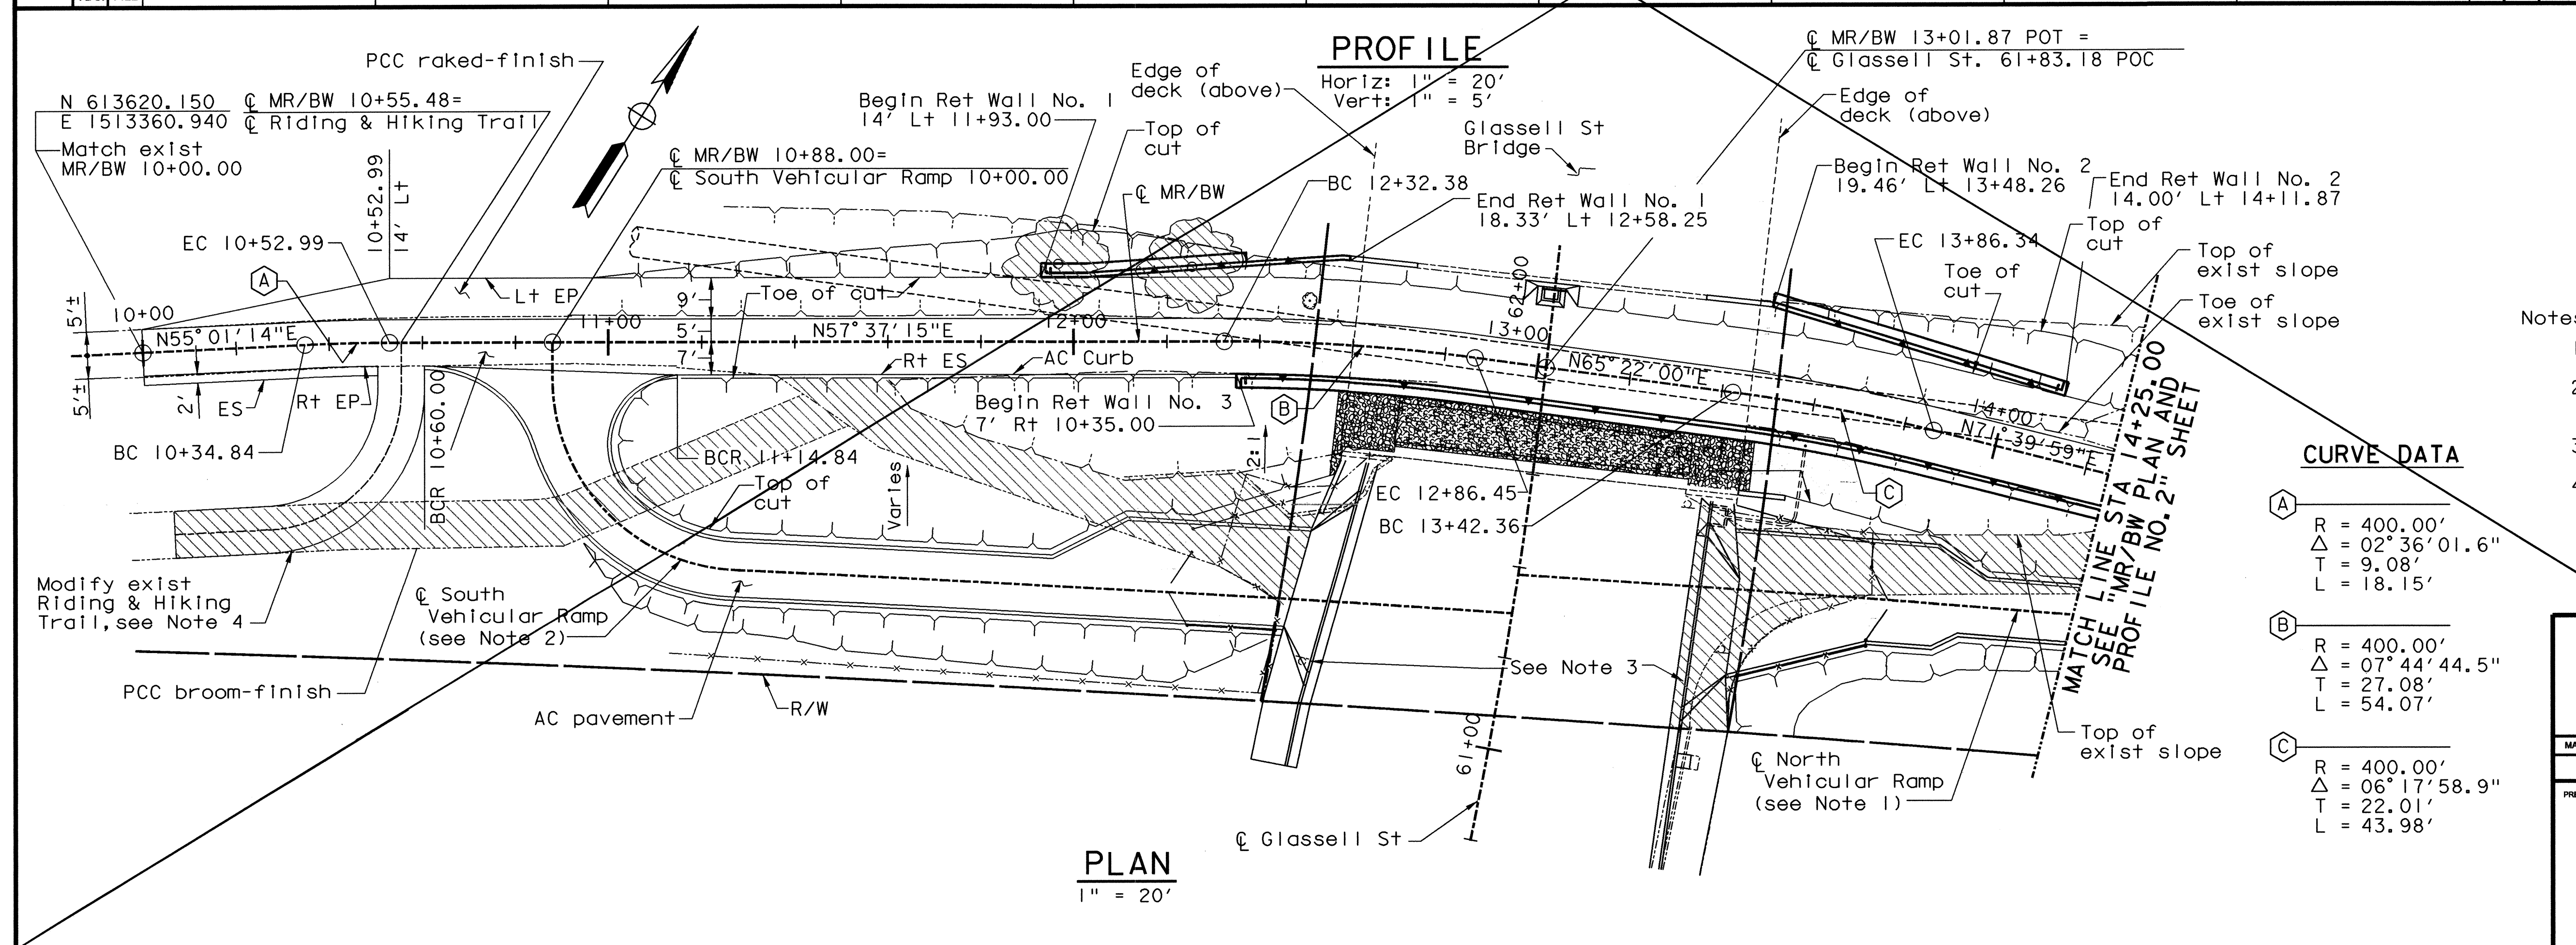

LEGEND

- Remove exist Riding & Hiking trail & Vehicular Ramp
- Remove exist trees

Notes:

- See "North Vehicular Ramp Plan and Profile" sheet for details not shown.
- See "South Vehicular Maintenance Ramp Plan and Profile" sheet for details not shown.
- See "Glassell St Sidewalk Modification Details" sheet.
- See "Riding and Hiking Trail Modification Plan" sheet for information not shown.

CURVE DATA

- (A) $R = 400.00'$
 $\Delta = 02^\circ 36' 01.6''$
 $T = 9.08'$
 $L = 18.15'$
- (B) $R = 400.00'$
 $\Delta = 07^\circ 44' 44.5''$
 $T = 27.08'$
 $L = 54.07'$
- (C) $R = 400.00'$
 $\Delta = 06^\circ 17' 58.9''$
 $T = 22.01'$
 $L = 43.98'$

W. Koo & Associates, Inc.
 600 The City Parkway West, Suite 310
 Orange, CA 92668
 PH: (714) 456-0280
 FAX: (714) 456-0295

ORANGE COUNTY PUBLIC FACILITIES AND RESOURCES DEPARTMENT	
GLASSELL STREET BRIDGE WIDENING OVER SANTA ANA RIVER	
MAINTENANCE ROAD/ BIKEWAY (MR/BW) PLAN AND PROFILE NO. 1	
DESIGNED: G. BUELOW	SHEET
DRAWN: G. BUELOW	8
SCALE: AS SHOWN	OF 70
DATE: 7/19/02	
CHECKED: S. SHARIF	
DRAWING NO.	

Date Plotted: 01/15/03

File Name: i:\010-14\glassellbt_pro.dgn

Border sheet last modified 09-Nov-1999