



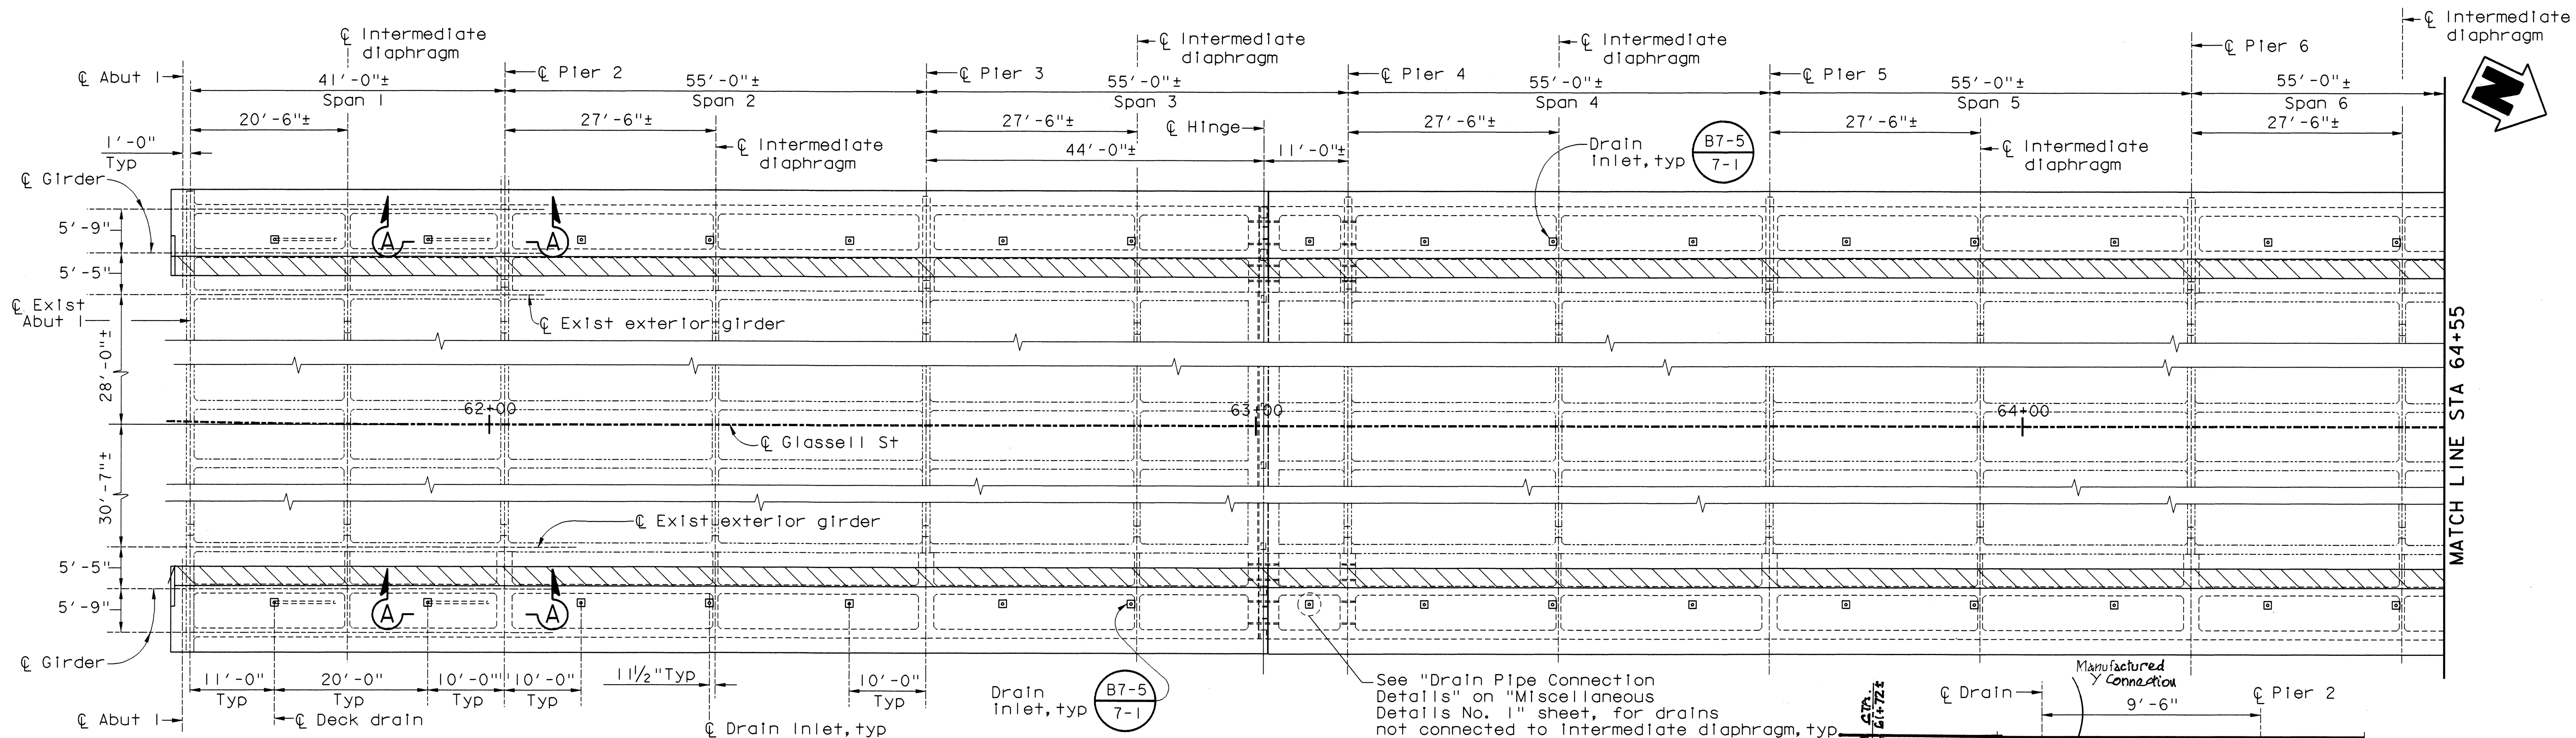


MATCH LINE STA 64+55

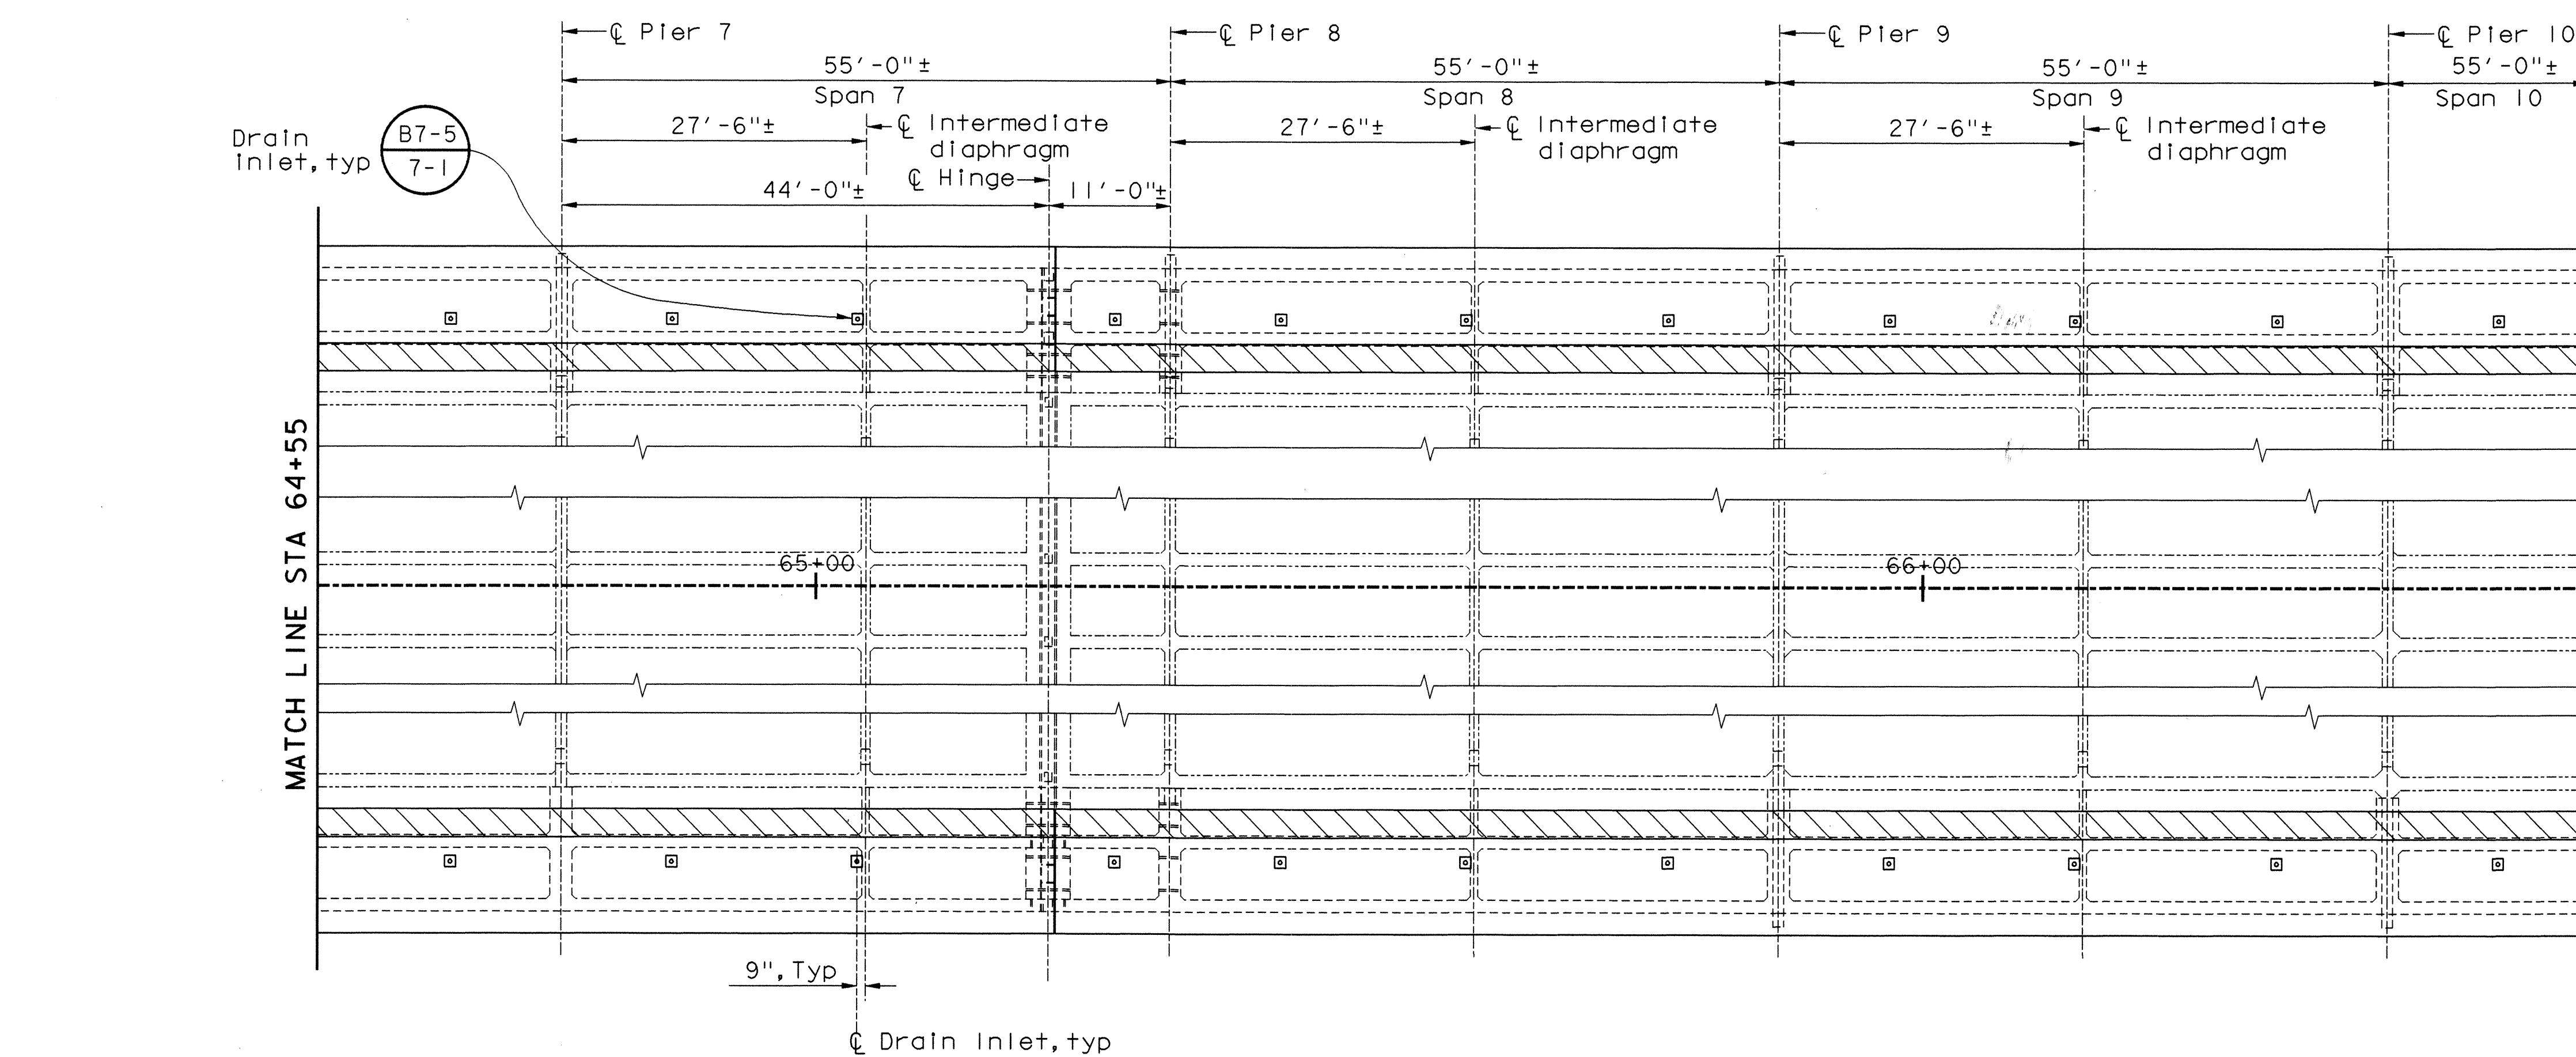

MATCH LINE STA 64+55

MATCH LINE STA 66+60
SEE "GIRDER LAYOUT NO. 2" SHEET

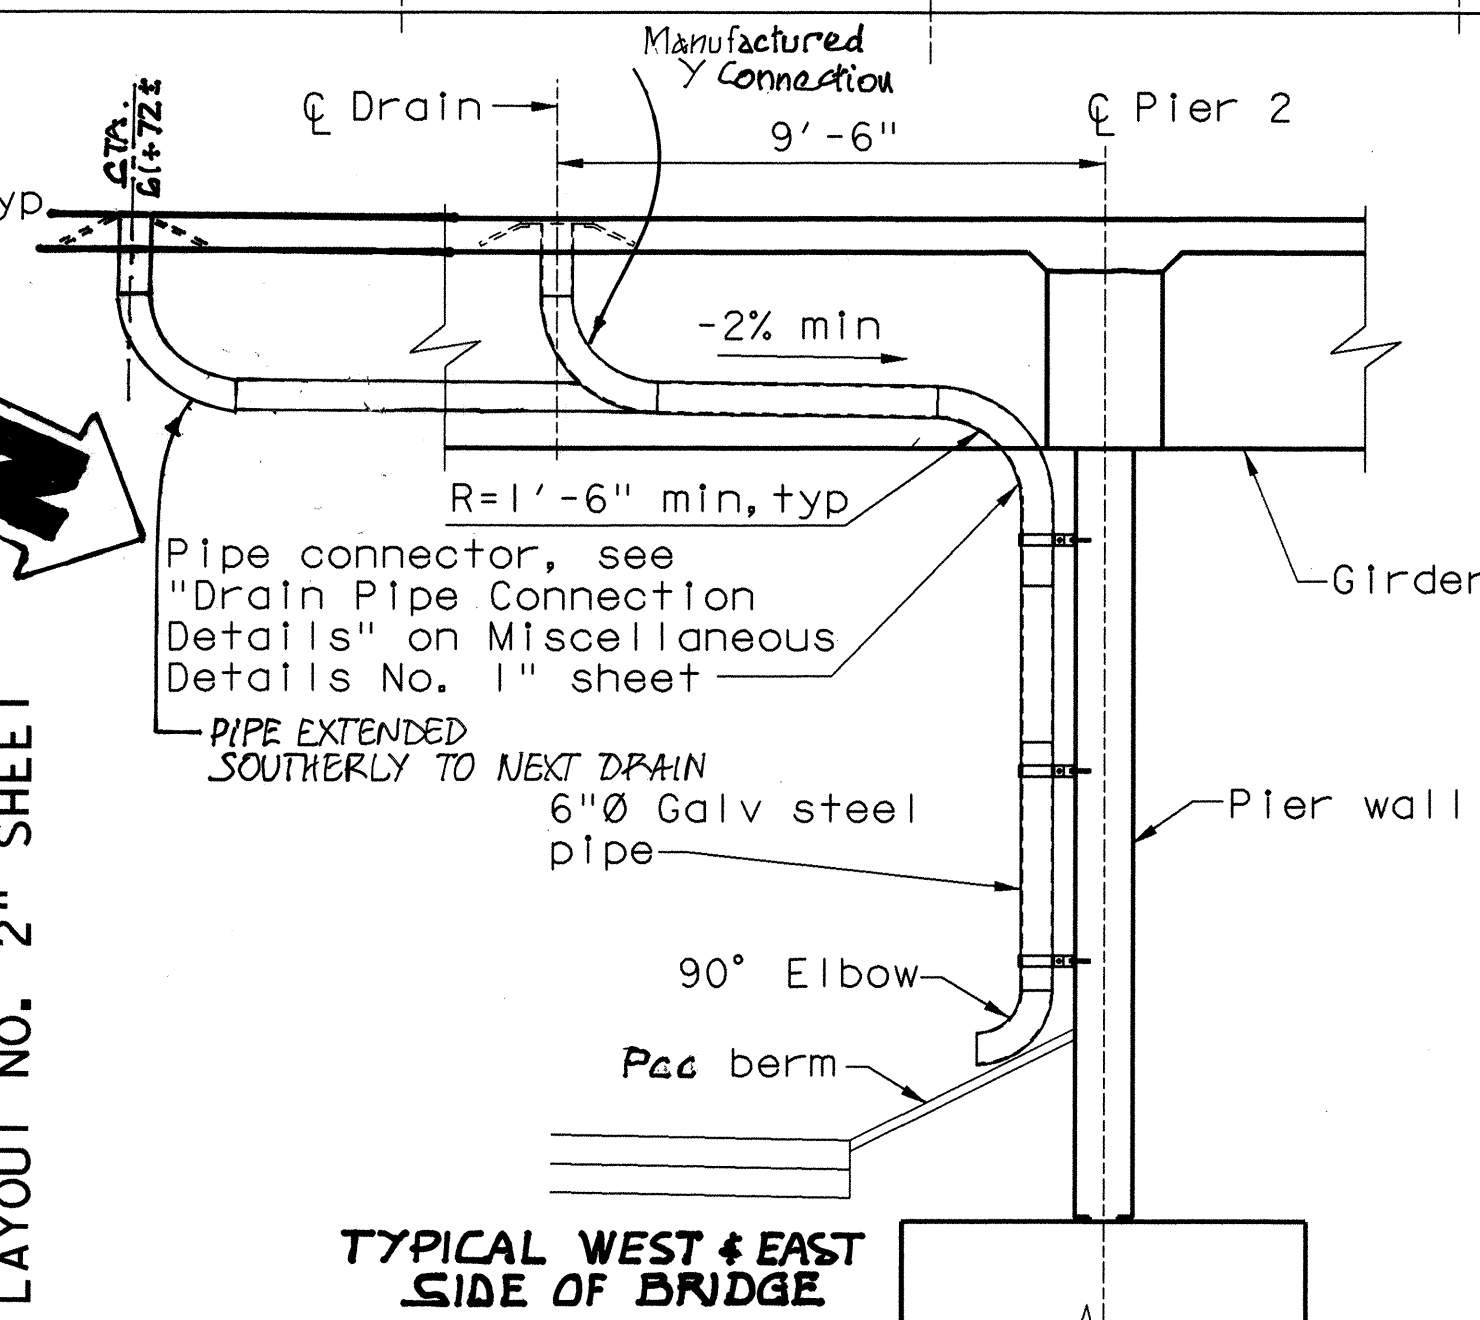

SECTION A-A
No Scale

Note:
Contractor shall verify all controlling field dimensions
before ordering or fabricating any material

W. Koo & Associates, Inc.
600 The City Parkway West, Suite 310
Orange, CA 92668
Ph: (714) 456-0280
Fax: (714) 456-0295

ORANGE COUNTY RESOURCES AND DEVELOPMENT MANAGEMENT DEPARTMENT		GLASSELL STREET BRIDGE WIDENING OVER SANTA ANA RIVER	
GIRDER LAYOUT NO. 1		SHEET 53R OF 70	
DESIGNED: K. RUSSELL	DRAWN: S. BUELOW	CHECKED: S. SHARIFAN	DATE: 7/19/02
SCALE: AS SHOWN	DATE: 7/19/02	DRAWING NO.	
PREPARED UNDER RESPONSIBLE CHARGE OF: PROFESSIONAL ENGINEER MICHAEL M. SHARIFAN No. CE 49627 Exp. 9-30-06 STATE OF CALIFORNIA			

Date Plotted: 07/25/2005

File Name: t:\cad\010-14\glassell\gl_g1.dgn

Border sheet last modified 09-Nov-1999