


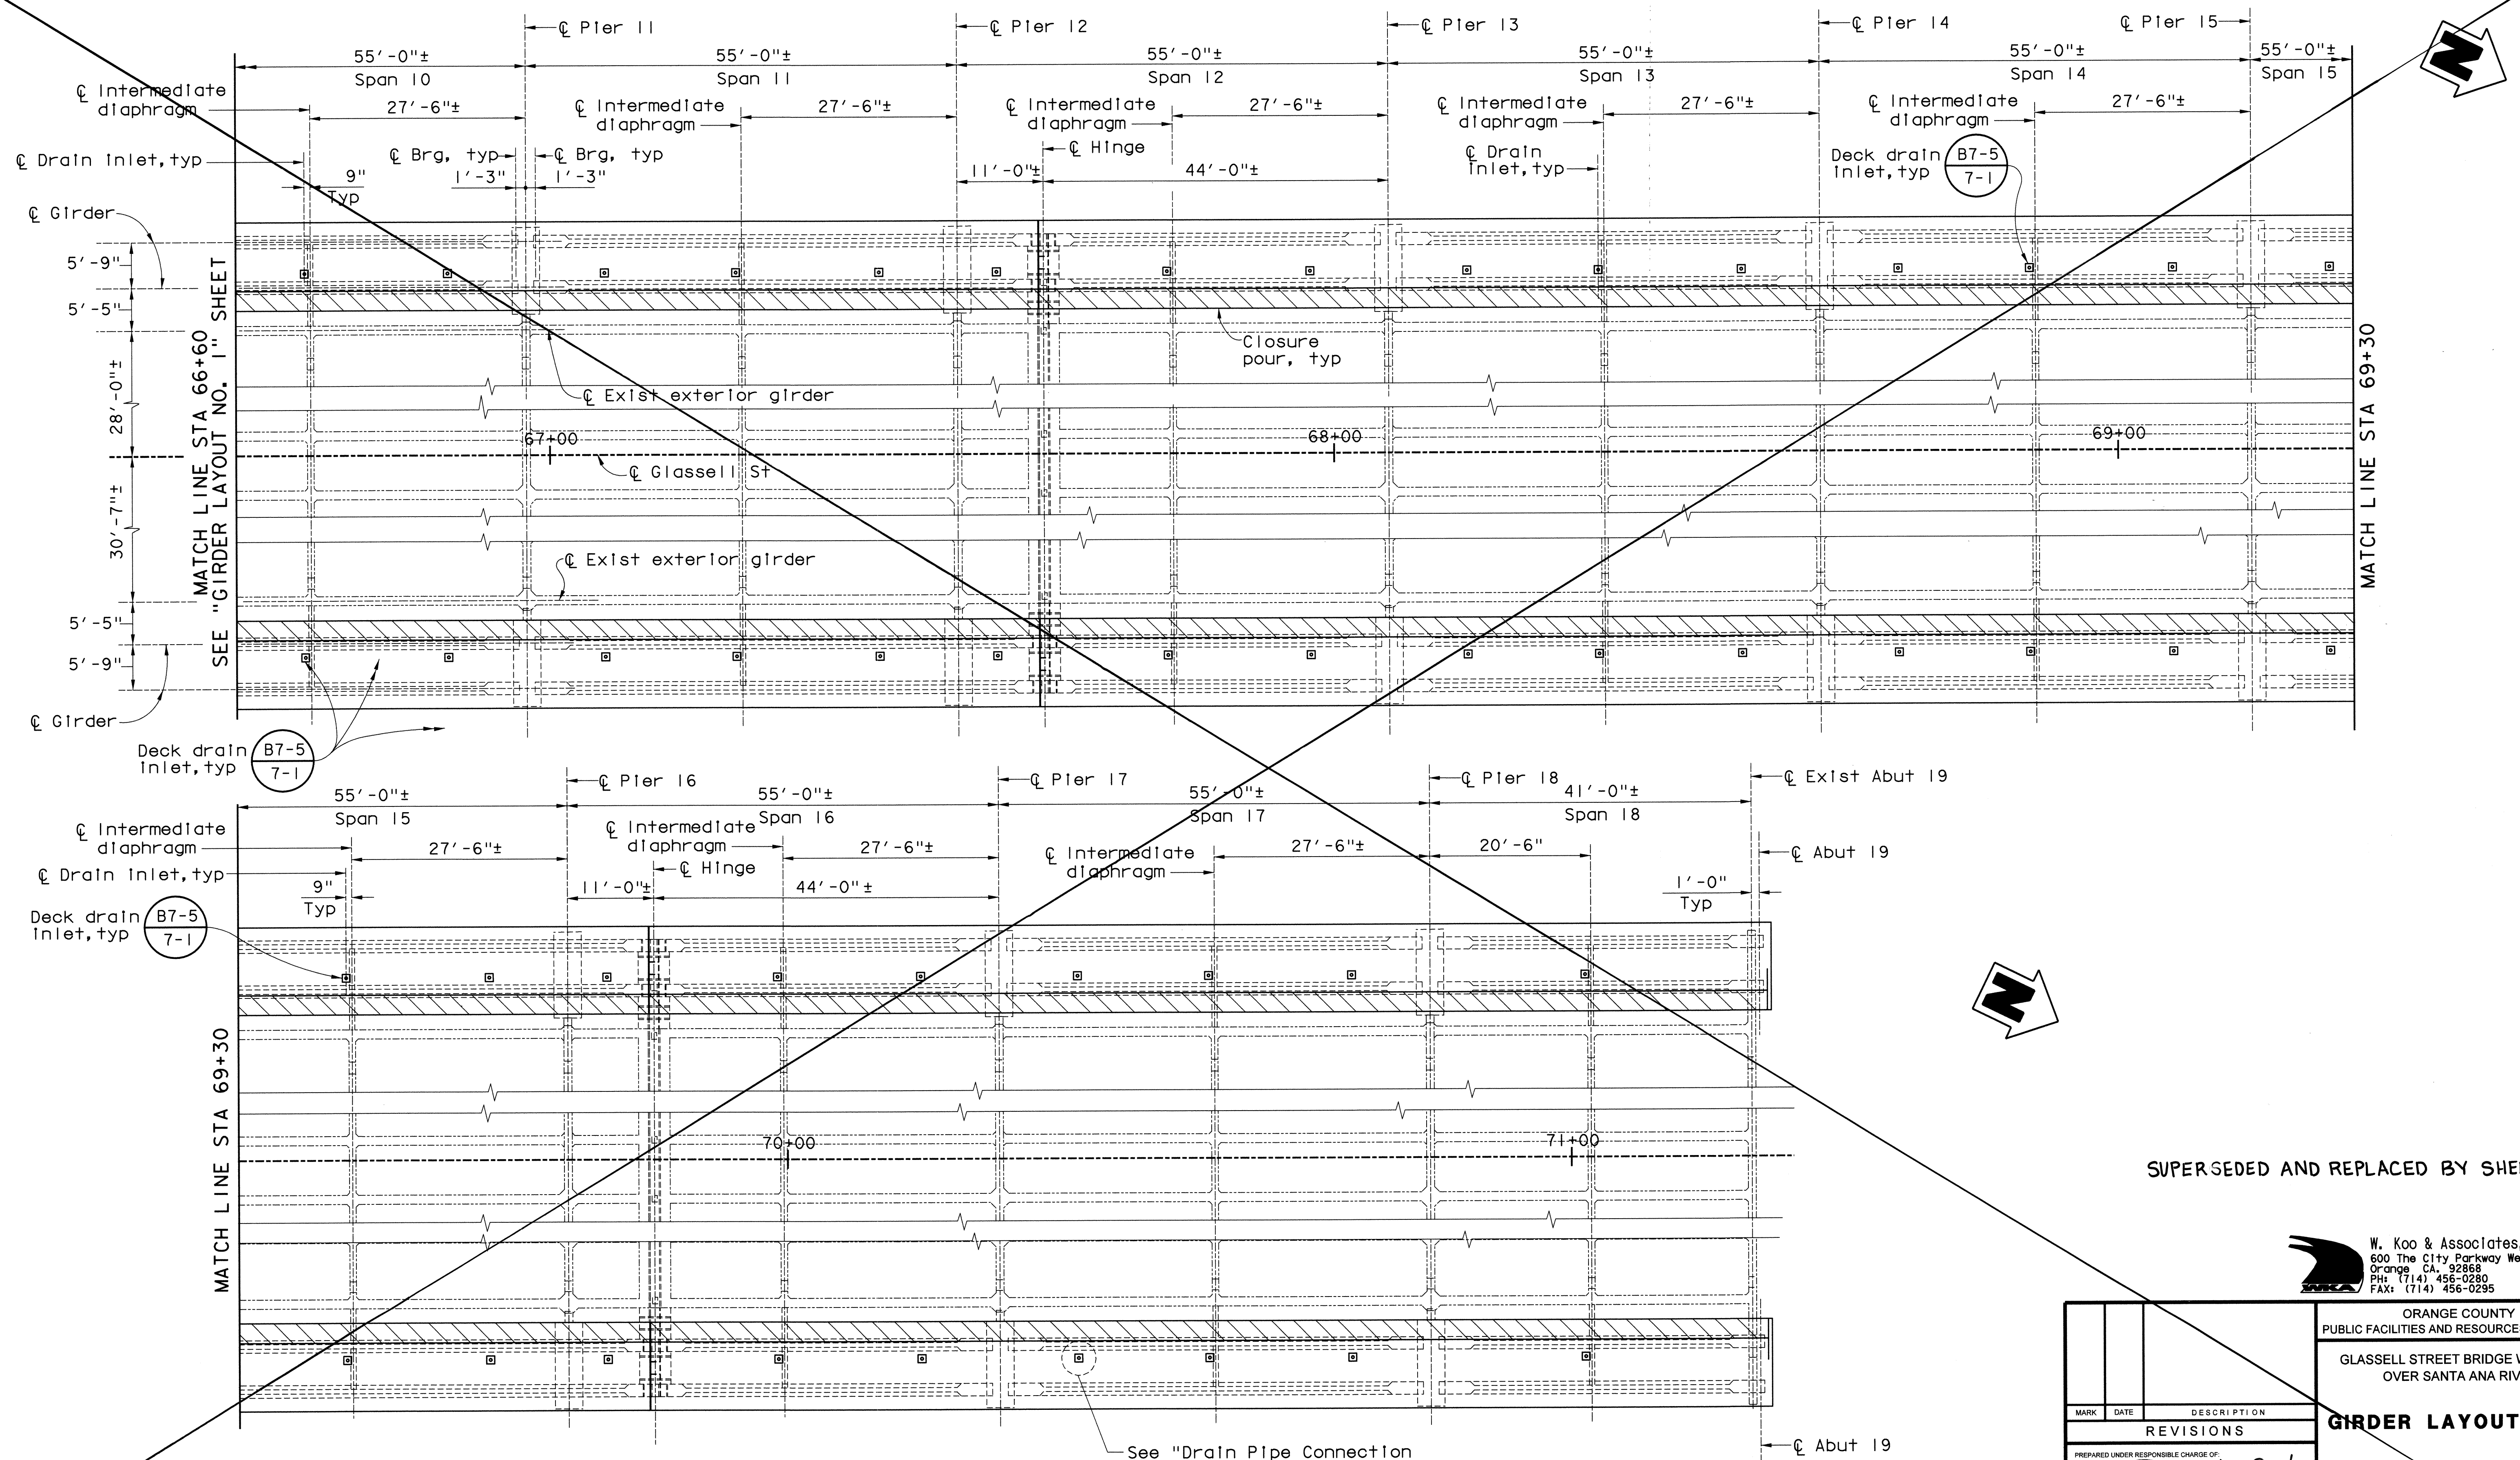

Note: Contractor shall verify all controlling field dimensions before ordering or fabricating any material

See "Drain Pipe Connection Details" on "Miscellaneous Details No. 1" sheet, for drains not connected to intermediate diaphragm, typ

SUPERSEDED AND REPLACED BY SHEET 54R.

W. Koo & Associates, Inc.
600 The City Parkway West, Suite 310
Orange, CA, 92668
PH: (714) 456-0280
FAX: (714) 456-0295

ORANGE COUNTY PUBLIC FACILITIES AND RESOURCES DEPARTMENT		GLASSELL STREET BRIDGE WIDENING OVER SANTA ANA RIVER							
GIRDER LAYOUT NO. 2		SHEET 54 OF 70							
<table border="1"> <thead> <tr> <th>MARK</th> <th>DATE</th> <th>DESCRIPTION</th> </tr> </thead> <tbody> <tr> <td colspan="3">REVISIONS</td> </tr> </tbody> </table>				MARK	DATE	DESCRIPTION	REVISIONS		
MARK	DATE	DESCRIPTION							
REVISIONS									
<table border="1"> <tr> <td>DESIGNED: K. RUSSELL</td> <td>CHECKED: S. SHARIFAN</td> </tr> <tr> <td>DRAWN: G. BUELOW</td> <td>DATE: 7/19/02</td> </tr> <tr> <td>SCALE: AS SHOWN</td> <td>DRAWING NO.</td> </tr> </table>				DESIGNED: K. RUSSELL	CHECKED: S. SHARIFAN	DRAWN: G. BUELOW	DATE: 7/19/02	SCALE: AS SHOWN	DRAWING NO.
DESIGNED: K. RUSSELL	CHECKED: S. SHARIFAN								
DRAWN: G. BUELOW	DATE: 7/19/02								
SCALE: AS SHOWN	DRAWING NO.								

Date Plotted: \$DATES\$

File Name: \$FILES\$

Border sheet last modified 09-Nov-1999