
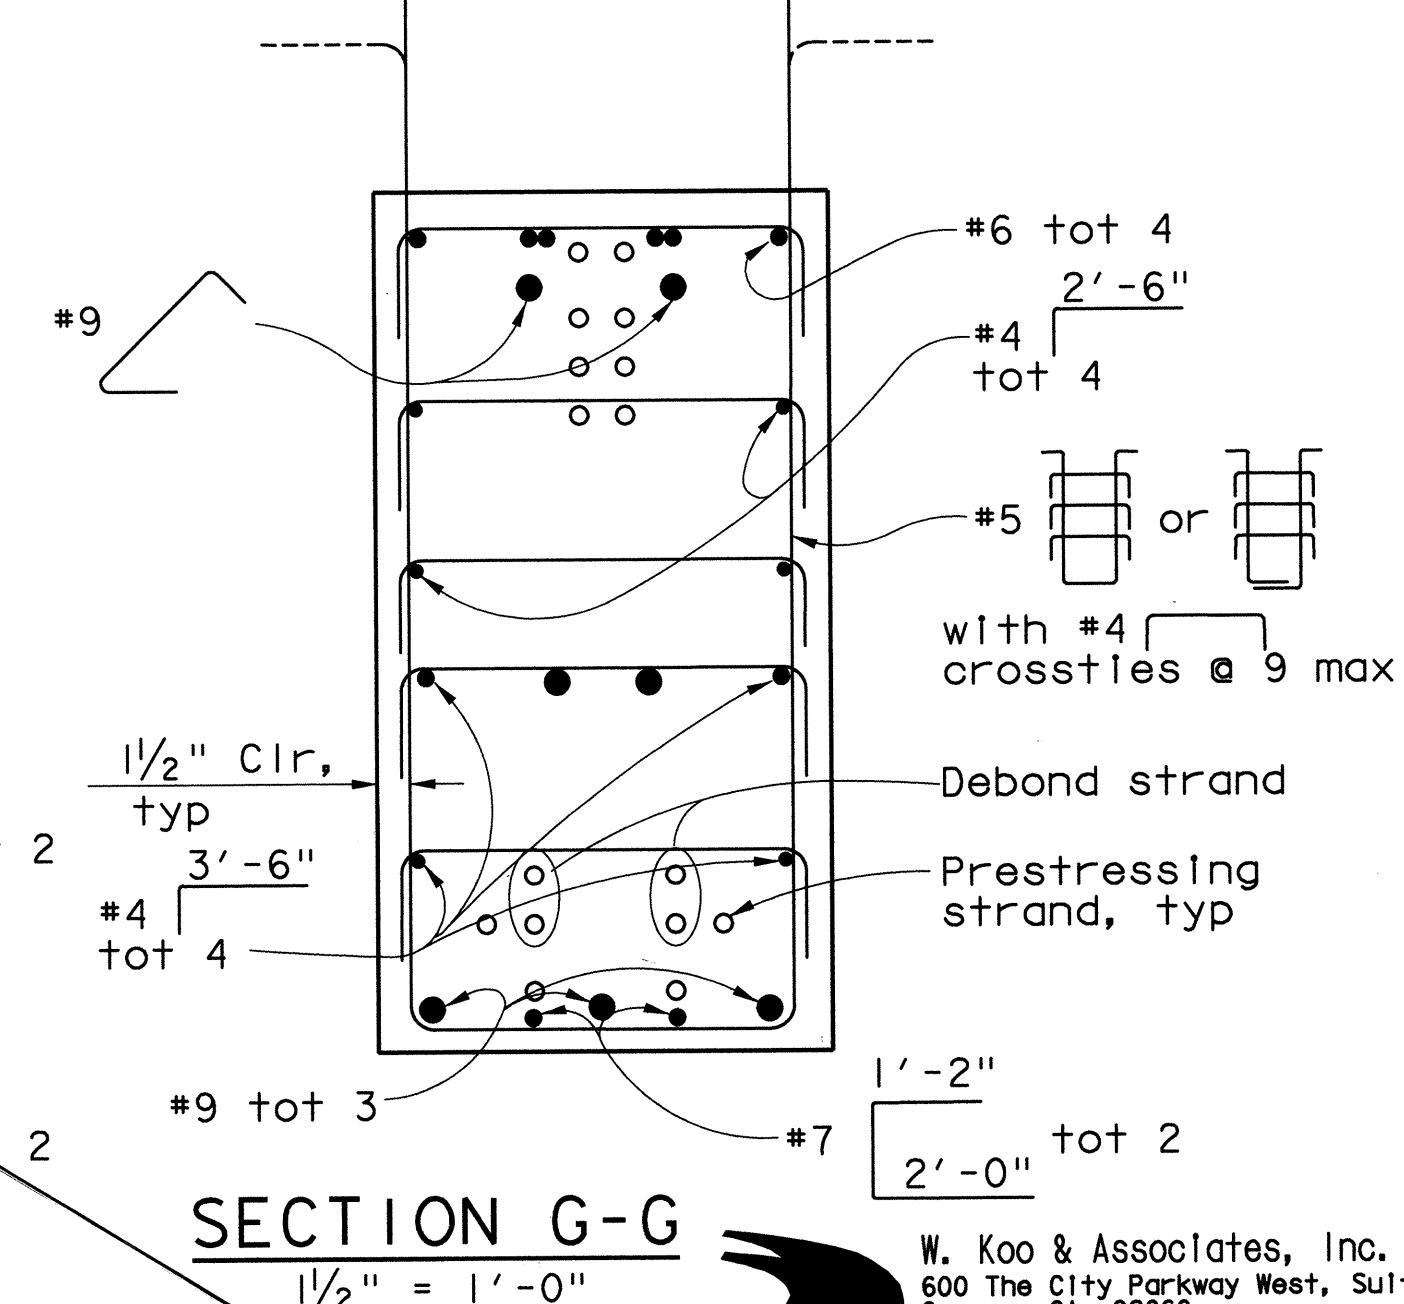
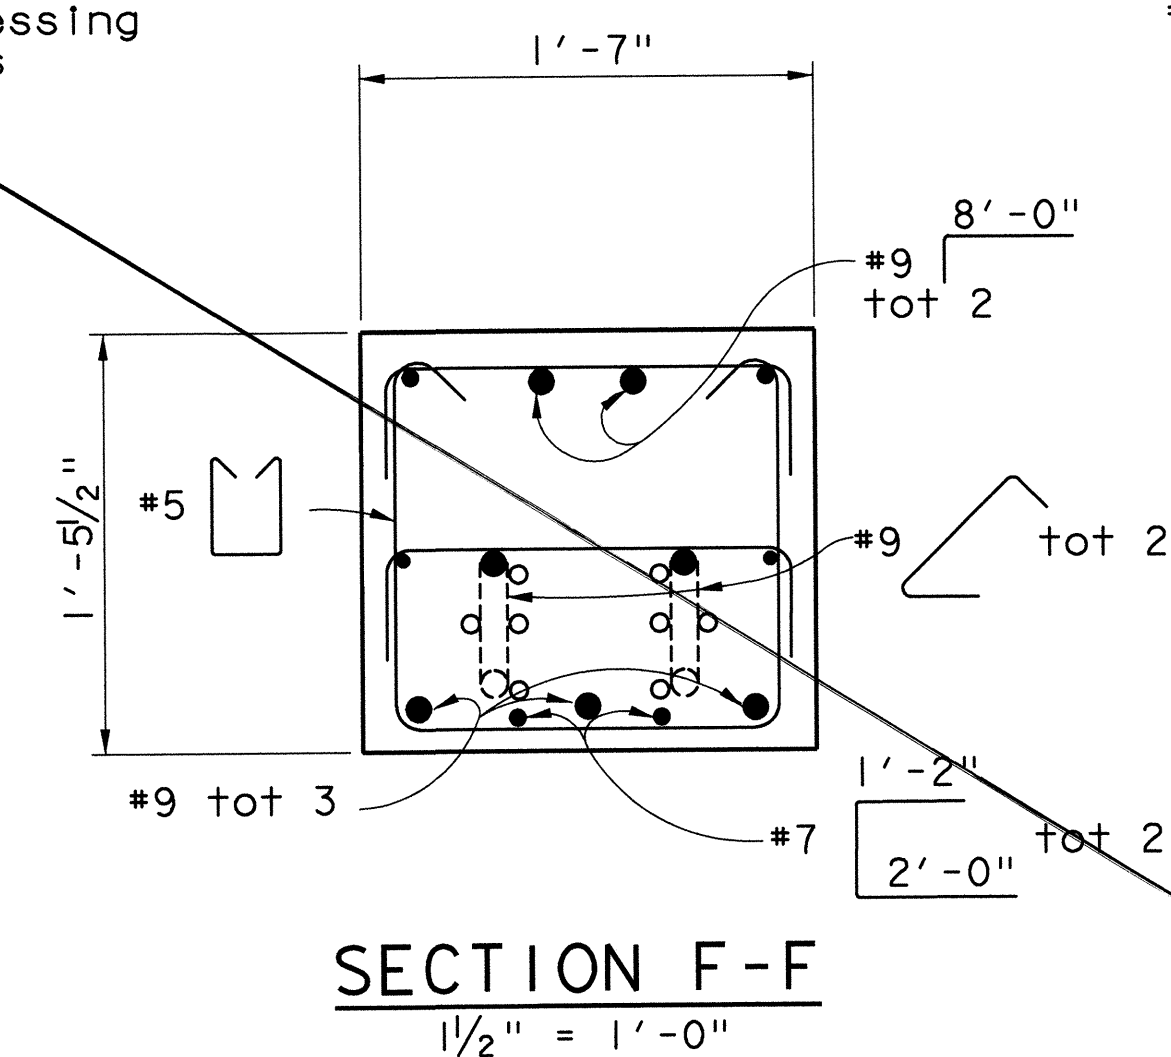
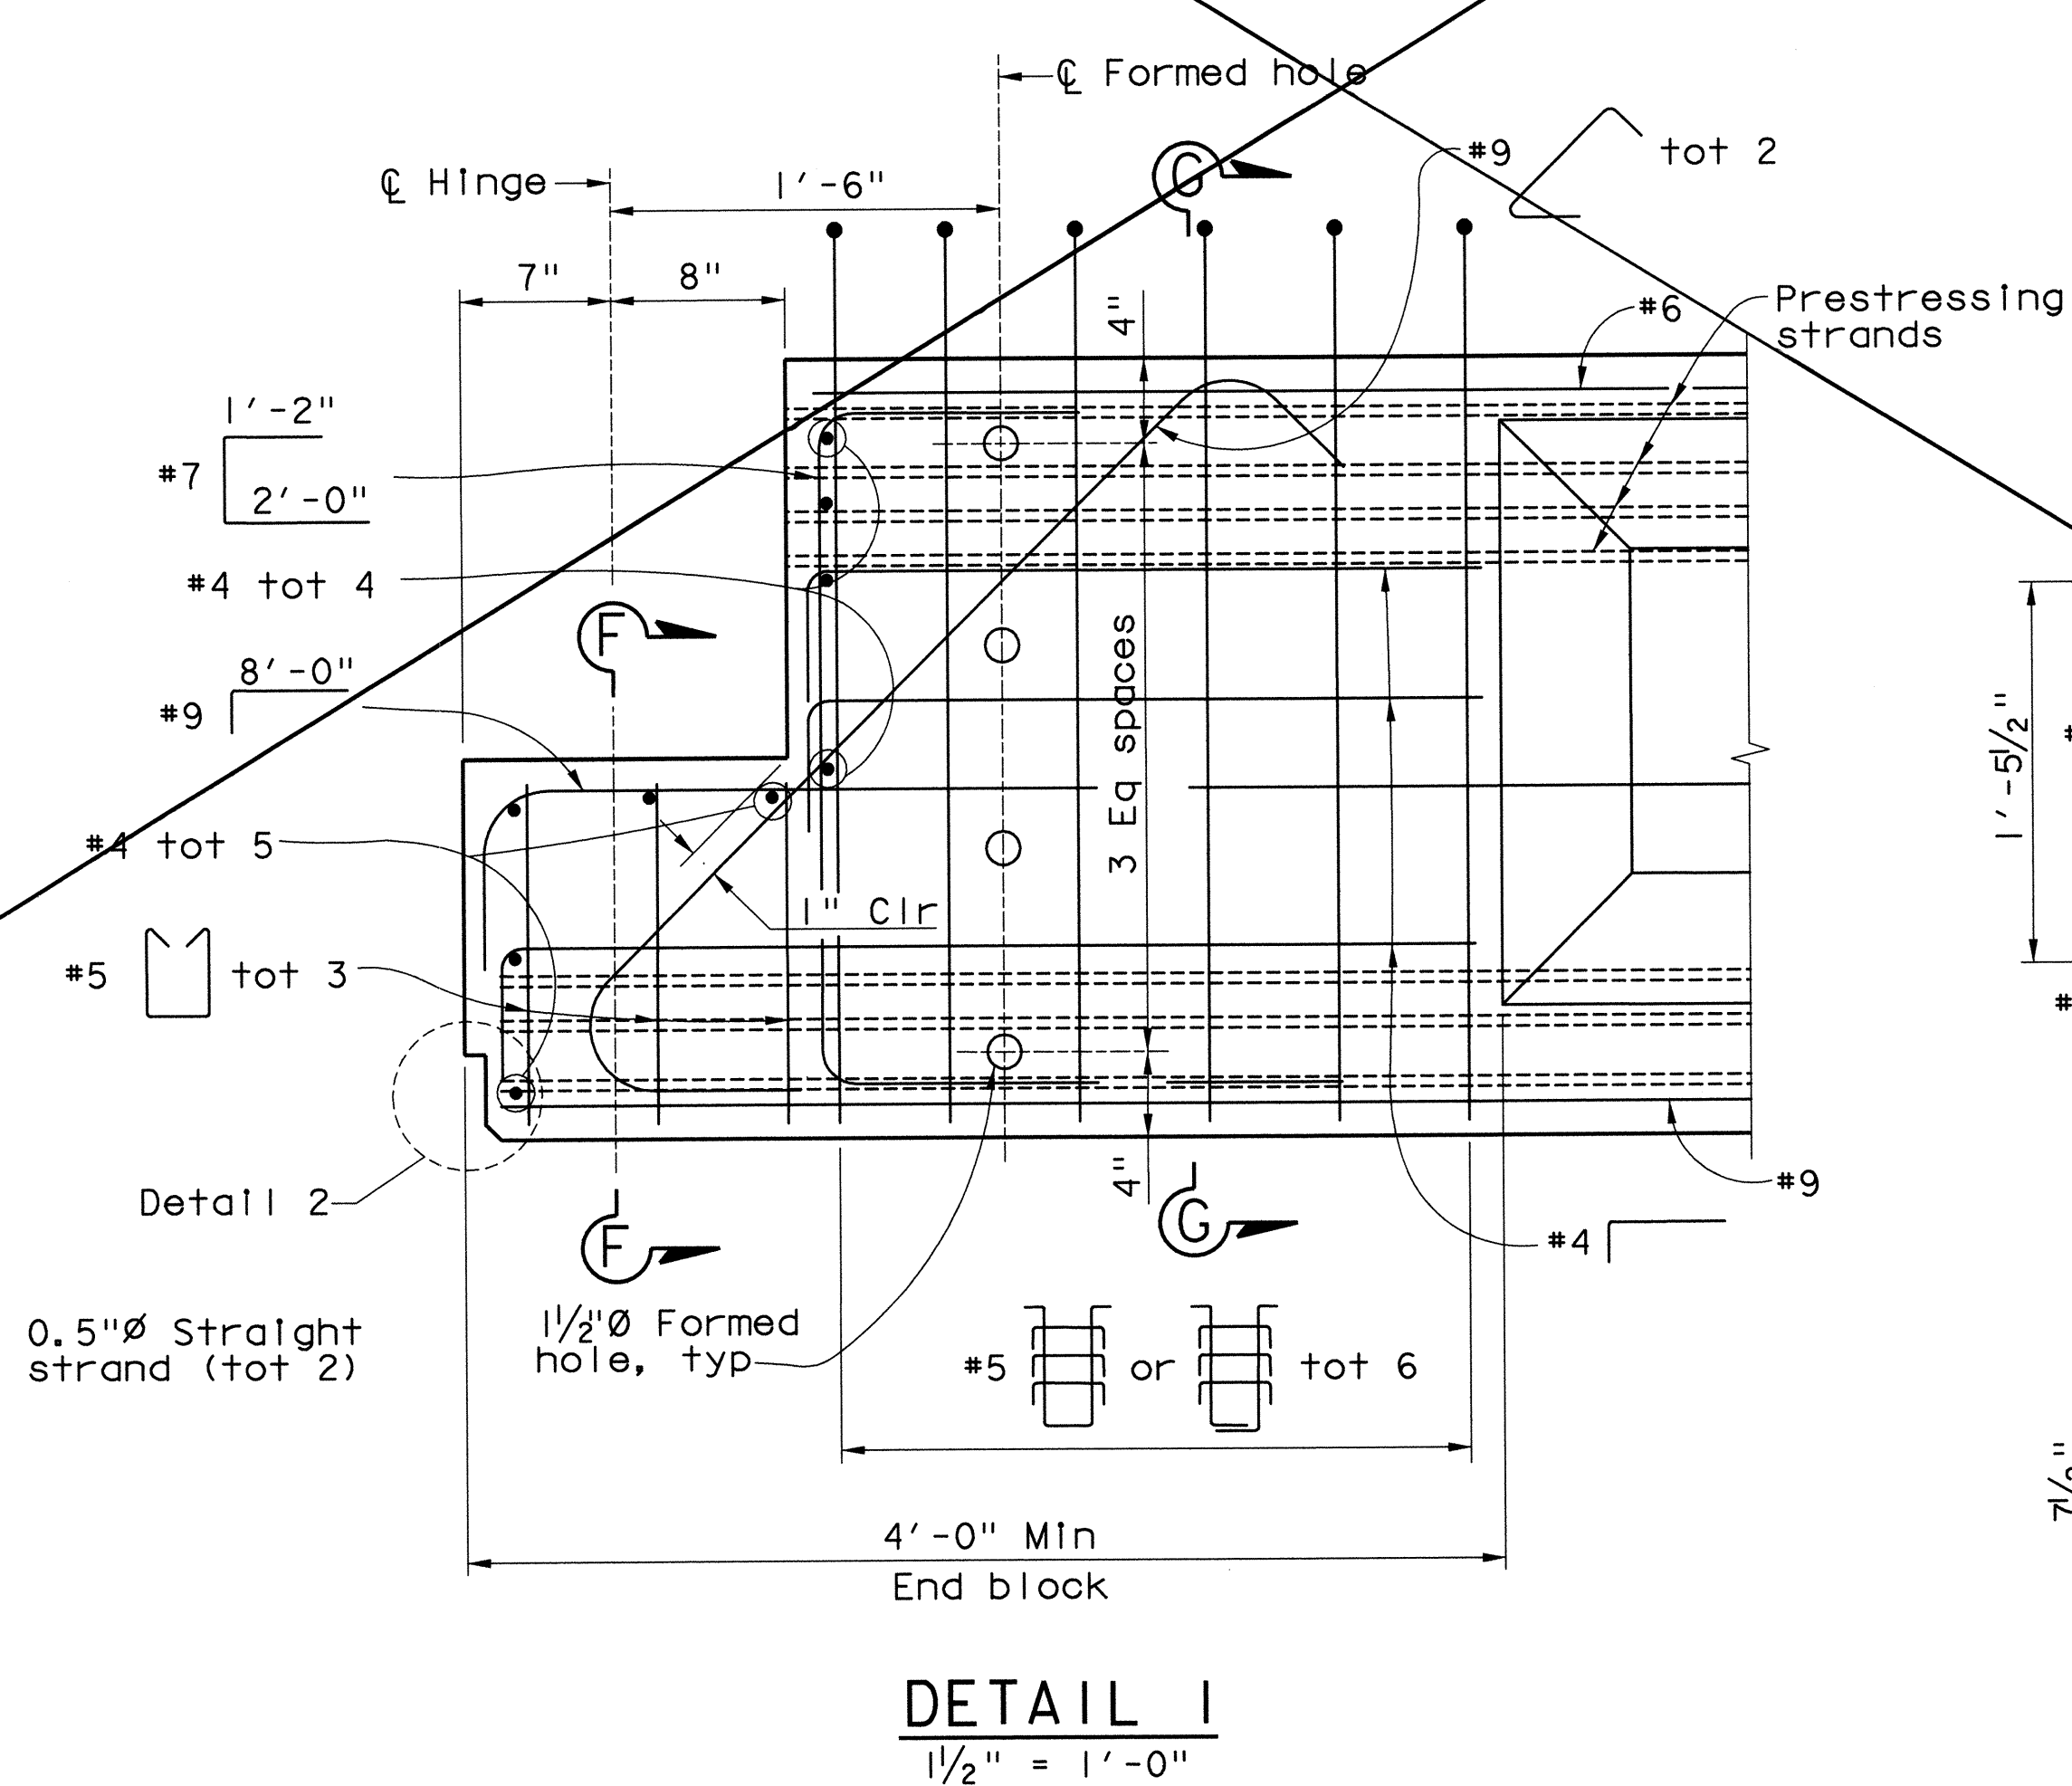
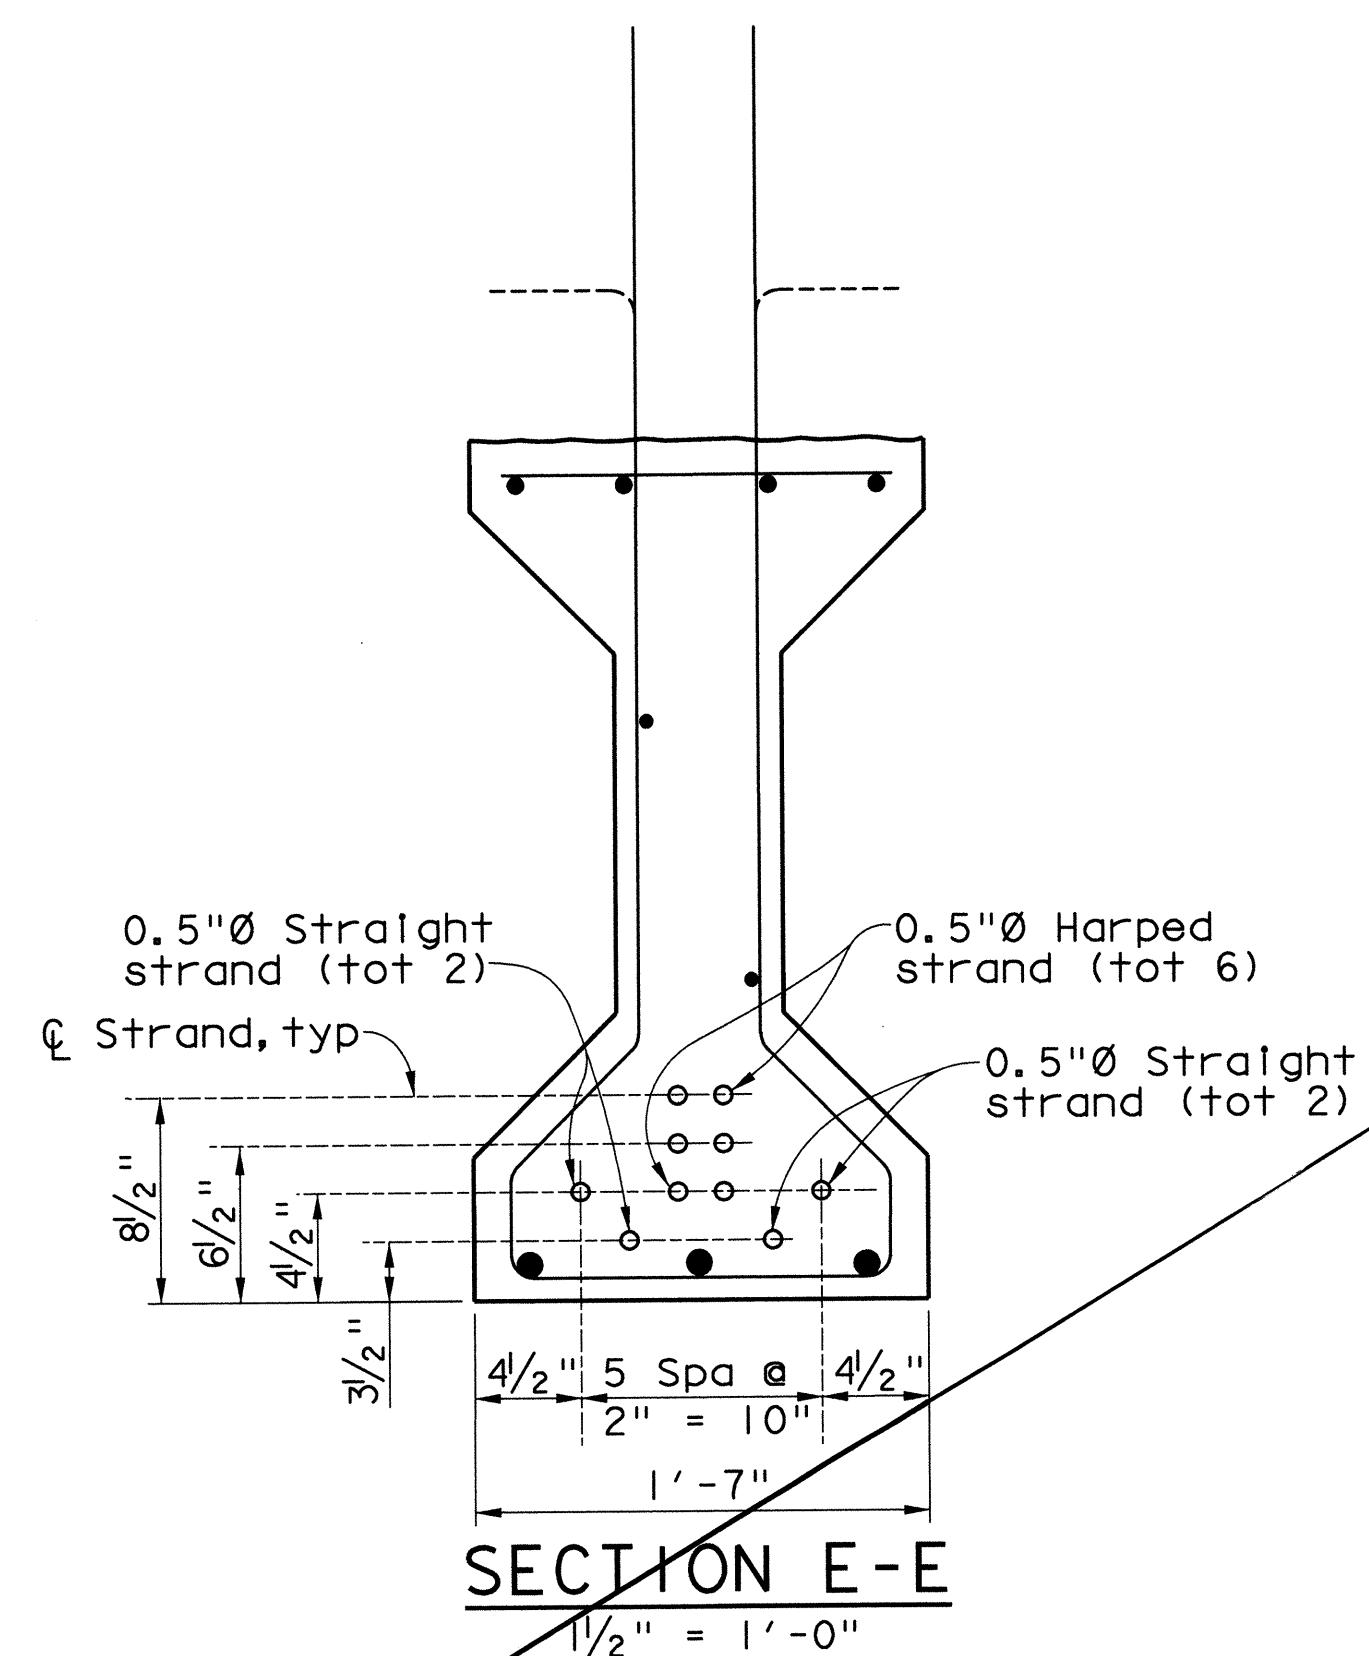
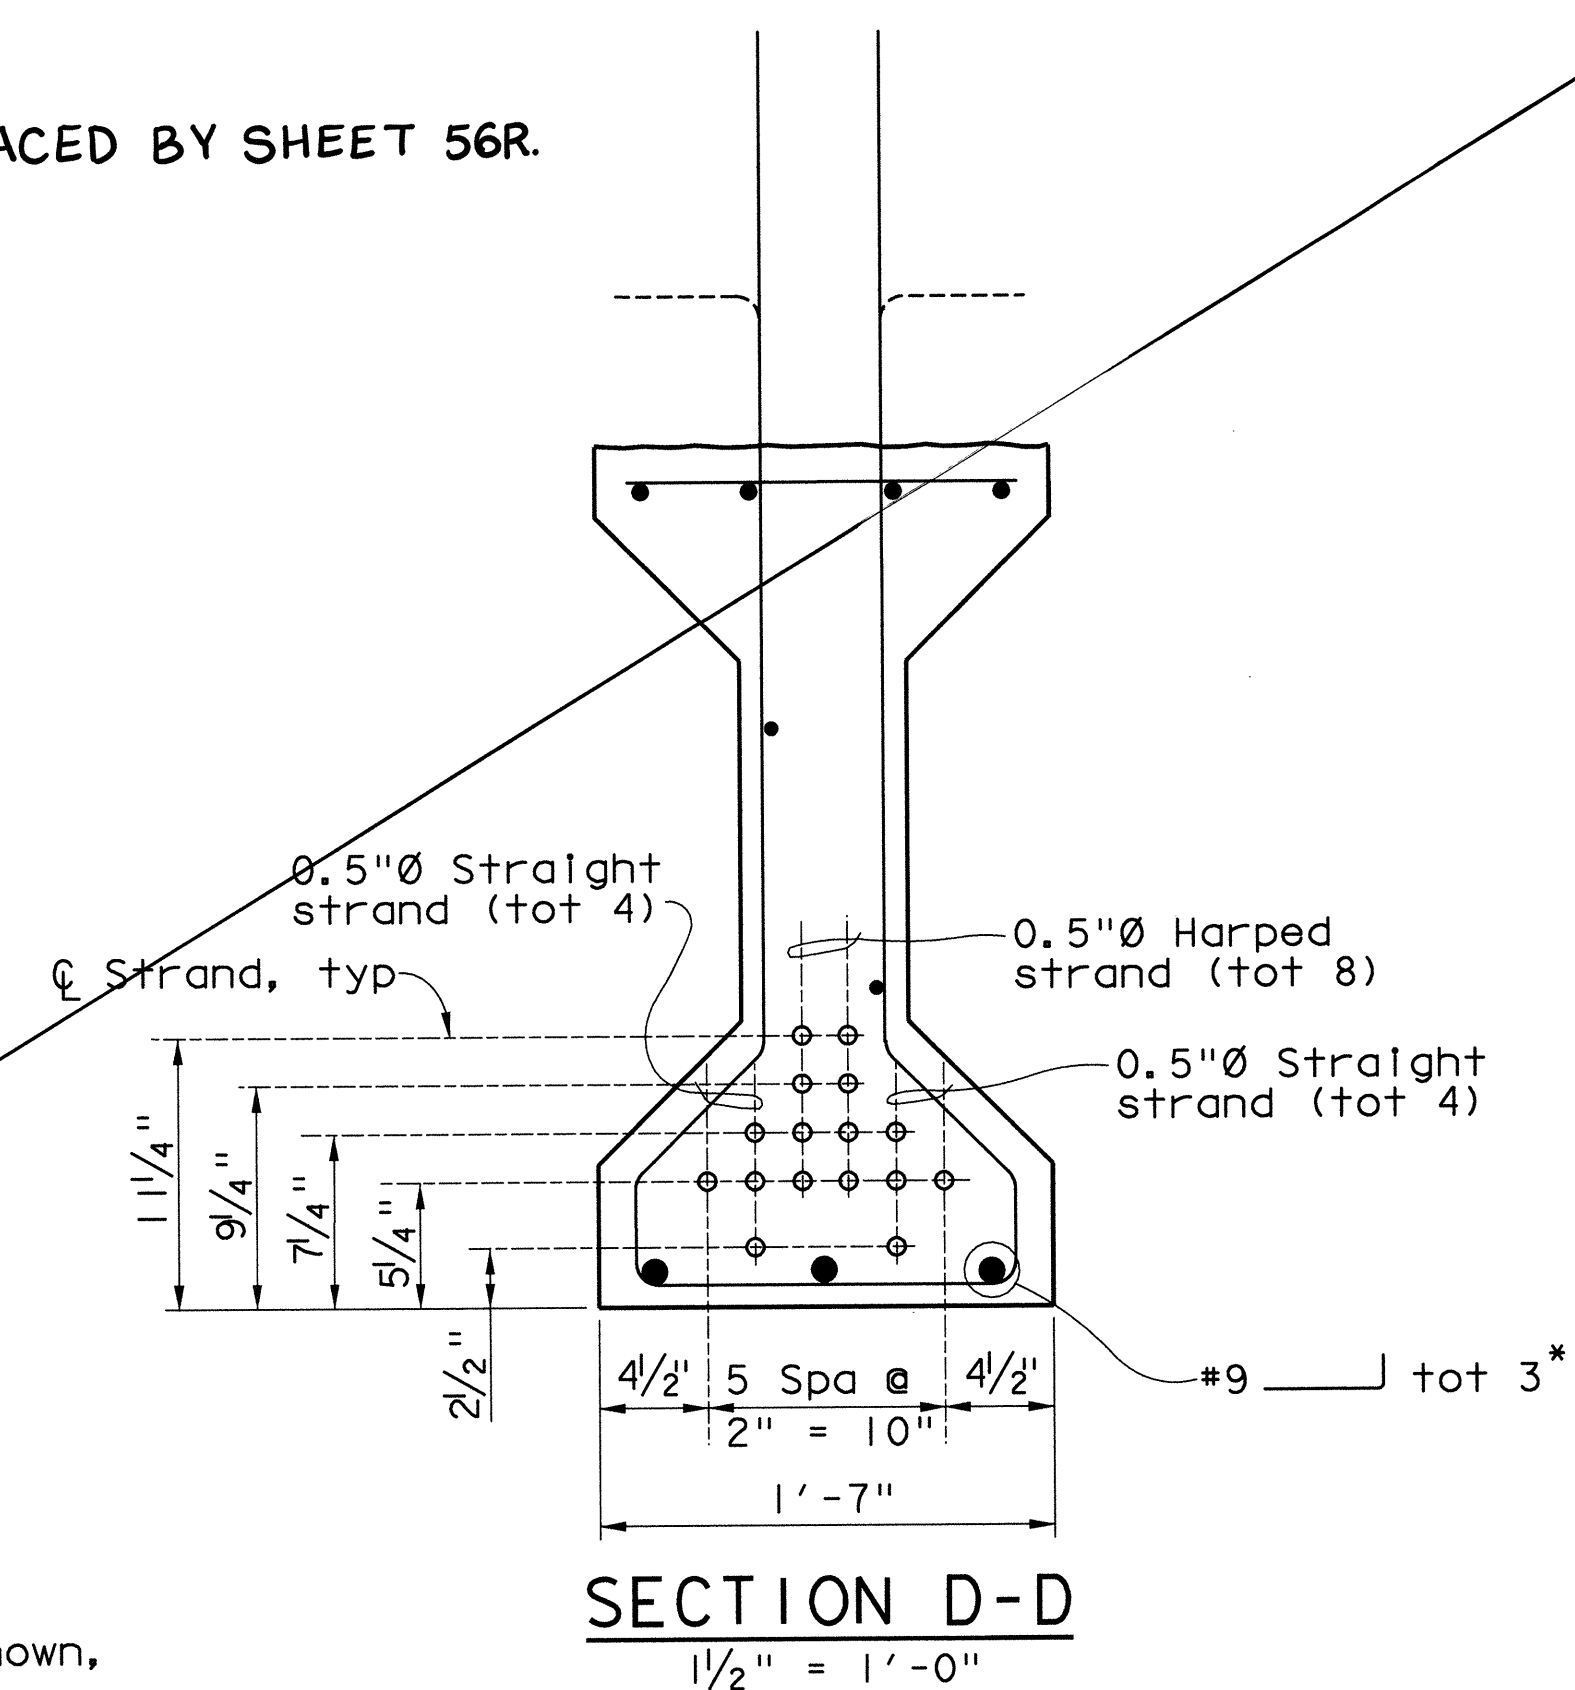
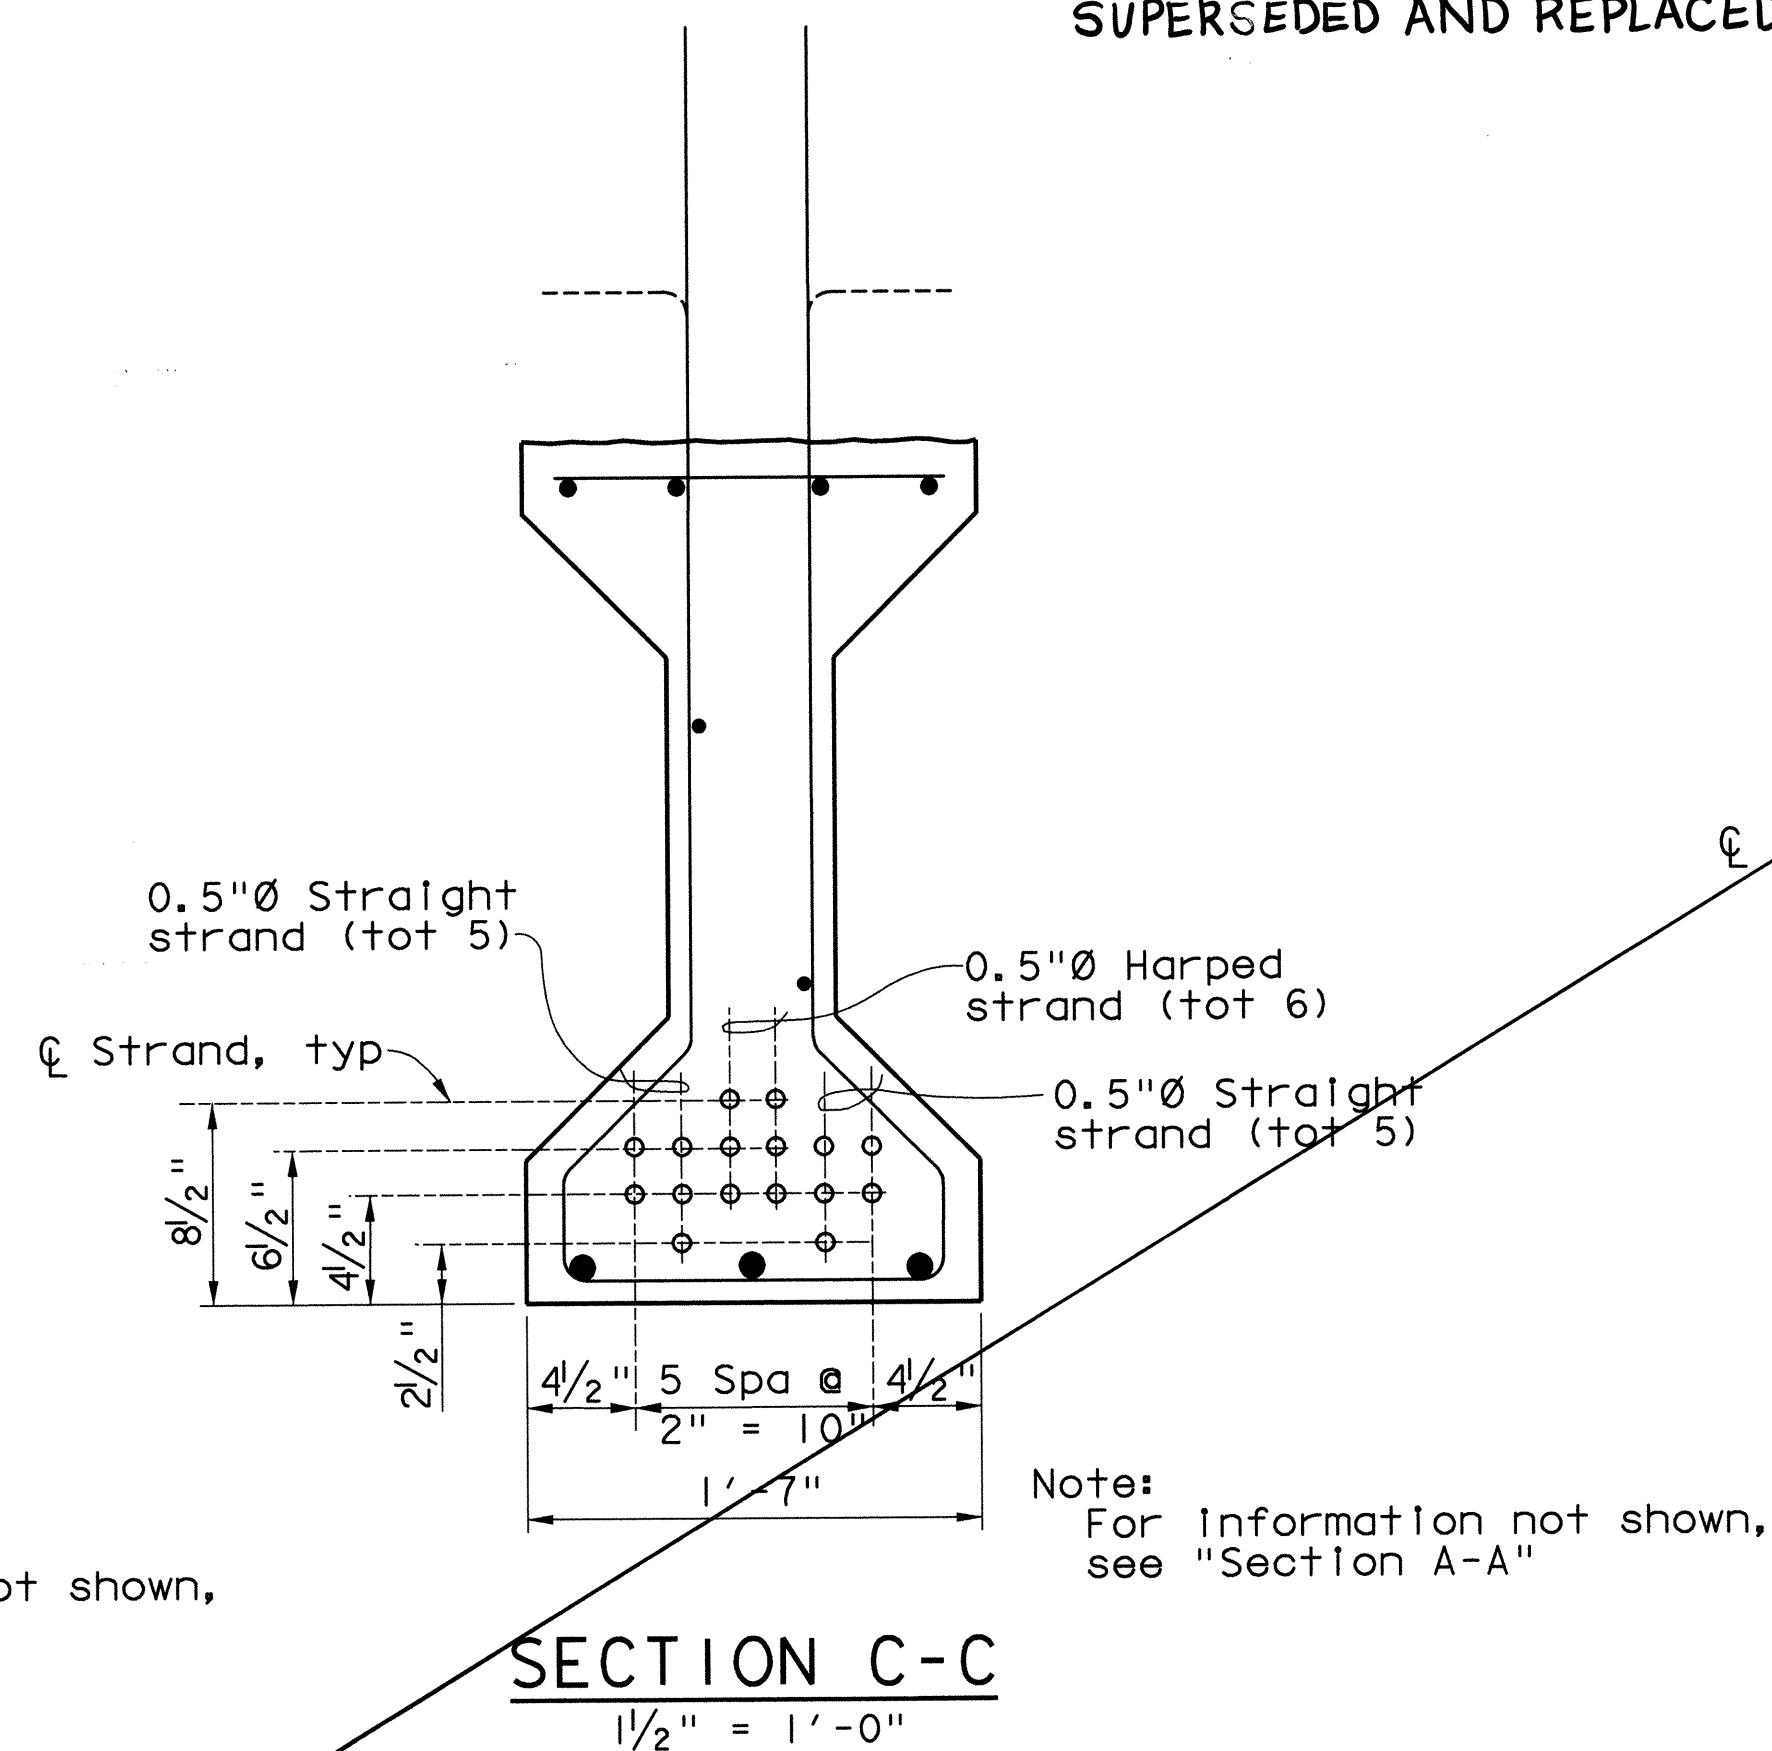
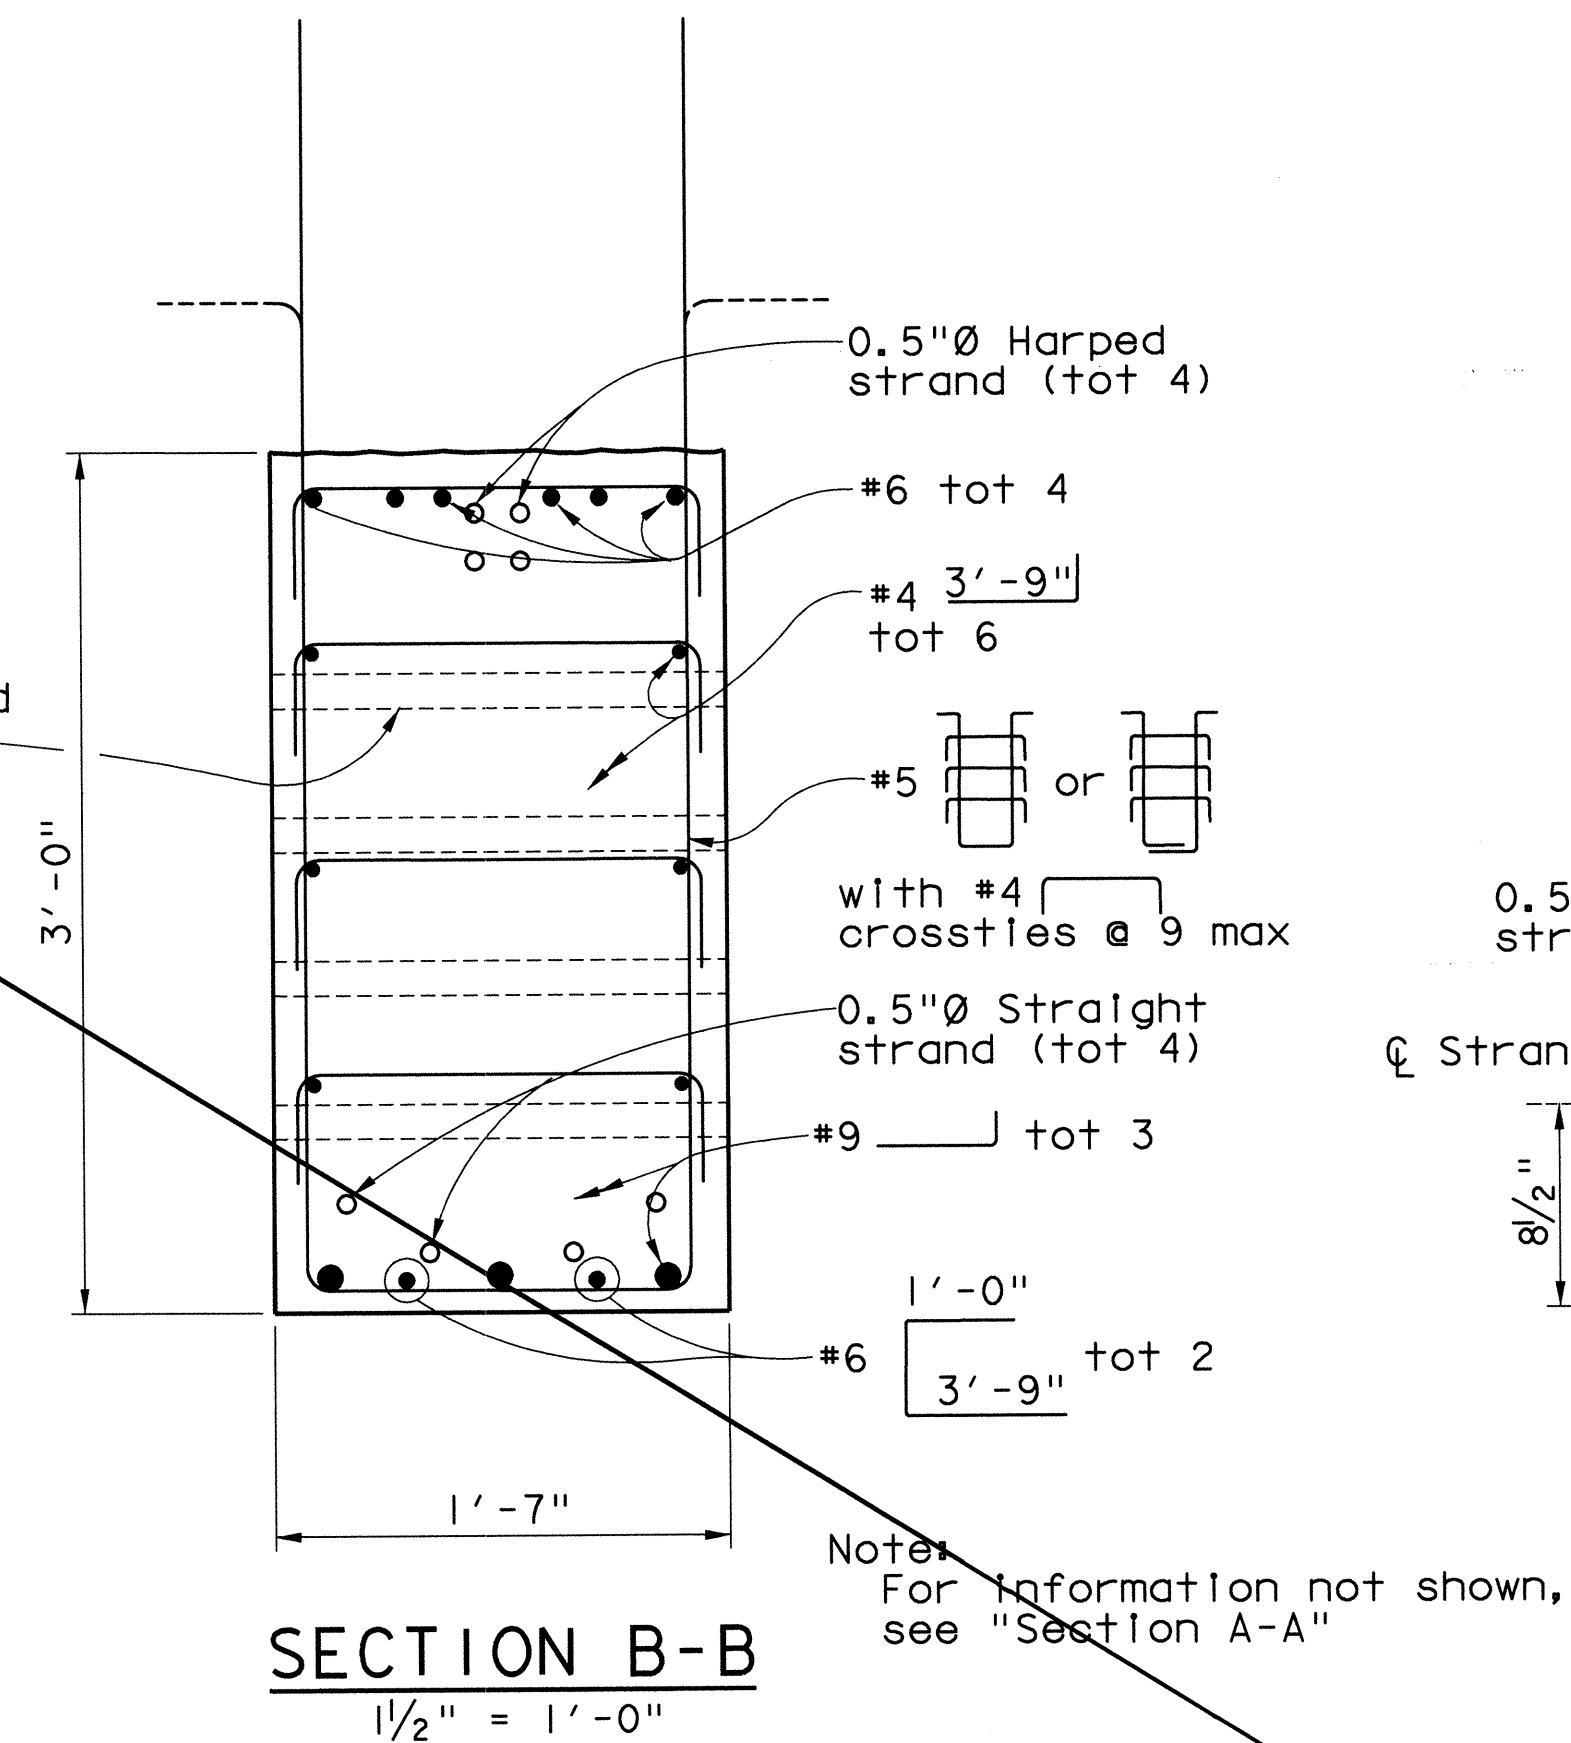


SUPERSEDED AND REPLACED BY SHEET 56R

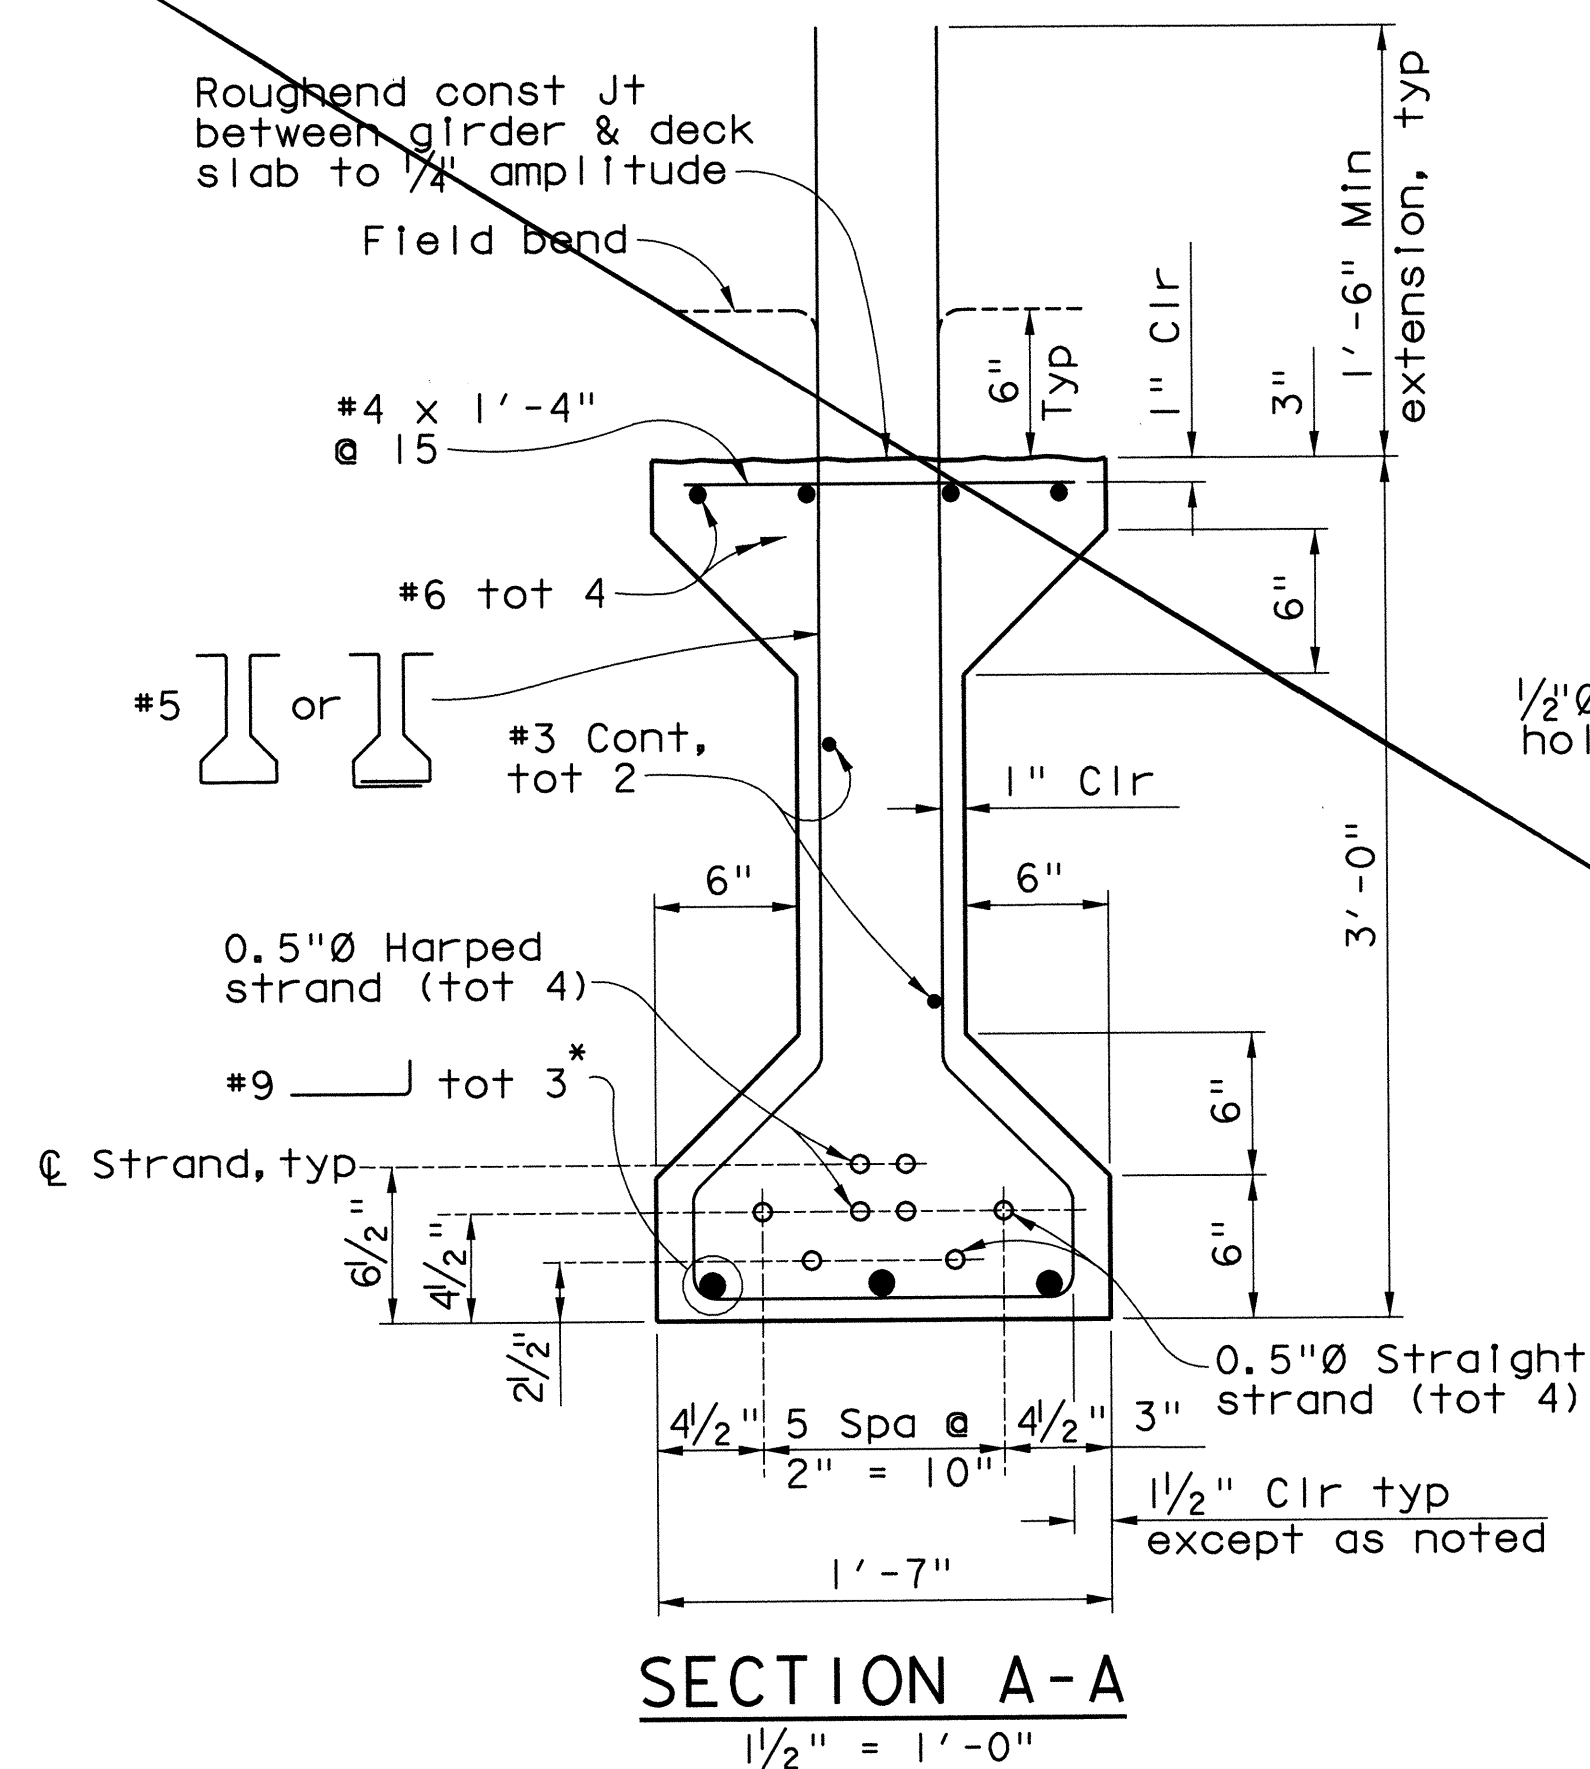

W. Koo & Associates, Inc.
600 The City Parkway West, Suite 310
Orange CA. 92868
PH: (714) 456-0280
FAX: (714) 456-0295

				ORANGE COUNTY PUBLIC FACILITIES AND RESOURCES DEPARTMENT	
				GLASSSELL STREET BRIDGE WIDENING OVER SANTA ANA RIVER	
MARK	DATE	DESCRIPTION			
REVISIONS					
PREPARED UNDER RESPONSIBLE CHARGE OF: 2/19/02					
				DESIGNED <u>K. RUSSELL</u>	
				SHEET	
				56	
				OF 70	
				DRAWN <u>G. BUELOW</u>	
				CHECKED <u>S. SHARFAN</u>	
		SCALE		DATE	
		AS SHOWN		7/19/02	
				DRAWING NO.	

Note: Contractor shall verify all controlling field dimensions before ordering or fabricating any material

Order sheet last modified 09-Nov-1999